

NO.	ISSUES/REVISIONS	DATE
	100% SCHEMATIC DESIGN	04/22/08
	20% DESIGN DEVELOPMENT	06/12/08
	30% DESIGN DEVELOPMENT	07/29/08
	SCHEMATICAL	
	05% INCREMENT #1	10/10/08
	10% INCREMENT #2	11/19/08
	15% INCREMENT #3	11/19/08
	20% INCREMENT #4	11/19/08
	25% INCREMENT #5	12/22/08
	30% INCREMENT #6	02/06/09
	35% INCREMENT #7	04/02/09
	40% INCREMENT #8	05/22/09
	45% INCREMENT #9	08/22/09
	50% INCREMENT #10	10/22/09
	55% INCREMENT #11	04/19/11
	60% INCREMENT #12	06/09/11
	65% INCREMENT #13	08/23/11


RECORDED DRAWINGS NEW 1
RECORDED DRAWINGS NEW 2
RECORDED DRAWINGS NEW 3
RECORDED DRAWINGS NEW 100

THE DIVISION OF
PUBLIC UTILITIES AND
ENERGY REGULATION
DATE: 01-10-11
FILE # 01-10117
PROJECT: SKYLINE COLLEGE
DRAWING: ELECTRICAL
SHEET: E-3033A

Increment 3

SKYLINE COLLEGE
SAN MATEO COUNTY
COMMUNITY COLLEGE
DISTRICT

CIP2 DESIGN-BUILD
PROJECT
BUILDING 4
INCREMENT 3

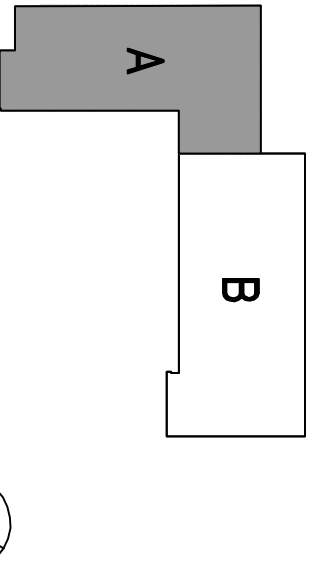

SHEET TITLE
**LEVEL 3
POWER AND SIGNAL
PLAN**
SECTOR A


PROJECT NO. SF1057UD DRAWN BY: IB
DATE: 04/26/08 CHECKED BY: AS

SCALE: 3/32"=1'-0"

SHEET NO.: E-3033A

LEVEL 3 - POWER AND SIGNAL PLAN - SECTOR A

SCALE: 1/8"=1'-0"

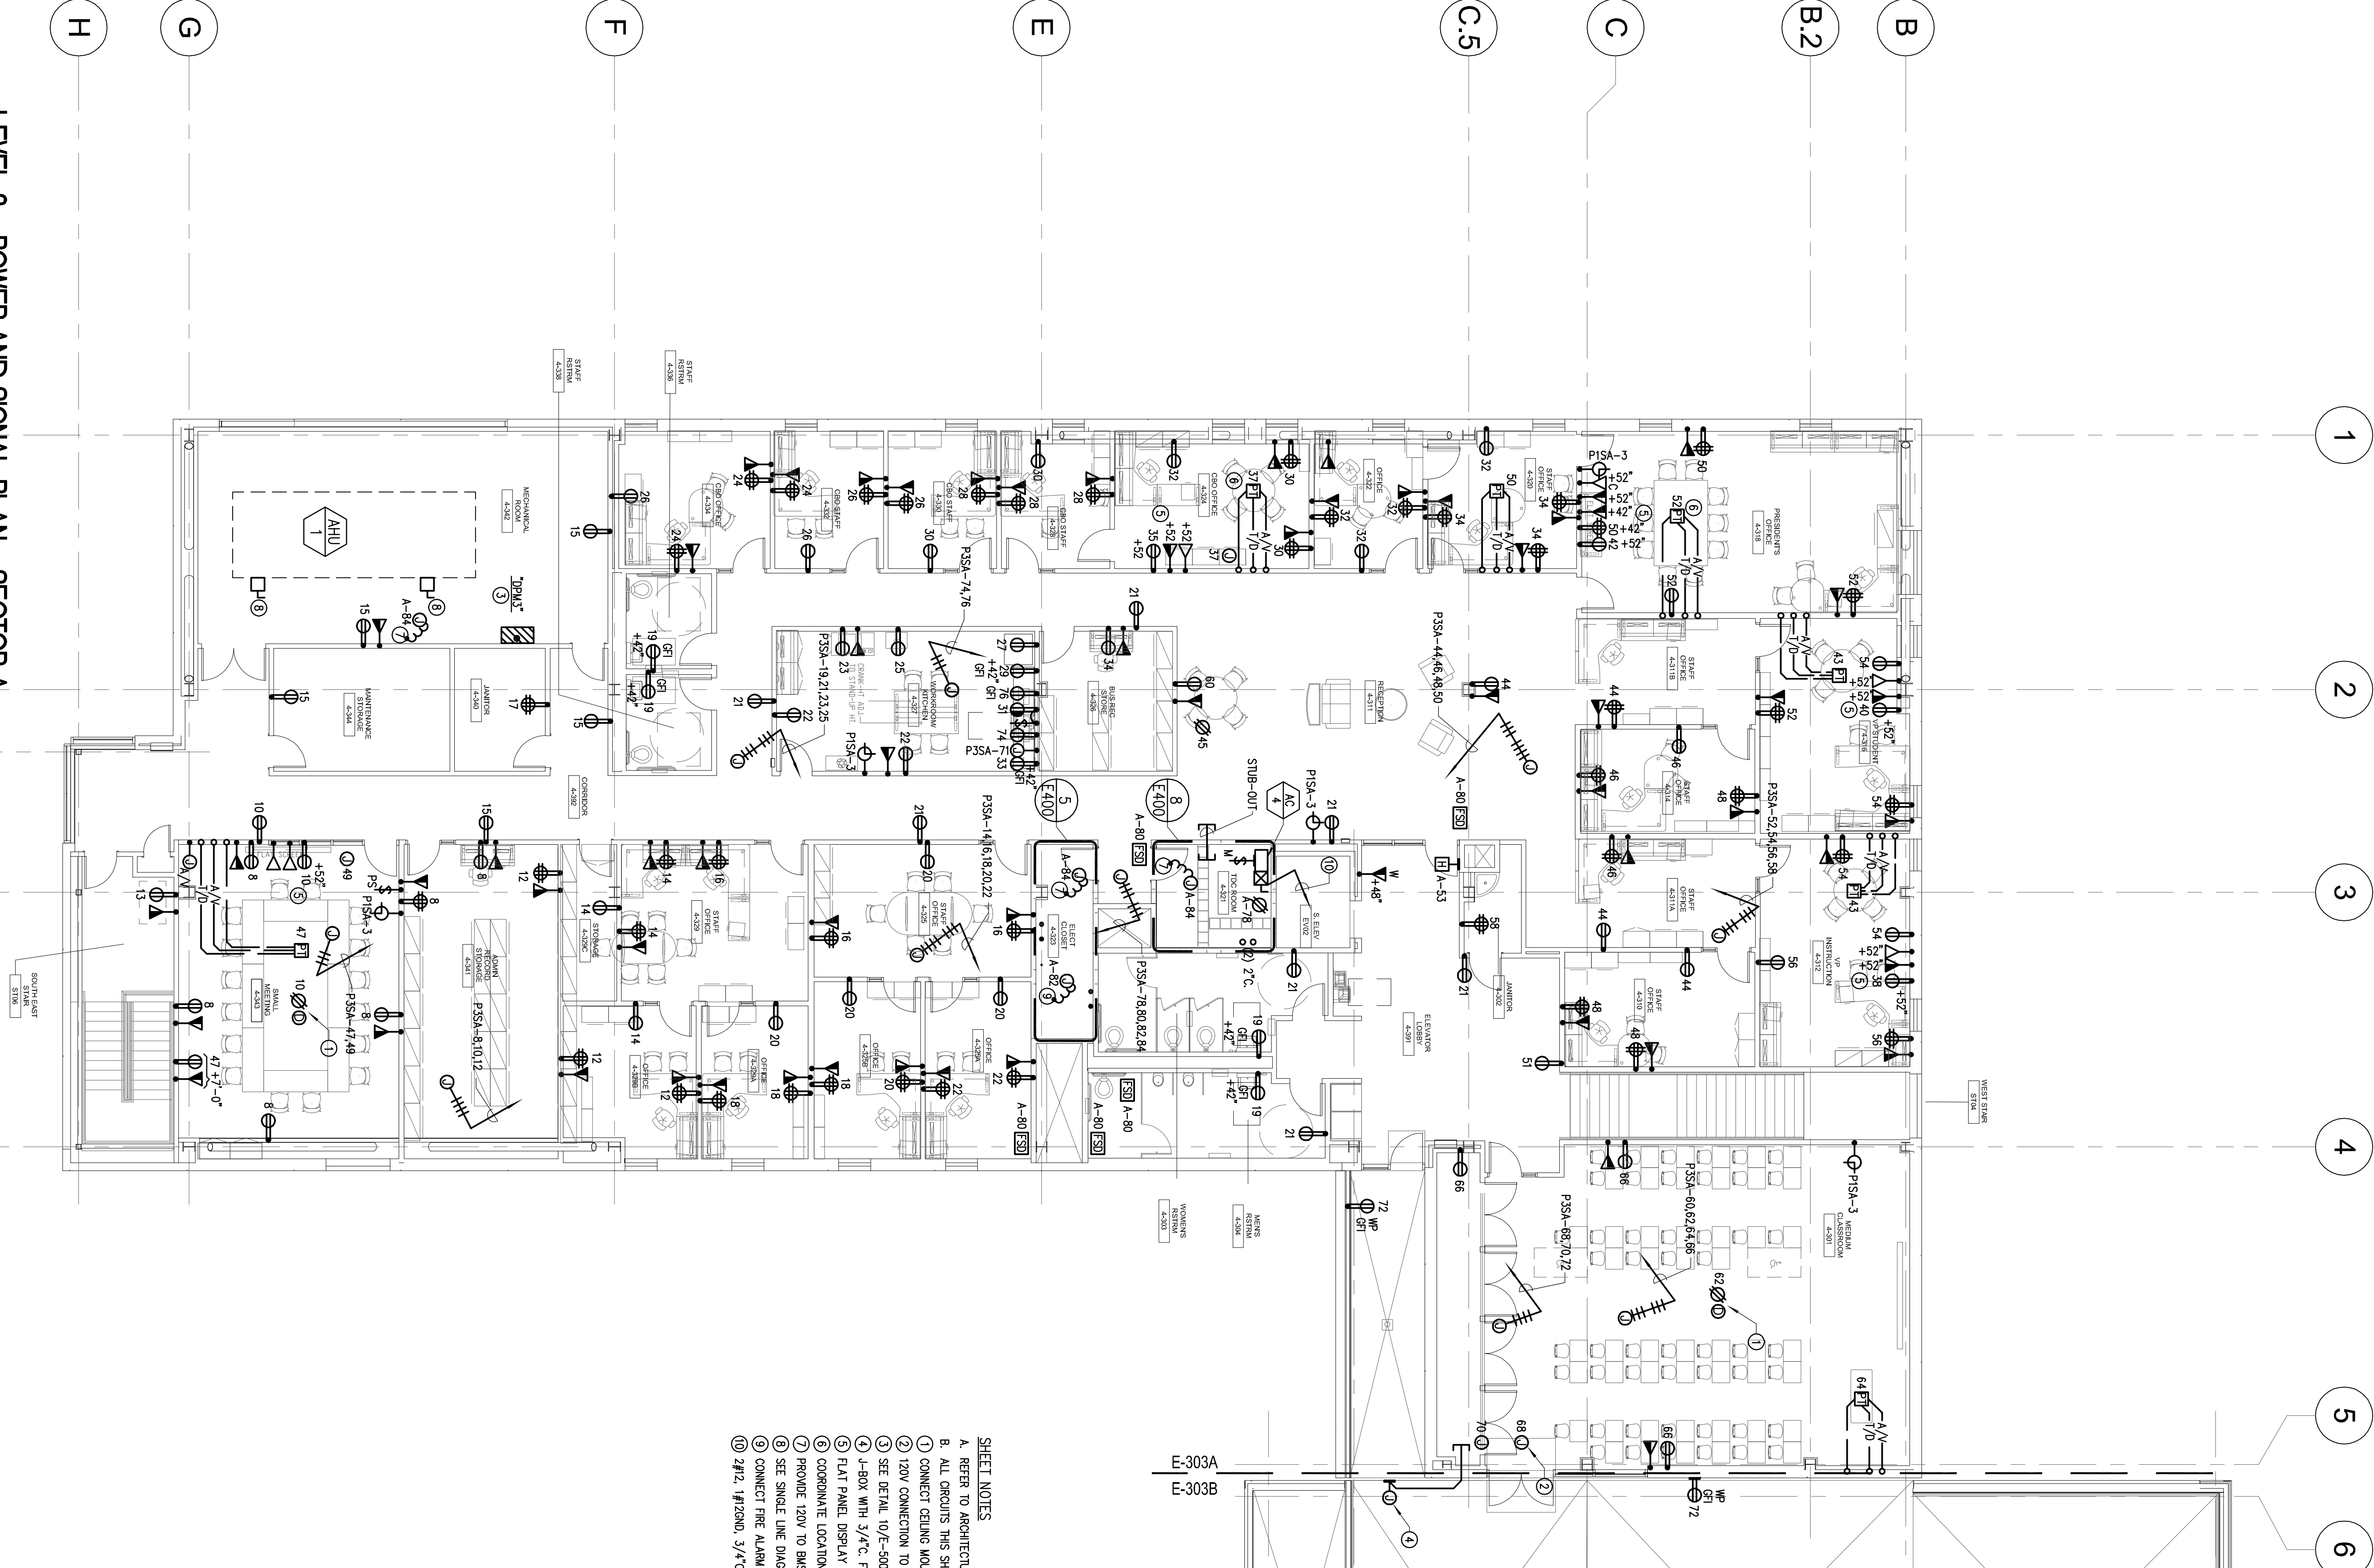

- SHEET NOTES**
- A. REFER TO ARCHITECTURAL DRAWINGS FOR EXACT DIMENSIONS AND MOUNTING HEIGHTS.
 - B. ALL CIRCUITS THIS SHEET END FROM PANEL 735A UNLS.
 - 1. CONNECT BELOW MOUNTED PROJECTOR.
 - 2. 120V CONNECTION TO ELECTRIC DOOR LOCK. COORDINATE WITH SECURITY.
 - 3. SEE DETAIL 10/-300 FOR ADDITIONAL INFORMATION.
 - 4. J-BOX WITH 3/4" C. FOR SECURITY CAMERA. COORDINATE REQUIREMENTS WITH SECURITY DRAWINGS.
 - 5. FLAT PANEL DISPLAY COORDINATE CONNECTION WITH AV CONSULTANT.
 - 6. COORDINATE LOCATION OF FLOOR MOUNTED OUTLETS WITH ARCHITECT PRIOR TO ROOM-IN.
 - 7. PROVIDE 120V TO BIAS POWER SUPPLY IN THIS ROOM. COORDINATE LOCATION WITH CONTROLS CONTRACTOR.
 - 8. SEE SINGLE LINE DIAGRAM.
 - 9. CONNECT FIRE ALARM PANEL.
 - 10. 2#12 #1200L, 3/4" C. TO CU-4 ON ROOF.