

AUDIOVISUAL TITLE SHEET

AUDIOVISUAL

- Ⓞ CEILING BOX
- Ⓜ FLOOR BOX
- Ⓟ POKE-THRU
- Ⓢ BACKCAN FOR CEILING MOUNTED LOUDSPEAKER
- Ⓜ WALL BOX
- Ⓢ CEILING MOUNTED PROJECTION SCREEN
- Ⓢ CONDUIT STUB ABOVE CEILING





NOTE: SEE BACKBOX SCHEDULE FOR DEVICE TYPE AND SIZE.

- Ⓢ EVENT ANNUNCIATION SYSTEM LOUDSPEAKER, CEILING MOUNTED.
- Ⓢ EVENT ANNUNCIATION SYSTEM LOUDSPEAKER, WALL MOUNTED.

NOTE: DAISY-CHAIN SIGNAL CABLE BACK TO IDF ROOM.

CONVENTIONS

- [E-1] ELECTRICAL SHEET NOTE
- [G-1] GENERAL CONTRACTOR SHEET NOTE
- [M-1] MECHANICAL CONTRACTOR SHEET NOTE
- [S-1] SECURITY SHEET NOTE
- [T-1] TELECOM SHEET NOTE
- [AV-1] AUDIOVISUAL SHEET NOTE
- ① CONDUIT IDENTIFICATION TAG.
- ① NUMBERED SHEET NOTE (APPLIES TO DRAWING CONTAINING NOTES ONLY).
- ① EQUIPMENT IDENTIFICATION TAG.
- 001 DOOR NUMBER
- co1 TELECOMMUNICATION CONDUIT BANK TAG. REFER TO SCHEDULE.

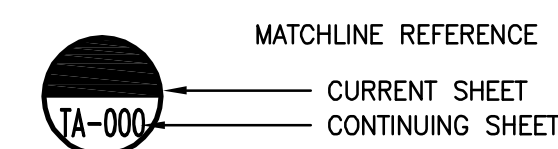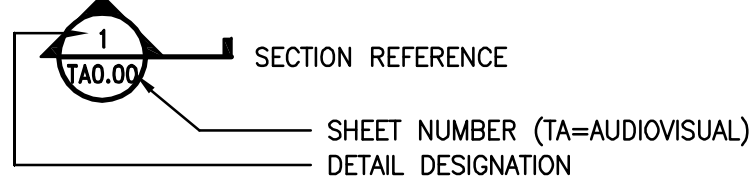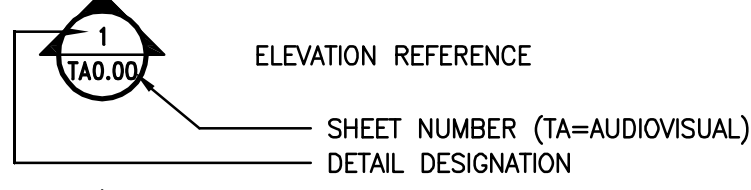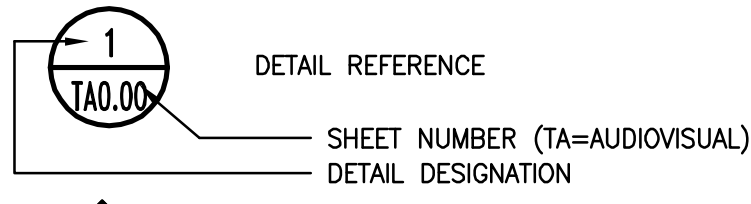

GENERAL NOTES

- PROJECT OVERALL:**
- THE PURPOSE OF THIS SHEET IS TO ILLUSTRATE AND DEFINE TYPICAL GRAPHIC SYMBOLS, AND SYSTEMS OF GRAPHIC SYMBOLS, WHICH MAY OCCUR ON THE AUDIOVISUAL DRAWINGS. THE ILLUSTRATION OF A SYMBOL, OR SYSTEM OF SYMBOLS, ON THIS SHEET DOES NOT NECESSARILY INDICATE THAT THE BUILDING ITEM OF THE DESCRIBED SYSTEM BY THE SYMBOL IS USED AS PART OF THIS PROJECT. REFER TO THE PLANS, ELEVATIONS, SECTIONS, SCHEDULES, DETAILS, AND SPECIFICATIONS TO DETERMINE THE SCOPE OF THE WORK.
 - THE WORK – INCLUDING MATERIALS, METHODS, ASSEMBLIES, ETC – MUST COMPLY WITH THE MINIMUM REQUIREMENTS OF THE GOVERNING LAWS, ORDINANCES, AND REGULATIONS OF ALL FEDERAL, STATE, DISTRICT, AND LOCAL AUTHORITIES HAVING JURISDICTION OVER THE PROJECT, AS WELL AS THOSE GREATER REQUIREMENTS INDICATED BY THE CONTRACT DOCUMENTS. NO PART OF THE CONTRACT DOCUMENTS MAY BE CONSTRUED TO REQUIRE OR PERMIT WORK CONTRARY TO A GOVERNING LAW, ORDINANCE, OR REGULATION.
 - THE AUDIOVISUAL DRAWINGS ARE PART OF A LARGER SET OF DRAWINGS WHICH, WHEN COMPLETE, CONSISTS OF DRAWINGS LISTED BY THE "INDEX OF DRAWINGS". THE WORK DESCRIBED BY THE DRAWINGS OF ANY ONE DISCIPLINE MAY BE AFFECTED BY THE WORK AND REQUIREMENTS DESCRIBED ON DRAWINGS OF ANOTHER DISCIPLINE AND MAY REQUIRE REFERENCE TO THE DRAWINGS OF ANOTHER DISCIPLINE. PARTIAL SETS OF DRAWINGS ARE INCOMPLETE AND SHOULD NOT BE DISTRIBUTED OR UTILIZED BY THE CONTRACTOR. MANAGE, SUPERVISE, REVIEW, AND COORDINATE THE WORK OF SUB-CONTRACTORS, TRADES, AND SUPPLIERS WITH THE REQUIREMENTS OF THE CONTRACT DOCUMENTS BEFORE COMMENCING CONSTRUCTION AND TO ASSURE THAT PARTIES ARE AWARE OF REQUIREMENTS, REGARDLESS OF WHERE THE REQUIREMENTS OCCUR IN THE CONTRACT DOCUMENTS, WHICH MIGHT AFFECT THE WORK OF THAT PARTY.
 - THE ARCHITECTURAL DRAWINGS ESTABLISH AND COORDINATE THE FINISHED APPEARANCE AND EXACT LOCATION OF EXPOSED ELEMENTS OF THE WORK OF TRADES, INCLUDING THAT WORK THAT IS ILLUSTRATED PRIMARILY ON THESE DRAWINGS. LOCATIONS SHOWN ON THESE DRAWINGS ARE DIAGRAMMATIC, UNLESS OTHERWISE NOTED ON THE ARCHITECTURAL DRAWINGS.
 - MAINTAIN A COPY OF THE SPECIFICATIONS AND DRAWINGS AT THE JOB SITE. PRESENT THE SPECIFICATIONS AND DRAWINGS UPON REQUEST. MAINTAIN DAILY MARKUPS OF ACTUAL INSTALLATION AND PRESENT FOR REVIEW UPON REQUEST.
 - REFER TO WRITTEN SPECIFICATIONS FOR PROJECT SCOPE, GENERAL REQUIREMENTS, PRODUCT SPECIFICATIONS, AND INSTALLATION REQUIREMENTS.
 - PROVIDE NECESSARY EQUIPMENT AND ACCESSORIES FOR A FULLY FUNCTIONAL SYSTEM THAT MEETS INTENDED DESIGN WHETHER EXPRESSLY SPECIFIED OR NOT.
 - LABEL MATERIALS AND EQUIPMENT LISTED BY UNDERWRITERS LABORATORIES FOR THE PURPOSE USED AND BEARING THEIR LABEL.
 - PRIOR TO PERFORMING WORK, IMMEDIATELY NOTIFY THE OWNER OR OWNER'S REPRESENTATIVE, IN WRITING OF OBSERVATIONS OR CONDITIONS THAT ARE DISCOVERED THAT WOULD PREVENT INSTALLATION ACCORDING TO DRAWINGS AND SPECIFICATIONS.
 - BRING A SET OF MARKED UP PLANS TO WEEKLY CONSTRUCTION MEETINGS FOR OWNER'S, OR OWNER'S REPRESENTATIVE'S, APPROVAL PRIOR TO PRODUCTION OF AS-BUILT DRAWINGS FOR RECORD DOCUMENTATION.
 - REMOVE ABANDONED CABLING AND LEFT OVER CONDUIT, WIRE, SCRAPS, ETC. AND LEAVE PREMISES CLEAN AND FREE OF TRASH OR DEBRIS RESULTING FROM WORK.

AUDIOVISUAL PATHWAYS:

- INSTALL EQUIPMENT, DEVICES, AND PATHWAYS, SUCH AS CABLE TRAY, RUNWAY, CONDUITS, CABLE HANGERS, AND PULLBOXES, ETC., ACCORDING TO STATE AND LOCAL CODES FOR SEISMIC BRACING.
- CONDUIT ROUTING, WHERE SHOWN ON DRAWINGS, IS DIAGRAMMATIC IN NATURE. FIELD DETERMINE CONDUIT ROUTES TO SUIT FIELD CONDITIONS WHILE CONFORMING TO SPECIFICATIONS. PREPARE SHOP DRAWINGS SHOWING EXACT CONDUIT ROUTES, INDICATING PENETRATION TYPES (e.g., FRAMED WALL, CONCRETE WALL, ETC.). COORDINATE REQUIREMENTS OF OTHER TRADES.
- CONFORM TO CONDUIT INSTALLATION INSTRUCTIONS OF TIA/EIA-568 AND BICSI TDMM.
- ROUTE CONDUIT, CABLE TRAYS, AND OTHER PATHWAYS PERPENDICULAR OR PARALLEL TO BUILDING LINES.
- CONDUITS WITH LESS THAN 2" INSIDE DIAMETER WILL HAVE A 90-DEGREE BEND RADIUS OF NO LESS THAN 6 TIMES THE INSIDE DIAMETER. CONDUITS WITH A 2" OR GREATER INSIDE DIAMETER WILL HAVE A 90-DEGREE BEND RADIUS OF NO LESS THAN 10 TIMES THE INSIDE DIAMETER.
- CONDUIT RUNS SHALL NOT EXCEED 180 DEGREES OR TWO 90-DEGREE BENDS WITHOUT AN APPROPRIATE NEMA RATED PULL BOX OR/AND INCREASE CONDUIT BY ONE TRADE SIZE FOR EACH ADDITIONAL BEND, UNLESS LAST BEND IS WITHIN 12 INCHES OF THE CONDUIT END.
- WHEN ROUTING CONDUIT IN CONCRETE, MAINTAIN A GRADUATED BEND RADIUS TO MAINTAIN CONDUIT CAPACITY. THE USE OF 90-DEGREE "ELBOW" FITTINGS IS EXPRESSLY PROHIBITED UNLESS PRIOR AUTHORIZATION IS RECEIVED FROM OWNER, OR OWNER'S REPRESENTATIVE, IN WRITING.
- PROPERLY FIRE SEAL CONDUIT AND RACEWAY PENETRATIONS THROUGH FIRE RATED WALLS AND FLOORS TO MAINTAIN THE FIRE SEPARATION RATING. PROVIDE FIRE SEALING ASSEMBLIES THAT ARE UL LISTED FOR THE APPLICATION. COORDINATE REQUIREMENTS WITH LOCAL FIRE MARSHALL PRIOR TO INSTALLATION.
- PROVIDE EXPANSION/DEFLECTION FITTINGS FOR CONDUITS AT STRUCTURAL EXPANSION JOINT CROSSINGS.
- PROVIDE PLASTIC BUSHINGS ON EXPOSED ENDS OF CONDUIT AND SLEEVES, WHETHER VISIBLE OR NOT.
- PROVIDE EMT 4" TRADE SIZE CONDUITS FOR BACKBONE PATHWAYS WITH 40" MINIMUM BEND RADIUS FITTINGS, UON.
- PROVIDE MINIMUM OF 1-1/4 INCH SIZE CONDUIT FOR HORIZONTAL DISTRIBUTION AND AUDIOVISUAL DEVICES.
- PROVIDE DEDICATED CONDUIT STUB PER AUDIOVISUAL DEVICE BOX. DAISY-CHAINING DEVICE BOXES IS PROHIBITED.
- CONDULET ("LB", ETC.) FITTINGS ARE EXPRESSLY PROHIBITED FOR BACKBONE AND HORIZONTAL SYSTEM PATHWAYS.
- PROVIDE A PULL STRING IN EMPTY/UNUSED HORIZONTAL DISTRIBUTION CONDUITS AND CONDUITS SERVING AUDIOVISUAL DEVICES SUITABLE FOR A 200 LB PULL TENSION MINIMUM.
- PROVIDE DEDICATED SUPPORTS (e.g., CLIPS & WIRES) FOR CABLE SUPPORT HANGERS (OR SIMILAR PATHWAY COMPONENTS) INTENDED FOR AUDIOVISUAL CABLES. DO NOT SHARE SUPPORTS WITH OTHER TRADES/SYSTEMS.

AUDIOVISUAL CABLING & DEVICES:

- DO NOT TIE THE CABLES TO OTHER STRUCTURES NOT INTENDED FOR THIS SPECIFIC USE. DO NOT TIE THE CABLES TO CABLE TRAY.
- ROUTE AUDIOVISUAL CABLES PERPENDICULAR OR PARALLEL TO BUILDING LINES. ROUTE AUDIOVISUAL CABLES NO LESS THAN 12 INCHES FROM ANY POWER SOURCE OR FLORESCENT LIGHTING FIXTURE, AND NO LESS THAN 4 FEET FROM ANY TRANSFORMER OR MOTOR.
- PROVIDE AUDIOVISUAL CONDUITS FOR CABLING ROUTED THROUGH NON-ACCESSIBLE CEILING SPACE (e.g., "HARD LID" CEILING), UON. SIZE CONDUITS TO MAINTAIN A FILL CAPACITY NO LESS THAN 40% PLUS 50% SPARE CAPACITY.
- INSTALL AUDIOVISUAL DEVICES AT HEIGHTS NOTED ON SYMBOLS LIST AND DEVICE SCHEDULE, UNLESS OTHERWISE SHOWN ON THE DRAWINGS STATED IN SPECIFICATIONS. MOUNTING HEIGHTS ARE FROM FINISHED FLOOR TO THE CENTERLINE OF THE DEVICE. REFER TO ARCHITECTURAL ELEVATION DRAWINGS FOR ADDITIONAL INFORMATION OR EXACT LOCATIONS OF WALL/CEILING/FLOOR MOUNTED DEVICES.
- PROVIDE A 24" MINIMUM SEPARATION BETWEEN "BACK-TO-BACK" TELECOMMUNICATION POWER OR SIGNAL DEVICES IN FRAMED WALLS.
- GROUP AND DRESS EXPOSED AUDIOVISUAL CABLE GROUPS USING VELCRO TIES, UON.

APPLIES TO ALL SHEETS

DRAWING INDEX

SHEET NUMBER	SHEET TITLE	ISSUE LOG										
		REV 1P SUBMITTAL	REV 2P SUBMITTAL	REV 3P SUBMITTAL	REV 4P SUBMITTAL	REV 5P SUBMITTAL	REV 6P SUBMITTAL	REV 7P SUBMITTAL	REV 8P SUBMITTAL	REV 9P SUBMITTAL	REV 10P SUBMITTAL	REV 11P SUBMITTAL
TA-001	AUDIOVISUAL SYMBOLS LIST AND DRAWING INDEX	X	X	X	X	X	X	X	X	X	X	X
TA-002	BACKBOX SCHEDULE AND NOTES	-	-	-	-	X	X	X	X	X	X	X
TA-011	AUDIOVISUAL RISER DIAGRAMS	-	-	X	X	X	X	X	X	X	X	X
TA-101	LEVEL 1 AUDIOVISUAL OVERALL FLOOR PLAN	X	X	X	X	X	X	X	X	X	X	X
TA-102	LEVEL 2 AUDIOVISUAL OVERALL FLOOR PLAN	X	X	X	X	X	X	X	X	X	X	X
TA-103	LEVEL 3 AUDIOVISUAL OVERALL FLOOR PLAN	X	X	X	X	X	X	X	X	X	X	X
TA-103A	LEVEL 3 AUDIOVISUAL OVERALL FLOOR PLAN	-	-	-	-	-	-	-	-	-	X	X
TA-201	LEVEL 1 AUDIOVISUAL OVERALL R C P	-	-	X	X	X	X	X	X	X	X	X
TA-202	LEVEL 2 AUDIOVISUAL OVERALL R C P	-	-	X	X	X	X	X	X	X	X	X
TA-203	LEVEL 3 AUDIOVISUAL OVERALL R C P	-	-	X	X	X	X	X	X	X	X	X
TA-401	SECTIONS AND ELEVATIONS	-	-	X	X	X	X	X	X	X	X	X
TA-501	AUDIOVISUAL DETAILS	X	X	X	X	X	X	X	X	X	X	X
TA-502	AUDIOVISUAL DETAILS	-	-	-	-	-	-	-	-	-	X	X

ISSUE LOG KEY:

* X * ISSUED AS PART OF A SET
 * - * NOT A PART OF ISSUED SET

ABBREVIATIONS

AFF ABOVE FINISHED FLOOR	MSW MULTI-MEDIA SWITCHER
AFT AM/FM TUNER	MTX MATRIX SWITCHER
AMP AUDIO AMPLIFIER	NET NETWORK WIRELESS ACCESS POINT
ANT ANTENNA	NIC NOT IN CONTRACT
APB AUDIO PATCH BAY	NTS NOT TO SCALE
ATC AUDIO CONFERENCE UNIT	OFE OWNER FURNISHED EQUIPMENT
AVC AUDIOVISUAL CONTRACTOR	OFU OWNER FURNISHED OWNER INSTALLED
AVS AUDIO/VIDEO SWITCHER	OPJ OVERHEAD PROJECTOR
BFC BELOW FINISHED CEILING	PJS PROJECTION SCREEN
CAS CASSETTE DECK	PSU POWER SUPPLY
CCD CLOSED CAPTIONING DECODER	RGB HI-RES COMPUTER SIGNAL
CCP CD/CASSETTE PLAYER	SCN SCAN CONVERTER
CDP COMPACT DISC PLAYER	SCR SCALER
CPU CENTRAL PROCESSING UNIT	SPU SLIDE PROJECTOR
CSI CONTROL SYSTEM INTERFACE	SPK LOUDSPEAKER
CSP CONTROL SYSTEM PROCESSOR	SRP SURROUND PROCESSOR
CSS CONTROL SYSTEM SENSOR	SRT SATELLITE RECEIVER TUNER
CTLB CONTROL SYSTEM BUSS STRIP	SW SWITCHER
CTLR CONTROLLER	TBK TERMINATION BLOCK
DA DISTRIBUTION AMPLIFIER	TBO TO BE DETERMINED
DOC VIDEO DOCUMENT CAMERA	TDS TREND DATA SERVER
DSP DIGITAL SIGNAL PROCESSOR	TP CONTROL TOUCH PANEL
DTC DATA TELECOMMUNICATION CONTRACTOR	TR TELECOMMUNICATION ROOM
DVD DIGITAL VIDEO DISC PLAYER	TS TERMINAL STRIP
EC ELECTRICAL CONTRACTOR	TVT TV/RF TUNER
FPD FLAT PANEL DISPLAY	UON UNLESS OTHERWISE NOTED
GC GENERAL CONTRACTOR	USB UNIVERSAL SERIAL BUS
HDP HIGH-DEF PLAYER	VCA VOLTAGE CONTROLLED AMPLIFIER
HST HAND/HEAD SET	VCR VIDEO CASSETTE RECORDER
IAA INTEGRATED AUDIO AMPLIFIER	VDC VCR/DVD COMBO
IFP INTERFACE PANEL	VDP VIDEO PROCESSOR
IG ISOLATED GROUND	VOL VOLUME CONTROL
IRD INFRARED DISPLAY	VPJ VIDEO PROJECTOR
JBX JUNCTION BOX	VSW VIDEO SWITCHER
KVM KEYBOARD/VIDEO/MOUSE	WAP WIRELESS ACCESS POINT
MIC MICROPHONE	WRX WIRELESS RECEIVER
MIX MIXER	WTP WIRELESS TOUCH PANEL
MON MONITOR	WTX WIRELESS TRANSMITTER

WRNSSTUDIO, LP

801 SECOND STREET
 4TH FLOOR, STE. 402
 SAN FRANCISCO
 CALIFORNIA 94107
 415.489.2224 TEL
 415.358.9100 FAX
 WWW.WRNSSTUDIO.COM

Steinberg Architects

Hensel Phelps Construction Co.

DECKER ELECTRIC

TELECOM DESIGN GROUP

NO.	ISSUES/REVISIONS	DATE
1	100% SCHEMATIC DESIGN SUBMITTAL	04/28/08
2	50% DESIGN DEVELOPMENT SUBMITTAL	06/13/08
3	100% DESIGN DEVELOPMENT SUBMITTAL	07/28/08
4	DSA INCREMENT #1 SITE DEMOLITION, EXCAVATION, ROUGH GRADING & UTILITIES	09/25/08
5	INCREMENT 2 80% REVIEW	10/10/08
6	DSA INCREMENT #2 STRUCTURE & SPRIG PANELS	11/11/08
7	DSA INCREMENT #3 50% REVIEW	11/11/08
8	DSA INCREMENT #1 BACK CHECK	11/19/08
9	DSA INCREMENT #3 90% REVIEW	12/19/08
10	DSA INCREMENT #3 TENANT IMPROVEMENT & ROOFING SYSTEM	02/09/09
11	DSA INCREMENT #2 BACK-CHECK	03/11/09
12	DSA INCREMENT #3 BACK-CHECK	05/12/09
13	PROJECT RECORD SET	01/31/11

PROJECT RECORD SET

SKYLINE COLLEGE CIP2 DESIGN-BUILD BUILDING 4N

PROJECT NO.: 01/31/11
 DATE: 01/31/11
 SCALE: NONE

AUDIOVISUAL SYMBOLS LIST AND DRAWING INDEX

SHEET NO.: TA-001

AUDIOVISUAL BACKBOX SCHEDULE

SOME OF THESE SYMBOLS SHOWN MAY NOT BE USED ON THIS PROJECT

SYMBOL	DESCRIPTION	PATHWAY FEED	COMMENTS	DEVICE BOX	RING	COMMENTS	MOUNTING	COMMENTS	FACEPLATE	COMMENTS	NOTES
	CEILING BOX FOR SKYTRON CAMERA		-	1 GANG, 2 1/2" DEEP	-	2	IN-CEILING	-	-	-	SEE DETAIL 12, SHEET TA-501
	CEILING BOX FOR PROJECTOR		1.a	2 GANG, 2 1/2" DEEP	-	2	IN-CEILING	6, 9	-	-	SEE DETAIL 2, SHEET TA-501
	AV FLOOR BOX		1.a	SEE SPECIFICATIONS	-	2	IN FLOOR	4, 7, 8	-	-	SEE DETAIL 7, SHEET TA-501
	AV POKE-THRU		-	SEE SPECIFICATIONS	-	2	IN FLOOR	4, 7, 8	-	-	SEE DETAIL 8, SHEET TA-501
	BACKCAN FOR CEILING MOUNTED LOUDSPEAKER		-	SEE SPECIFICATIONS	-	3	IN-CEILING	-	-	-	SEE DETAIL 1, SHEET TA-501
	WALL BOX FOR AUDIO LINES		1.b	3 GANG, 2-1/2" DEEP	-	2	IN WALL AT OUTLET HEIGHT, UON	-	-	-	-
	WALL BOX FOR CAMERA		1.b	2 GANG, 2-1/2" DEEP	-	2	IN WALL AT OUTLET HEIGHT, UON	9	-	-	-
	WALL BOX FOR VIDEO INTERFACE		1.b	2 GANG, 2-1/2" DEEP	-	2	IN WALL AT OUTLET HEIGHT, UON	-	-	-	SEE DETAIL 12, SHEET TA-501
	WALL BOX FOR ELECTRONIC WHITEBOARD		1.b	2 GANG, 2 1/2" DEEP	-	2	IN WALL AT SWITCH HEIGHT, UON	9	-	-	-
	WALL BOX FOR FLAT PANEL DISPLAY		1.a	2 GANG, 2 1/2" DEEP	-	2	IN WALL AT SWITCH HEIGHT, UON	9	-	-	SEE DETAIL 5, SHEET TA-501
	WALL BOX FOR INTERFACE PLATE		1.a	2 GANG, 2-1/2" DEEP	-	2	IN WALL AT SWITCH HEIGHT, UON	9	-	-	-
	WALL BOX FOR PROJECTION SCREEN CONTROLLER		1.a	1 GANG, 2 1/2" DEEP	-	2	IN WALL AT SWITCH HEIGHT, UON	-	-	-	-
	WALL BOX FOR VOLUME CONTROL		1.a	1 GANG, 2 1/2" DEEP	-	2	IN WALL AT SWITCH HEIGHT, UON	-	-	-	-
	WALL BOX FOR CAMERA WALL CONTROL		1.b	CUSTOM BOX FROM SKYTRON	-	2	IN WALL AT SWITCH HEIGHT, UON	4	-	-	SEE DETAIL 12, SHEET TA-501
	WALL BOX FOR CONTROL PANEL		-	TO BE DETERMINED	-	-	IN WALL AT SWITCH HEIGHT, UON	-	-	-	-
	WALL BOX FOR SCREEN CONTROL		1.b	1 GANG, 2 1/2" DEEP	-	2	ON WALL ABOVE CEILING, ADJACENT TO PROJECTION SCREEN	-	-	-	-
	CEILING BOX FOR (FUTURE) FLAT PANEL DISPLAY		-	2 GANG, 2 1/2" DEEP	-	2	IN-CEILING	6, 9	-	-	-

NUMBERED COMMENTS

1. ELECTRICAL CONTRACTOR SHALL PROVIDE:
 - a. DEVICE BOX AND CONTINUOUS CONDUIT FROM BOX TO TERMINAL PANEL (WB-TP) OR FLOOR BOX (FB-INT)
 - b. CONDUIT STUB WITH PULL STRING FROM CEILING SPACE DOWN WALL TO DEVICE BOX
 - c. CONDUIT TO DAISY-CHAIN FROM BOX TO BOX
2. ELECTRICAL CONTRACTOR SHALL PROVIDE DEVICE BOX AND RING.
3. AUDIOVISUAL CONTRACTOR SHALL PROVIDE DEVICE BOX.
4. DEVICE SHARED WITH ELECTRICAL. REFER TO ELECTRICAL FOR DEVICE TYPE AND INSTALLATION REQUIREMENTS.
5. PROVIDE TWO DUPLEX OUTLETS ADJACENT TO BOX. REFER TO ELECTRICAL DRAWINGS.
6. PROVIDE (2) DATA PORTS ON SINGLE GANG PLATE ADJACENT TO BOX.
7. PROVIDE DUPLEX OUTLET WITHIN BOX. REFER TO ELECTRICAL DRAWINGS.
8. PROVIDE (2) DATA PORTS ON SINGLE GANG PLATE WITHIN BOX.
9. PROVIDE SINGLE DUPLEX OUTLET ADJACENT TO BOX. REFER TO ELECTRICAL DRAWINGS.

GENERAL COMMENTS

- A. CIRCUITS ARE 120 VAC, 60 HZ, 1-PHASE, UNLESS OTHERWISE NOTED.
- B. PROVIDE POWER TO THE AUDIOVISUAL SYSTEMS FROM THE SAME PHASE LEG.
- C. PROVIDE A SEPARATE TRANSFORMER TAP AND SERVICE PANEL TO THE AUDIOVISUAL SYSTEM. DO NOT SHARE POWER WITH LIGHTING AND VARIABLE LOAD DEVICES (I.E.: ELEVATOR MOTORS, WATER HEATERS).
- D. REFER TO FLOOR PLANS FOR DIAGRAMMATIC LAYOUT OF AUDIOVISUAL DEVICES.

WRNSSTUDIO.LP

801 SECOND STREET
4TH FLOOR, STE. 402
SAN FRANCISCO
CALIFORNIA 94107
415.489.2224 TEL
415.358.9100 FAX
WWW.WRNSSTUDIO.COM

Steinberg Architects



NO.	ISSUES/REVISIONS	DATE
1	100% SCHEMATIC DESIGN SUBMITTAL	04/28/08
2	50% DESIGN DEVELOPMENT SUBMITTAL	06/13/08
3	100% DESIGN DEVELOPMENT SUBMITTAL	07/28/08
4	DSA INCREMENT #1: SITE DEMOLITION, EXCAVATION, ROUGH GRADING & UTILITIES	09/25/08
5	INCREMENT 2 80% REVIEW	10/10/08
6	DSA INCREMENT #2: STRUCTURE & GRG PANELS	11/11/08
7	DSA INCREMENT #3 50% REVIEW	11/11/08
8	DSA INCREMENT #1: BACK CHECK	11/18/08
9	DSA INCREMENT #3 90% REVIEW	12/18/08
10	DSA INCREMENT #3: TENANT IMPROVEMENT & ROOFING SYSTEM	02/09/09
11	DSA INCREMENT #2: BACKCHECK	03/11/09
12	DSA INCREMENT #3: BACKCHECK	05/12/09
13	PROJECT RECORD SET	01/31/11


PROJECT RECORD SET

SKYLINE COLLEGE CIP2 DESIGN-BUILD BUILDING 4N


PROJECT NO: DRAWN BY: WAC
DATE: 01/31/11 CHECKED BY: APA
SCALE: NONE

SHEET TITLE: BACKBOX SCHEDULE AND NOTES


SHEET NO: TA-002

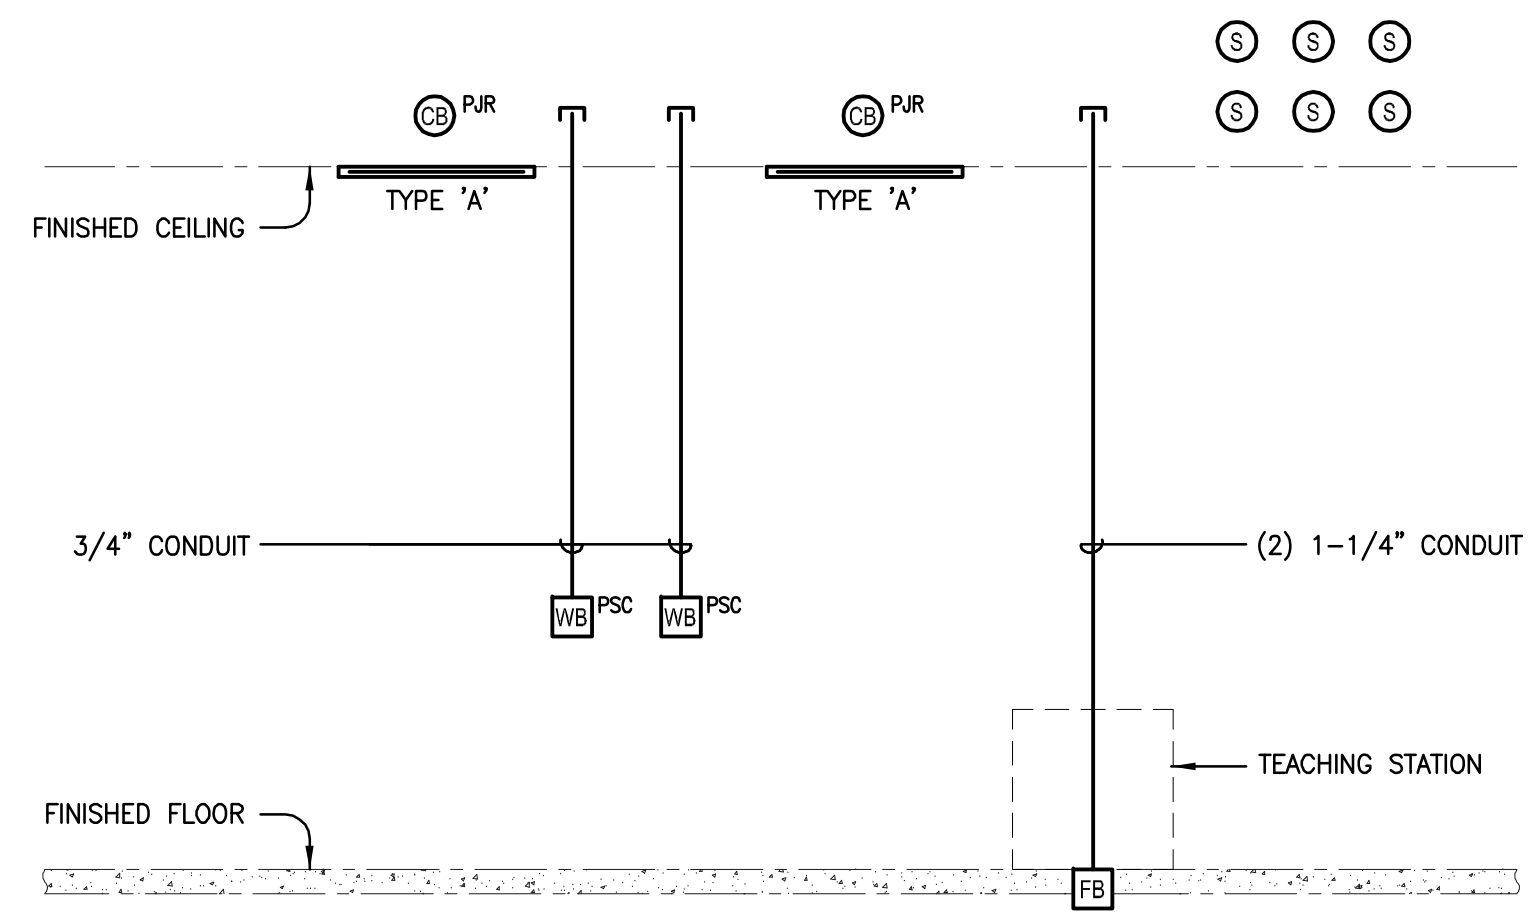


APPLICABLE TO ROOMS: 4-148, 4-170, 4-180

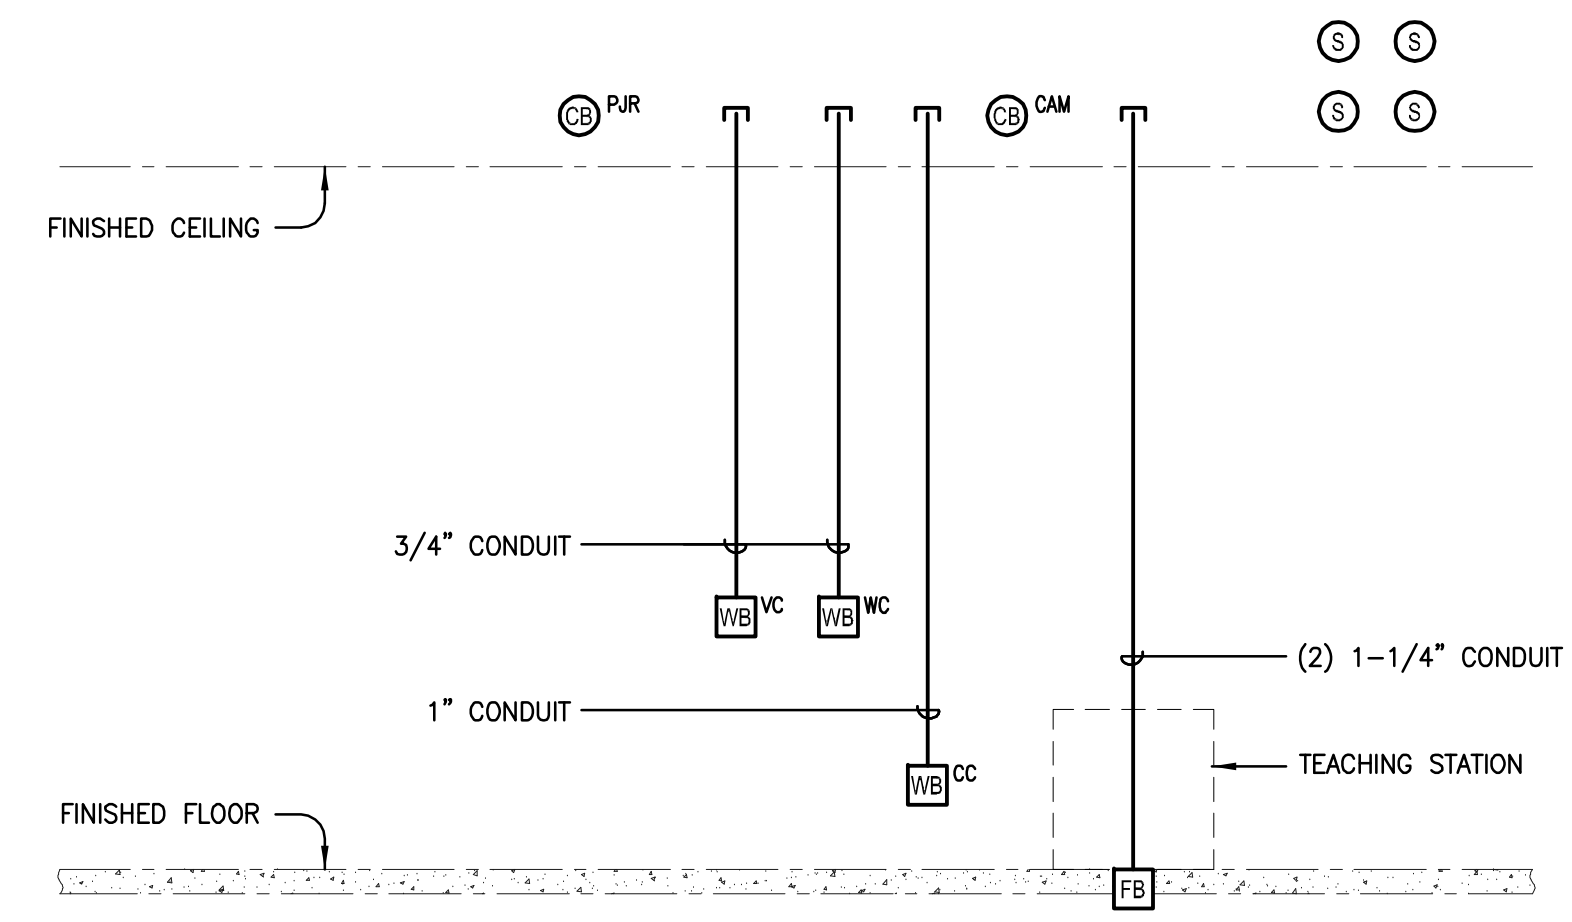

APPLICABLE TO ROOM: 4-102

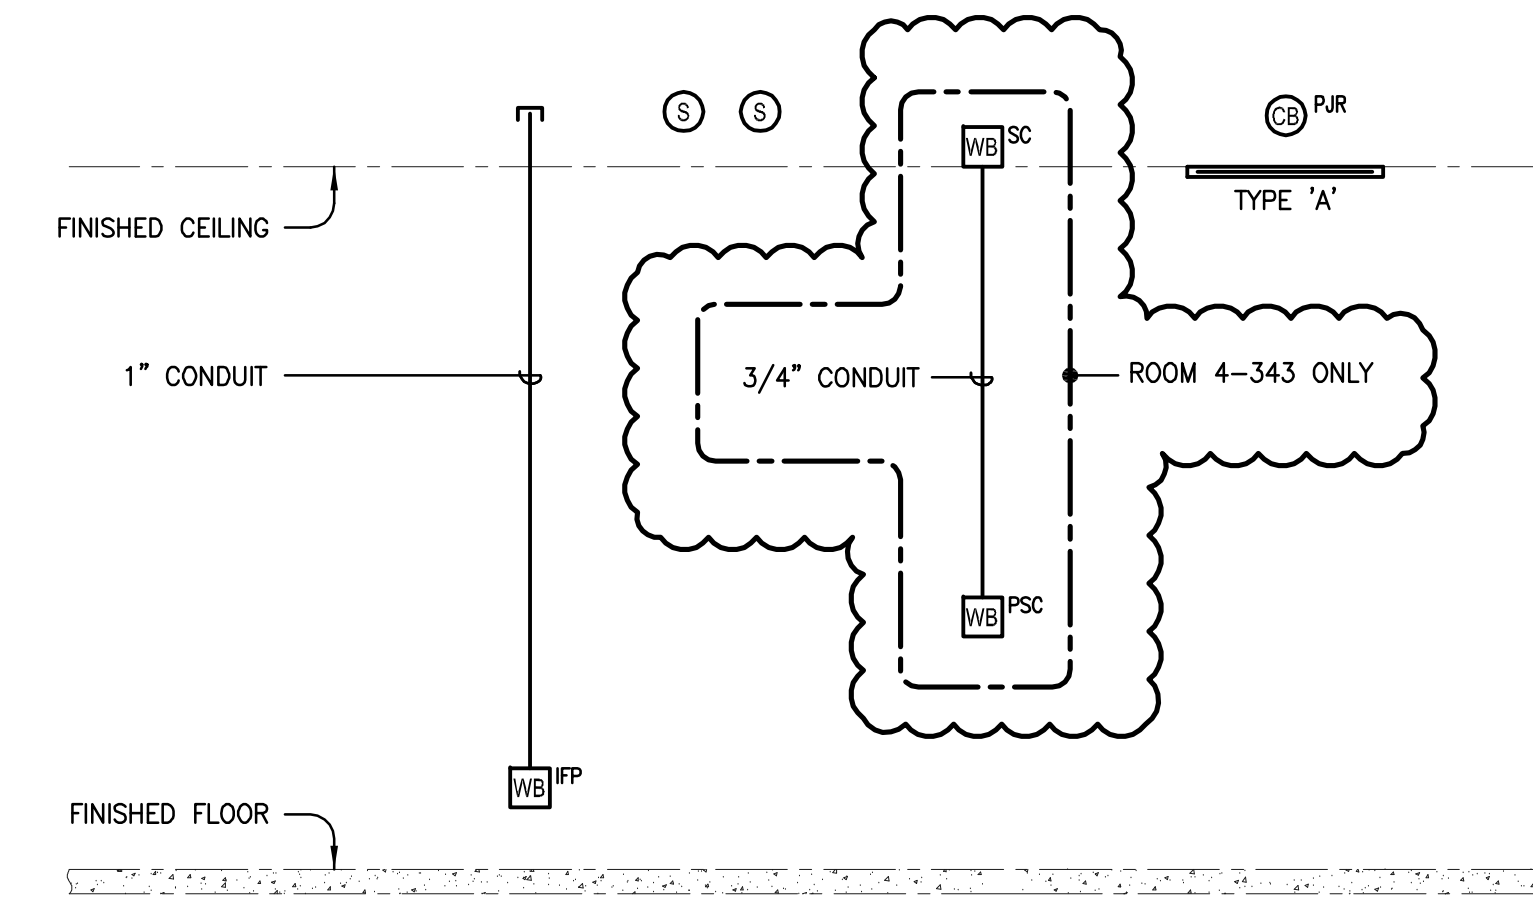

APPLICABLE TO ROOMS: 4-132, 4-343

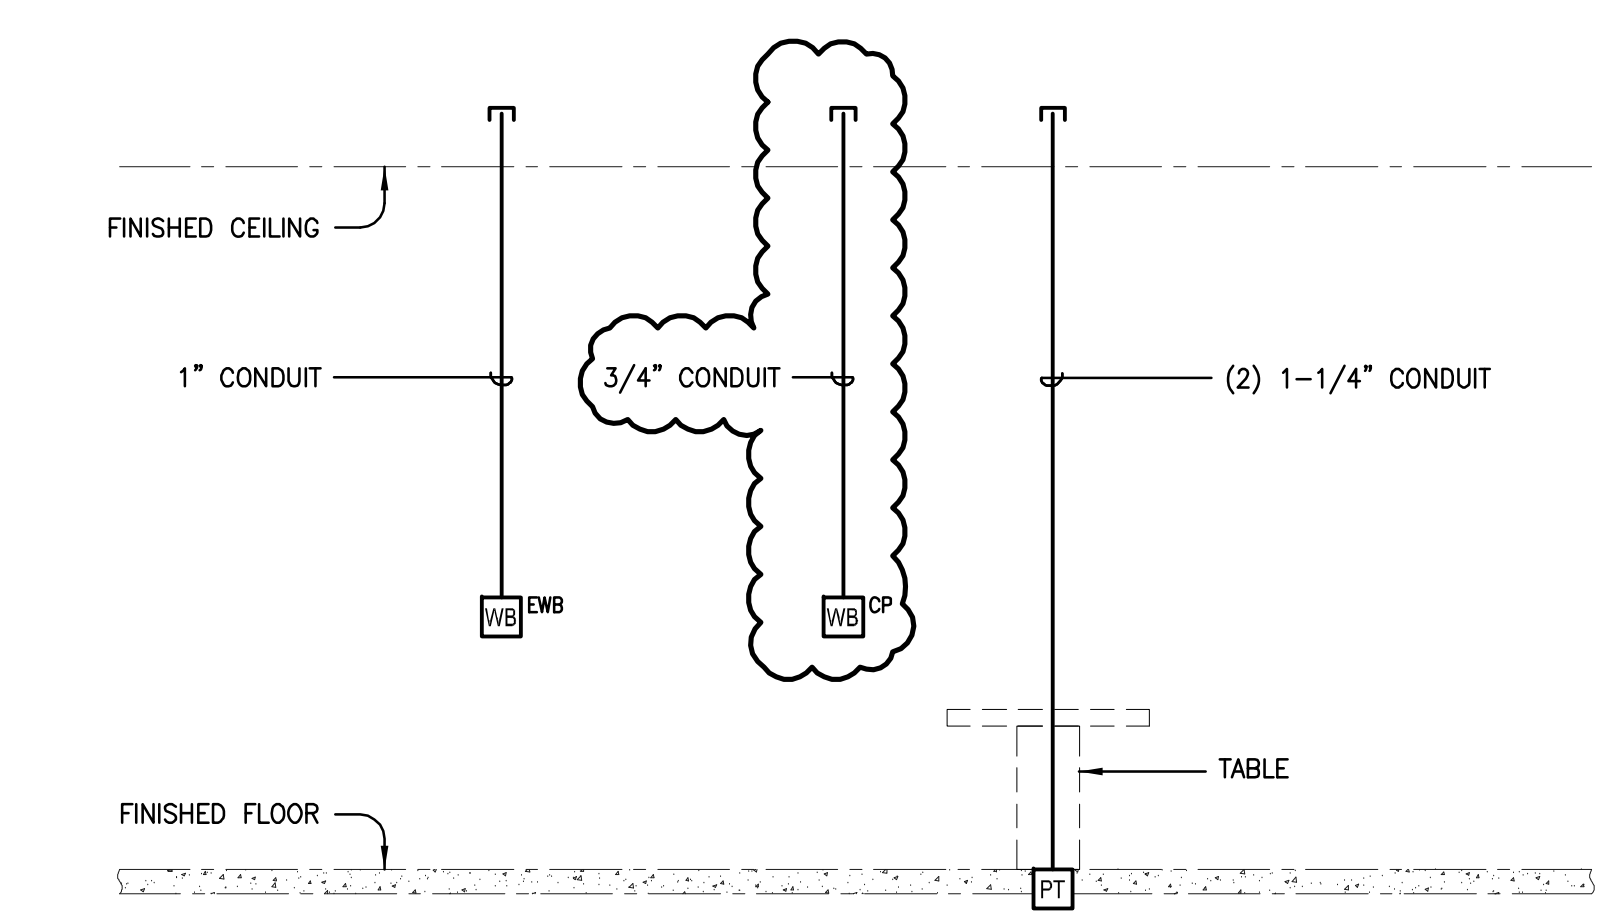


APPLICABLE TO ROOM: 4-318

LARGE CLASSROOMS
SCALE: NTS **1**


MEDIUM CLASSROOM
SCALE: NTS **2**

MEETING ROOMS
SCALE: NTS **3**


PRESIDENT'S OFFICE
SCALE: NTS **4**

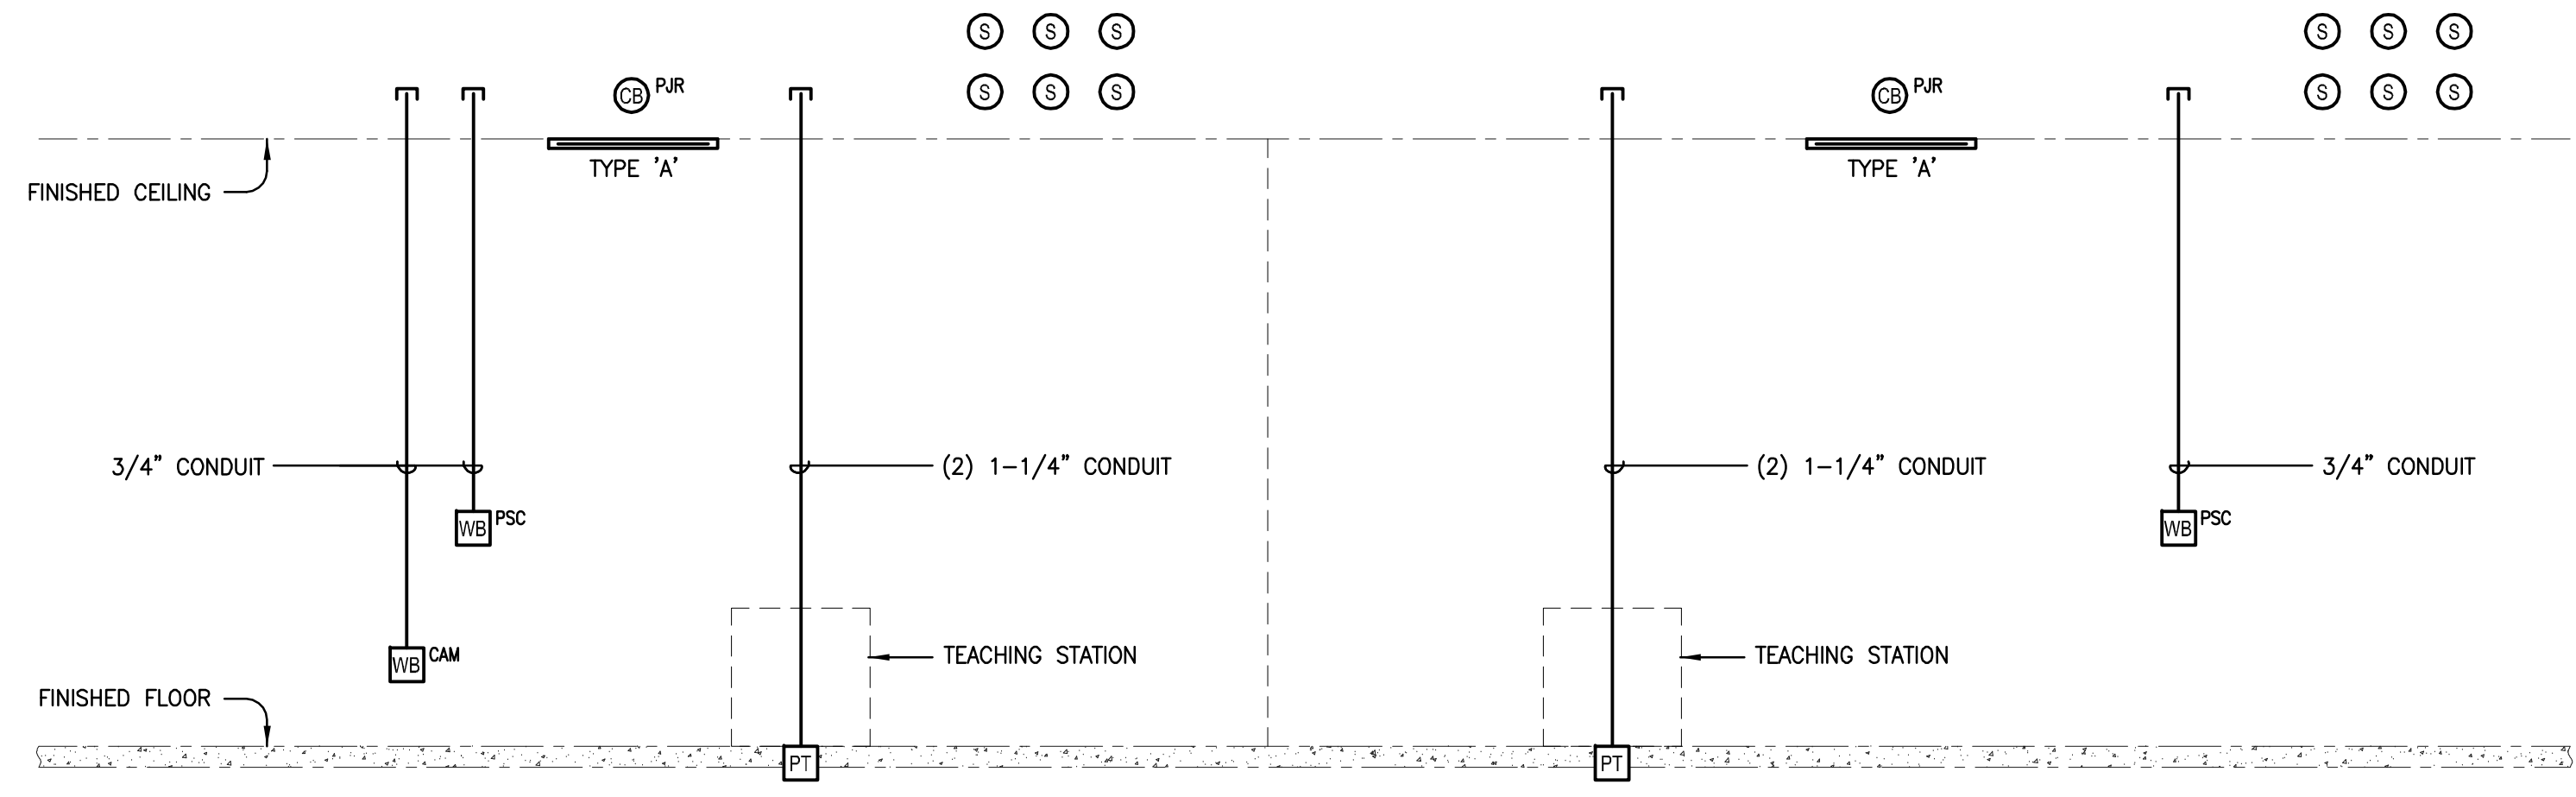

APPLICABLE TO ROOM: 4-201

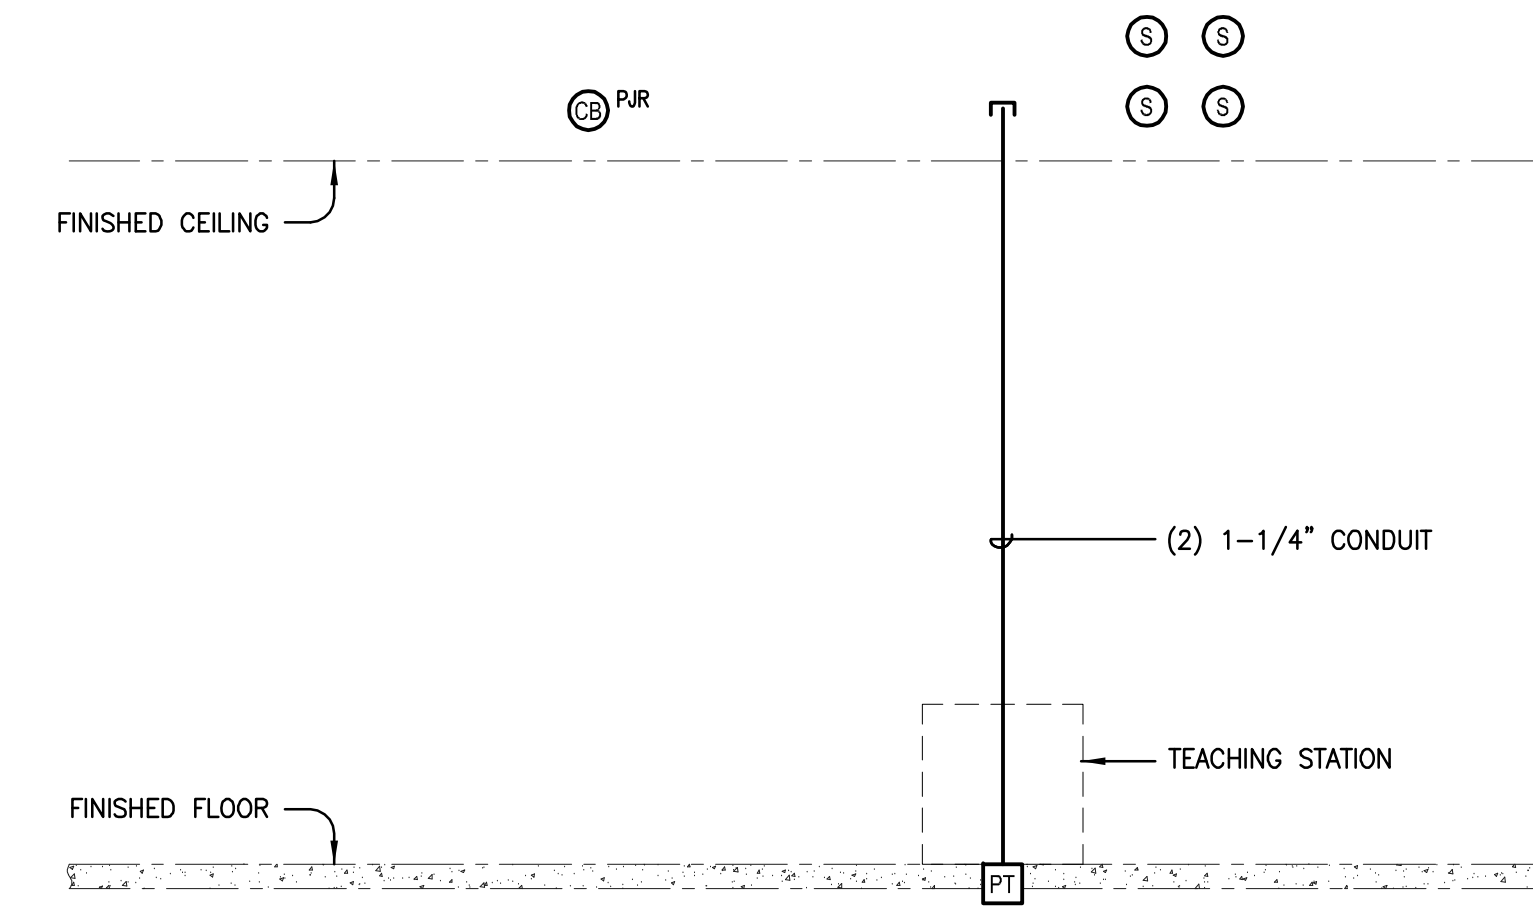

APPLICABLE TO ROOMS: 4-218, 4-271, 4-272, 4-273, 4-274, 4-301

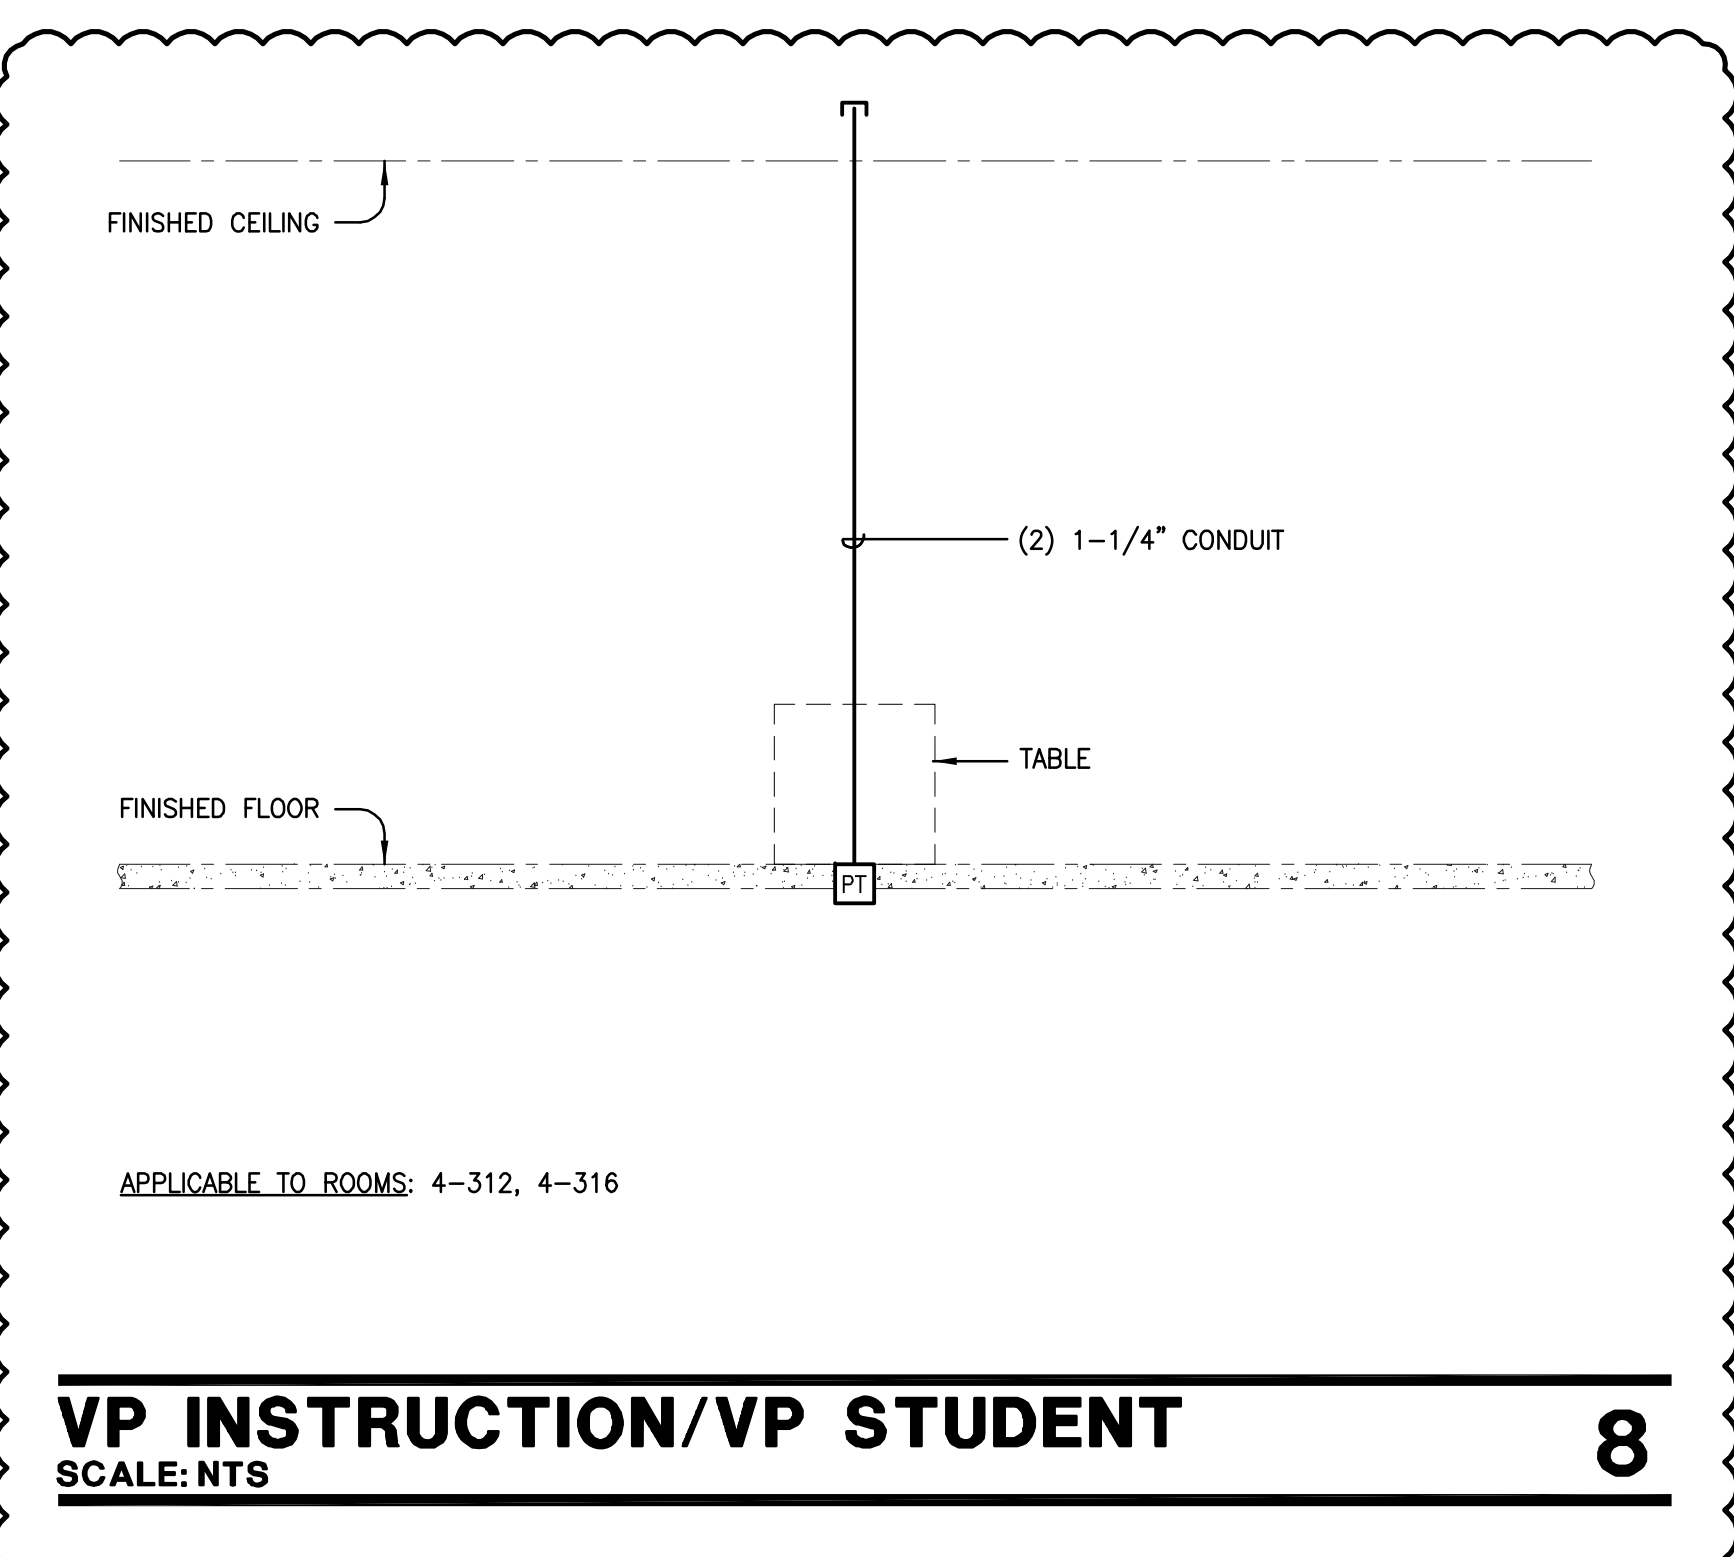


APPLICABLE TO ROOMS: 4-312, 4-316

LARGE CLASSROOM
SCALE: NTS **6**


MEDIUM CLASSROOMS
SCALE: NTS **7**

VP INSTRUCTION/VP STUDENT
SCALE: NTS **8**

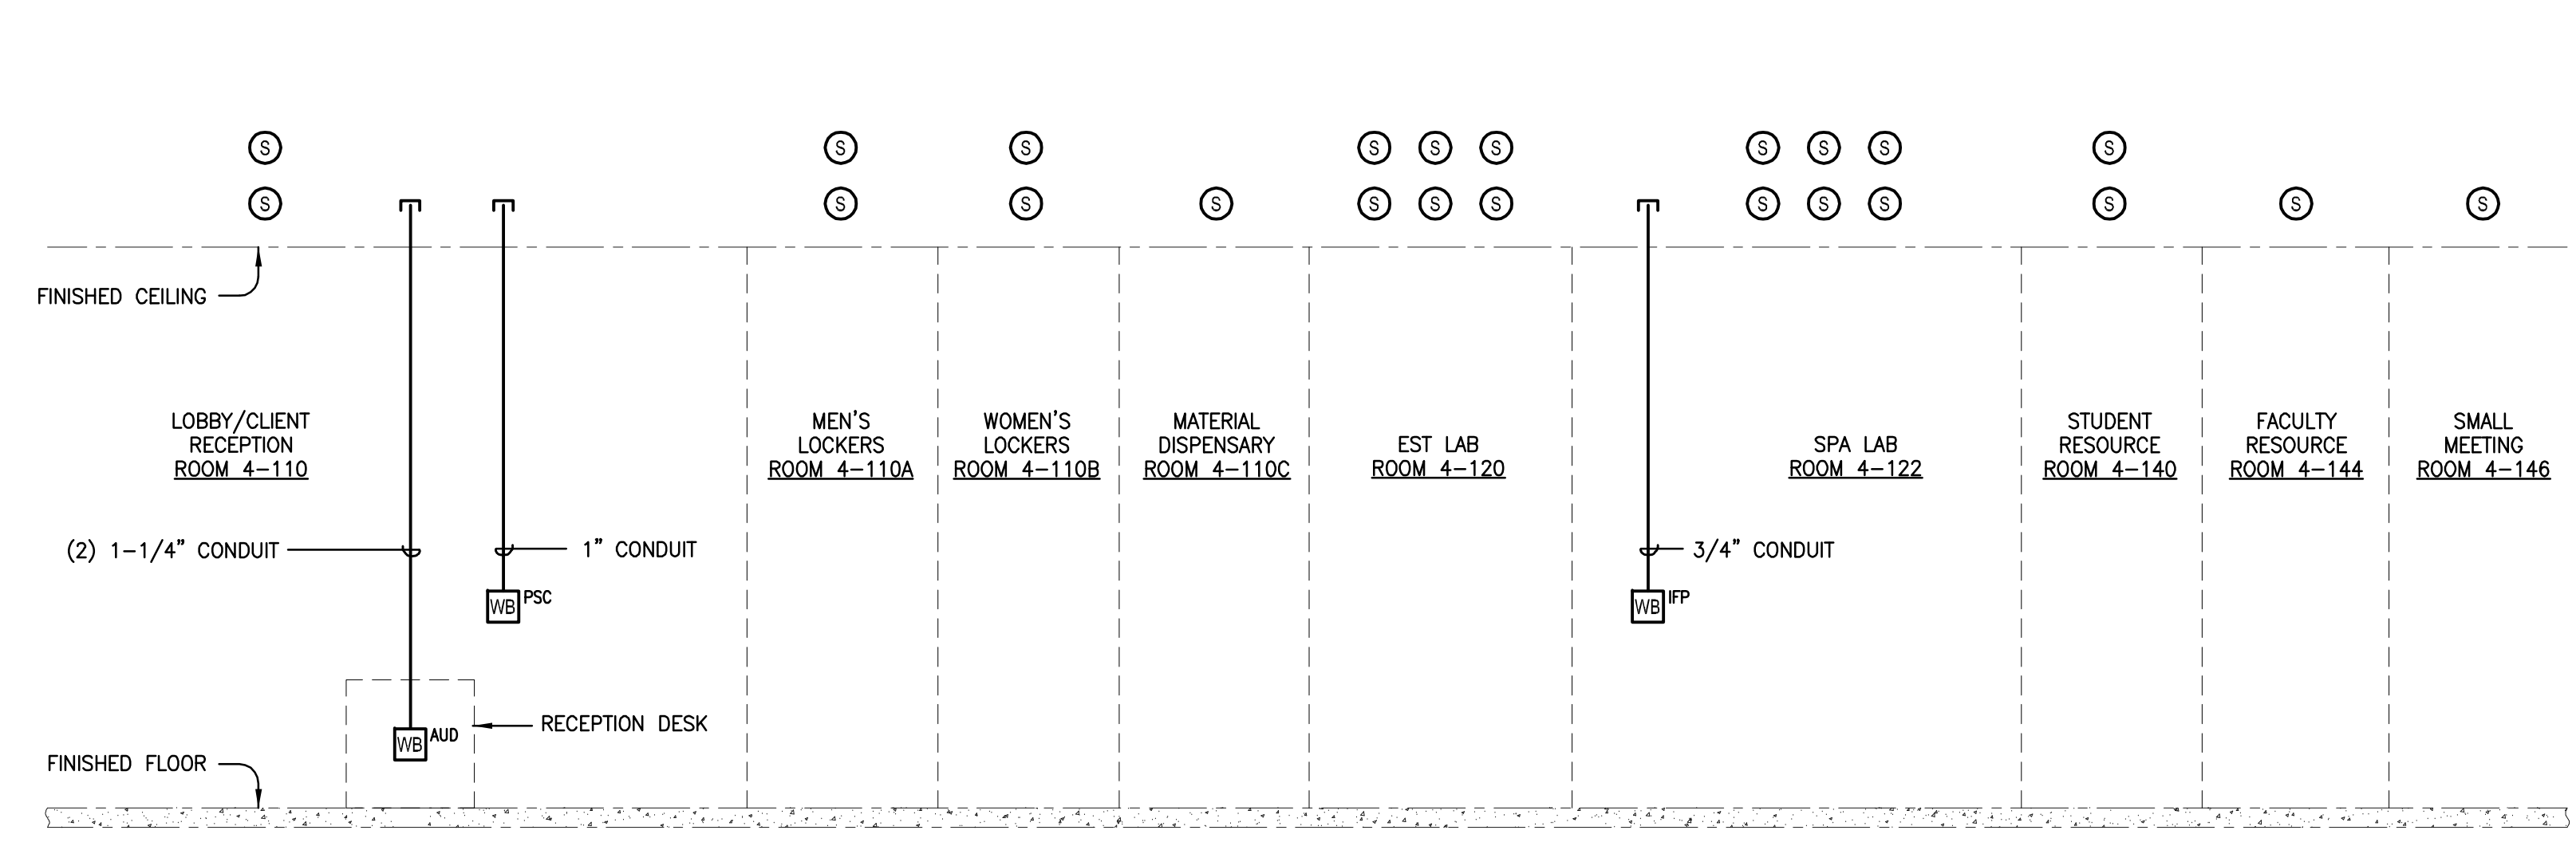

APPLICABLE TO ROOM: AS NOTED

LEVEL 1 - VARIOUS LOCATIONS
SCALE: NTS **10**

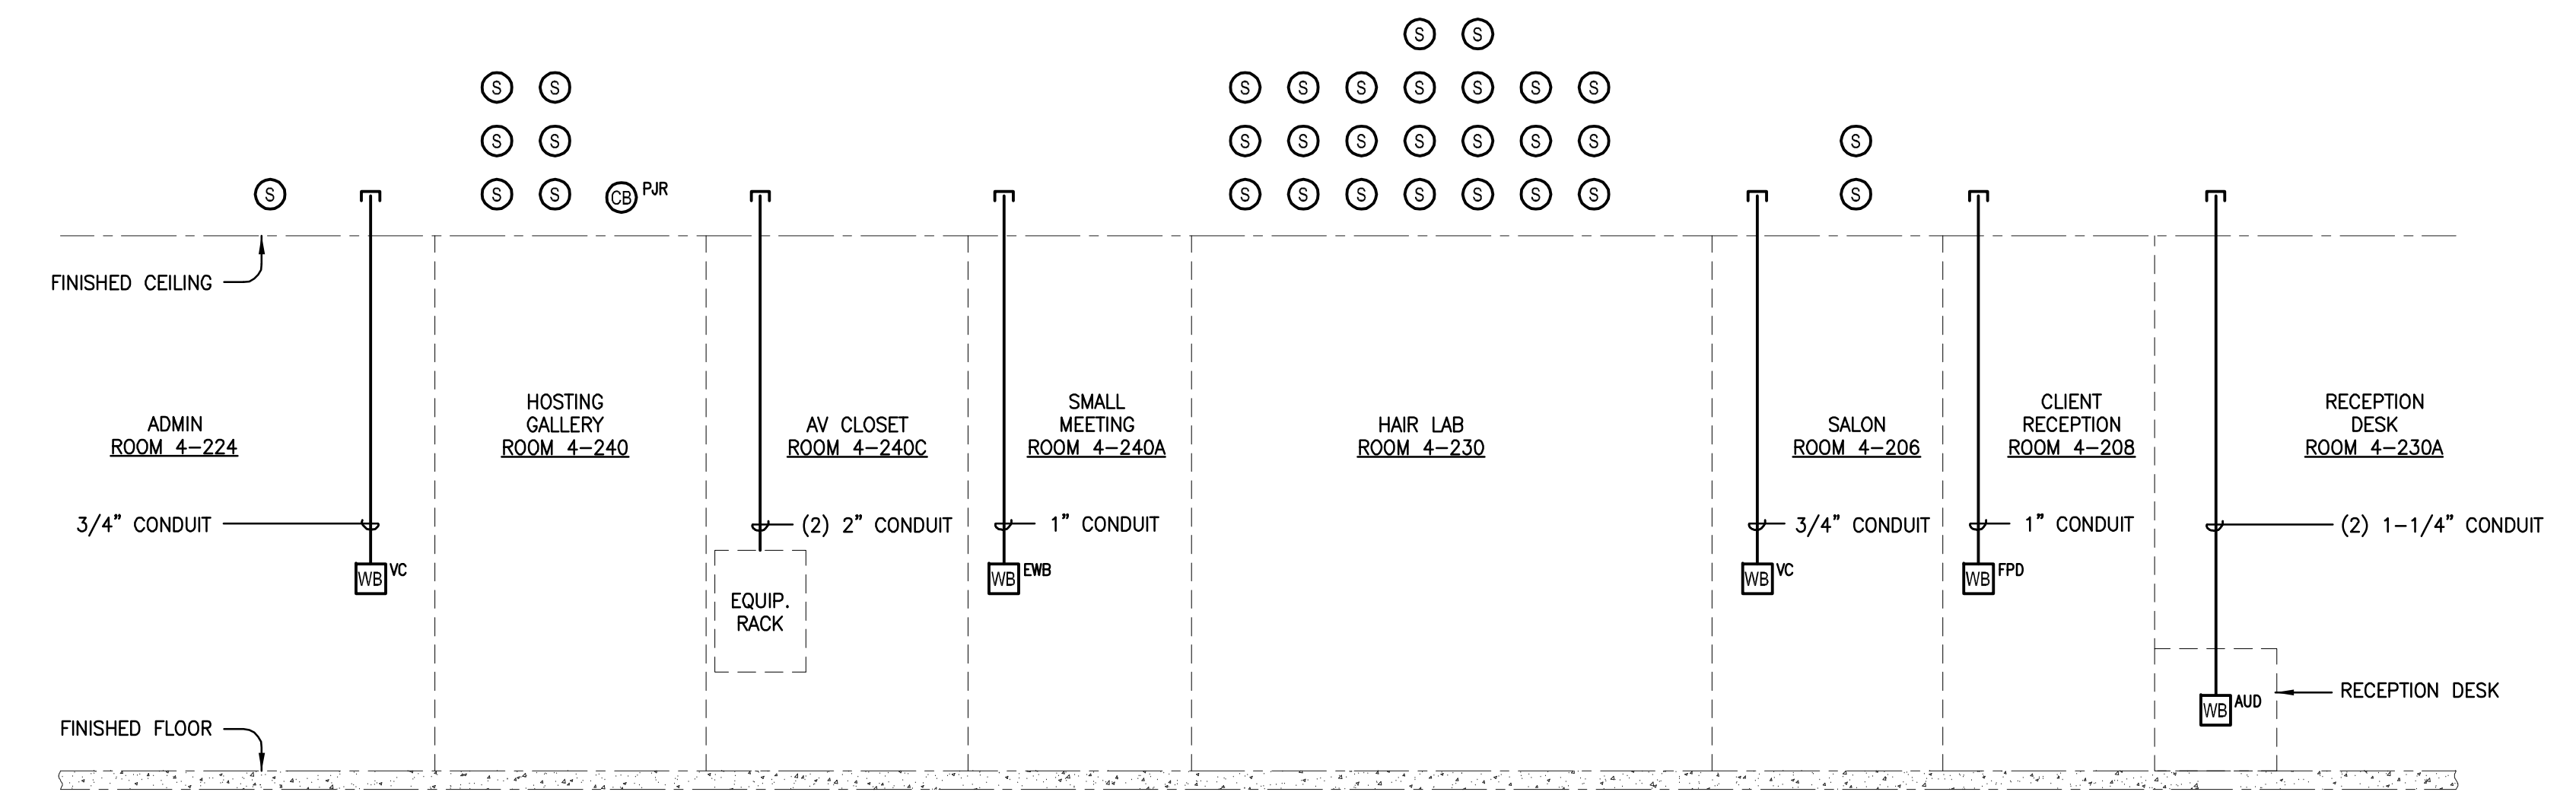

APPLICABLE TO ROOMS: AS NOTED

LEVEL 2 - VARIOUS LOCATIONS
SCALE: NTS **12**

NO.	ISSUES/REVISIONS	DATE
1	100% SCHEMATIC DESIGN SUBMITTAL	04/28/08
2	50% DESIGN DEVELOPMENT SUBMITTAL	06/13/08
3	100% DESIGN DEVELOPMENT SUBMITTAL	07/28/08
4	DSA INCREMENT #1: SITE DEMOLITION, EXCAVATION, ROUGH GRADING & UTILITIES	09/25/08
5	INCREMENT 2 80% REVIEW	10/10/08
6	DSA INCREMENT #2: STRUCTURE & GRC PANELS	11/11/08
7	DSA INCREMENT #3 50% REVIEW	11/11/08
8	DSA INCREMENT #1: BACK CHECK	11/18/08
9	DSA INCREMENT #3: 90% REVIEW	12/18/08
10	DSA INCREMENT #3: TENANT IMPROVEMENT & ROOFING SYSTEM	02/09/09
11	DSA INCREMENT #2: BACKCHECK	03/11/09
12	DSA INCREMENT #3: BACKCHECK	05/12/09
13	PROJECT RECORD SET	01/31/11

PROJECT RECORD SET

**SKYLINE COLLEGE
CIP2 DESIGN-BUILD
BUILDING 4N**


PROJECT NO: DRAWN BY: WAC
DATE: 01/31/11 CHECKED BY: APA
SCALE: NONE

**AUDIOVISUAL
RISER DIAGRAMS**

All drawings and written material appearing herein constitute original and unpublished work of the Architect/Engineer and may not be duplicated, used or disclosed without consent of Architect/Engineer. If this drawing is not 30"x42", then the drawing has been revised from its original size. Noted scales must be adjusted. This line should be equal to one inch.

NUMBERED SHEET NOTES

ELECTRICAL:
E-1 COORDINATE EXACT LOCATION OF WALL BOX WITH OWNER'S REPRESENTATIVE.

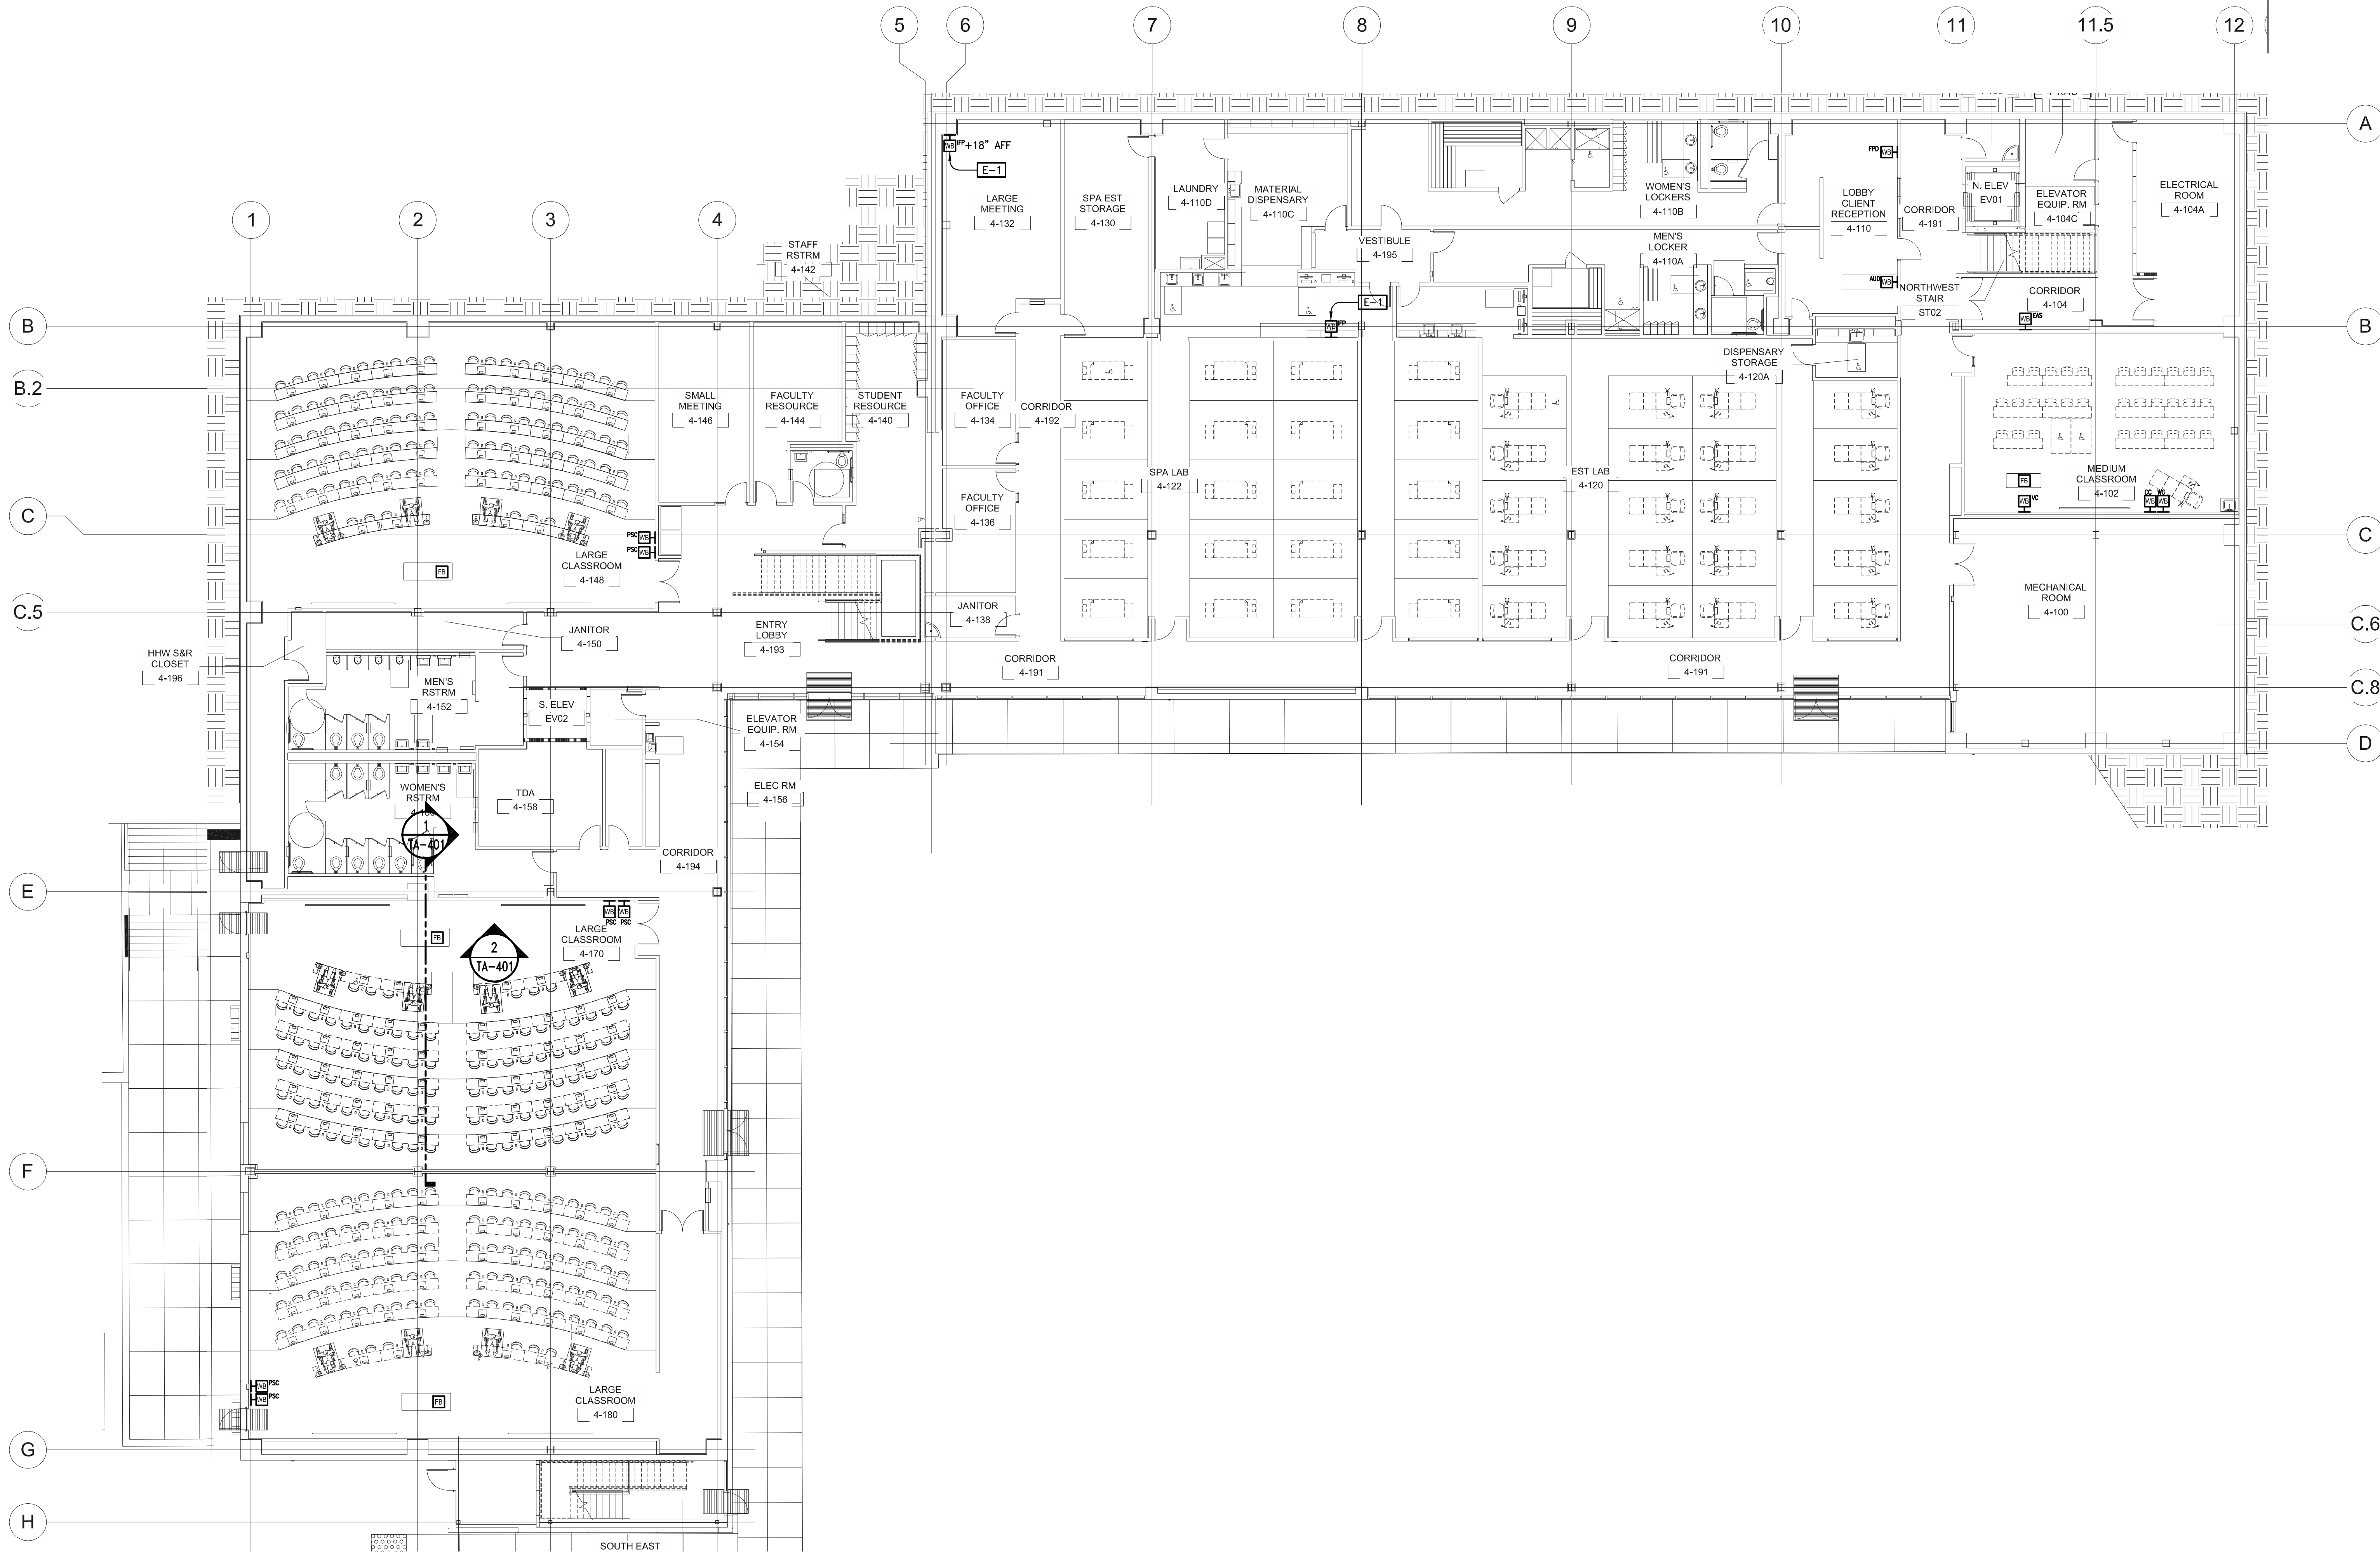

NO.	ISSUES/REVISIONS	DATE
1	100% SCHEMATIC DESIGN SUBMITTAL	04/28/08
2	50% DESIGN DEVELOPMENT SUBMITTAL	06/13/08
3	100% DESIGN DEVELOPMENT SUBMITTAL	07/28/08
4	DSA INCREMENT #1: SITE DEMOLITION, EXCAVATION, ROUGH GRADING & UTILITIES	09/25/08
5	INCREMENT 2 80% REVIEW	10/10/08
6	DSA INCREMENT #2: STRUCTURE & GRG PANELS	11/11/08
7	DSA INCREMENT #3 50% REVIEW	11/11/08
8	DSA INCREMENT #1: BACK CHECK	11/19/08
9	DSA INCREMENT #3: 90% REVIEW	12/18/08
10	DSA INCREMENT #3: TENANT IMPROVEMENT & ROOFING SYSTEM	02/09/09
11	DSA INCREMENT #2: BACK-CHECK	03/11/09
12	DSA INCREMENT #3: BACK-CHECK	05/12/09
13	PROJECT RECORD SET	01/31/11

PROJECT RECORD SET


SKYLINE COLLEGE CIP2 DESIGN-BUILD BUILDING 4N

PROJECT NO.:
 DATE: 01/31/11
 SCALE: 3/32" = 1'-0"

DRAWN BY: WAC
 CHECKED BY: APA

LEVEL 1 AUDIOVISUAL OVERALL FLOOR PLAN


SHEET NO.: TA-101

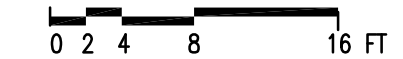

All drawings and written material appearing herein constitute original and unpublished work of the Architect/Engineer and may not be duplicated, used or disclosed without consent of Architect/Engineer.
 If this drawing is not 30"x42", then the drawing has been revised from its original size. Noted scales must be adjusted. This line should be equal to one inch.

NUMBERED SHEET NOTES

ELECTRICAL:
E-1 COORDINATE EXACT LOCATION OF WALL BOX WITH OWNER'S REPRESENTATIVE.

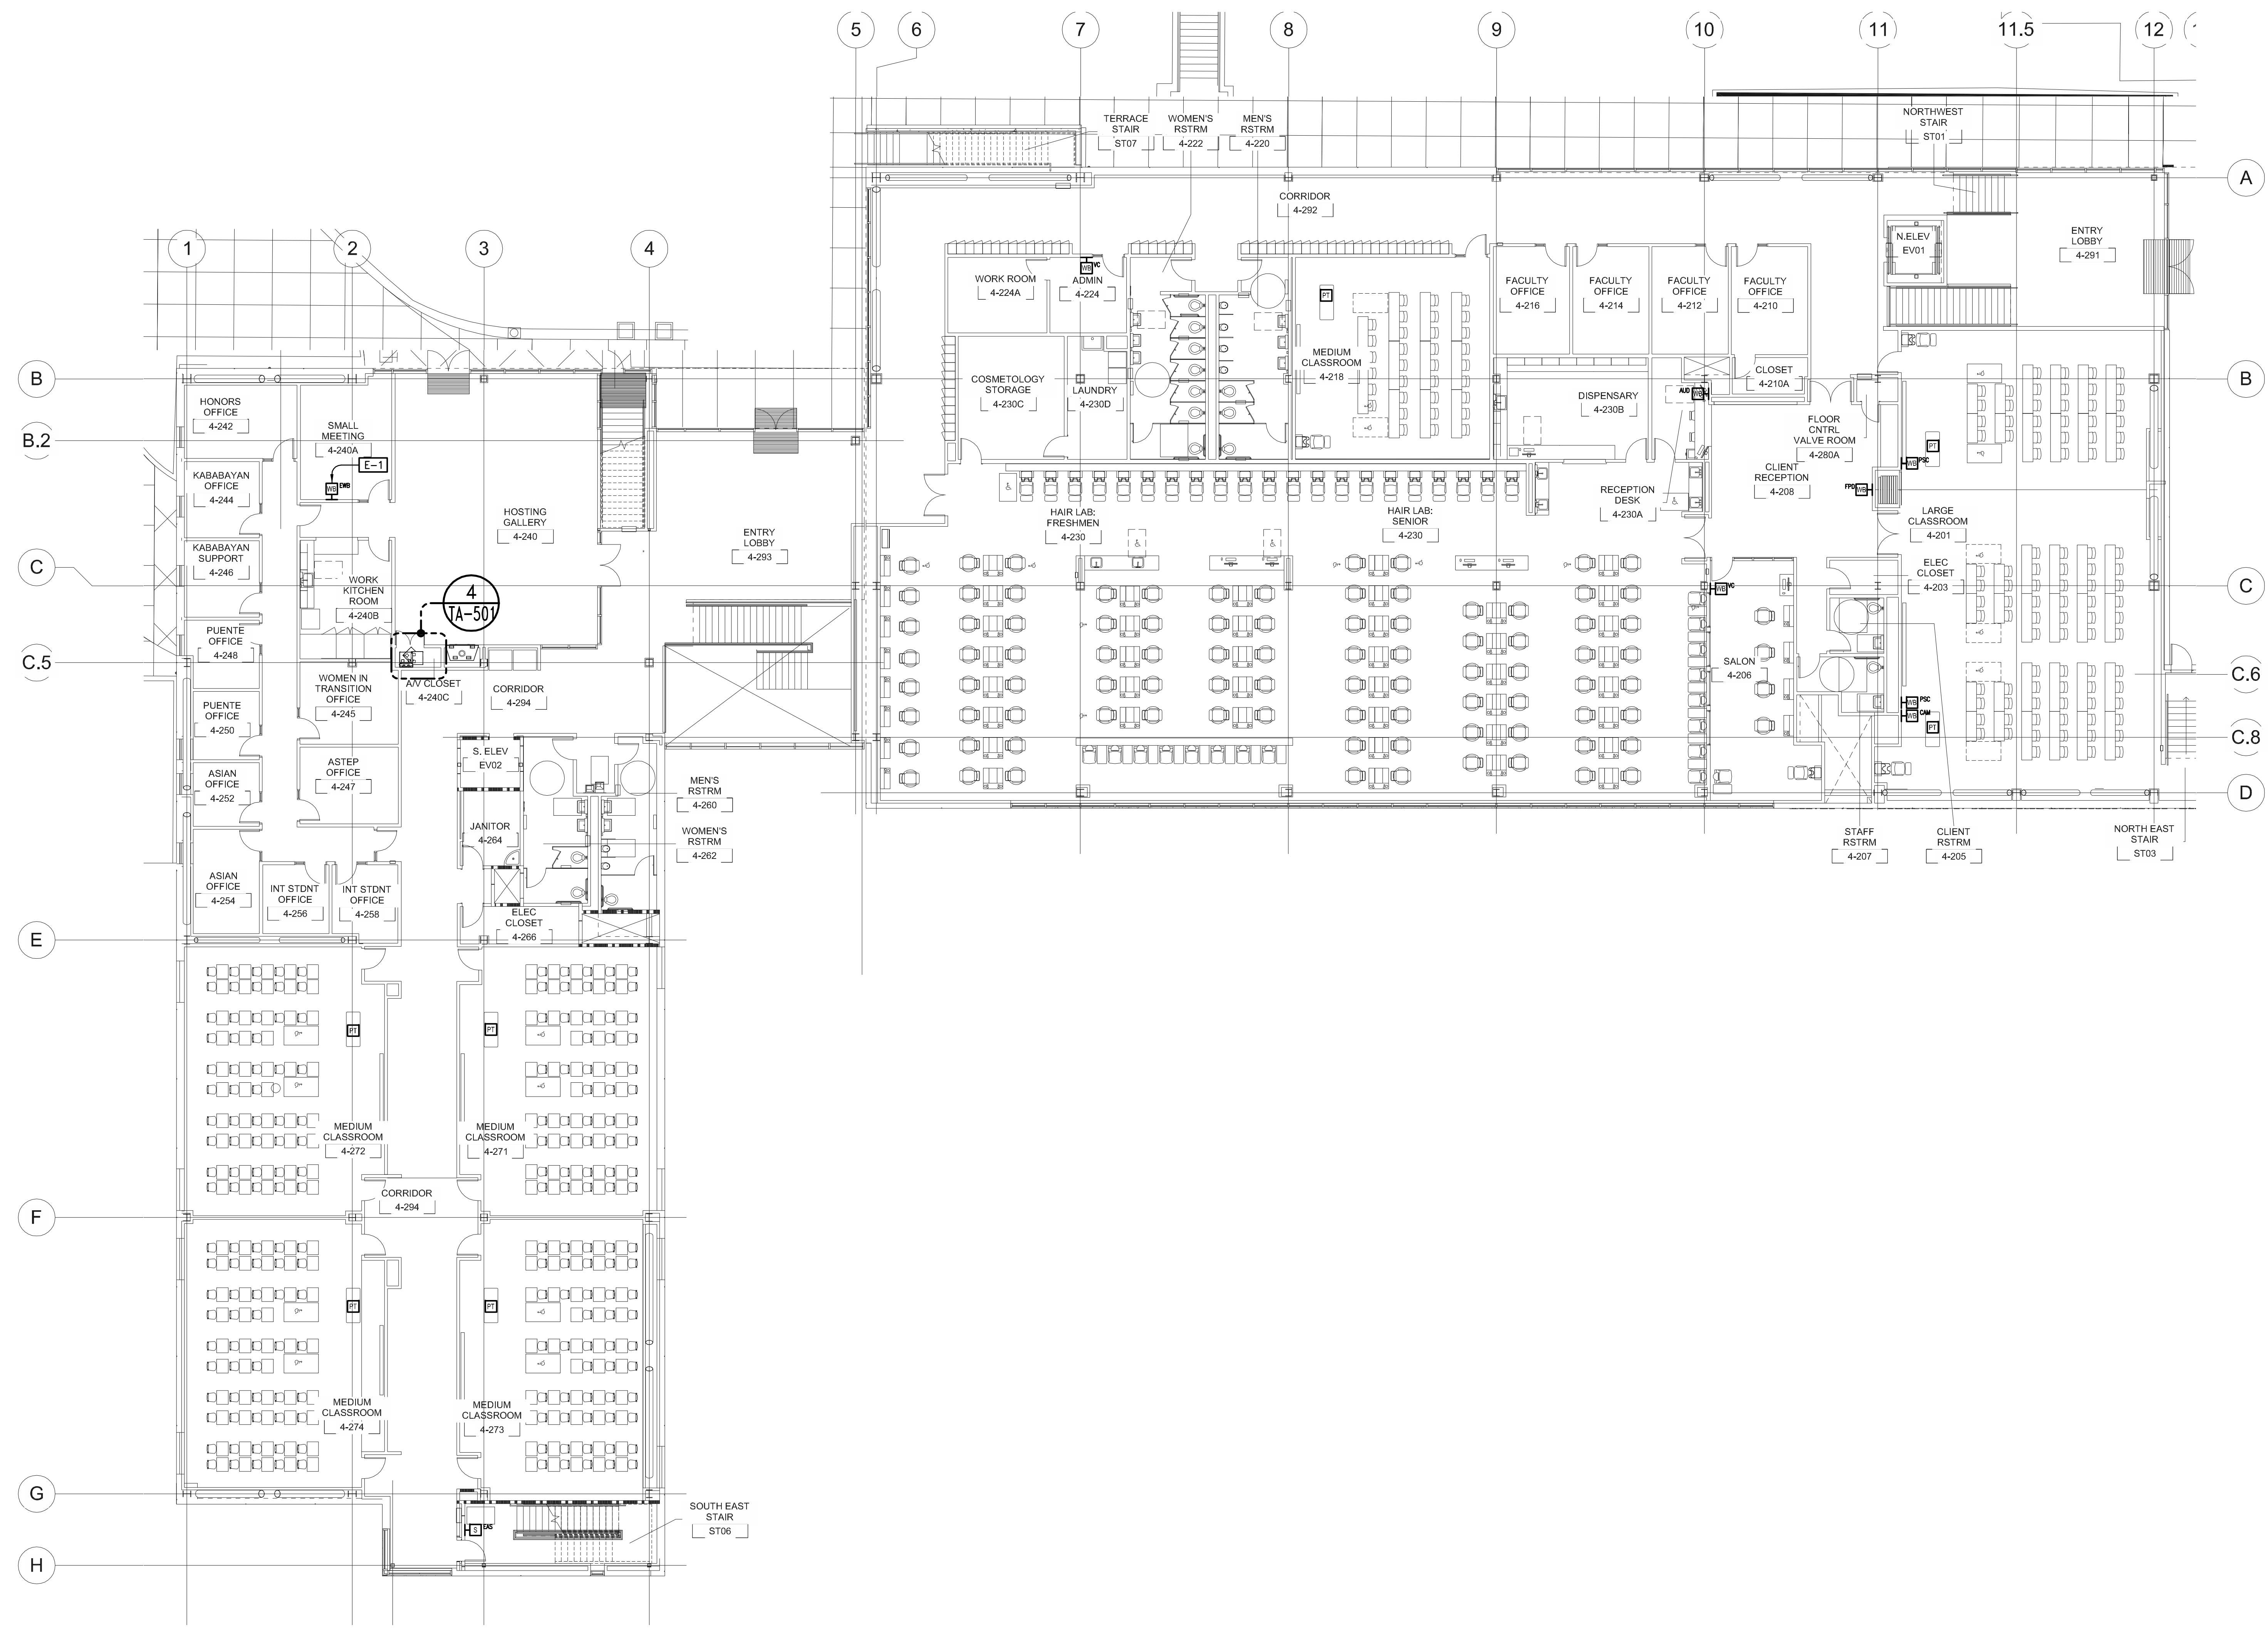

NO.	ISSUES/REVISIONS	DATE
1	100% SCHEMATIC DESIGN SUBMITTAL	04/28/08
2	50% DESIGN DEVELOPMENT SUBMITTAL	06/13/08
3	100% DESIGN DEVELOPMENT SUBMITTAL	07/28/08
4	DSA INCREMENT #1: SITE DEMOLITION, EXCAVATION, ROUGH GRADING & UTILITIES	09/25/08
5	INCREMENT 2 80% REVIEW	10/10/08
6	DSA INCREMENT #2: STRUCTURE & GRG PANELS	11/11/08
7	DSA INCREMENT #3 50% REVIEW	11/11/08
8	DSA INCREMENT #1: BACK CHECK	11/18/08
9	DSA INCREMENT #3: 90% REVIEW	12/18/08
10	DSA INCREMENT #3: TENANT IMPROVEMENT & ROOFING SYSTEM	02/09/09
11	DSA INCREMENT #2: BACK-CHECK	03/11/09
12	DSA INCREMENT #3: BACK-CHECK	05/12/09
13	PROJECT RECORD SET	01/31/11


PROJECT RECORD SET

SKYLINE COLLEGE CIP2 DESIGN-BUILD BUILDING 4N

PROJECT NO.: DRAWN BY: WAC
 DATE: 01/31/11 CHECKED BY: APA
 SCALE: 3/32" = 1'-0"

LEVEL 2 AUDIOVISUAL OVERALL FLOOR PLAN


SHEET NO.: TA-102

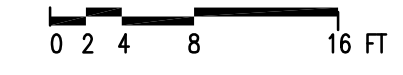

All drawings and written material appearing herein constitute original and unpublished work of the Architect/Engineer and may not be duplicated, used or disclosed without consent of Architect/Engineer.
 If this drawing is not 30"x42", then the drawing has been revised from its original size. Noted scales must be adjusted. This line should be equal to one inch.

NUMBERED SHEET NOTES

ELECTRICAL:
 [E-1] COORDINATE EXACT LOCATION OF WALL BOX WITH OWNER'S REPRESENTATIVE.

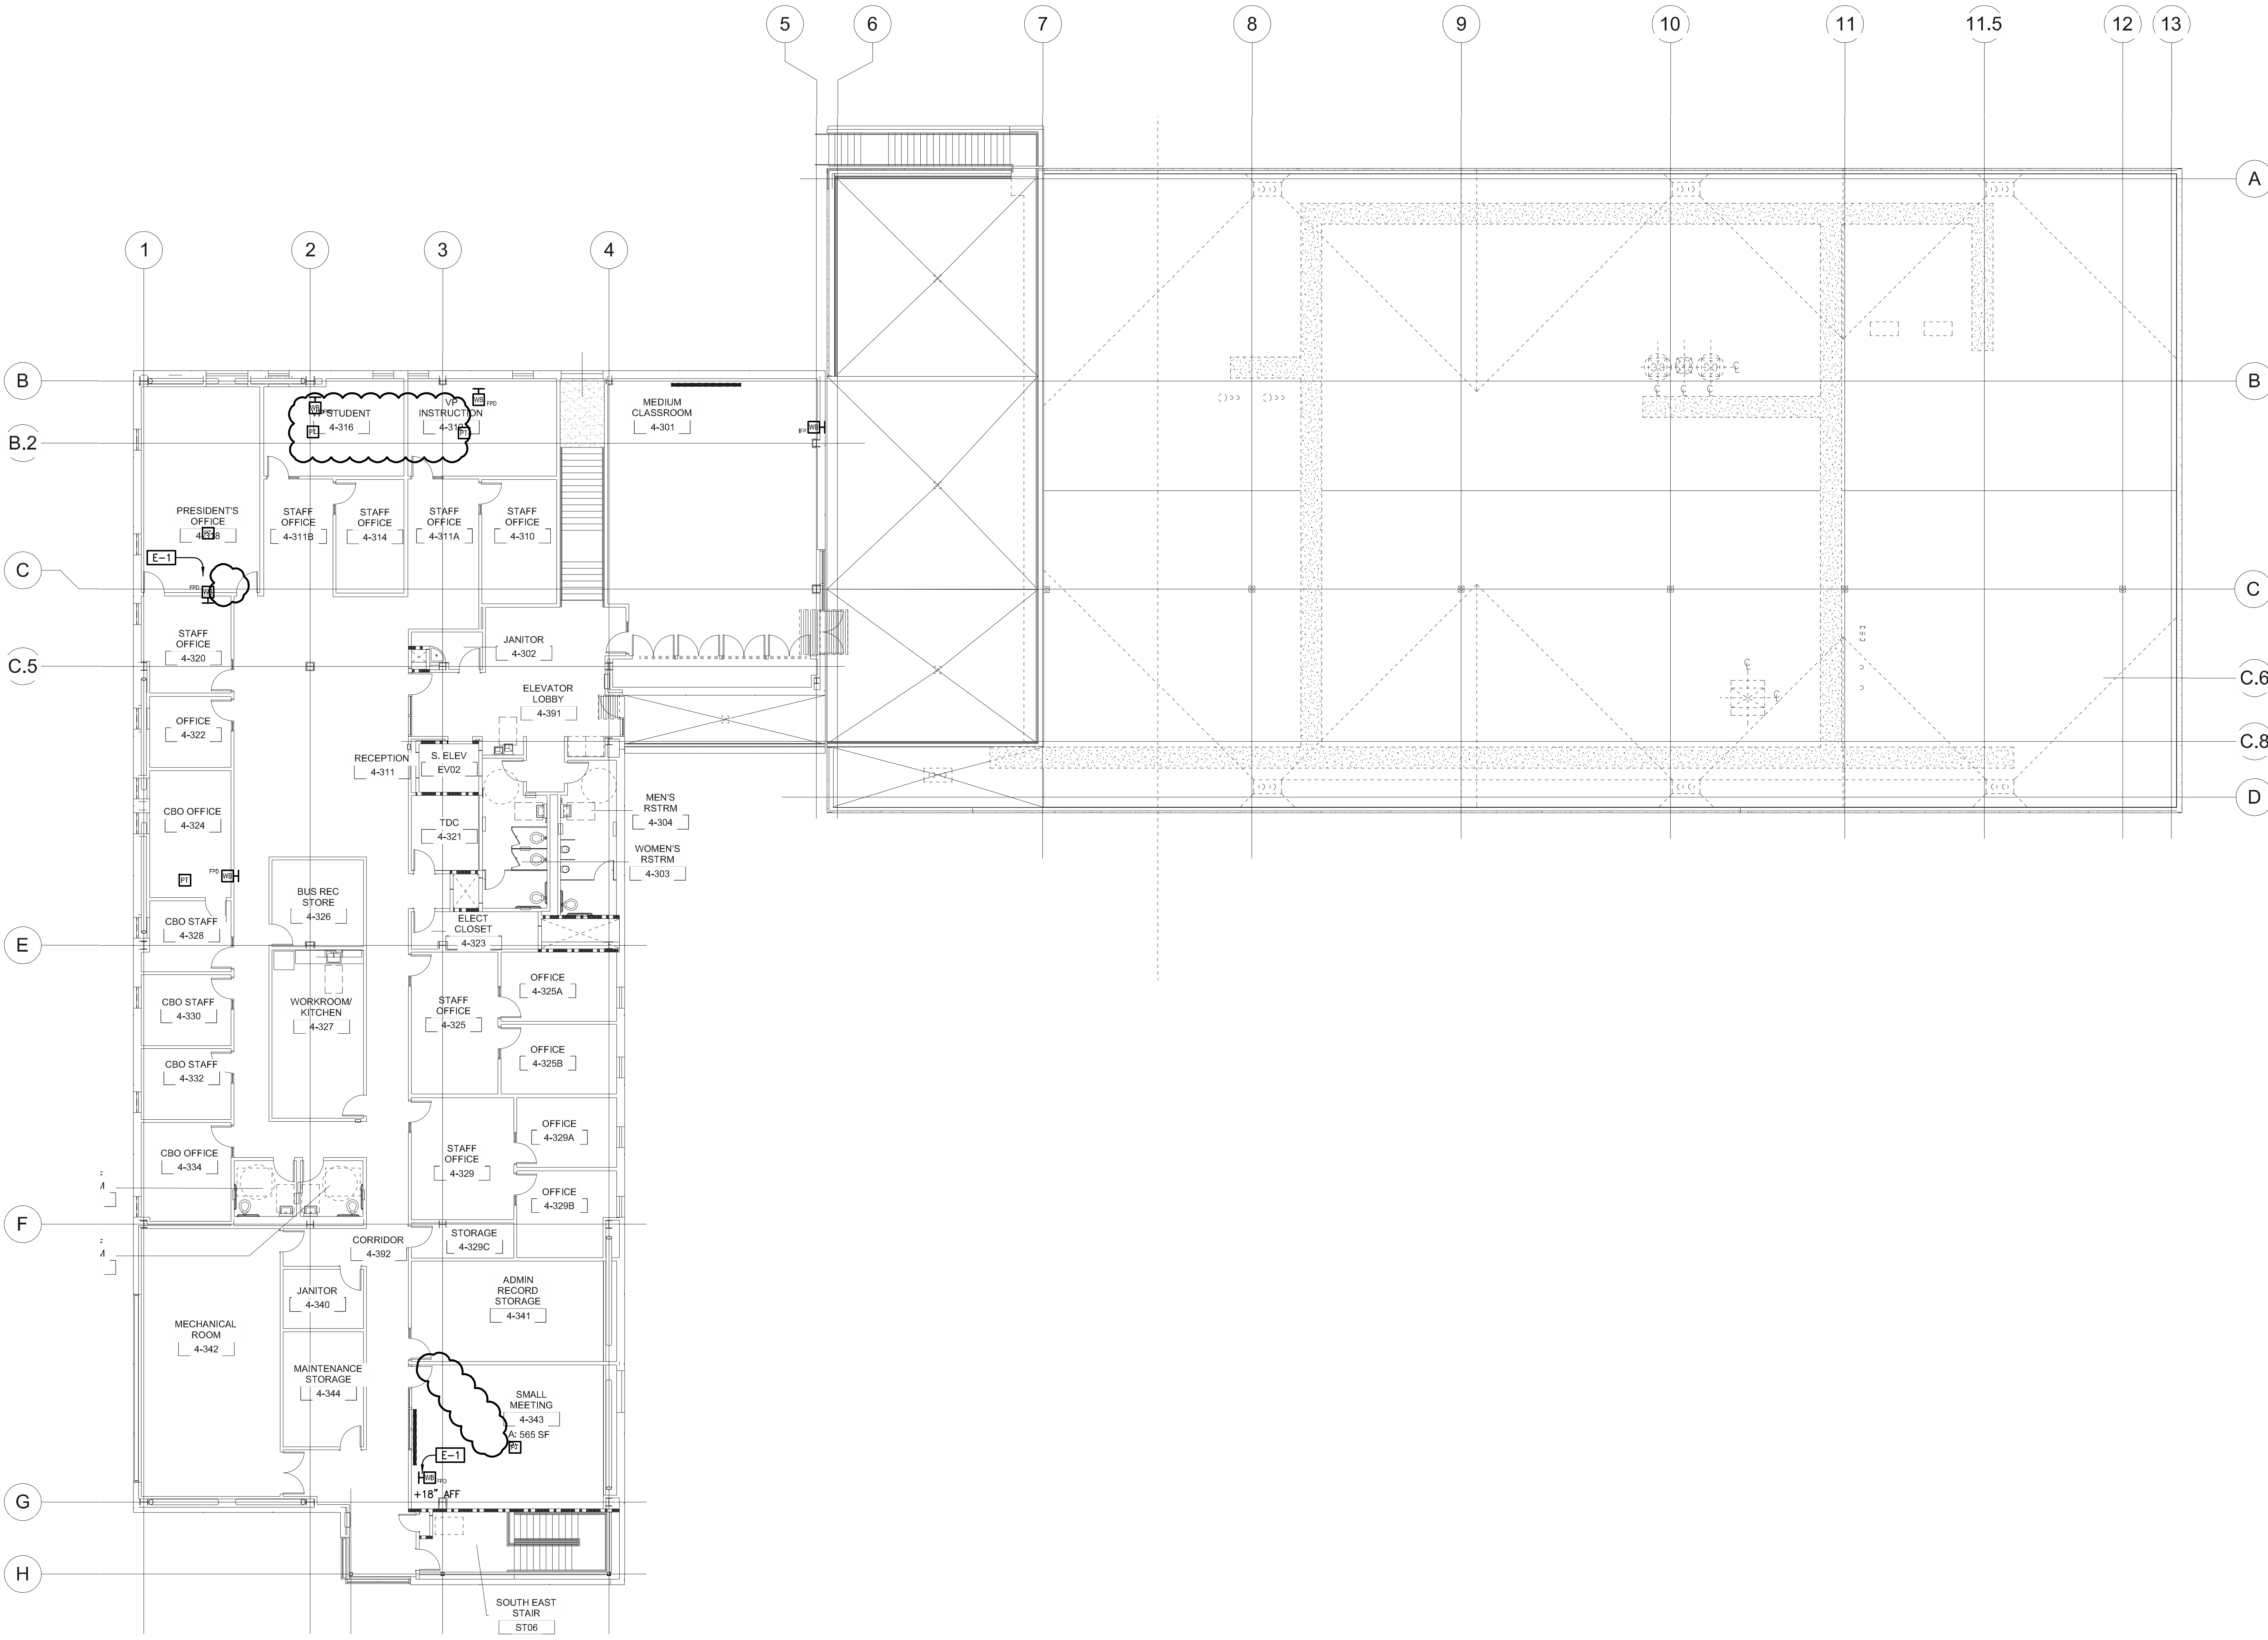

NO.	ISSUES/REVISIONS	DATE
1	100% SCHEMATIC DESIGN SUBMITTAL	04/28/08
2	50% DESIGN DEVELOPMENT SUBMITTAL	06/13/08
3	100% DESIGN DEVELOPMENT SUBMITTAL	07/28/08
4	DSA INCREMENT #1: SITE DEMOLITION, EXCAVATION, ROUGH GRADING & UTILITIES	09/25/08
5	INCREMENT 2 80% REVIEW	10/10/08
6	DSA INCREMENT #2: STRUCTURE & SPRIG PANELS	11/11/08
7	DSA INCREMENT #3 50% REVIEW	11/11/08
8	DSA INCREMENT #1: BACK CHECK	11/19/08
9	DSA INCREMENT #3: 90% REVIEW	12/19/08
10	DSA INCREMENT #3: TENANT IMPROVEMENT & ROOFING SYSTEM	02/09/09
11	DSA INCREMENT #2: BACK-CHECK	03/11/09
12	DSA INCREMENT #3: BACK-CHECK	05/12/09
13	PROJECT RECORD SET	01/31/11

PROJECT RECORD SET


**SKYLINE COLLEGE
 CIP2 DESIGN-BUILD
 BUILDING 4N**

PROJECT NO: DRAWN BY: WAC
 DATE: 01/31/11 CHECKED BY: APA
 SCALE: 3/32" = 1'-0"

**LEVEL 3
 AUDIOVISUAL
 OVERALL
 FLOOR PLAN**

All drawings and written material appearing herein constitute original and unpublished work of the Architect/Engineer and may not be duplicated, used or disclosed without consent of Architect/Engineer.
 If this drawing is not 30"x42", then the drawing has been revised from its original size. Noted scales must be adjusted. This line should be equal to one inch.

SYMBOL LIST	
AUDIOVISUAL:	
	AV POKE-THRU, 6" ROUND, (2) 1-1/4" CONDUIT STUBBED UP TO ACCESSIBLE CEILING
	WALL BOX FOR FLAT PANEL DISPLAY, 2-GANG, CENTER OF BOX AT 52" AFF, (1) 1-1/4" CONDUIT STUBBED UP TO ACCESSIBLE CEILING. PROVIDE DATA AND ADJACENT TO BOX.
	WALL BOX FOR INTERFACE PLATE, 3-GANG, CENTER OF BOX AT 18" AFF, (2) 1-1/4" CONDUIT STUBBED UP TO ACCESSIBLE CEILING. PROVIDE DATA AND ADJACENT TO BOX.

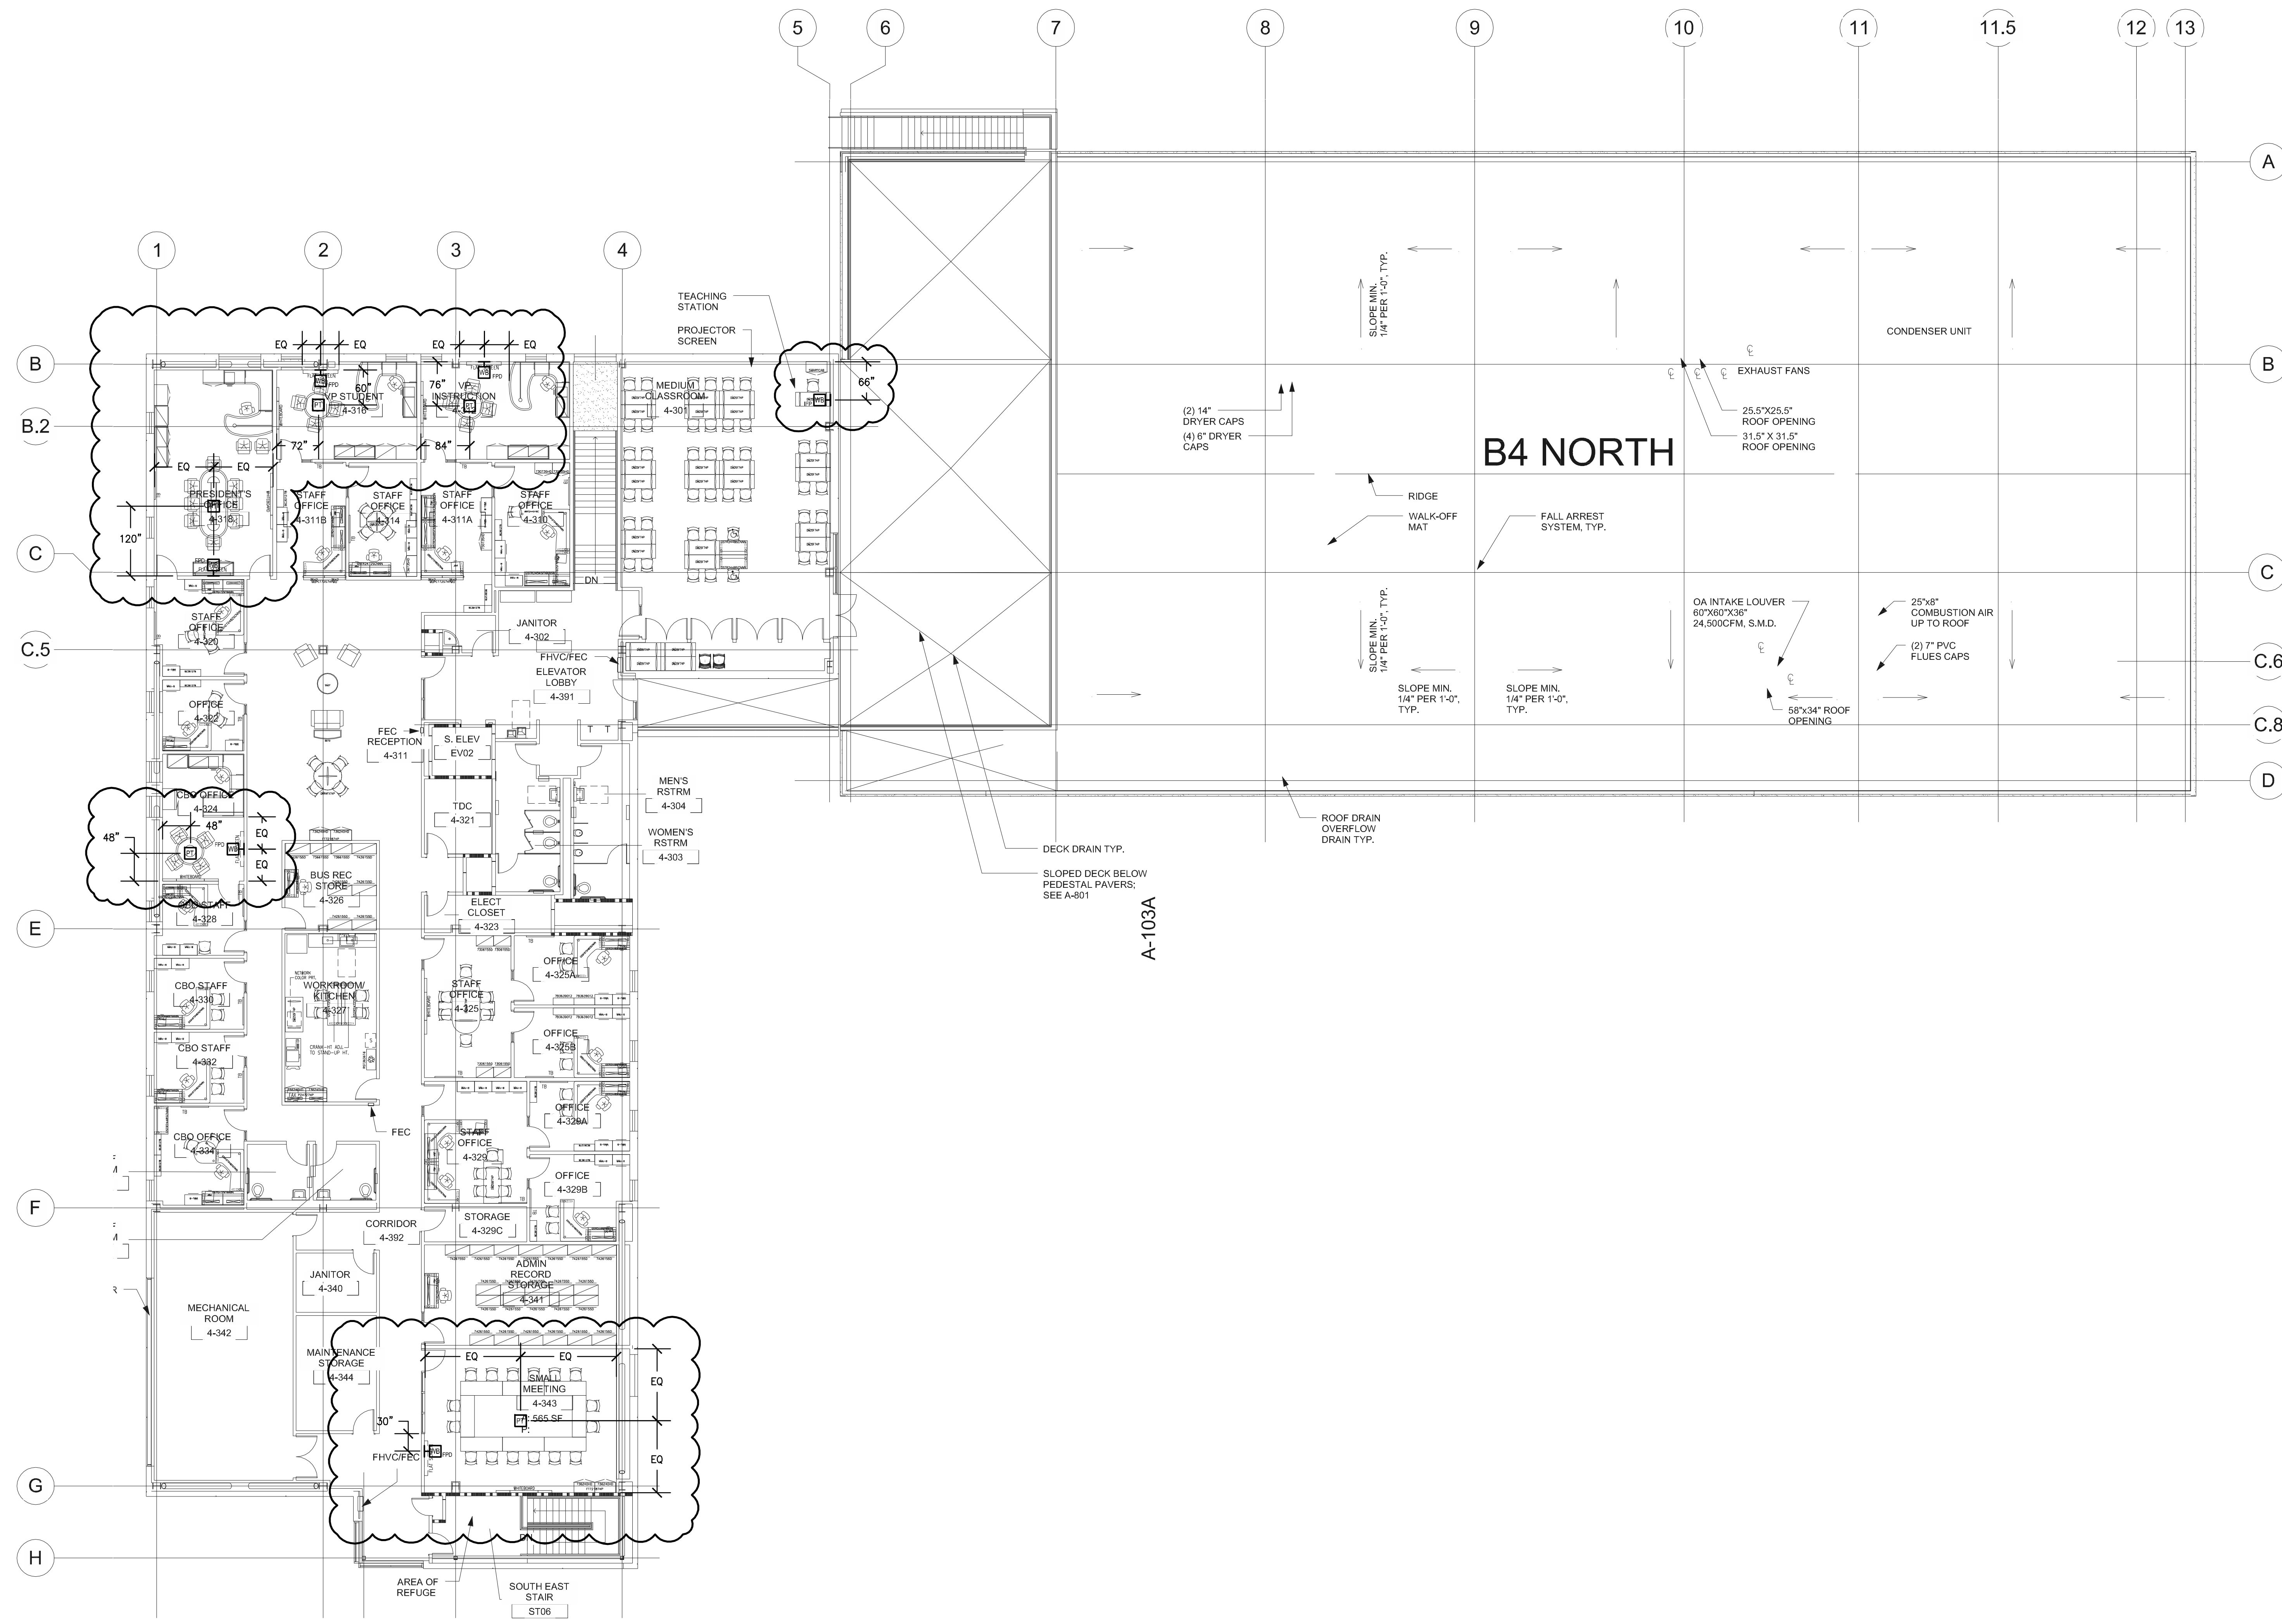

NO.	ISSUES/REVISIONS	DATE
1	100% SCHEMATIC DESIGN SUBMITTAL	04/28/08
2	50% DESIGN DEVELOPMENT SUBMITTAL	06/13/08
3	100% DESIGN DEVELOPMENT SUBMITTAL	07/28/08
4	DSA INCREMENT #1: SITE DEMOLITION, EXCAVATION, ROUGH GRADING & UTILITIES	09/25/08
5	INCREMENT 2 80% REVIEW	10/10/08
6	DSA INCREMENT #2: STRUCTURE & GRG PANELS	11/11/08
7	DSA INCREMENT #3 50% REVIEW	11/11/08
8	DSA INCREMENT #1: BACK CHECK	11/18/08
9	DSA INCREMENT #3: 90% REVIEW	12/18/08
10	DSA INCREMENT #3: TENANT IMPROVEMENT & ROOFING SYSTEM	02/09/09
11	DSA INCREMENT #2: BACK-CHECK	03/11/09
12	DSA INCREMENT #3: BACK-CHECK	05/12/09
13	PROJECT RECORD SET	01/31/11

PROJECT
RECORD SET


SKYLINE COLLEGE
CIP2 DESIGN-BUILD
BUILDING 4N

PROJECT NO: 01/31/11
DATE: 01/31/11
SCALE: 3/32" = 1'-0"

SHEET TITLE:
**LEVEL 3
AUDIOVISUAL
OVERALL
FLOOR PLAN**

SHEET NO: TA-103A

All drawings and written material appearing herein constitute original and unpublished work of the Architect/Engineer and may not be duplicated, used or disclosed without consent of Architect/Engineer.
If this drawing is not 30"x42", then the drawing has been revised from its original size. Noted scales must be adjusted. This line should be equal to one inch.

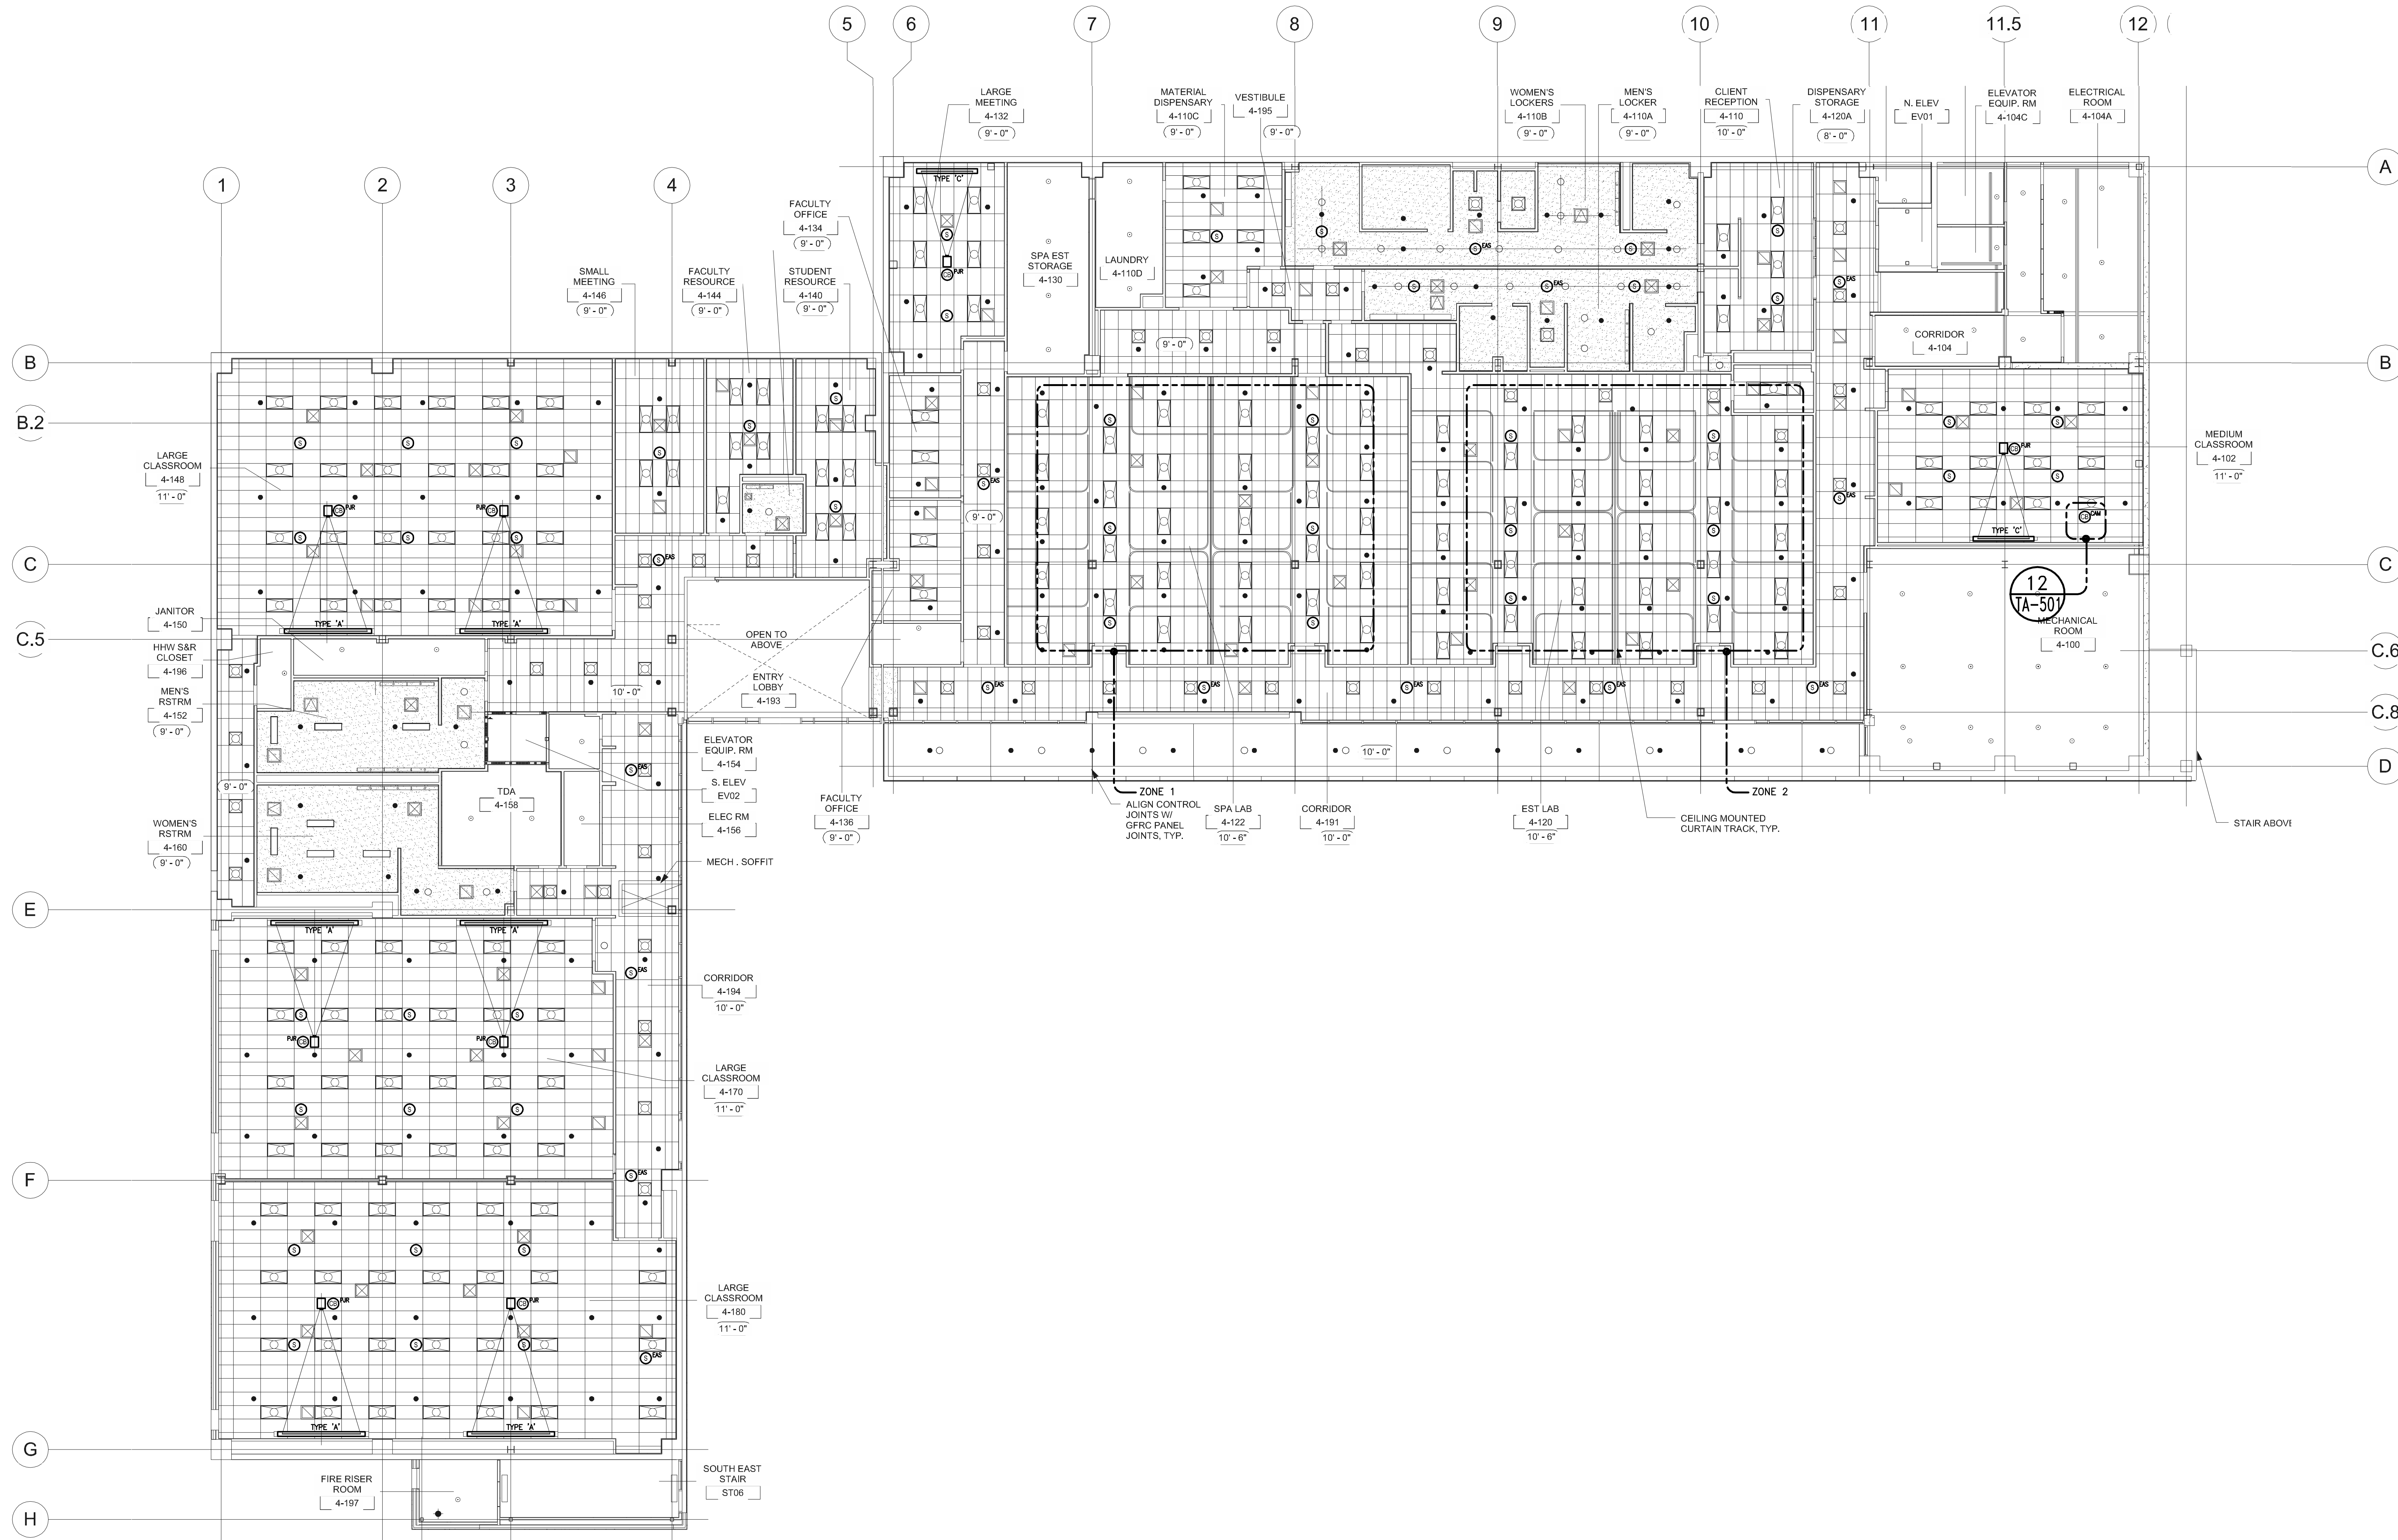

NO.	ISSUES/REVISIONS	DATE
1	100% SCHEMATIC DESIGN SUBMITTAL	04/28/08
2	50% DESIGN DEVELOPMENT SUBMITTAL	06/13/08
3	100% DESIGN DEVELOPMENT SUBMITTAL	07/28/08
4	DSA INCREMENT #1 SITE DEMOLITION, EXCAVATION, ROUGH GRADING & UTILITIES	09/25/08
5	INCREMENT 2 80% REVIEW	10/10/08
6	DSA INCREMENT #2 STRUCTURE & GFCI PANELS	11/11/08
7	DSA INCREMENT #3 50% REVIEW	11/11/08
8	DSA INCREMENT #1 BACK CHECK	11/18/08
9	DSA INCREMENT #3 90% REVIEW	12/18/08
10	DSA INCREMENT #3 TENANT IMPROVEMENT & ROOFING SYSTEM	02/09/09
11	DSA INCREMENT #2 BACK-CHECK	03/11/09
12	DSA INCREMENT #3 BACK-CHECK	05/12/09
13	PROJECT RECORD SET	01/31/11

PROJECT RECORD SET

SKYLINE COLLEGE CIP2 DESIGN-BUILD BUILDING 4N

PROJECT NO: DRAWN BY: WAC
DATE: 01/31/11 CHECKED BY: APA
SCALE: 3/32" = 1'-0"

LEVEL 1 AUDIOVISUAL OVERALL RCP

All drawings and written material appearing herein constitute original and unpublished work of the Architect/Engineer and may not be duplicated, used or disclosed without consent of Architect/Engineer. If this drawing is not 30"x42", then the drawing has been revised from its original size. Noted scales must be adjusted. This line should be equal to one inch.

NO.	ISSUES/REVISIONS	DATE
1	100% SCHEMATIC DESIGN SUBMITTAL	04/28/08
2	50% DESIGN DEVELOPMENT SUBMITTAL	06/13/08
3	100% DESIGN DEVELOPMENT SUBMITTAL	07/28/08
4	DSA INCREMENT #1 SITE DEMOLITION, EXCAVATION, ROUGH GRADING & UTILITIES	09/25/08
5	INCREMENT 2 80% REVIEW	10/10/08
6	DSA INCREMENT #2 STRUCTURE & GFRG PANELS	11/11/08
7	DSA INCREMENT #3 50% REVIEW	11/11/08
8	DSA INCREMENT #1 BACK CHECK	11/19/08
9	DSA INCREMENT #3 90% REVIEW	12/19/08
10	DSA INCREMENT #3 TENANT IMPROVEMENT & ROOFING SYSTEM	02/09/09
11	DSA INCREMENT #2 BACK-CHECK	03/11/09
12	DSA INCREMENT #3 BACK-CHECK	05/12/09
13	PROJECT RECORD SET	01/31/11


PROJECT
RECORD SET

SKYLINE COLLEGE
CIP2 DESIGN-BUILD
BUILDING 4N

PROJECT NO: DRAWN BY: WAC
DATE: 01/31/11 CHECKED BY: APA
SCALE: 3/32" = 1'-0"

SHEET TITLE:
LEVEL 2
AUDIOVISUAL
OVERALL
R C P

SHEET NO: TA-202

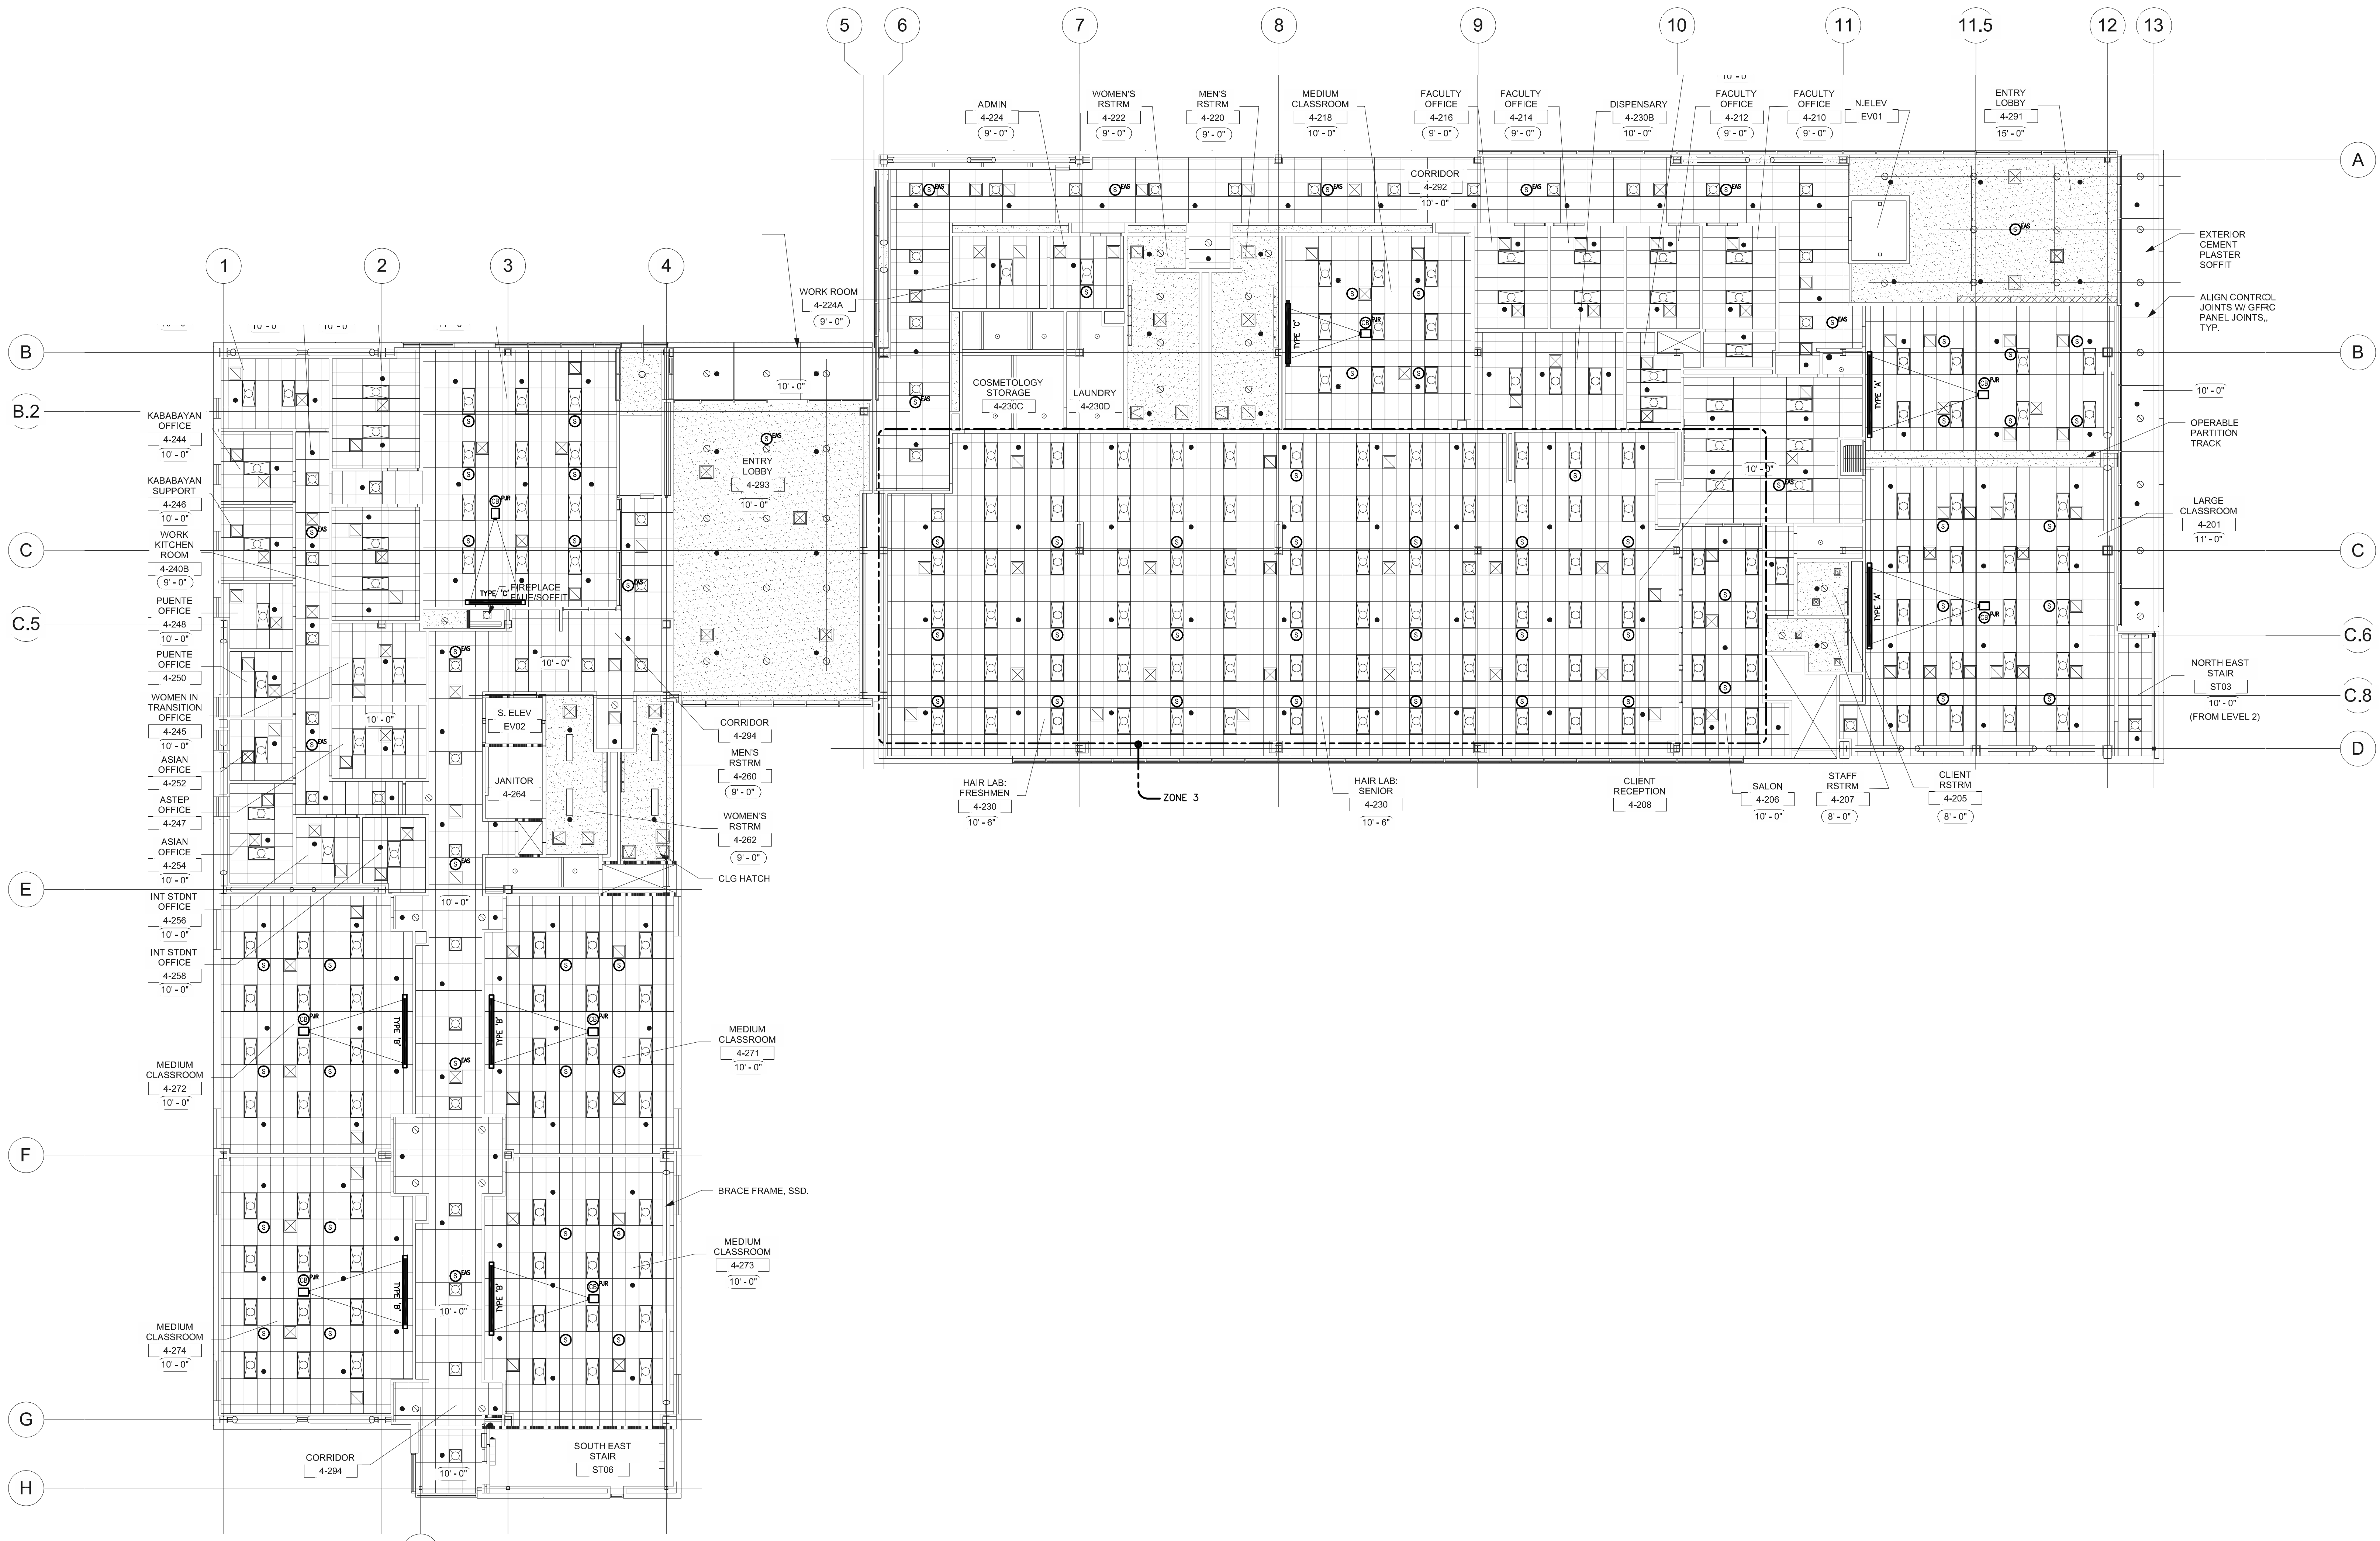

All drawings and written material appearing herein constitute original and unpublished work of the Architect/Engineer and may not be duplicated, used or disclosed without consent of Architect/Engineer. If this drawing is not 30"x42", then the drawing has been revised from its original size. Noted scales must be adjusted. This line should be equal to one inch.

NUMBERED SHEET NOTES

ELECTRICAL:
 [E-1] PROVIDE CONDUIT PATHWAY TO PROJECTION SCREEN CONTROLLER (HMS^{PS}C) SHOWN ON FLOOR PLAN, SHEET TA-103.

NO.	ISSUES/REVISIONS	DATE
1	100% SCHEMATIC DESIGN SUBMITTAL	04/28/08
2	50% DESIGN DEVELOPMENT SUBMITTAL	06/13/08
3	100% DESIGN DEVELOPMENT SUBMITTAL	07/28/08
4	DSA INCREMENT #1: SITE DEMOLITION, EXCAVATION, ROUGH GRADING & UTILITIES	09/25/08
5	INCREMENT 2 80% REVIEW	10/10/08
6	DSA INCREMENT #2: STRUCTURE & GFRG PANELS	11/11/08
7	DSA INCREMENT #3 50% REVIEW	11/11/08
8	DSA INCREMENT #1: BACK CHECK	11/18/08
9	DSA INCREMENT #3: 90% REVIEW	12/18/08
10	DSA INCREMENT #3: TENANT IMPROVEMENT & ROOFING SYSTEM	02/09/09
11	DSA INCREMENT #2: BACKCHECK	03/11/09
12	DSA INCREMENT #3: BACKCHECK	05/12/09
13	PROJECT RECORD SET	01/31/11


PROJECT RECORD SET

**SKYLINE COLLEGE
 CIP2 DESIGN-BUILD
 BUILDING 4N**

PROJECT NO: DRAWN BY: WAC
 DATE: 01/31/11 CHECKED BY: APA
 SCALE: 3/32" = 1'-0"

**LEVEL 3
 AUDIOVISUAL
 OVERALL
 R C P**

SHEET NO: TA-203

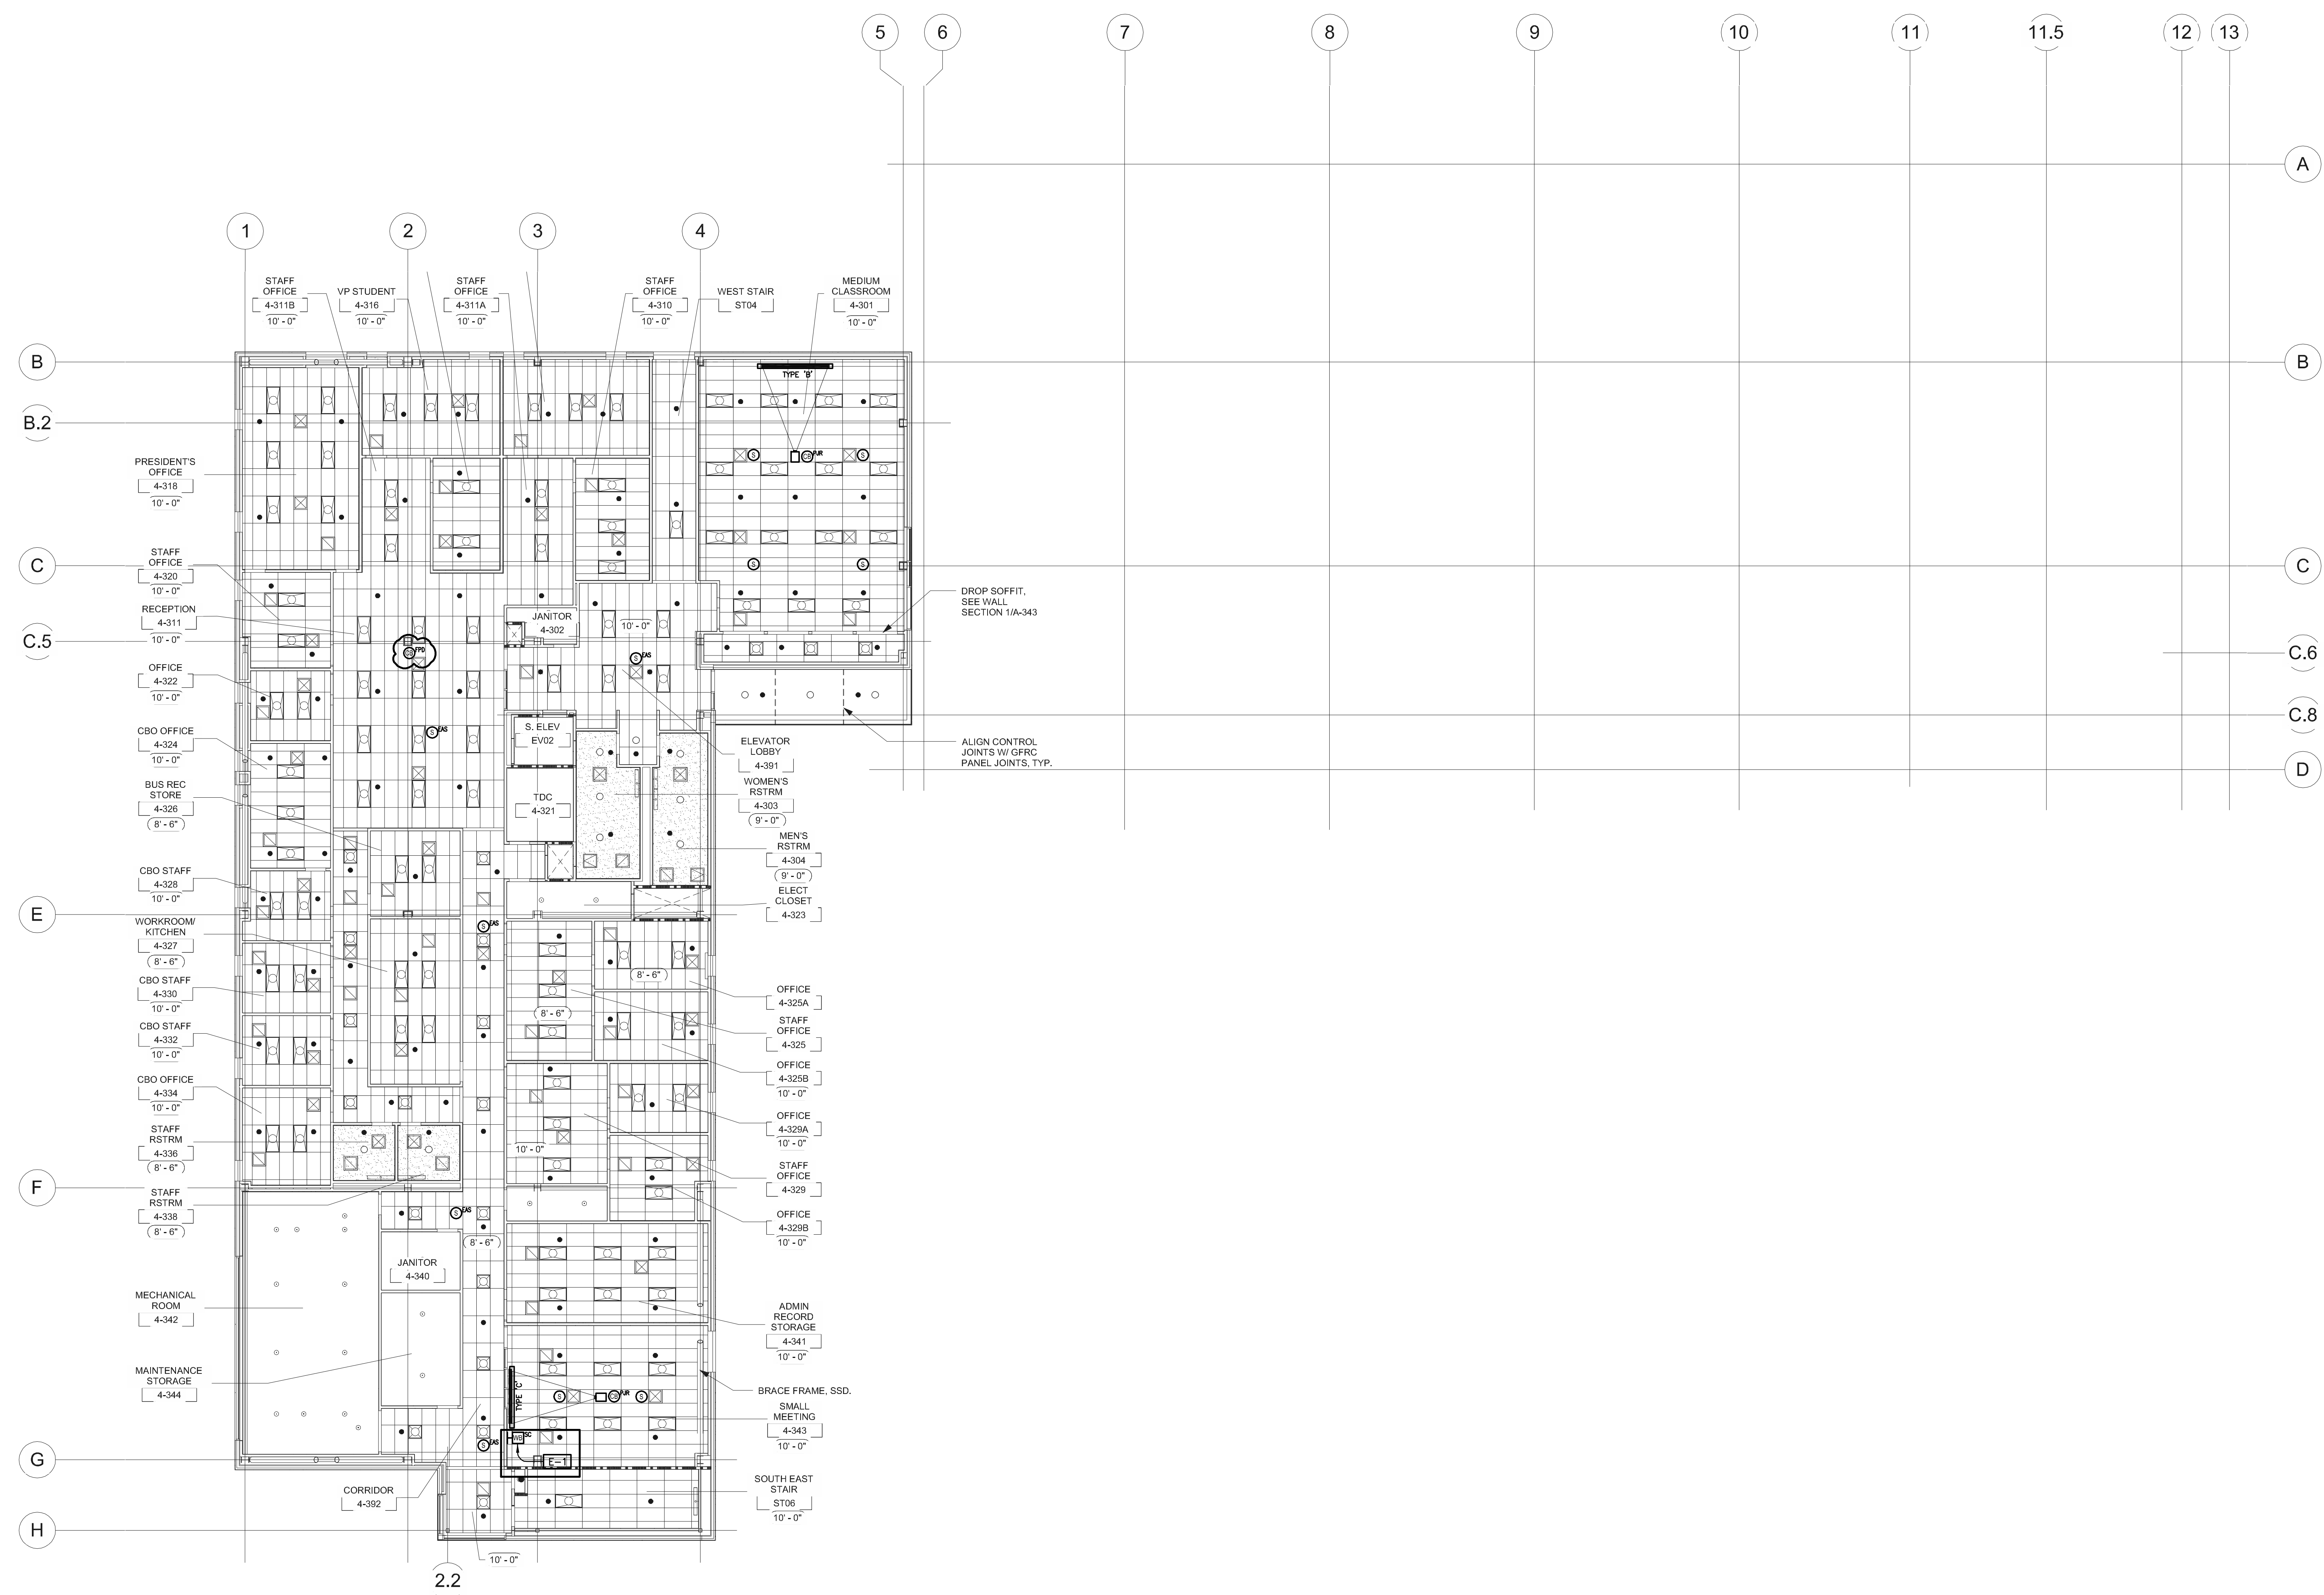

All drawings and written material appearing herein constitute original and unpublished work of the Architect/Engineer and may not be duplicated, used or disclosed without consent of Architect/Engineer.
 If this drawing is not 30"x42", then the drawing has been revised from its original size. Noted scales must be adjusted. This line should be equal to one inch.

GENERAL SHEET NOTES

1. REFER TO ARCHITECTURAL DRAWINGS FOR ADDITIONAL ROOM SECTIONS AND ELEVATIONS

WRNSSTUDIO.LP
 801 SECOND STREET
 4TH FLOOR, STE. 402
 SAN FRANCISCO
 CALIFORNIA 94107
 415.489.2224 TEL
 415.358.9100 FAX
 WWW.WRNSSTUDIO.COM


Steinberg Architects

HP Hensel Phelps Construction Co.

DE DECKER ELECTRIC


TECOM DESIGN GROUP
 1333 BROADWAY STE 601
 OAKLAND CA 94612
 510-337-2800
 510-337-2804 FAX
 WWW.TECOM.COM

NO.	ISSUES/REVISIONS	DATE
1	100% SCHEMATIC DESIGN SUBMITTAL	04/28/08
2	50% DESIGN DEVELOPMENT SUBMITTAL	06/13/08
3	100% DESIGN DEVELOPMENT SUBMITTAL	07/28/08
4	DSA INCREMENT #1: SITE DEMOLITION, EXCAVATION, ROUGH GRADING & UTILITIES	09/25/08
5	INCREMENT 2 80% REVIEW	10/10/08
6	DSA INCREMENT #2: STRUCTURE & SPRIG PANELS	11/11/08
7	DSA INCREMENT #3 50% REVIEW	11/11/08
8	DSA INCREMENT #1: BACK CHECK	11/18/08
9	DSA INCREMENT #3 90% REVIEW	12/18/08
10	DSA INCREMENT #3: TENANT IMPROVEMENT & ROOFING SYSTEM	02/09/09
11	DSA INCREMENT #2: BACKCHECK	03/11/09
12	DSA INCREMENT #3: BACKCHECK	05/12/09
13	PROJECT RECORD SET	01/31/11

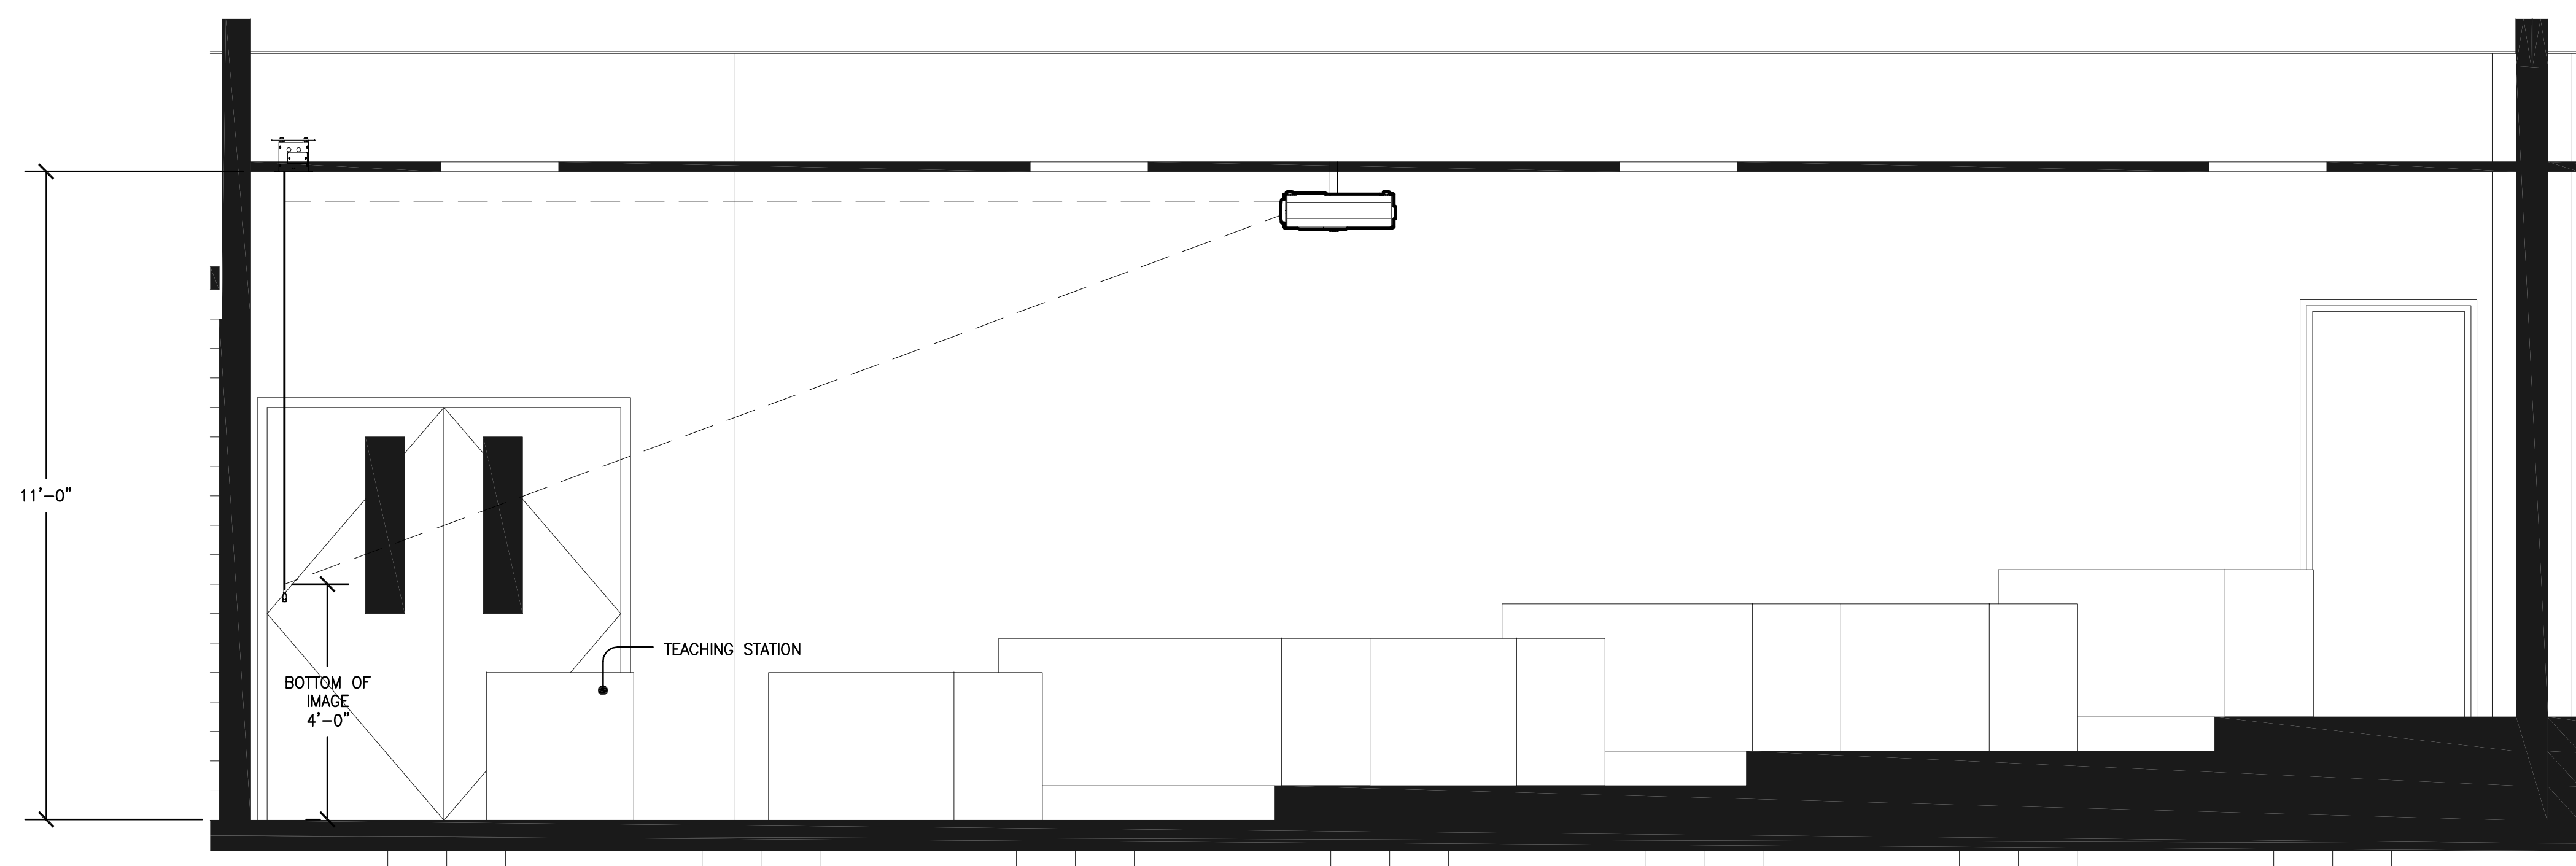

LARGE CLASSROOM - SECTION
 SCALE: 1/2" = 1'-0"

1

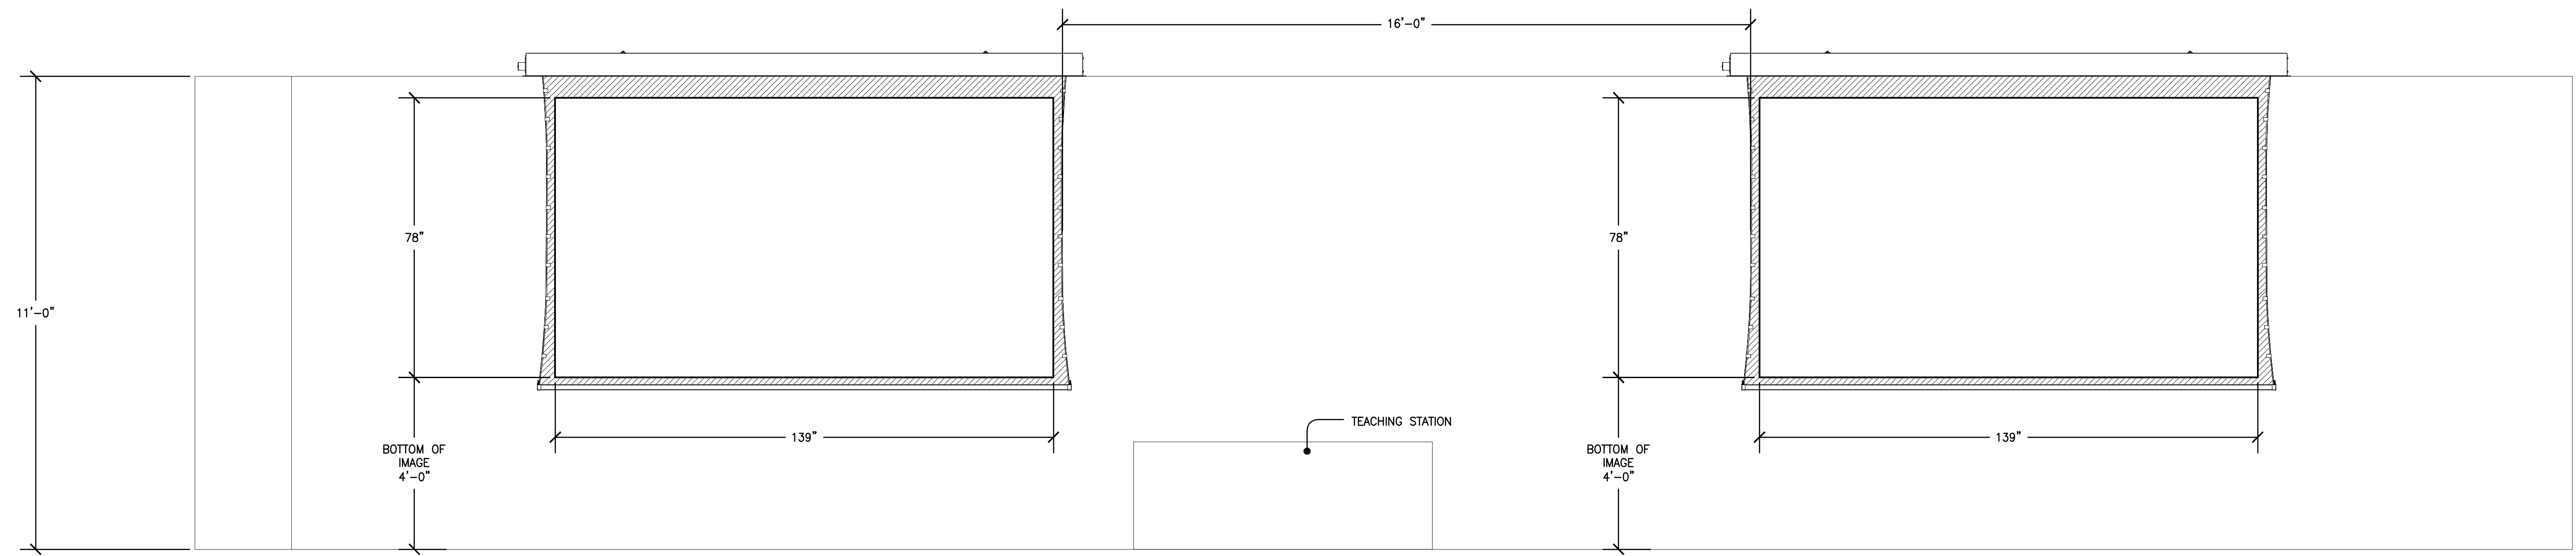

LARGE CLASSROOM - SCREEN ELEVATION
 SCALE: 1/2" = 1'-0"

2

PROJECT RECORD SET


**SKYLINE COLLEGE
 CIP2 DESIGN-BUILD
 BUILDING 4N**

PROJECT NO.: DRAWN BY: WAC
 DATE: 01/31/11 CHECKED BY: APA
 SCALE: NONE

SHEET TITLE:
SECTIONS AND ELEVATIONS

SHEET NO.: TA-401


All drawings and written material appearing herein constitute original and unpublished work of the Architect/Engineer and may not be duplicated, used or disclosed without consent of Architect/Engineer.
 If this drawing is not 30"x42", then the drawing has been revised from its original size. Noted scales must be adjusted. This line should be equal to one inch

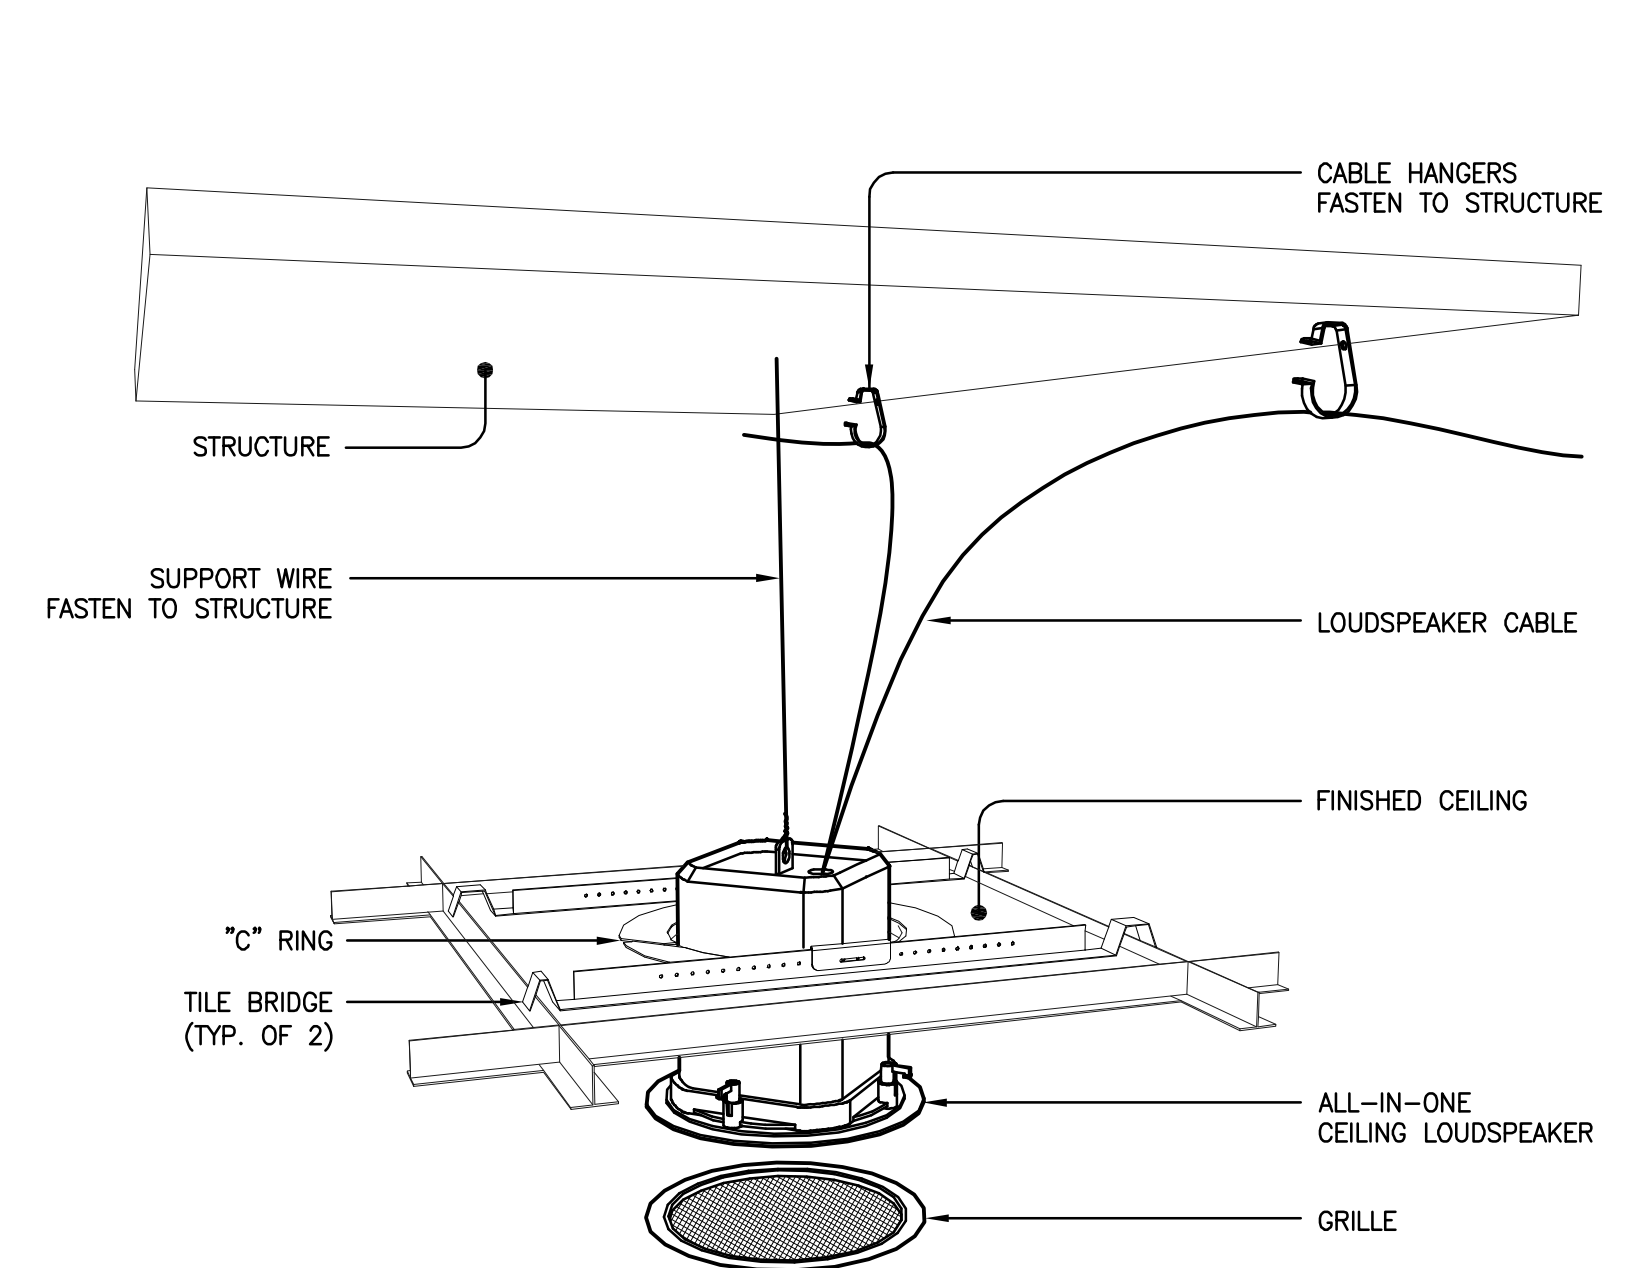

NOTE: SEE SHEET TA-502 FOR STRUCTURAL DETAILS

APPLICABLE TO SYMBOL: [Symbol]


CEILING MOUNTED LOUDSPEAKER - ATC 1
SCALE: NTS

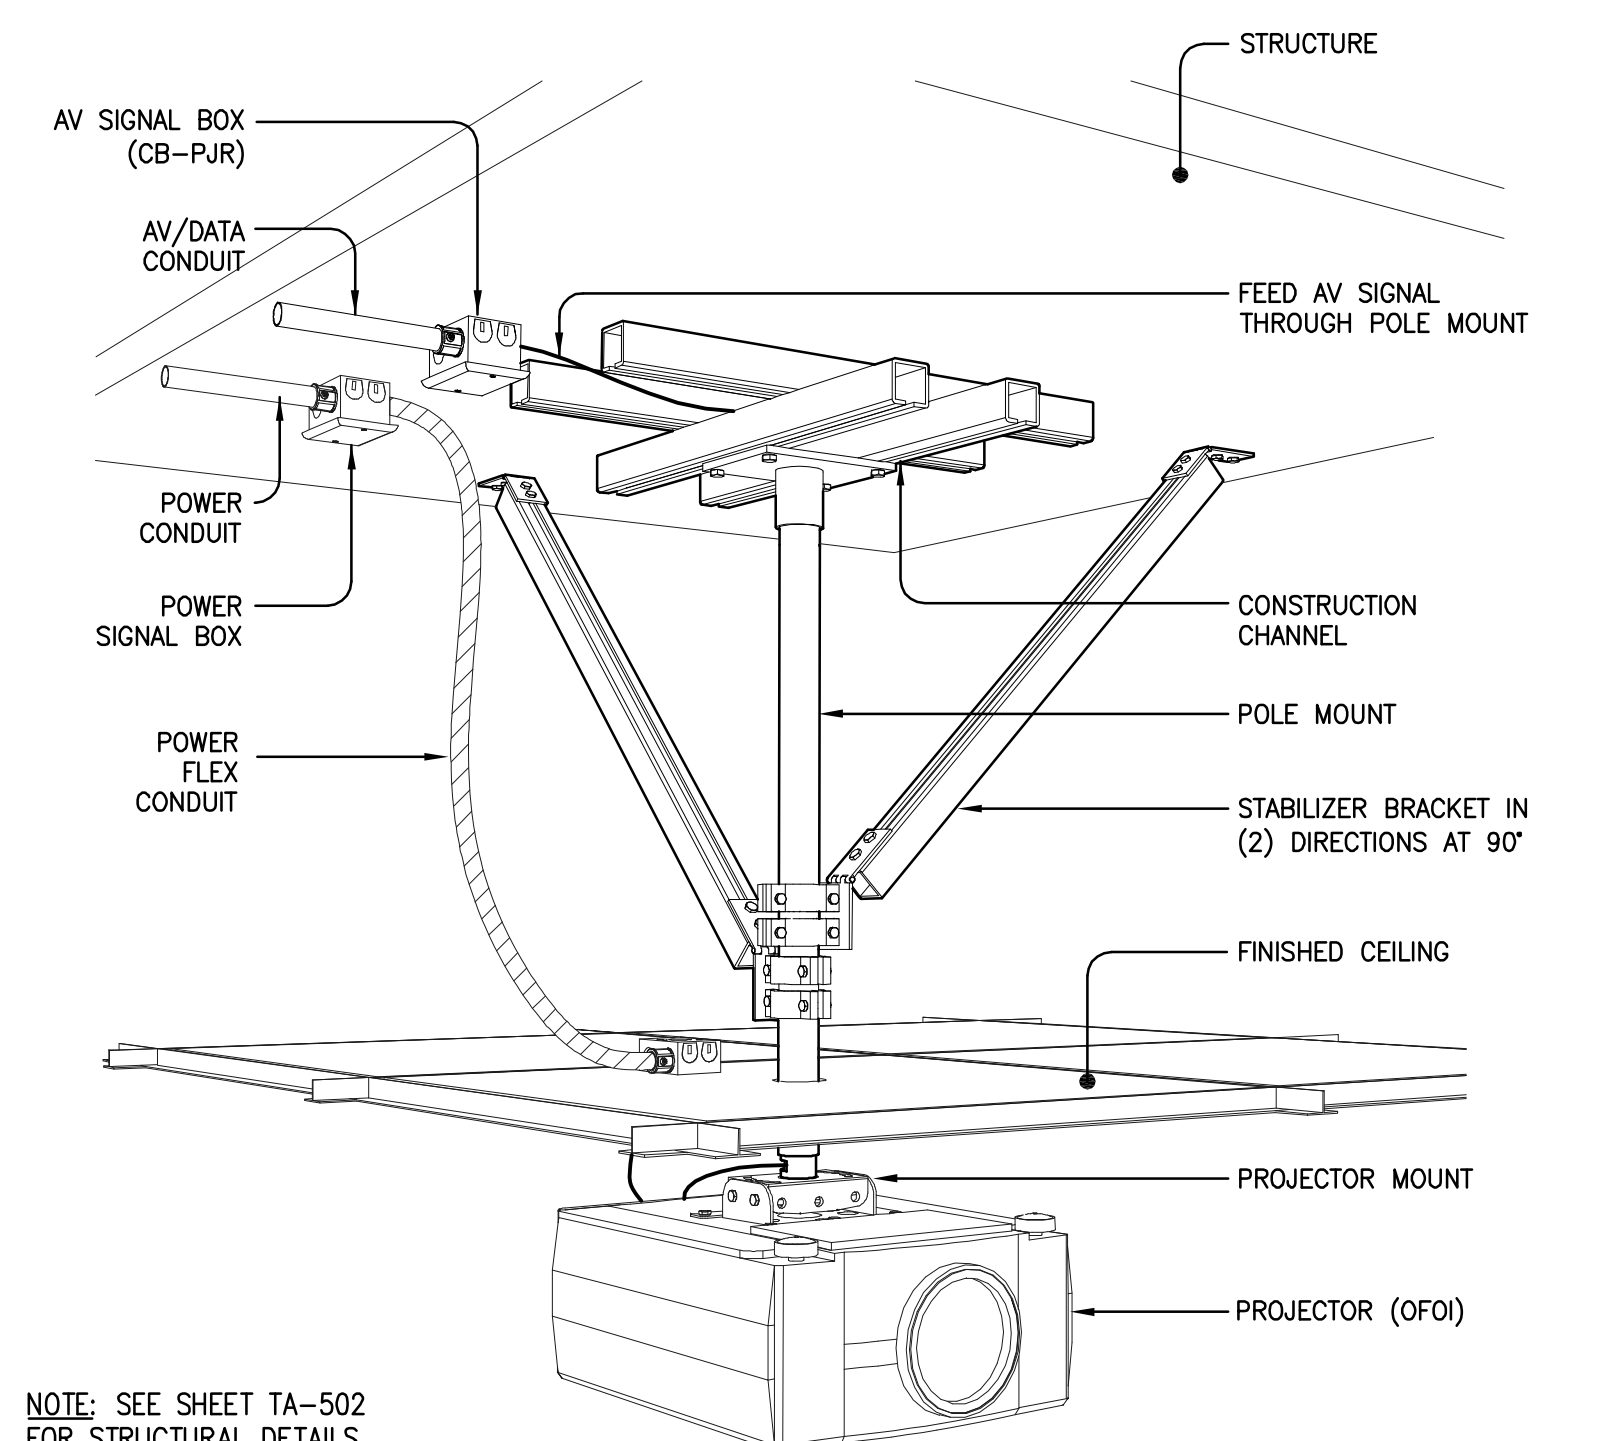


NOTE: SEE SHEET TA-502 FOR STRUCTURAL DETAILS

APPLICABLE TO SYMBOL: [Symbol]

CEILING MOUNTED PROJECTOR 2
SCALE: NTS

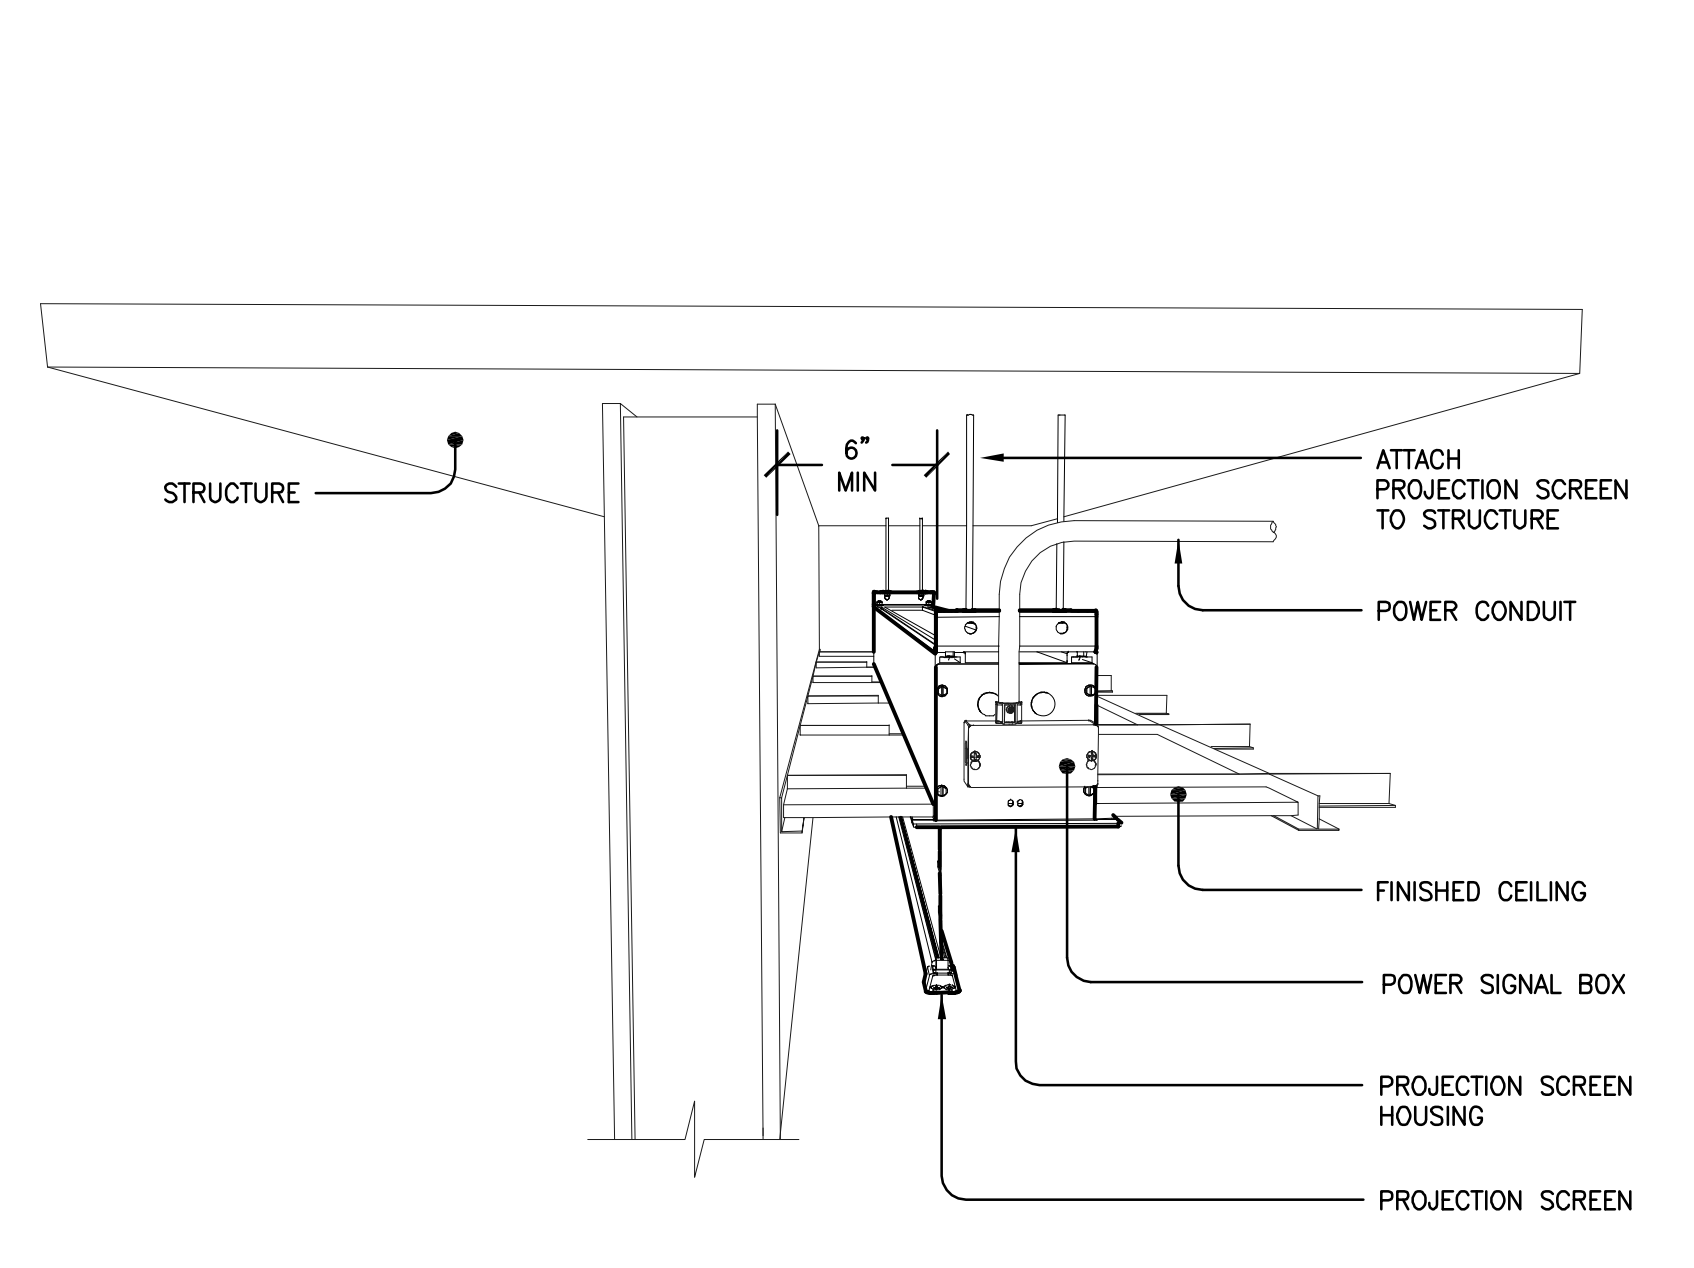


MOTORIZED PROJECTION SCREEN 3
SCALE: NTS

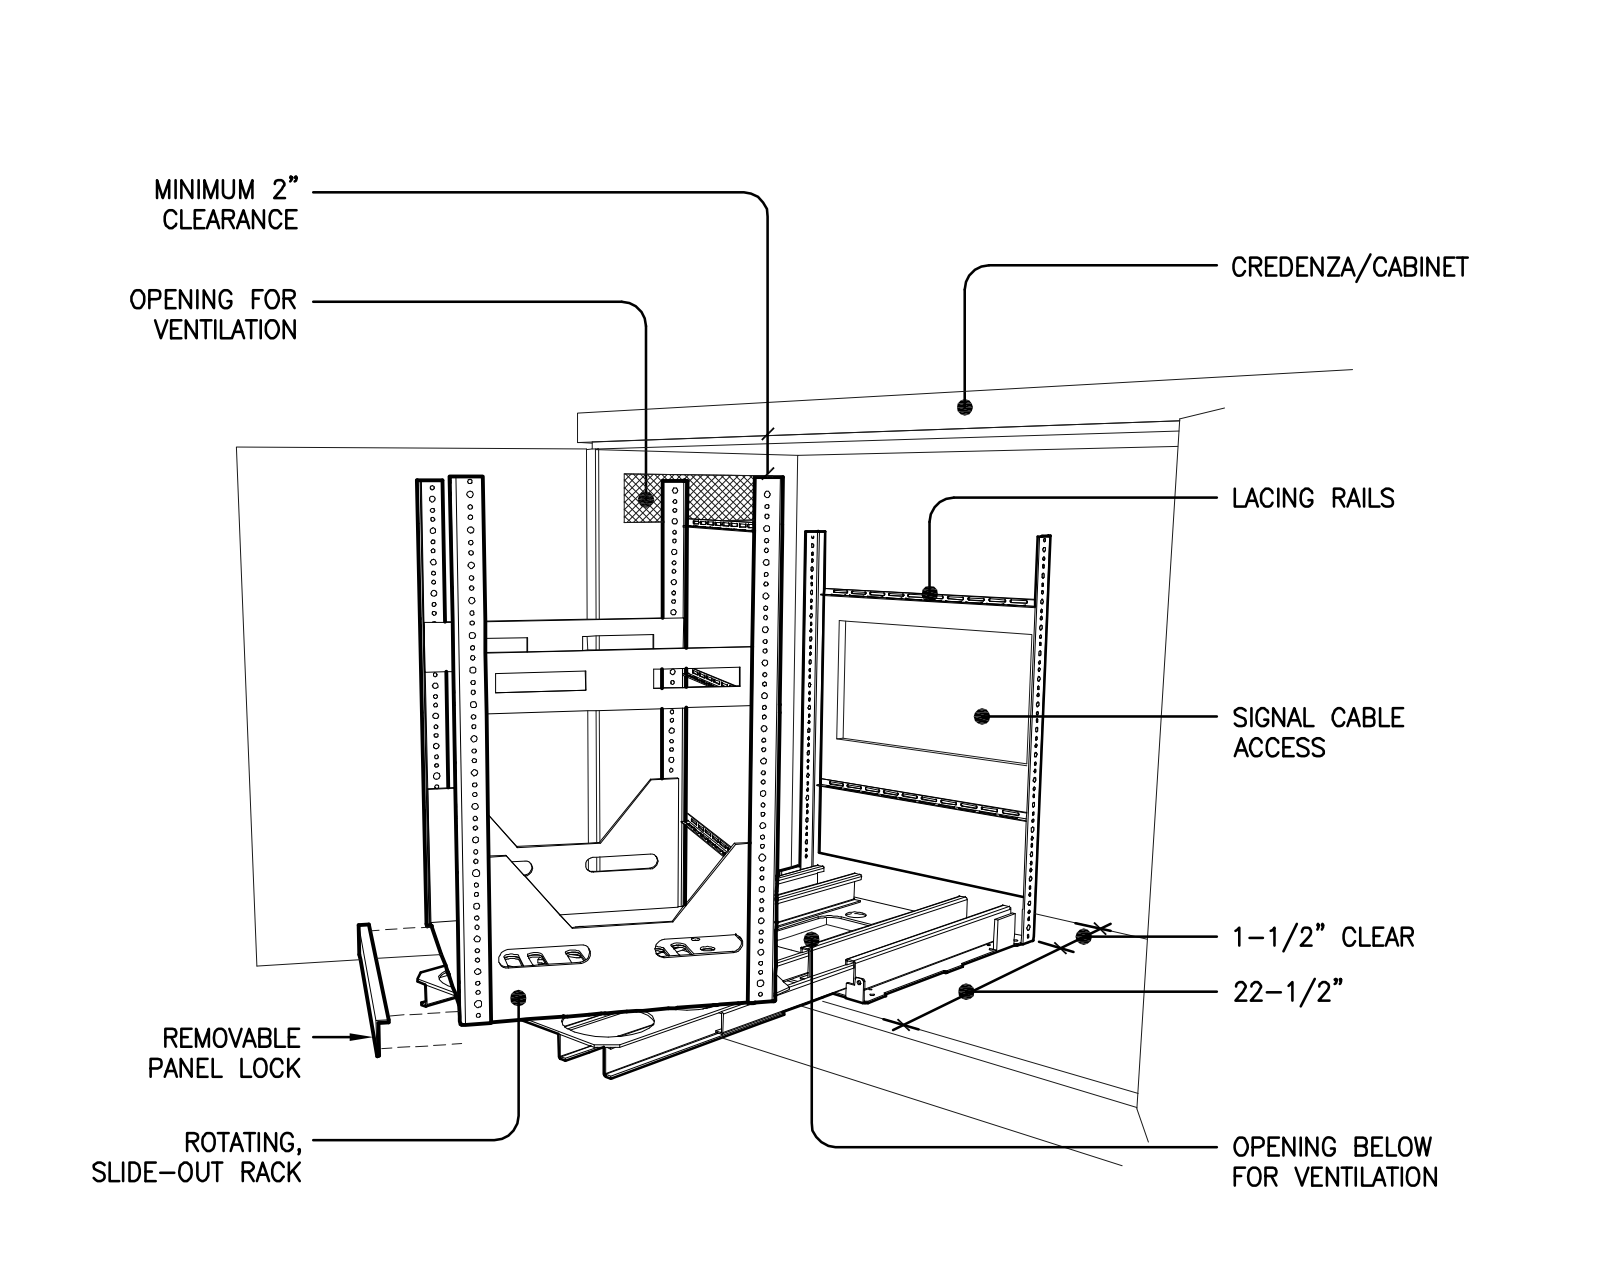

NOTE: INSIDE CLEAR DIMENSIONS OF CREDEENZA/CABINET A MINIMUM OF 24" DEEP AND 19-1/4" WIDE. HEIGHT DIMENSION WILL DEPEND ON FINAL EQUIPMENT COUNT PLUS 4". SEE INSTALLATION MANUAL FOR SPECIFIC INFORMATION.


SLIDE-OUT AV EQUIPMENT RACK 4
SCALE: NTS

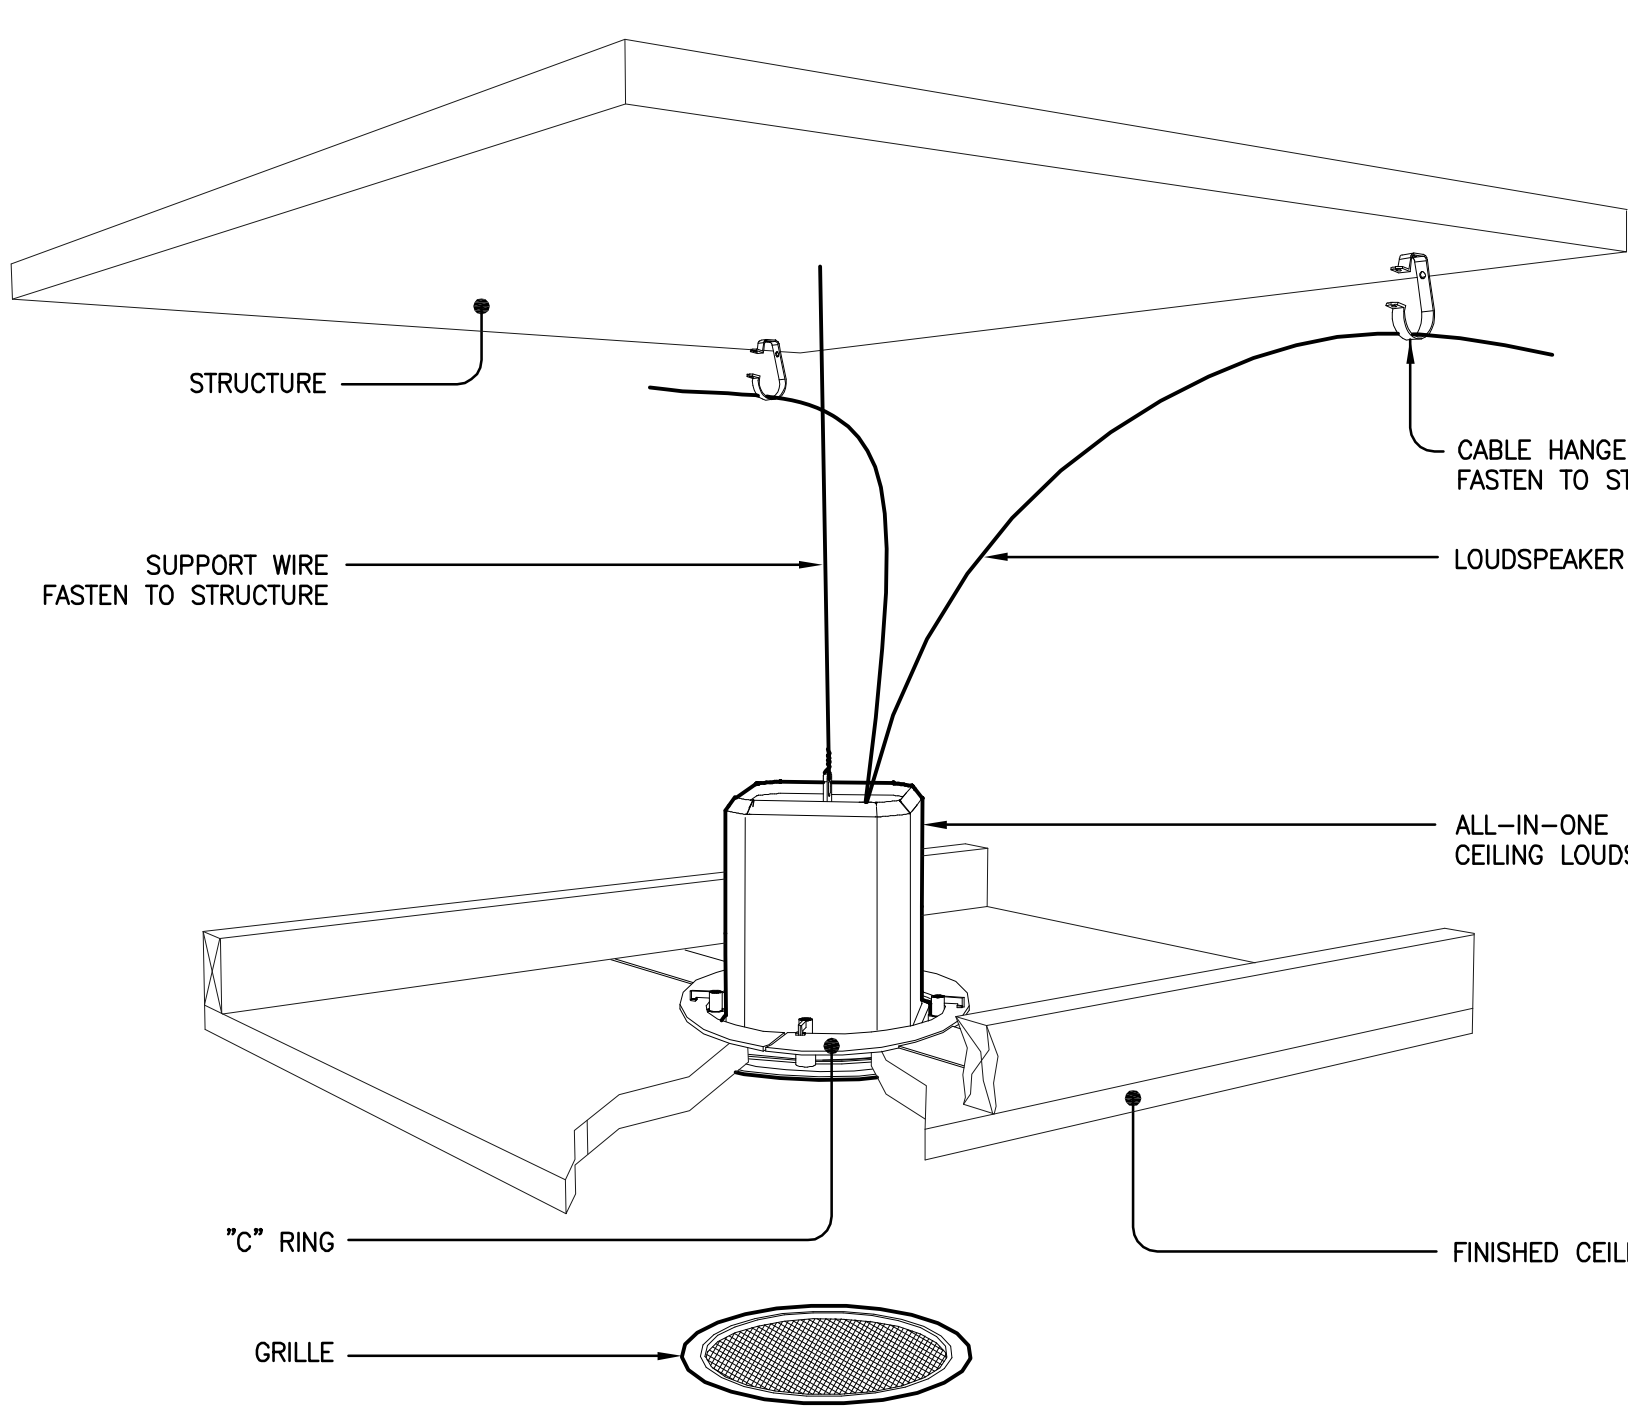

NOTE: SEE SHEET TA-502 FOR STRUCTURAL DETAILS

APPLICABLE TO SYMBOL: [Symbol]


CEILING MOUNTED LOUDSPEAKER - GYP 5
SCALE: NTS

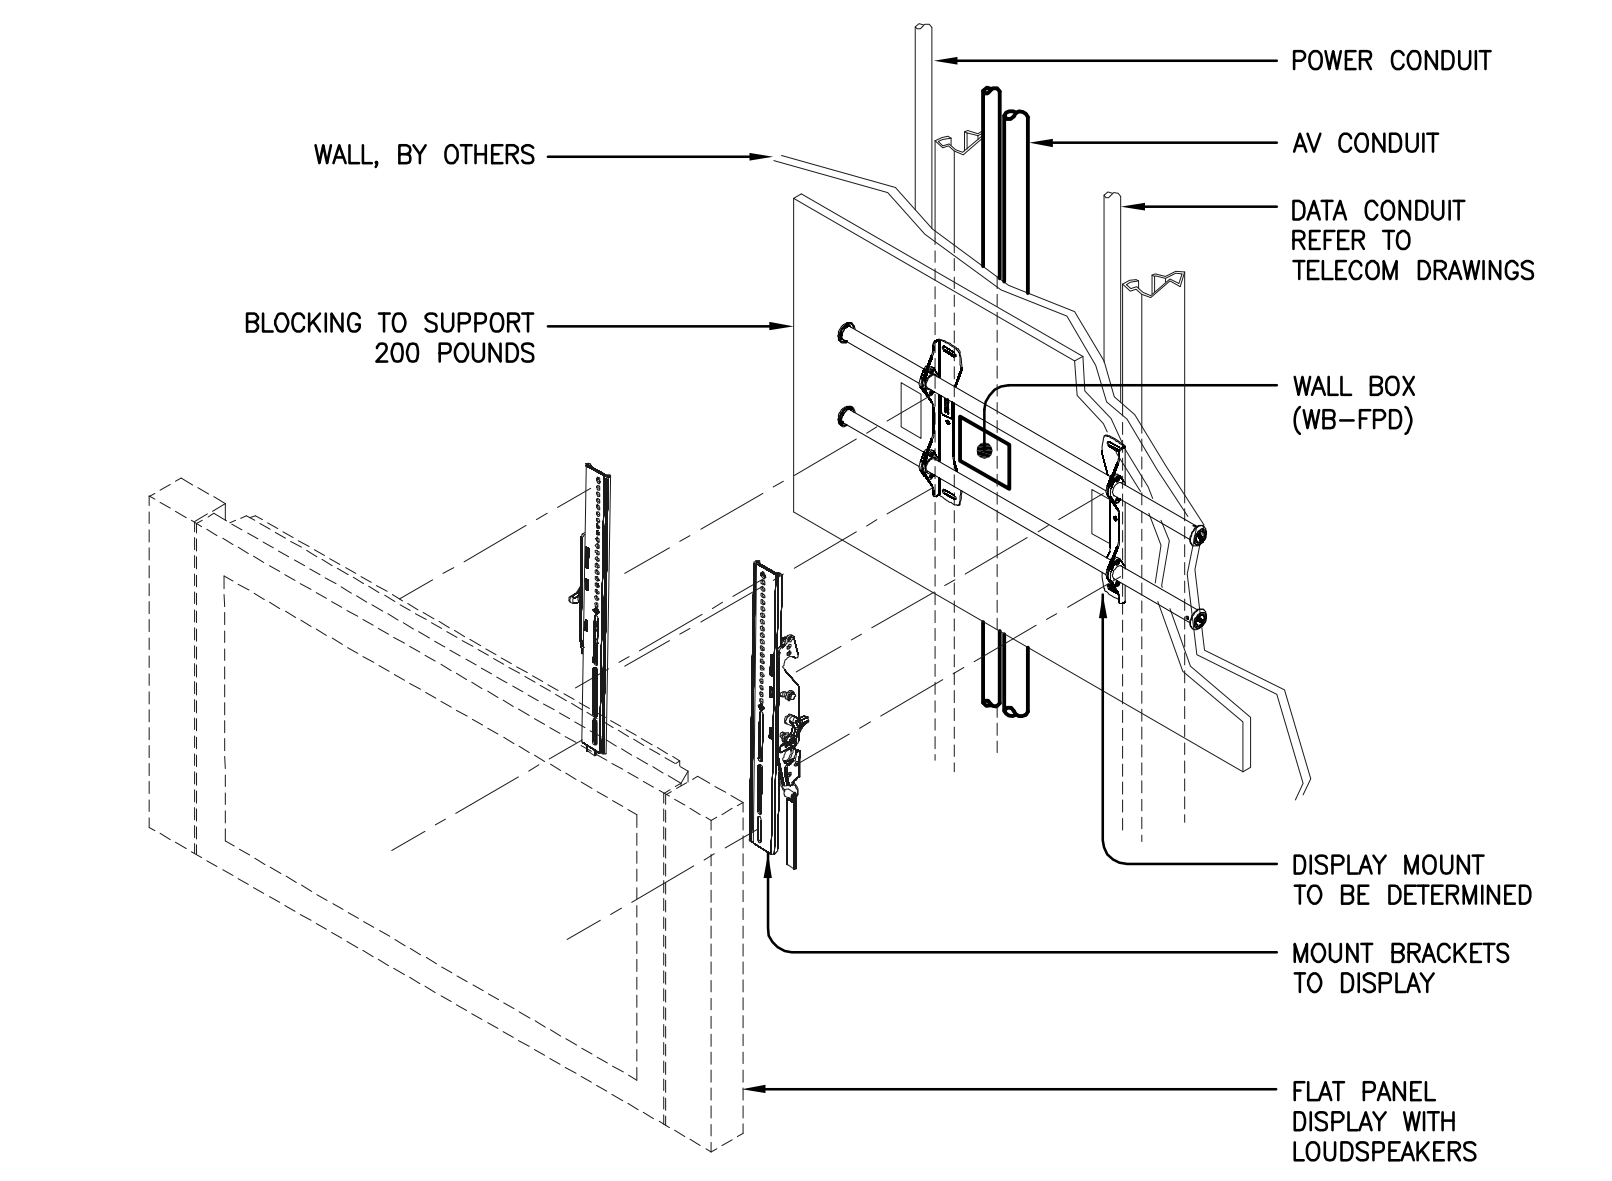

NOTE: SEE SHEET TA-502 FOR STRUCTURAL DETAILS


APPLICABLE TO SYMBOL: [Symbol]

WALL MOUNTED FLAT PANEL DISPLAY 6
SCALE: NTS

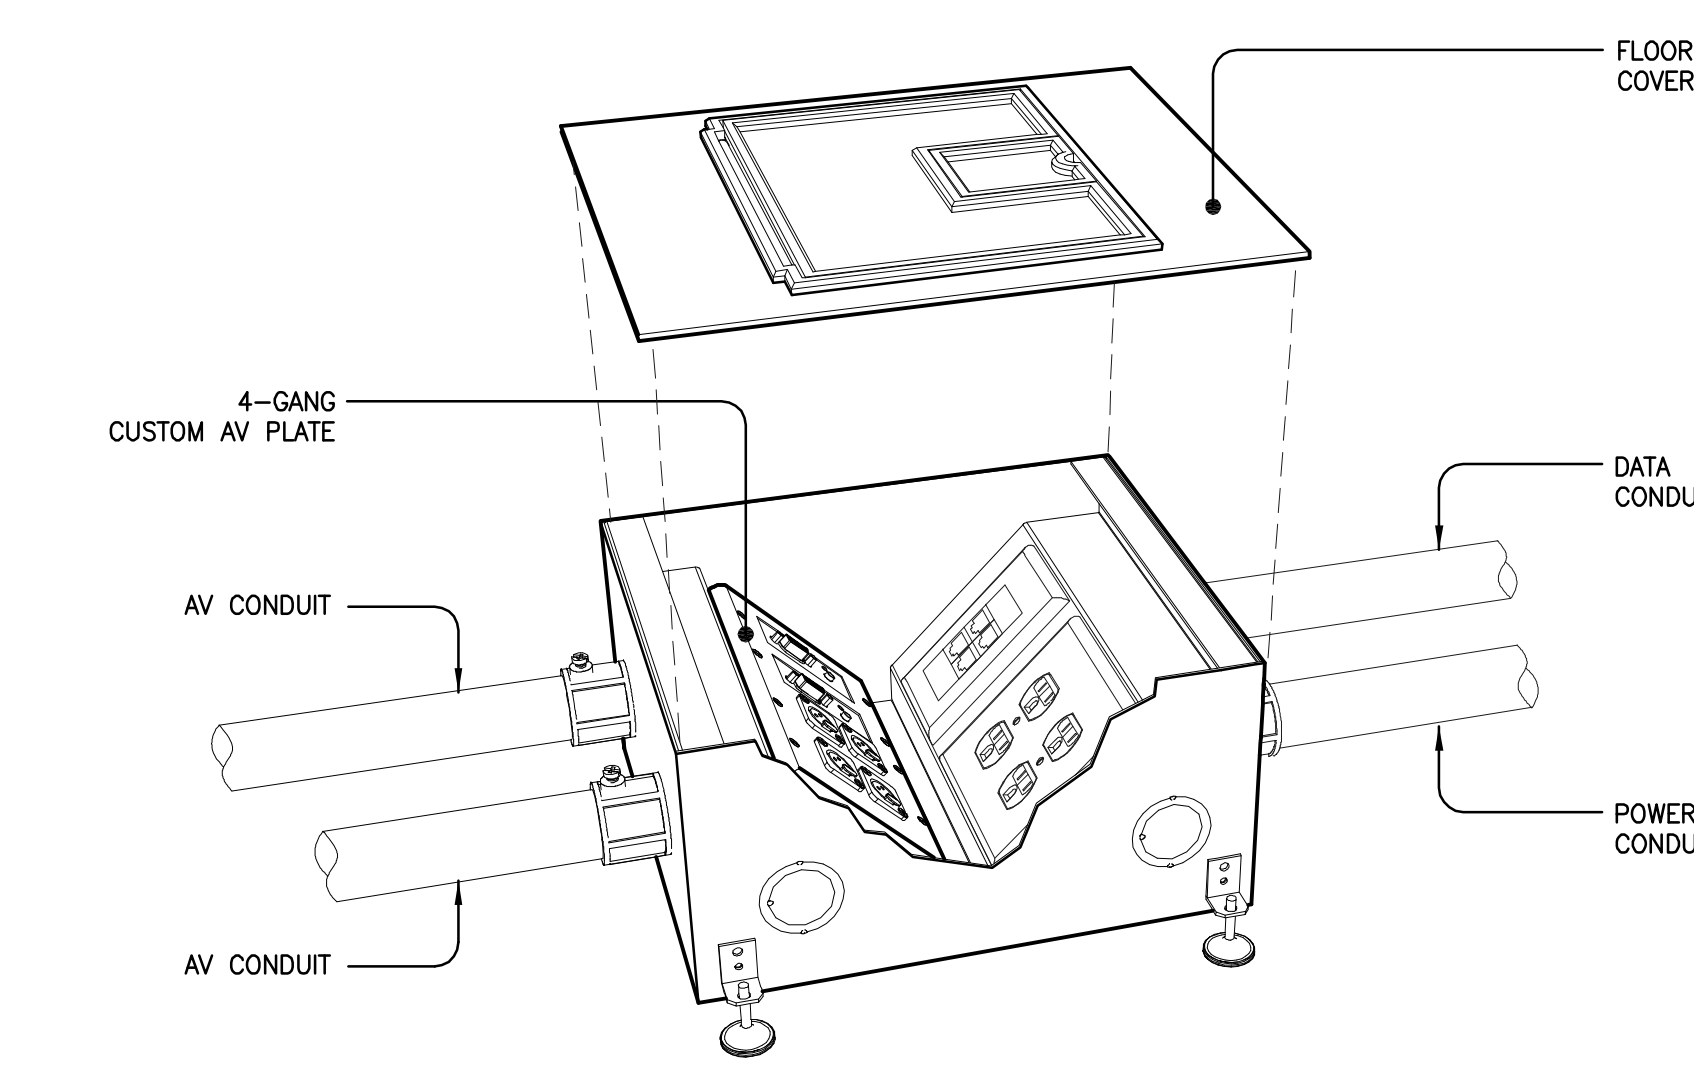


NOTE: FLOOR BOX AND FLOOR BOX COVER MANUFACTURED BY FSR INC. WWW.FSRINC.COM

FLOOR BOX 7
SCALE: NTS

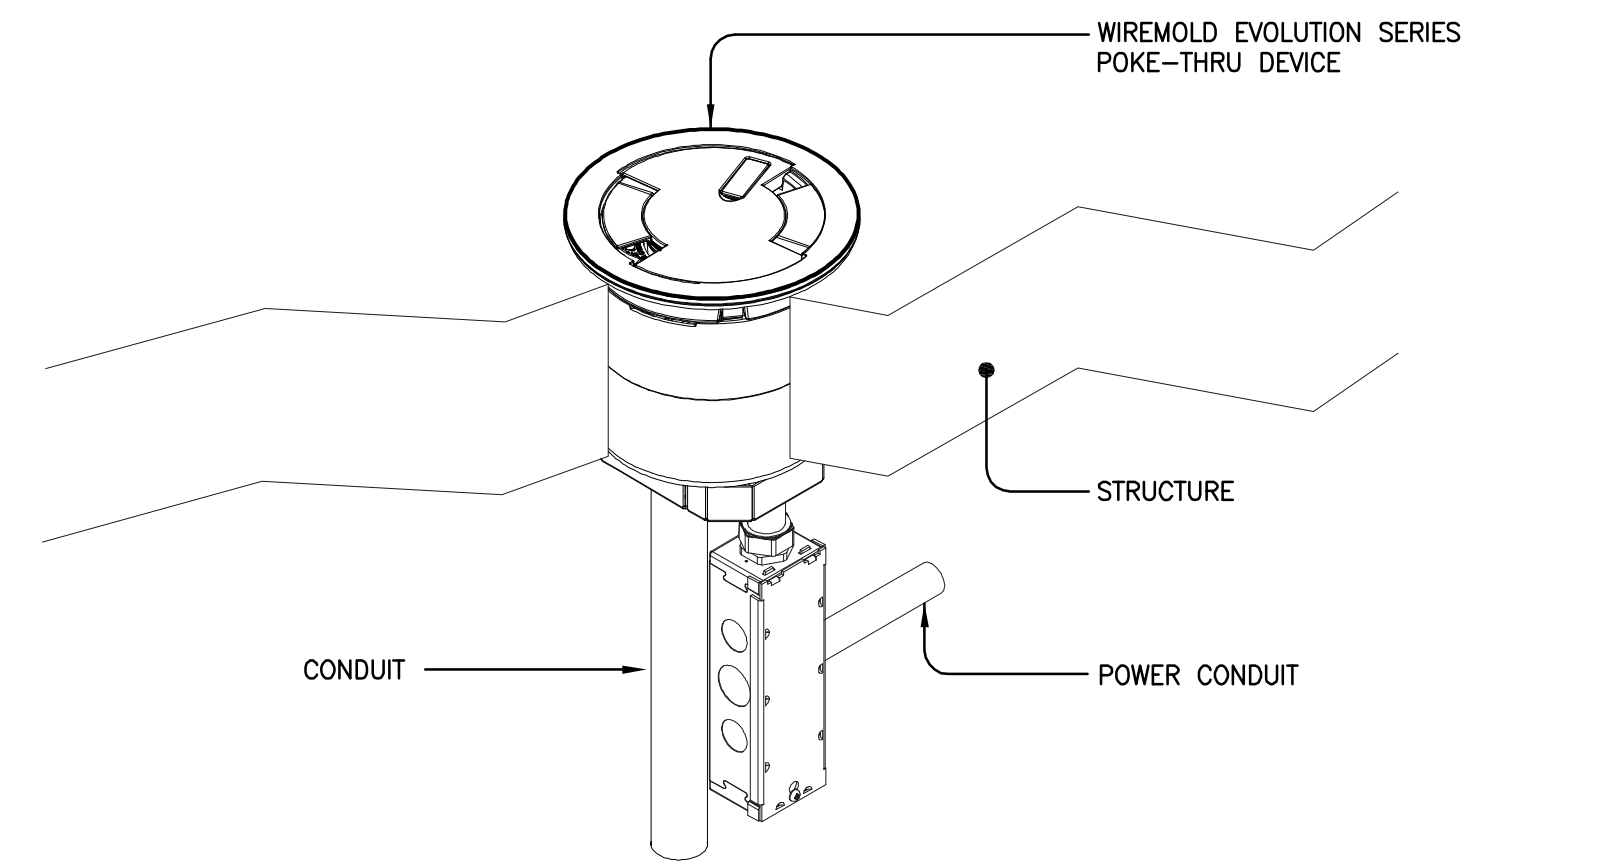

NOTE: POKE-THRU DEVICE AND COVER MANUFACTURED BY WIREMOLD WWW.WIREMOLD.COM/EVOLUTION

POKE-THRU 8
SCALE: NTS

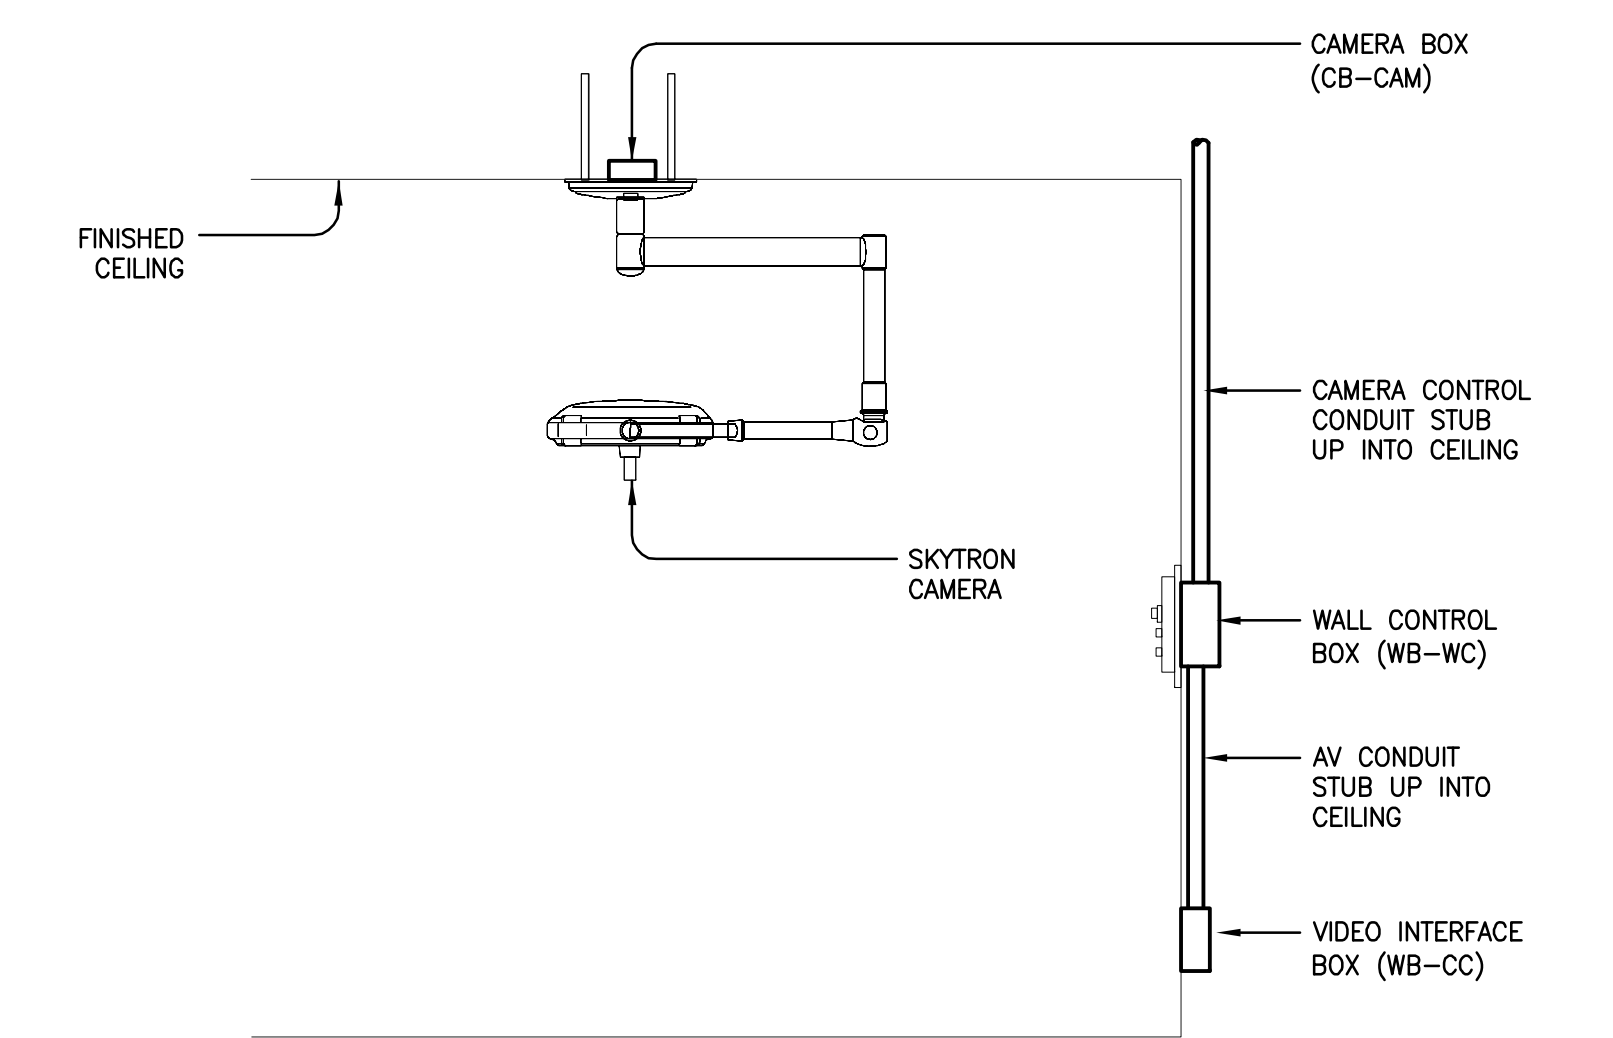

APPLICABLE TO SYMBOL: [Symbol]

SKYTRON CAMERA 12
SCALE: NTS

WRNSSTUDIO.LP
801 SECOND STREET
4TH FLOOR, STE. 402
SAN FRANCISCO
CALIFORNIA 94107
415.489.2224 TEL
415.358.9100 FAX
WWW.WRNSSTUDIO.COM

Steinberg Architects

Hensel Phelps Construction Co.

DECKER ELECTRIC

TELECOM DESIGN GROUP
1333 BROADWAY STE 601
OAKLAND CA 94612
510-337-2800
510-337-2804 FAX
www.tcom.com

NO.	ISSUES/REVISIONS	DATE
1	100% SCHEMATIC DESIGN SUBMITTAL	04/28/08
2	50% DESIGN DEVELOPMENT SUBMITTAL	06/13/08
3	100% DESIGN DEVELOPMENT SUBMITTAL	07/28/08
4	DSA INCREMENT #1: SITE DEMOLITION, EXCAVATION, ROUGH GRADING & UTILITIES	09/25/08
5	INCREMENT 2 80% REVIEW	10/10/08
6	DSA INCREMENT #2: STRUCTURE & SPRIG PANELS	11/11/08
7	DSA INCREMENT #3 50% REVIEW	11/11/08
8	DSA INCREMENT #1: BACK CHECK	11/18/08
9	DSA INCREMENT #3: 90% REVIEW	12/18/08
10	DSA INCREMENT #3: TENANT IMPROVEMENT & ROOFING SYSTEM	02/09/09
11	DSA INCREMENT #2: BACK-CHECK	03/11/09
12	DSA INCREMENT #3: BACK-CHECK	05/12/09
13	PROJECT RECORD SET	01/31/11

PROJECT RECORD SET

SKYLINE COLLEGE
CIP2 DESIGN-BUILD
BUILDING 4N

PROJECT NO: DRAWN BY: WAC
DATE: 01/31/11 CHECKED BY: APA
SCALE: NONE


SHEET TITLE:
**AUDIOVISUAL
DETAILS**

SHEET NO: TA-501

All drawings and written material appearing herein constitute original and unpublished work of the Architect/Engineer and may not be duplicated, used or disclosed without consent of Architect/Engineer. If this drawing is not 30"x42", then the drawing has been revised from its original size. Noted scales must be adjusted. This line should be equal to one inch.

NO.	ISSUES/REVISIONS	DATE
1	100% SCHEMATIC DESIGN SUBMITTAL	04/28/08
2	50% DESIGN DEVELOPMENT SUBMITTAL	06/13/08
3	100% DESIGN DEVELOPMENT SUBMITTAL	07/28/08
4	DSA INCREMENT #1 SITE DEMOLITION, EXCAVATION, ROUGH GRADING & UTILITIES	09/25/08
5	INCREMENT 2 80% REVIEW	10/10/08
6	DSA INCREMENT #2, STRUCTURE & SPRIG PANELS	11/11/08
7	DSA INCREMENT #3 50% REVIEW	11/11/08
8	DSA INCREMENT #1: BACK CHECK	11/18/08
9	DSA INCREMENT #3: 90% REVIEW	12/18/08
10	DSA INCREMENT #3, TENANT IMPROVEMENT & ROOFING SYSTEM	02/09/09
11	DSA INCREMENT #2: BACK-CHECK	03/11/09
12	DSA INCREMENT #3: BACK-CHECK	05/12/09
13	PROJECT RECORD SET	01/31/11

PROJECT RECORD SET

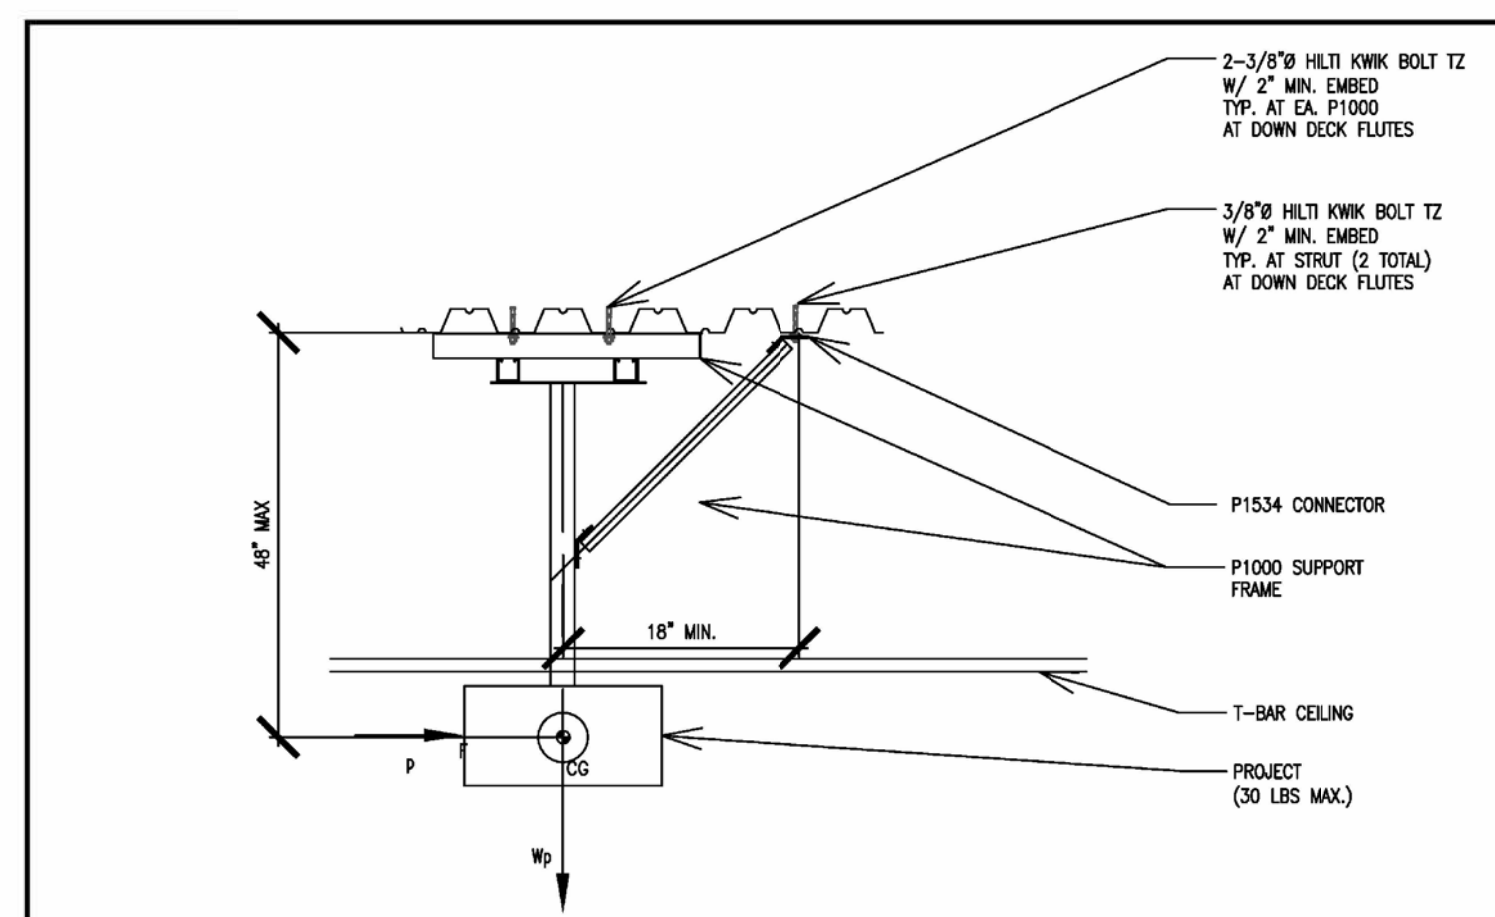


- SCHEDULE NOTES:**
- USE HELIX BOLT TZ ANCHORS INSTALLED IN CONCRETE WITH F=3000 PSI MIN (NORMAL OR LIGHT WEIGHT) AND INSTALL PER MANUFACTURERS PUBLISHED INSTRUCTIONS AND PER ESR 1897.
 - FOR INTERIOR INSTALLATIONS USE CARBON STEEL ANCHORS AND FOR EXTERIOR INSTALLATIONS USE STAINLESS STEEL ANCHORS.
 - ANCHORS MUST BE INSTALLED IN HOLES DRILLED INTO THE CONCRETE WITH CARBON TIPPED MASONRY DRILL BITS COMPLYING WITH ANSI B213.12-1994. THE NOMINAL DRILL BIT DIAMETER MUST BE EQUAL TO THAT OF THE ANCHOR AND THE DRILL HOLE MUST EXCEED THE DEPTH OF THE ANCHOR ENGAGEMENT BY AT LEAST ONE ANCHOR DIAMETER TO PERMIT OVERLAPPING OF ANCHORS AND TO PROVIDE A DUST COLLECTION AREA AS REQUIRED. THE ANCHOR MUST BE HAMMERED INTO THE PREDRILLED HOLE UNTIL AT LEAST FOUR THREADS ARE BELOW FINISH SURFACE. THE NUT MUST BE TIGHTENED AGAINST THE WASHER UNTIL THE ABOVE LISTED TORQUE VALUES ARE ACHIEVED.
 - FOR INSTALLATION IN THE SPOT OF CONCRETE ON STEEL DECK ASSEMBLY, THE HOLE DIAMETER IN THE STEEL DECK SHALL NOT EXCEED THE DIAMETER OF THE HOLE IN THE CONCRETE BY MORE THAN 1/8\".



PROJECT:
SKYLINE - CIP2, BLDG 4

CUSTOMER:
DECKER ELECTRIC



REV. 2
05/13/2009
Page
S7

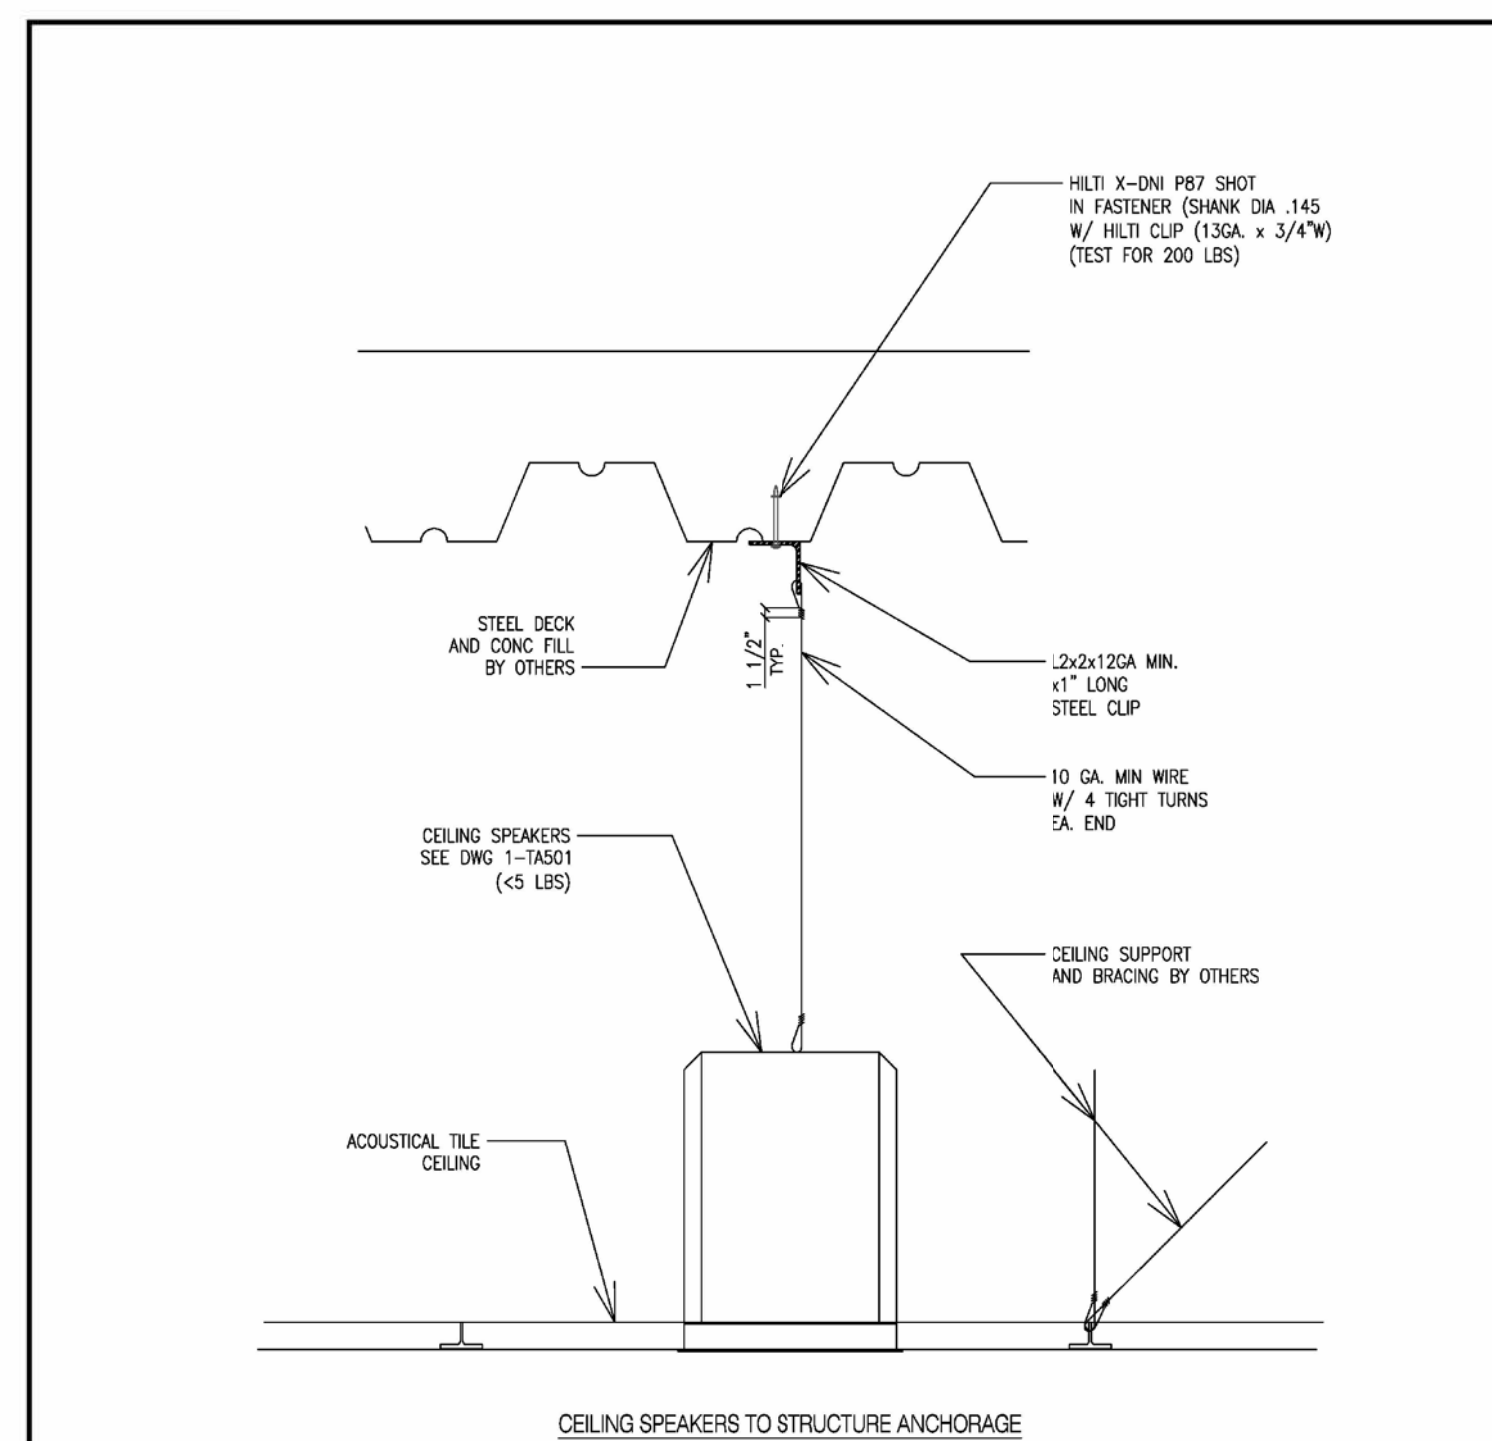

PROJECT:
SKYLINE - CIP2, BLDG 4

CUSTOMER:
DECKER ELECTRIC

REV. 2
05/13/2009
Page
S6

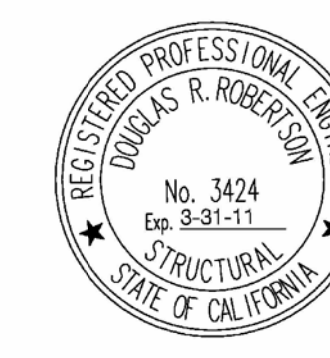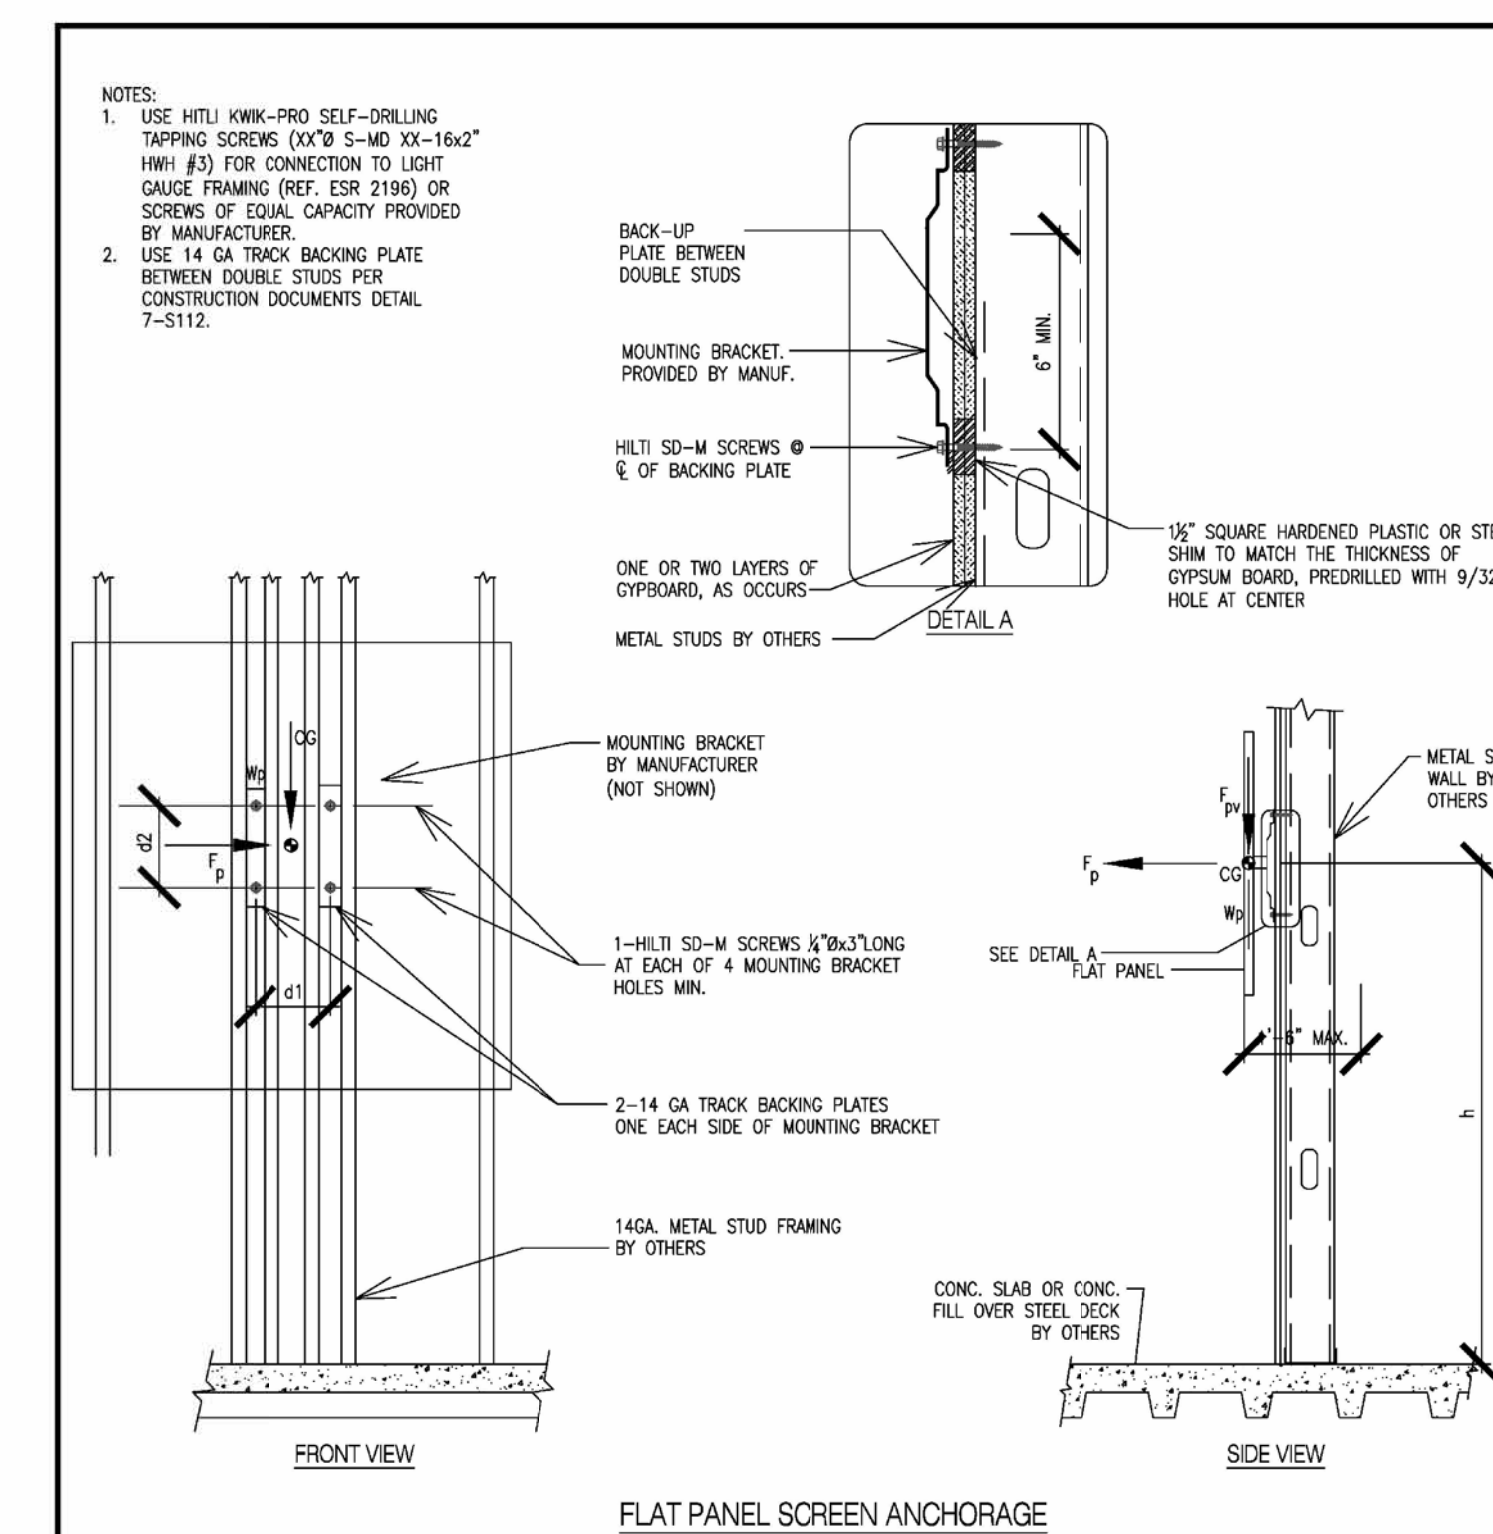

PROJECT:
SKYLINE - CIP2, BLDG 4

CUSTOMER:
DECKER ELECTRIC

REV. 2
05/13/2009
Page
S5

SKYLINE COLLEGE CIP2 DESIGN-BUILD BUILDING 4N

PROJECT NO.:
DATE: 01/31/11
SCALE: NONE

DRAWN BY: WAC
CHECKED BY: APA

SHEET TITLE:
AUDIOVISUAL DETAILS