




1 INTERIOR ELEVATIONS MEN'S LOCKER ROOM SCALE: 1/4"=1'-0"

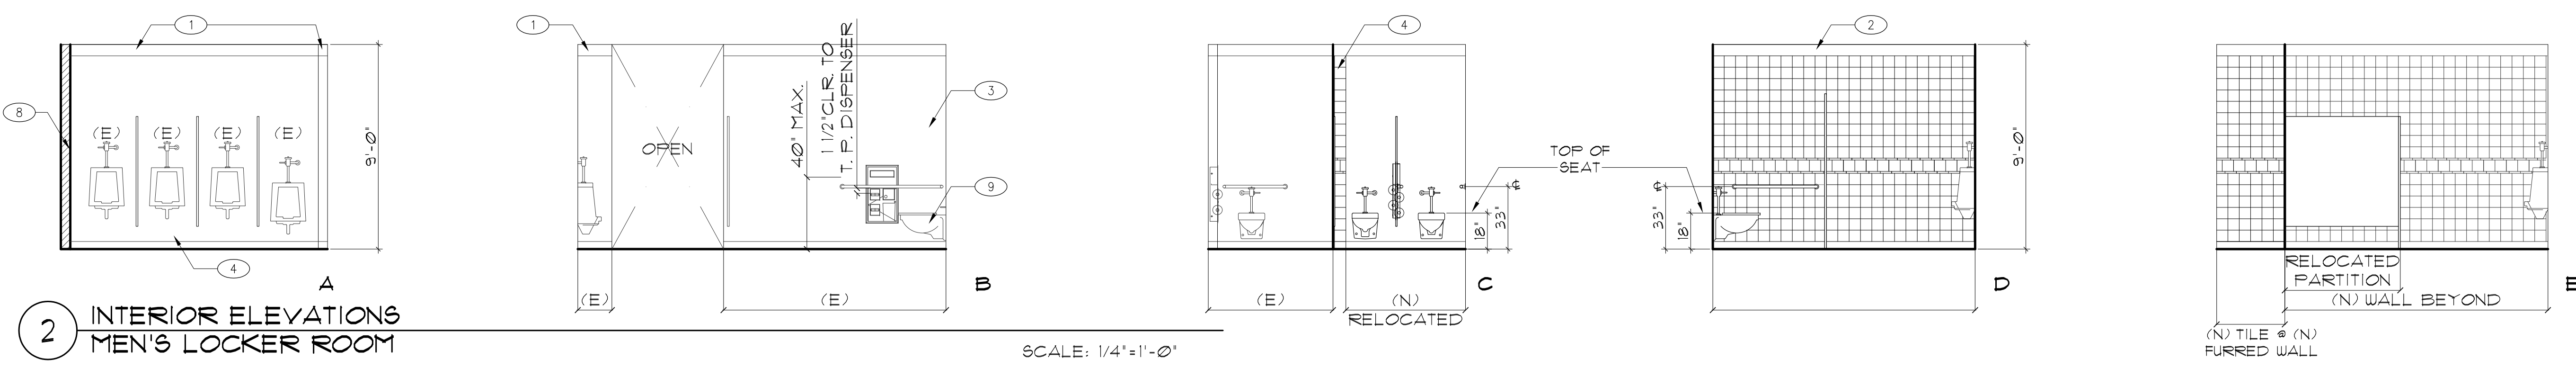


2 INTERIOR ELEVATIONS MEN'S LOCKER ROOM SCALE: 1/4"=1'-0"

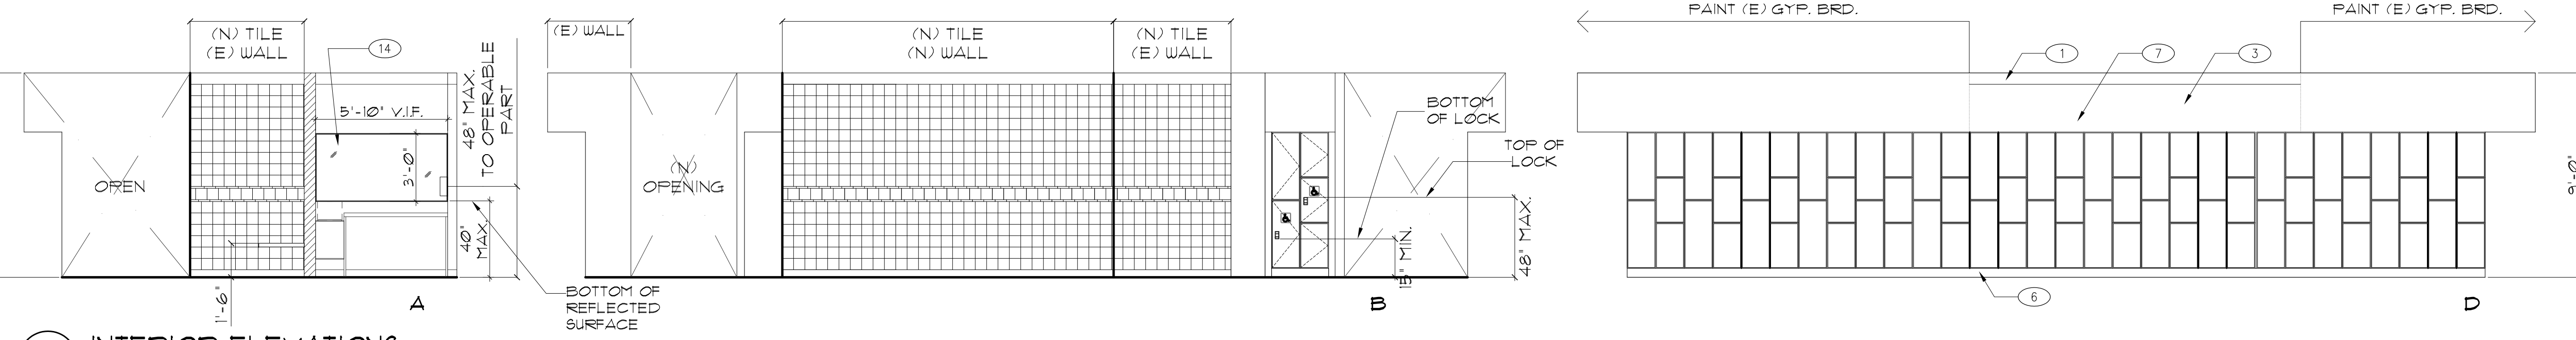

3 INTERIOR ELEVATIONS MEN'S LOCKER ROOM SCALE: 1/4"=1'-0"

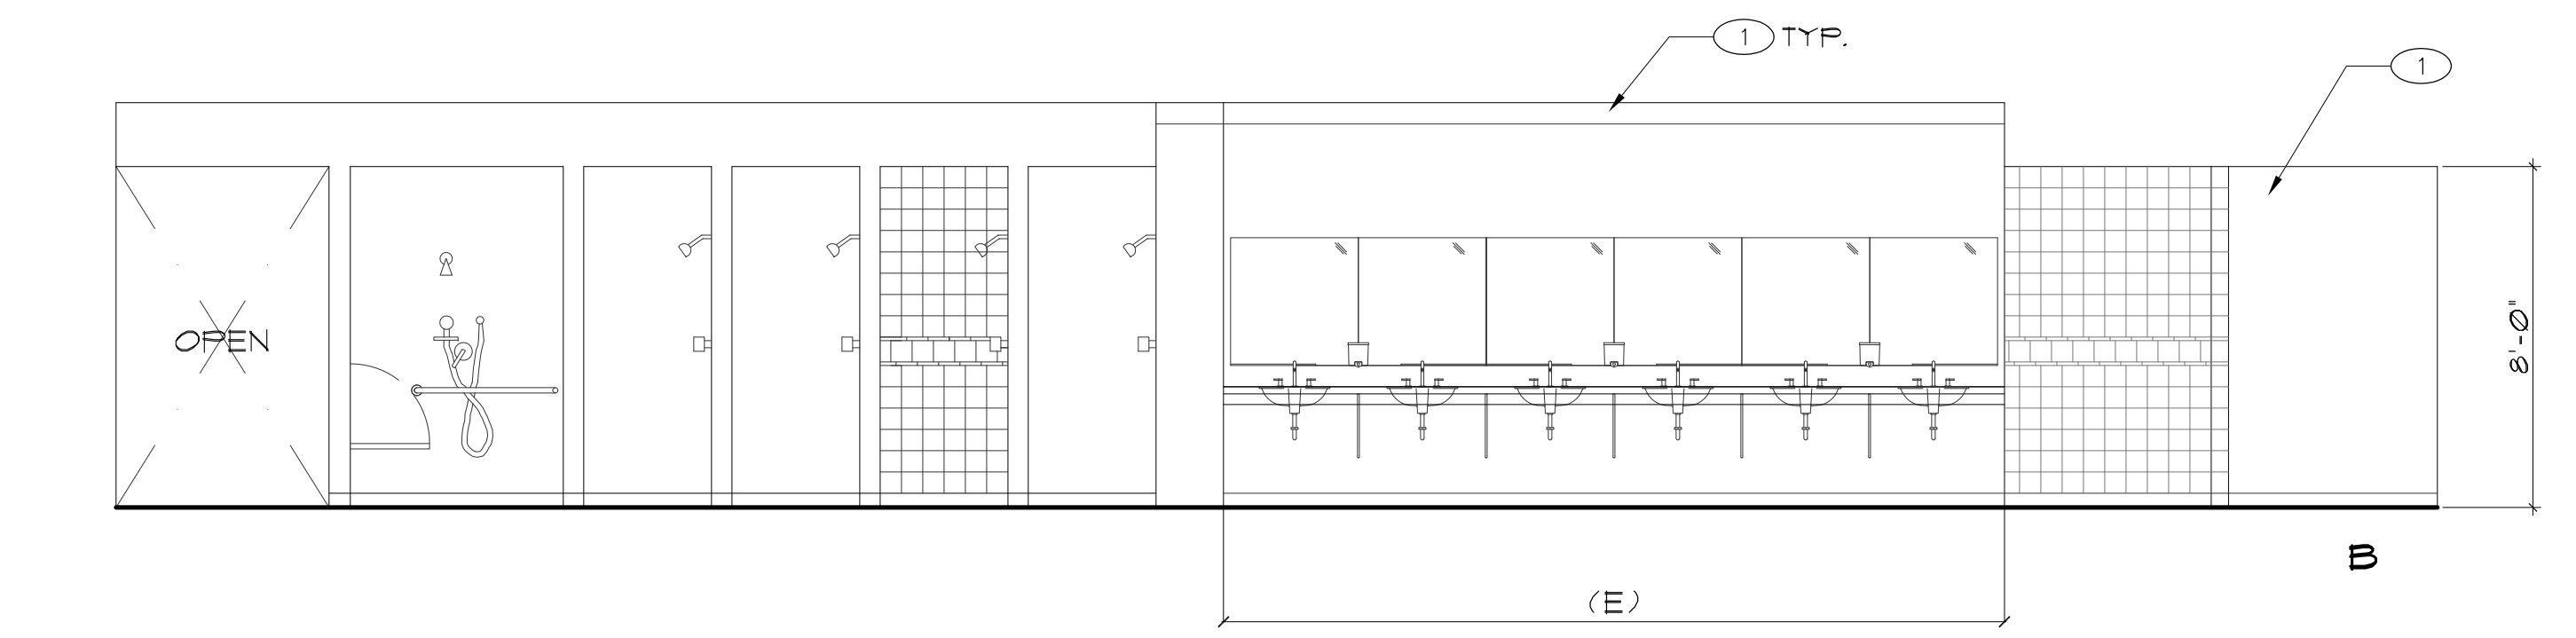

4 INTERIOR ELEVATIONS MEN'S LOCKER ROOM SCALE: 1/4"=1'-0"

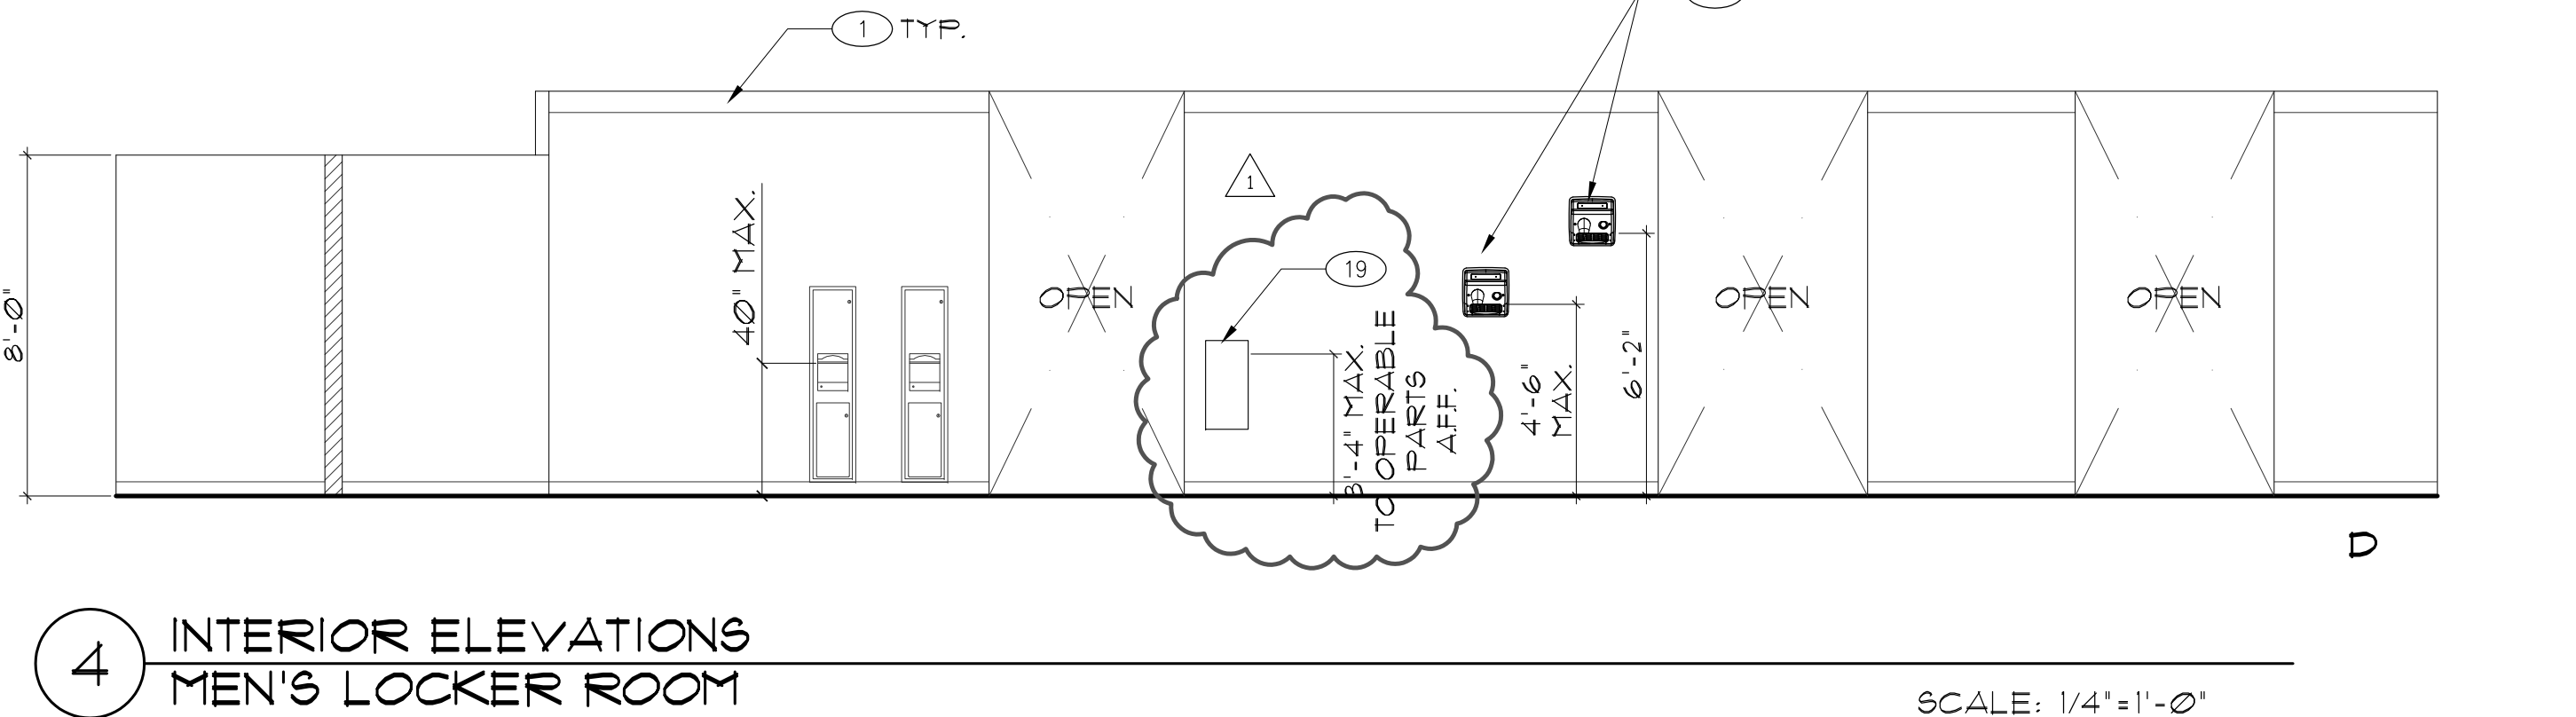

4 INTERIOR ELEVATIONS MEN'S LOCKER ROOM SCALE: 1/4"=1'-0"

**COLOR LEGEND**

- (P) PAINT TO MATCH EXISTING
- (TW) FIELD: 0120 ARCTIC WHITE TO MATCH (E)
- (TL) LINER: 0120 ARCTIC WHITE TO MATCH (E)
- (TA) ACCENT: 0120 ARCTIC WHITE TO MATCH (E)
- (TB) COVER TILE BASE: D311 BLACK TO MATCH (E)



5 TYPICAL FULL HEIGHT CERAMIC WALL SCALE: 1/4"=1'-0"

**GENERAL NOTES**

1. IF THE CONTRACTOR FINDS CONFLICTS IN THE DRAWINGS HE SHALL NOTIFY THE ARCHITECT IN WRITING AND OBTAIN CLARIFICATION BEFORE PROCEEDING WITH THE WORK IN QUESTION.
2. DO NOT OBTAIN CONSTRUCTION DIMENSIONS BY MEASURING OR SCALING THE DRAWINGS. USE NUMERICAL DIMENSIONS NOTED ON THE DRAWINGS. OBTAIN DIMENSIONS NEEDED BUT NOT NOTED ON THE DRAWINGS FIRST BY ARITHMETIC. IF THE CONFLICTS ARISE, NOTIFY THE ARCHITECT PRIOR TO PROCEEDING WITH THE WORK.
3. NOTES AND SYMBOLS ARE TO APPLY AT ALL AREAS OF SIMILAR GRAPHIC REPRESENTATION. SUCH INDICATION MAY BE LIMITED TO PROMOTE CLARITY OR AVOID REDUNDANCY. NO LIMITATION OF APPLICATION SHALL BE CONSTRUCTED WITHOUT SPECIFIC NOTIFICATION.
4. REFER TO ELECTRICAL DRAWINGS FOR HORNS, SPEAKERS, AND OTHER FEATURES NOT OTHERWISE SHOWN.
5. REFER TO MECHANICAL DRAWINGS FOR REGISTERS AND VENTS NOT OTHERWISE SHOWN.

**KEY NOTES**

 
- 1 (E) GYPSUM BOARD, PAINTED, TO MATCH (E)
- 1A (E) GYPSUM BOARD, PREP. AND PAINT, TO MATCH
- 2 (N) GYPSUM BOARD, PAINTED
- 3 (E) TILE TO REMAIN (TYP.)
- 4 (N) TILE TO MATCH (E), SEE 5/A-11
- 5 (E) TILE COVE BASE
- 6 (N) TILE COVE BASE TO MATCH (E), SEE 5/A-11
- 7 (N) LOCKERS, N.I.C. OWNER PROVIDE AND INSTALL CONTRACTOR TO COORDINATE
- 8 (N) WALL
- 9 (E) TOILET
- 10 (N) ELECTRIC HAIR DRYER
- 11 PATCH WALL W/ TILE TO MATCH (E)
- 12 LIGHT COVE IN FRONT
- 13 (N) PAPER TOWEL DISPENSER
- 14 (N) MIRROR
- 14A RELOCATED (E) MIRROR
- 15 RELOCATED RECESSED PAPER TOWEL DISPENSE
- 16 (N) RECESSED FEMININE NAPKIN DISPENSER
- 17 (N) OPENING TOWEL CHUTE
- 18 (N) BACK SPLASH, SEE 9/A-93
- 19 (N) DYSON AIR BLADE HAND DRYER

**SYMBOL LEGEND**



**REVISIONS**

NO	DESCRIPTION	DATE
01	D&A SUBMITTAL	8-31-2012
02	D&A BACKCHECK/ADDENDUM A	9-20-2012
1	ADDENDUM 1	9-26-2012



Sally Swanson Architects, Inc.

**SSA**  
 220 Sansome St, Suite 1100  
 San Francisco, CA 94104  
 Tel: 415.445.3045  
 Fax: 415.445.3055  
 ssa@swanarch.com

Architecture  
 Planning  
 Accessible Design

**ARCHITECT STAMP**

DATE: 9/20/2012

STATE OF CALIFORNIA

**D&A APPROVAL**

IDENTIFICATION STAMP  
 DIVISION OF THE STATE ARCHITECT

APPL. NO. 01-112844


AC, DB, FLS, DM/ED/SS, AK  
 DATE: 9/20/2012

**PROJECT**  
 COLLEGE OF SAN MATEO  
 CSM HEALTH & WELLNESS BLD. 5  
 1ST FLR LOCKER ROOMS RENOVATION  
 1100 W. HILLCREST BLVD.  
 SAN MATEO, CA 94403


**DRAWING TITLE**  
 INTERIOR ELEVATIONS

**SCALE:** 1/4"=1'-0"


<b>JOB NUMBER</b> 12042	<b>DRAWING NUMBER</b> A-7.1
<b>DRAWN BY</b> C.V. & S.C.	
<b>CHECKED BY</b> J.F.	
<b>DATE</b> 09/20/2012	<b>SHEET NO.</b> 9 <b>OF</b> 12

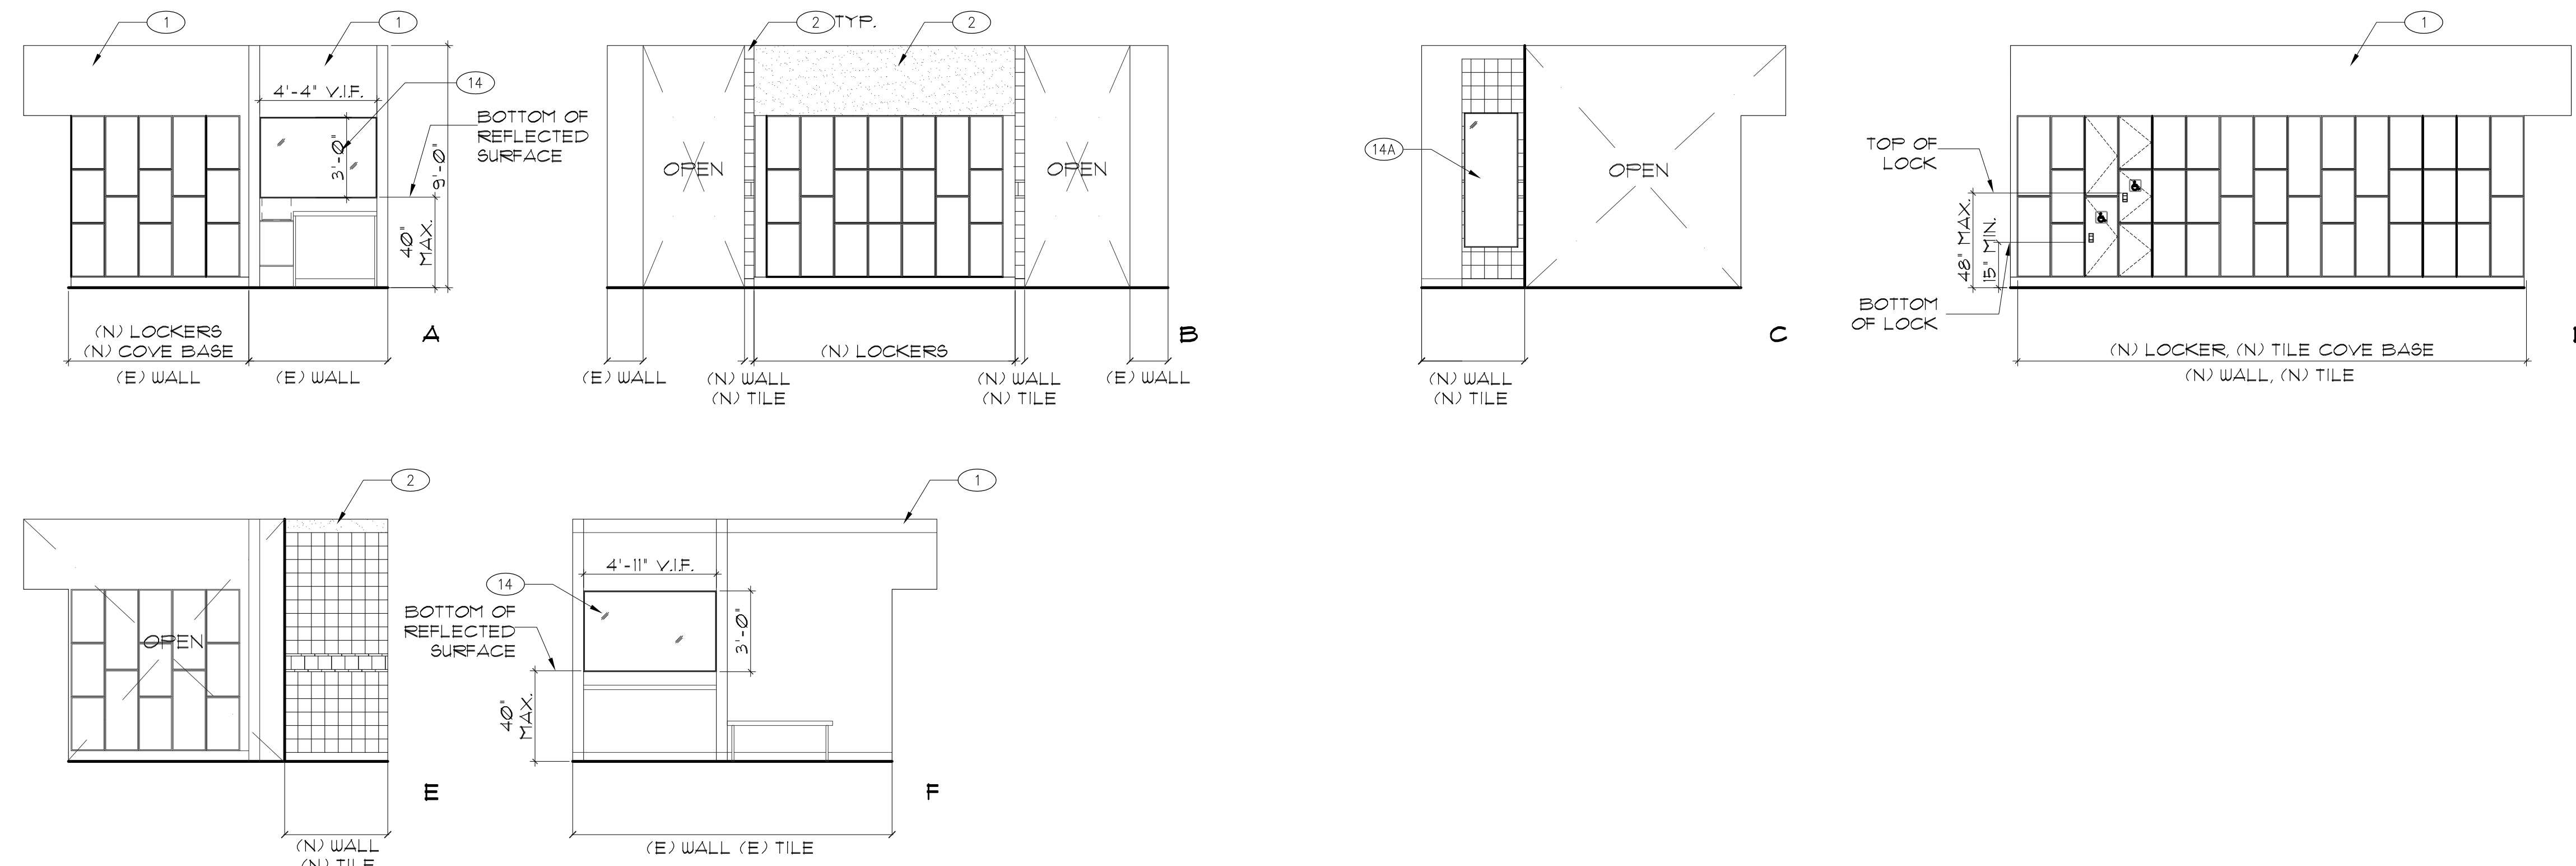


1 INTERIOR ELEVATIONS WOMEN'S LOCKER ROOM SCALE: 1/4"=1'-0"

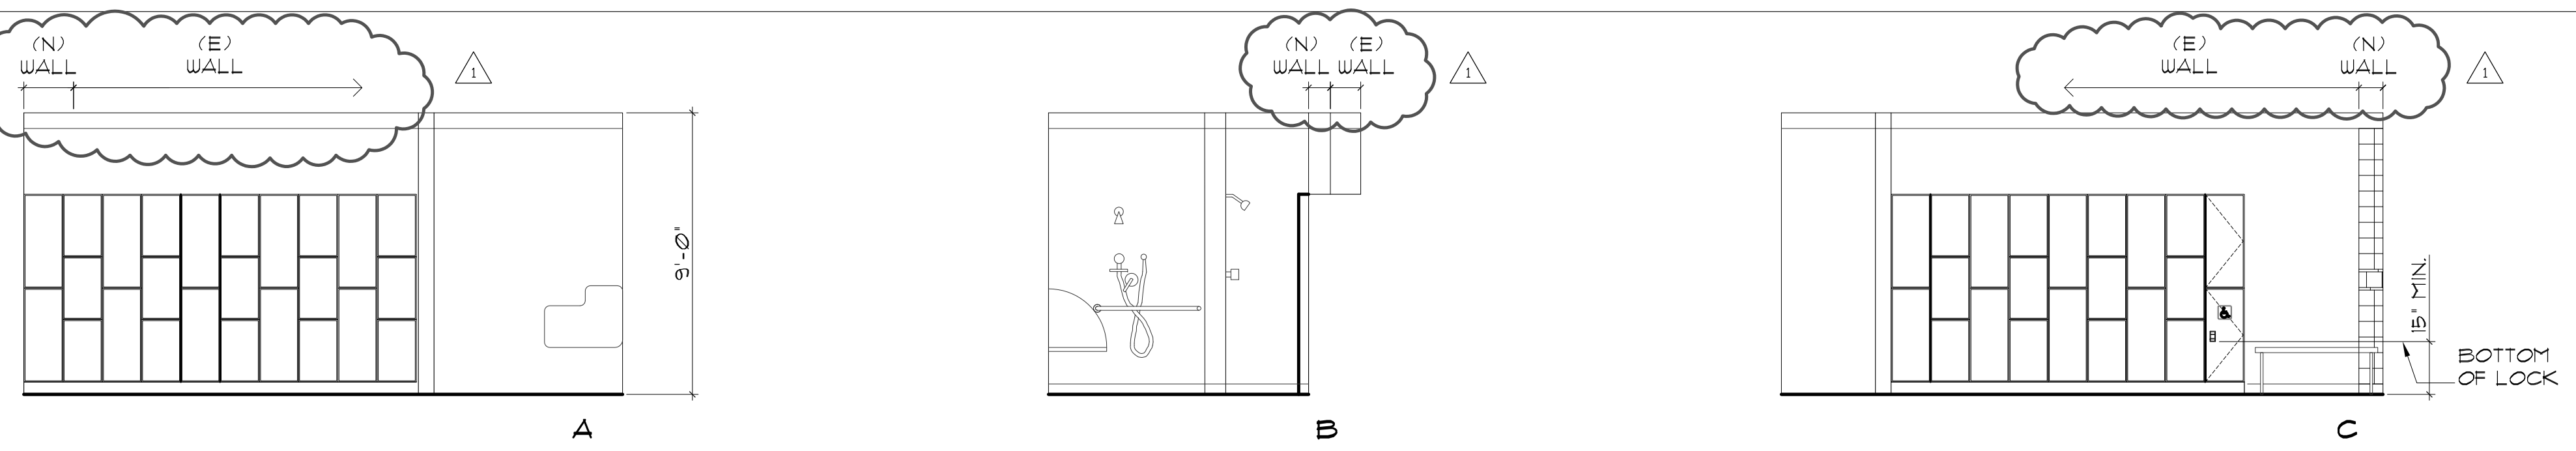

2 INTERIOR ELEVATIONS WOMEN'S LOCKER ROOM SCALE: 1/4"=1'-0"

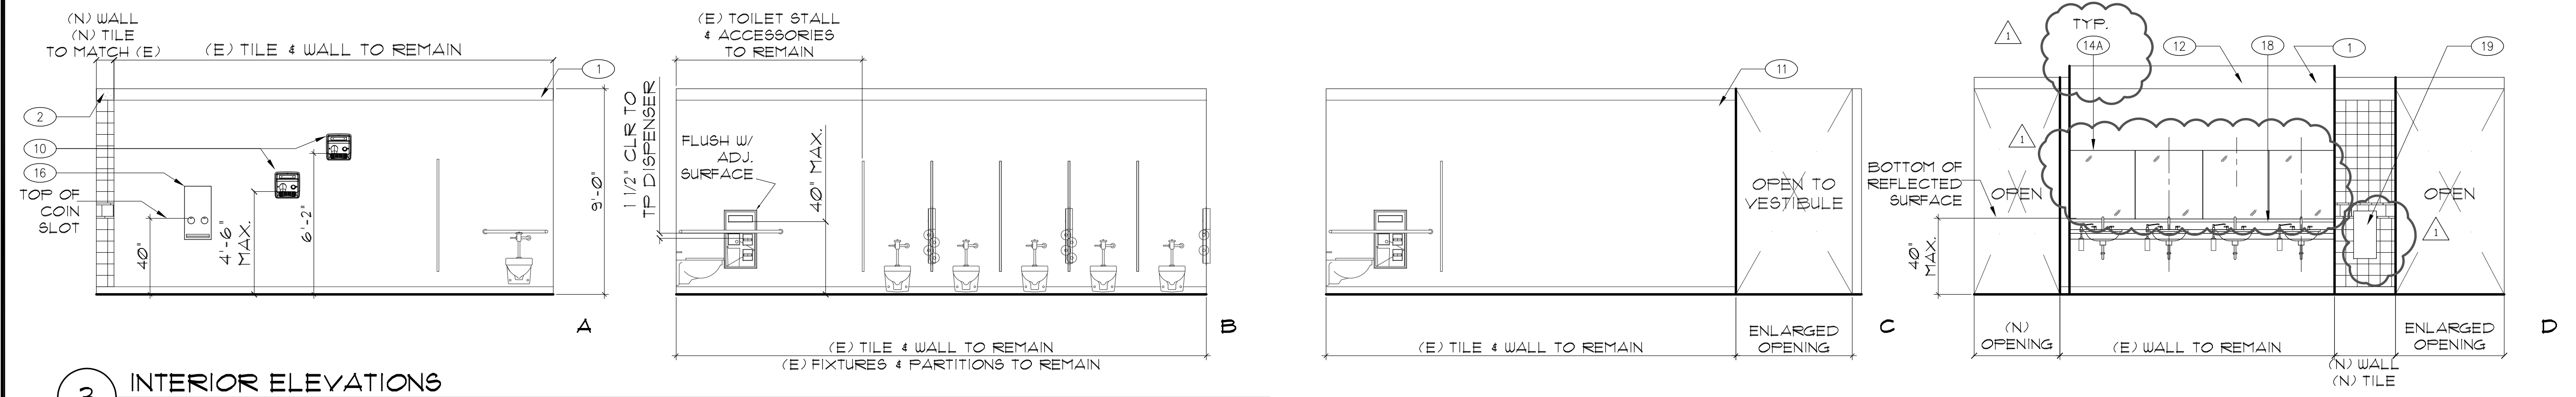

3 INTERIOR ELEVATIONS WOMEN'S LOCKER ROOM SCALE: 1/4"=1'-0"

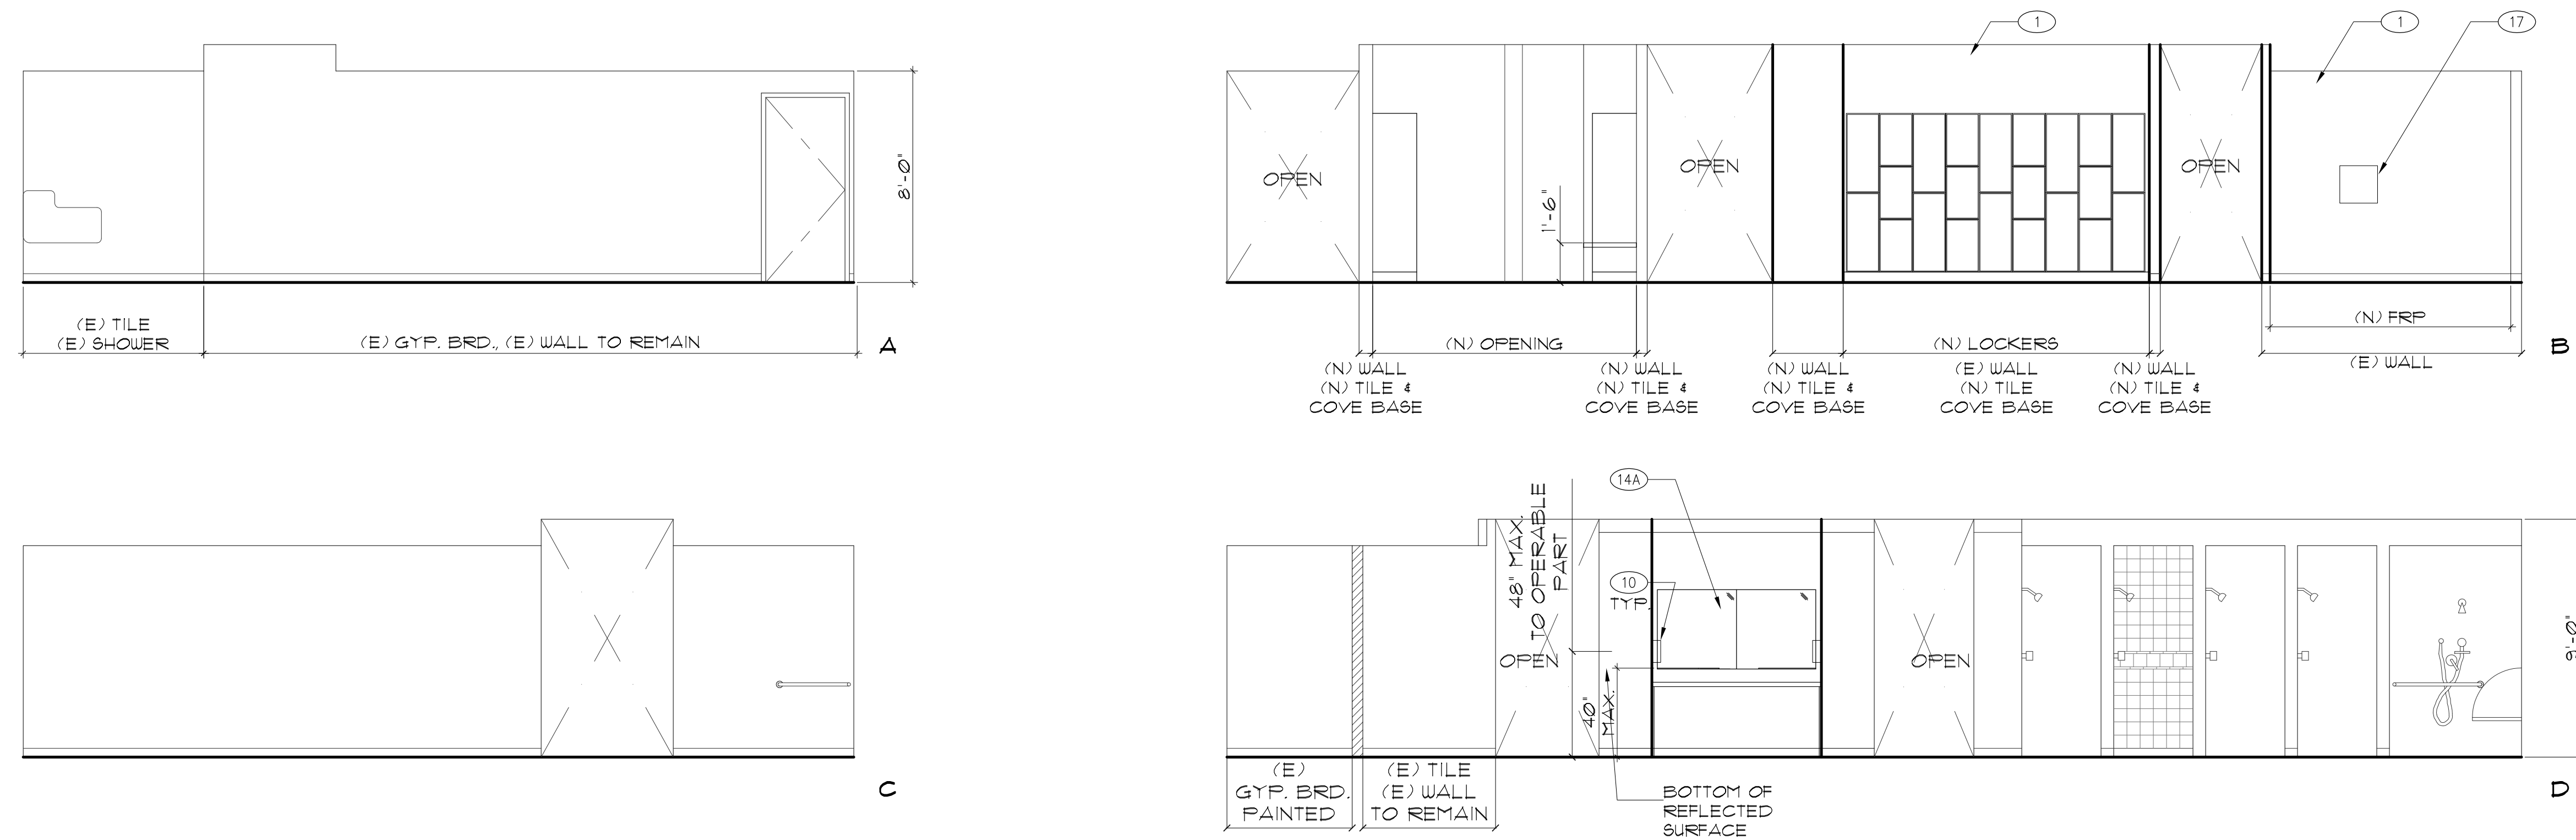

4 INTERIOR ELEVATIONS WOMEN'S LOCKER ROOM SCALE: 1/4"=1'-0"

GENERAL NOTES

- IF THE CONTRACTOR FINDS CONFLICTS IN THE DRAWINGS HE SHALL NOTIFY THE ARCHITECT IN WRITING AND OBTAIN CLARIFICATION BEFORE PROCEEDING WITH THE WORK IN QUESTION.
- DO NOT OBTAIN CONSTRUCTION DIMENSIONS BY MEASURING OR SCALING THE DRAWINGS. USE NUMERICAL DIMENSIONS NOTED ON THE DRAWINGS. OBTAIN DIMENSIONS NEEDED BUT NOT NOTED ON THE DRAWINGS FIRST BY ARITHMETIC. IF THE CONFLICTS ARISE, NOTIFY THE ARCHITECT PRIOR TO PROCEEDING WITH THE WORK.
- NOTES AND SYMBOLS ARE TO APPLY AT ALL AREAS OF SIMILAR GRAPHIC REPRESENTATION. SUCH INDICATION MAY BE LIMITED TO PROMOTE CLARITY OR AVOID REDUNDANCY. NO LIMITATION OF APPLICATION SHALL BE CONSTRUCTED WITHOUT SPECIFIC NOTIFICATION.
- REFER TO ELECTRICAL DRAWINGS FOR HORNS, SPEAKERS, AND OTHER FEATURES NOT OTHERWISE SHOWN.
- REFER TO MECHANICAL DRAWINGS FOR REGISTERS AND VENTS NOT OTHERWISE SHOWN.



KEY NOTES

- 1 (E) GYPSUM BOARD, PAINTED, TO MATCH (E)
- 1A (E) GYPSUM BOARD, PREP. AND PAINT, TO MATCH
- 2 (N) GYPSUM BOARD, PAINTED
- 3 (E) TILE TO REMAIN (TYP.)
- 4 (N) TILE TO MATCH (E), SEE 5/A-11
- 5 (E) TILE COVE BASE
- 6 (N) TILE COVE BASE TO MATCH (E) SEE 5/A-11
- 7 (N) LOCKERS, N.I.C. OWNER PROVIDE AND INSTALL. CONTRACTOR TO COORDINATE
- 8 (N) WALL
- 9 (E) TOILET
- 10 (N) ELECTRIC HAIR DRYER
- 11 PATCH WALL W/ TILE TO MATCH (E)
- 12 LIGHT COVE IN FRONT
- 13 (N) PAPER TOWEL DISPENSER
- 14 (N) MIRROR
- 14A RELOCATED (E) MIRROR
- 15 RELOCATED RECESSED PAPER TOWEL DISPENSER
- 16 (N) RECESSED FEMININE NAPKIN DISPENSER
- 17 (N) OPENING TOWEL CHUTE
- 18 (N) BACK SPLASH, SEE 3/A-23
- 19 (N) DYSON AIR BLADE HAND DRYER

SYMBOL LEGEND



NO	DESCRIPTION	DATE
01	D&A SUBMITTAL	8-31-2012
02	D&A BACKCHECK/ADDENDUM A	9-20-2012
△	ADDENDUM I	9-26-2012

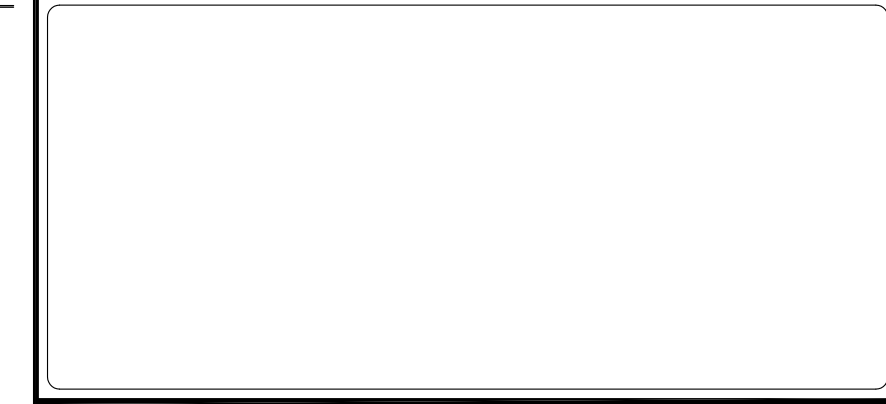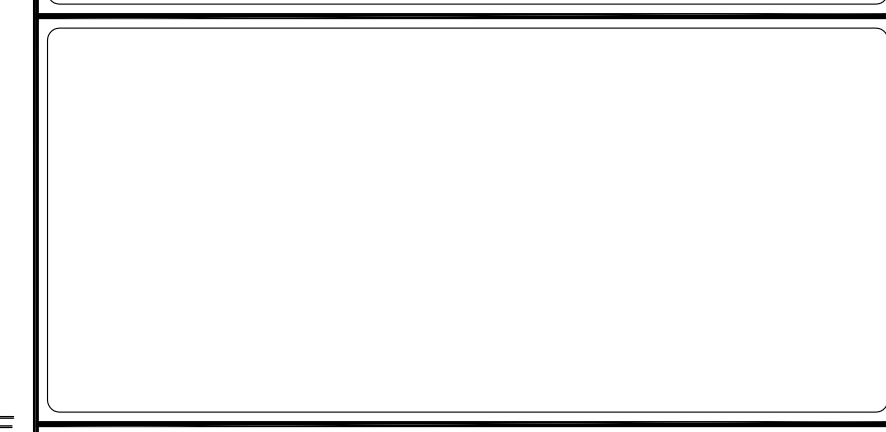

Sally Swanson Architects, Inc.

220 Sansome St, Suite 1100  
San Francisco, CA 94104  
Tel: 415.445.3045  
Fax: 415.445.3055  
ssa@swanarch.com

Architecture  
Planning  
Accessible Design

ARCHITECT STAMP

DATE: 9/20/2012

D&A APPROVAL

IDENTIFICATION STAMP  
DIVISION OF THE STATE ARCHITECT

APPL NO. 01-112844

AC\_DS ... FLS DM/ED/SS AK ...  
DATE: 9/20/2012

PROJECT  
COLLEGE OF SAN MATEO  
CSM HEALTH & WELLNESS BLD. 5  
1ST FLR LOCKER ROOMS RENOVATION  
1800 W. HILLCREST BLVD.,  
SAN MATEO, CA 94402

DRAWING TITLE  
INTERIOR ELEVATIONS

SCALE: 1/4"=1'-0"

JOB NUMBER 12042	DRAWING NUMBER A-7.2
DRAWN BY C.V. & S.C.	CHECKED BY J.F.
DATE 09/20/2012	SHEET NO. 10 OF 12

