

20D FLOOR PLAN
1/8"=1'-0"

FLOOR PLAN LEGEND


- 6" CURB - SEE WINDOW & DOOR SCHEDULES FOR CURB CONDITIONS @ EXTERIOR WINDOWS & DOOR
- FIBER ACOUSTICAL INSULATION - SEE A1.1 FOR LOCATIONS
- 5/8" GYP. BD. OVER 2x6 WOOD STUDS @ 16" O.C. - PROVIDE 1/2" RESILIENT CHANNELS ON INSIDE OF ROOM ONLY - SEE A1.1 FOR LOCATIONS

FLOOR PLAN NOTES

1. ALL DIMS ARE ϕ TO ϕ OF STUDS U.O.N.
2. ALL STUDS ARE 2X6 U.O.N.
3. ALL GYP. BD. IS 5/8" TYPE "X" U.O.N.
4. CONTRACTOR TO USE WATER RESISTANT GYP. BD. AT WET AREAS
5. SEE SHEET A1.1 FOR OPENINGS & MORE INFORMATION
6. SEE SHEET A4.0 & A4.1 FOR ENLARGED FLOOR PLANS OF TOILETS & KITCHEN
7. 10'-0" MARKER BOARD. PROVIDE BLOCKING FOR DISTRICT PROVIDED PROJECTOR SCREEN
8. RELOCATE CABINETS, SINKS, MICROWAVE AND UNDER COUNTER REFRIGERATOR FROM ROOM 04 TO ROOM 38
9. NEW ALUMINUM STOREFRONT WINDOW 3'-11" x 4'-5", SIMILAR TO WINDOW MARK 16. INSTALL WINDOW AS DIRECTED IN FIELD
10. WALL SECTION TO REMAIN TO ACCOMMODATE ELECTRIC OUTLET/JUNCTION BOX

NO.	DATE	REASON	BY
1	10/15/01	ADDENDUM#1	
2	10/26/01	ADDENDUM#2	
3	02/28/03	ADDENDUM#2	
4	3/17/03	CR #19	
5	5/20/03	CR #20	

ISSUE FOR PROGRESS REVIEW 01/15/01
 ISSUE FOR PLAN CHECK 01/25/01
 ISSUE FOR FINAL REVIEW 05/09/01
 ISSUE FOR BID
 ISSUE FOR CONSTRUCTION

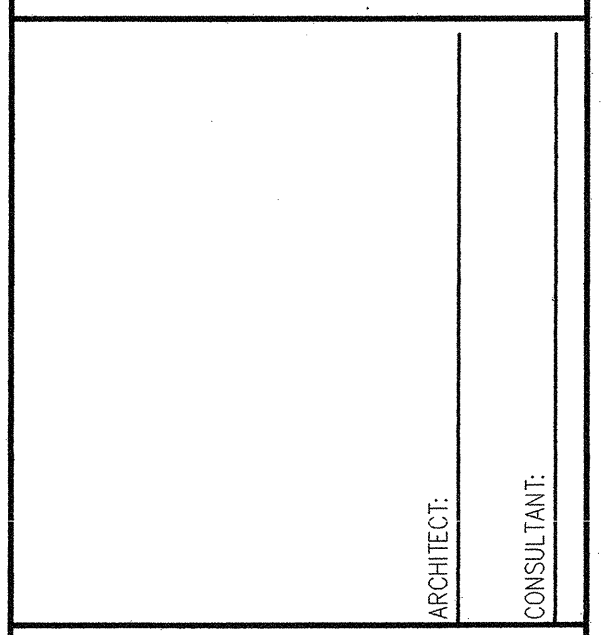

CONSULTANT:

ARCHITECT:
CIANFICHI
 ARCHITECTURE + PLANNING
 30 ANNE COURT
 WALNUT CREEK, CA 94598
 TEL: (925) 256-8638
 FAX: (925) 256-8652

PROJECT:
CHILD DEVELOPMENT CENTER
CAÑADA COLLEGE
 4200 FARM HILL BLVD.
 REDWOOD CITY, CA 94061
 SAN MATEO COUNTY COMMUNITY COLLEGE DISTRICT

STAMP:
 APPROVED
 DIV. OF THE STATE ARCHITECT
 AO: AG FLS: ED SS: SC
 APPL NO. 102529 DATE: 6-18-03

APPL. NUMBER:
 KEY PLAN:

SHEET TITLE:
FLOOR PLAN

AS-BUILTS

DRAWN BY: GL	PROJECT NO: 304-99
CHECKED BY: BA	DATE: 03/17/03
APPL. NO.:	SHEET: A1.0r
DATA NO.:	NO. OF: