


20D FLOOR PLAN - OPENINGS
1/8" = 1'-0"

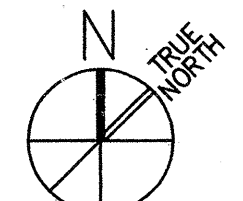

SEE SHEET NOTES A1.0r, DATED 5/20/03 DELTA 20

MILLWORK KEY

- ① WALL MTD. STORAGE UNITS (14" DEEP) - SIM. TO DETAIL 10Q/A6.3
- ①A STORAGE BINS (CUBBIES) (14" DEEP) - SEE DETAIL 10Q/A6.3
- ①B WALL MTD. STORAGE UNITS (24" DEEP) - SIM. TO DETAIL 10Q/A6.3
- ② CABINET W/SINK @ 34" A.F.F. W/O UPPER CABINETS - SIM. TO DETAIL 5A/A6.3
- ③ CABINET W/SINK @ 34" A.F.F. - SEE DETAIL 5A/A6.3
- ③A CABINET W/SINK @ 24" A.F.F. - SEE DETAIL 5A/A6.3
- ④ COUNTER @ 30" A.F.F. - SEE DETAIL 15A/A6.3


FLOOR PLAN LEGEND

- FIBER ACOUSTICAL INSULATION
- 5/8" GYP. BD. OVER 2x6 WOOD STUDS @ 16" O.C. - PROVIDE 1/2" RESILIENT CHANNELS ON INSIDE OF ROOM ONLY - SEE DTL. 12E/A6.1
- FIRE EXTINGUISHER CABINET - SEE DTL. 8E/A6.2

AS-BUILTS

NO.	DATE	REASON	BY
1	10/15/01	ADDENDUM#1	
2	10/26/01	ADDENDUM#2	
3	02/28/03	ADDENDUM#2	
4	3/17/03	CR #19	
5	5/20/03	CR #20	

ISSUE FOR PROGRESS REVIEW	01/15/01
ISSUE FOR PLAN CHECK	01/25/01
ISSUE FOR FINAL REVIEW	05/09/01
ISSUE FOR BID	
ISSUE FOR CONSTRUCTION	

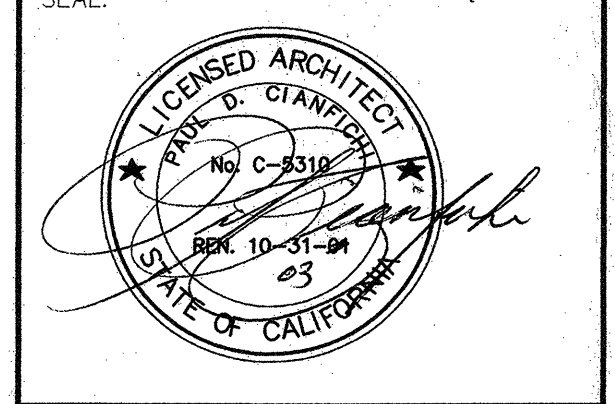

CONSULTANT:
ARCHITECT:
ARCHITECT:
CIANFICHI
ARCHITECTURE + PLANNING
30 ANNE COURT
WALNUT CREEK, CA 94598
TEL: (925) 256-8638
FAX: (925) 256-8652

PROJECT:
CHILD DEVELOPMENT CENTER
CAÑADA COLLEGE
4200 FARM HILL BLVD.
REDWOOD CITY, CA 94061
SAN MATEO COUNTY COMMUNITY COLLEGE DISTRICT

STAMP:
APPROVED
DIV. OF THE STATE ARCHITECT
AOL/SS/ED/SS
APPL NO. 102870, DATE 6.16.03

APPL. NUMBER:
KEY PLAN:

SHEET TITLE:
FLOOR PLAN - OPENINGS

DRAWN BY: CL	PROJECT NO.: 304.99
CHECKED BY: BA	DATE: 03/17/03
APPL. NO.:	SHEET: A1.1ar
DATA NO.:	NO. OF: