
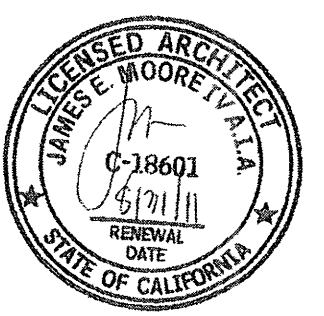


REF-67

FCD 60R2  
FILE NO. 43-C1  
APPL. NO. 01-110074

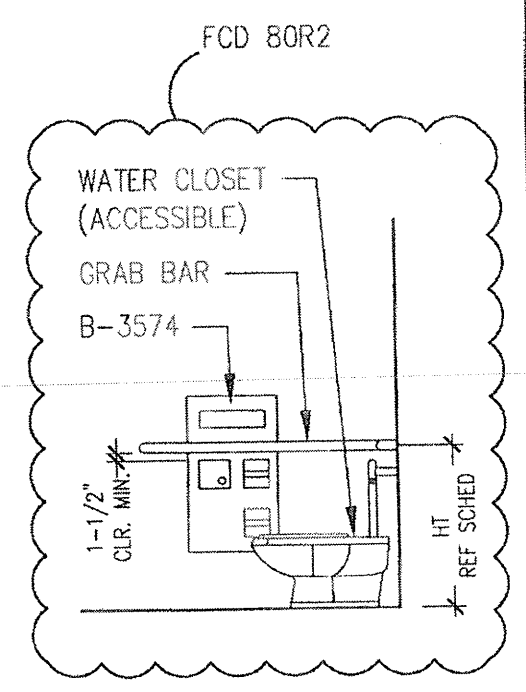

**1 B-3574 MOUNTING HEIGHT**  
 REF.: ADDED TO 30/A10.62 TOILET ACCESSORIES MOUNTING SCHEDULE SCALE: NTS