

6/10/10: Field walk to determine wall types. See A2.1.

RFI-212

RFI-299 Elevator Recall

RFP-22 Relocate Casework & Plumb

RFI-76 Wall Tags

RFI-266 Recessed Slab Depth

RFI-314 Adv. Reception

RFI-35 ASI-4


RFI-78

RFP-13

RFP-25

RFP-25

SECOND FLOOR PLAN

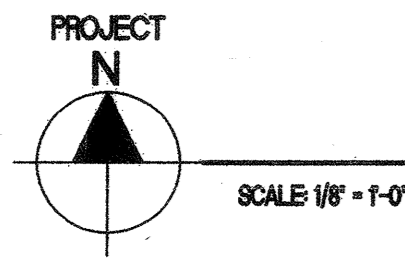

SHEET NOTES

- 2 FIRE EXTINGUISHER (20AB10C) IN SEMI-RECESSED CABINET (SEE DETS 25/A10.52 & 11/A10.62)
- 3 BASE CABINET. (SEE DET. 3/A10.62)
- 4 UPPER CABINET. (SEE DET. 3/A10.62)
- 5 FULL HEIGHT CABINET. (SEE DET. 5/A10.62)
- 6 ACCESSIBLE BASE CABINET W/ SINK. (SEE DET. 1/A10.62)
- 7 SIDE-BY-SIDE REFRIGERATOR SPACE (EQUIPMENT N.I.C.)
- 23 ROLLER SHADES
- 37 (E) CONCRETE COLUMN TO REMAIN
- 38 HI-LO DRINKING FOUNTAIN (SEE DETS. 13, 14, 18 & 19/A10.62)
- 40 ELECTRONIC WHITEBOARD. (SEE DET. 12/A10.62)
- 44 (E) MOP SINK TO REMAIN
- 50 COUNTER (OPEN BELOW) (SEE DET. 10/A10.62)
- 51 REPLACEMENT NOSING W/ CONTRASTING COLOR STRIPS AT (E) CONCRETE STAIRS, TYP. (SEE DET. 17/A10.21)
- 56 MECHANICAL EQUIPMENT, SEE MECH. PLANS
- 57 OPOI CASEWORK AND DUPLICATION EQUIPMENT
- 58 CONCRETE RAMP AND RAILINGS. (SEE DET. 10/A10.21)
- 59 FIXED SHELVES
- 61 (E) ELEVATOR TO REMAIN
- 62 16'-0" W. MARKER BOARD W/ TOP OF MARKER TRAY @ 36" A.F.F. (SEE DETS. 22, 23/A10.51)
- 78 SWINGING GATE FOR EXIT CONTROL. (SEE DET. 19/A10.21)
- 81 MODIFY (E) METAL GUARDRAIL. (SEE DET. 11/A10.21)
- 82 8'-0" W. TACKBOARD
- 83 4'-0" W. TACKBOARD
- 90 ADA-COMPLIANT HANDRAILS. DET 1/A10.21 SIM. SEE 29/A7.3
- 95 (E) CONC WALL TO REMAIN (SEE SHTS A9.41-A9.43 FOR FINISHES)
- 96 WALL MOUNTED PENCIL SHARPENER (BOSTON/X-ACTO MANULA KS SERIES) MOUNTED RIGHT-HANDED AT 34" AFF
- 97 42" HIGH WALL (SIM. TO TYPE B5) W/ PAINTED HARDWOOD CAP

BCA
architecture
planning
interiors

Burton Clifford Associates, Inc.
210 Hammond Ave.
Fremont, California 94539
[T] 510.445.1000
[F] 510.445.1005
www.BCAincOnline.com

SEE RFI-25 EXISTING DOORS

ARCHITECT	ENGINEER

- GENERAL NOTES
1. This sheet is part of a set and is not to be used alone.
 2. This sheet is not to be used for construction unless the architect's stamp and signature appear on the drawing and the status box indicates drawings have been released for construction.
 3. These plans and prints thereof, as instruments of service, are owned by the architect and are for use on this project only. Reproduction and/or distribution without the prior written consent of the architect is forbidden.
 4. Copyright Burton Clifford Associates, 2009

REMARKS	DATE
ADDENDUM NO. 1	08/29/08
ADDENDUM NO. 2	11/08/09

GENERAL NOTES

- A. STANDARD DOOR DISTANCES/CLEARANCES ARE AS FOLLOWS:
-
- B. ALL WALL AND CEILING ACCESS DOORS SHALL BE 1-HOUR RATED IN CORRIDORS AND 2-HOUR RATED IN OCCUPANCY SEPARATION WALLS.
- C. THE FLOOR OR LANDING LENGTH ON EACH SIDE OF AN EXIT DOOR SHALL BE LEVEL (MAX. SLOPE 1/4" PER FOOT) AND CLEAR AT LEAST 60 INCHES IN THE DIRECTION OF THE DOOR SWING (PULL SIDE) AND 48 INCHES ON THE PUSH SIDE, WHEN MEASURED AT RIGHT ANGLES FROM DOOR IN CLOSED POSITION. THE CLEAR WIDTH SHALL EXTEND 24 INCHES BEYOND THE STRIKE ON THE FULL SIDE OF ALL EXTERIOR EXIT DOORS AND 18 INCHES FOR INTERIOR EXIT DOORS. THE CLEAR WIDTH SHALL EXTEND 12 INCHES BEYOND THE STRIKE EDGE OF THE PUSH SIDE OF ALL EXIT DOORS. DOORS SHALL BE EQUIPPED WITH BOTH A LATCH AND CLOSER.
- D. SEE SHEET A9.1 & A9.2 FOR DOOR, WINDOW AND FINISH SCHEDULES. RATED DOORS AND PANIC HARDWARE ARE INDICATED ON THE DOOR SCHEDULE.
- E. PROVIDE ADDITIONAL STUD FRAMING FOR OPENINGS AS INDICATED ON STRUCTURAL PLANS AND ON DOOR AND WINDOW DETAILS.
- F. PROVIDE BACKING IN STUD WALLS FOR ALL WALL-MOUNTED CABINETS AND ACCESSORIES, TYP.

REVISION STATUS	DATE
DSA PLAN CHECK	08/29/08
DSA BACK CHECK	01/22/09
BIDDING	09/18/09
CONSTRUCTION	

FILE NO. 41-C1
IDENTIFICATION STAMP
DIV. OF THE STATE ARCHITECT
01- 110074
AC FLS. SS
DATE

BUILDINGS 5 & 6 RENOVATIONS
San Mateo County Community College District

APPROVED BY THE STATE ARCHITECT
AC 171 FLS. CB SS JB
APPL. NO. 110274 DATE 8/29/08

CAÑADA COLLEGE
4200 Farm Hill Boulevard
Redwood City, CA 94061

SECOND FLOOR PLAN

Date 08/29/08	Drawing Number
Scale AS NOTED	A2.2
Project Number 07013	

LEGEND

- 60" DIA. CLEAR SPACE FOR SINGLE WHEELCHAIR
- 30" x 48" ACCESSIBLE CLEAR SPACE
- (E) CONC. RETAINING WALL. SEE STRUCTURAL DWGS FOR SIZE
- EXISTING CONSTRUCTION TO REMAIN
- NEW CONSTRUCTION
- WALL TYPE, SEE DET. 15/A10.51
- RECESSED FIRE EXTINGUISHER CABINET. SEE DET. 25/A10.51
- WALL MOUNTED FIRE EXTINGUISHER
- FLOOR DRAIN, SEE PLUMBING DWGS