


LEGEND:

--- F ---
EXISTING TO BE REMOVED


===== F =====
EXISTING TO REMAIN (FOR UNRATED) (E) WALL SET DET: (H&A) OR (N) (H&B) RATED GA FILE NO WP-1072 SEE DET 25H&A1 SHEETWALLS INSTALLED WITHIN SCOPE OF SEISMIC UPGRADE CONTRACT

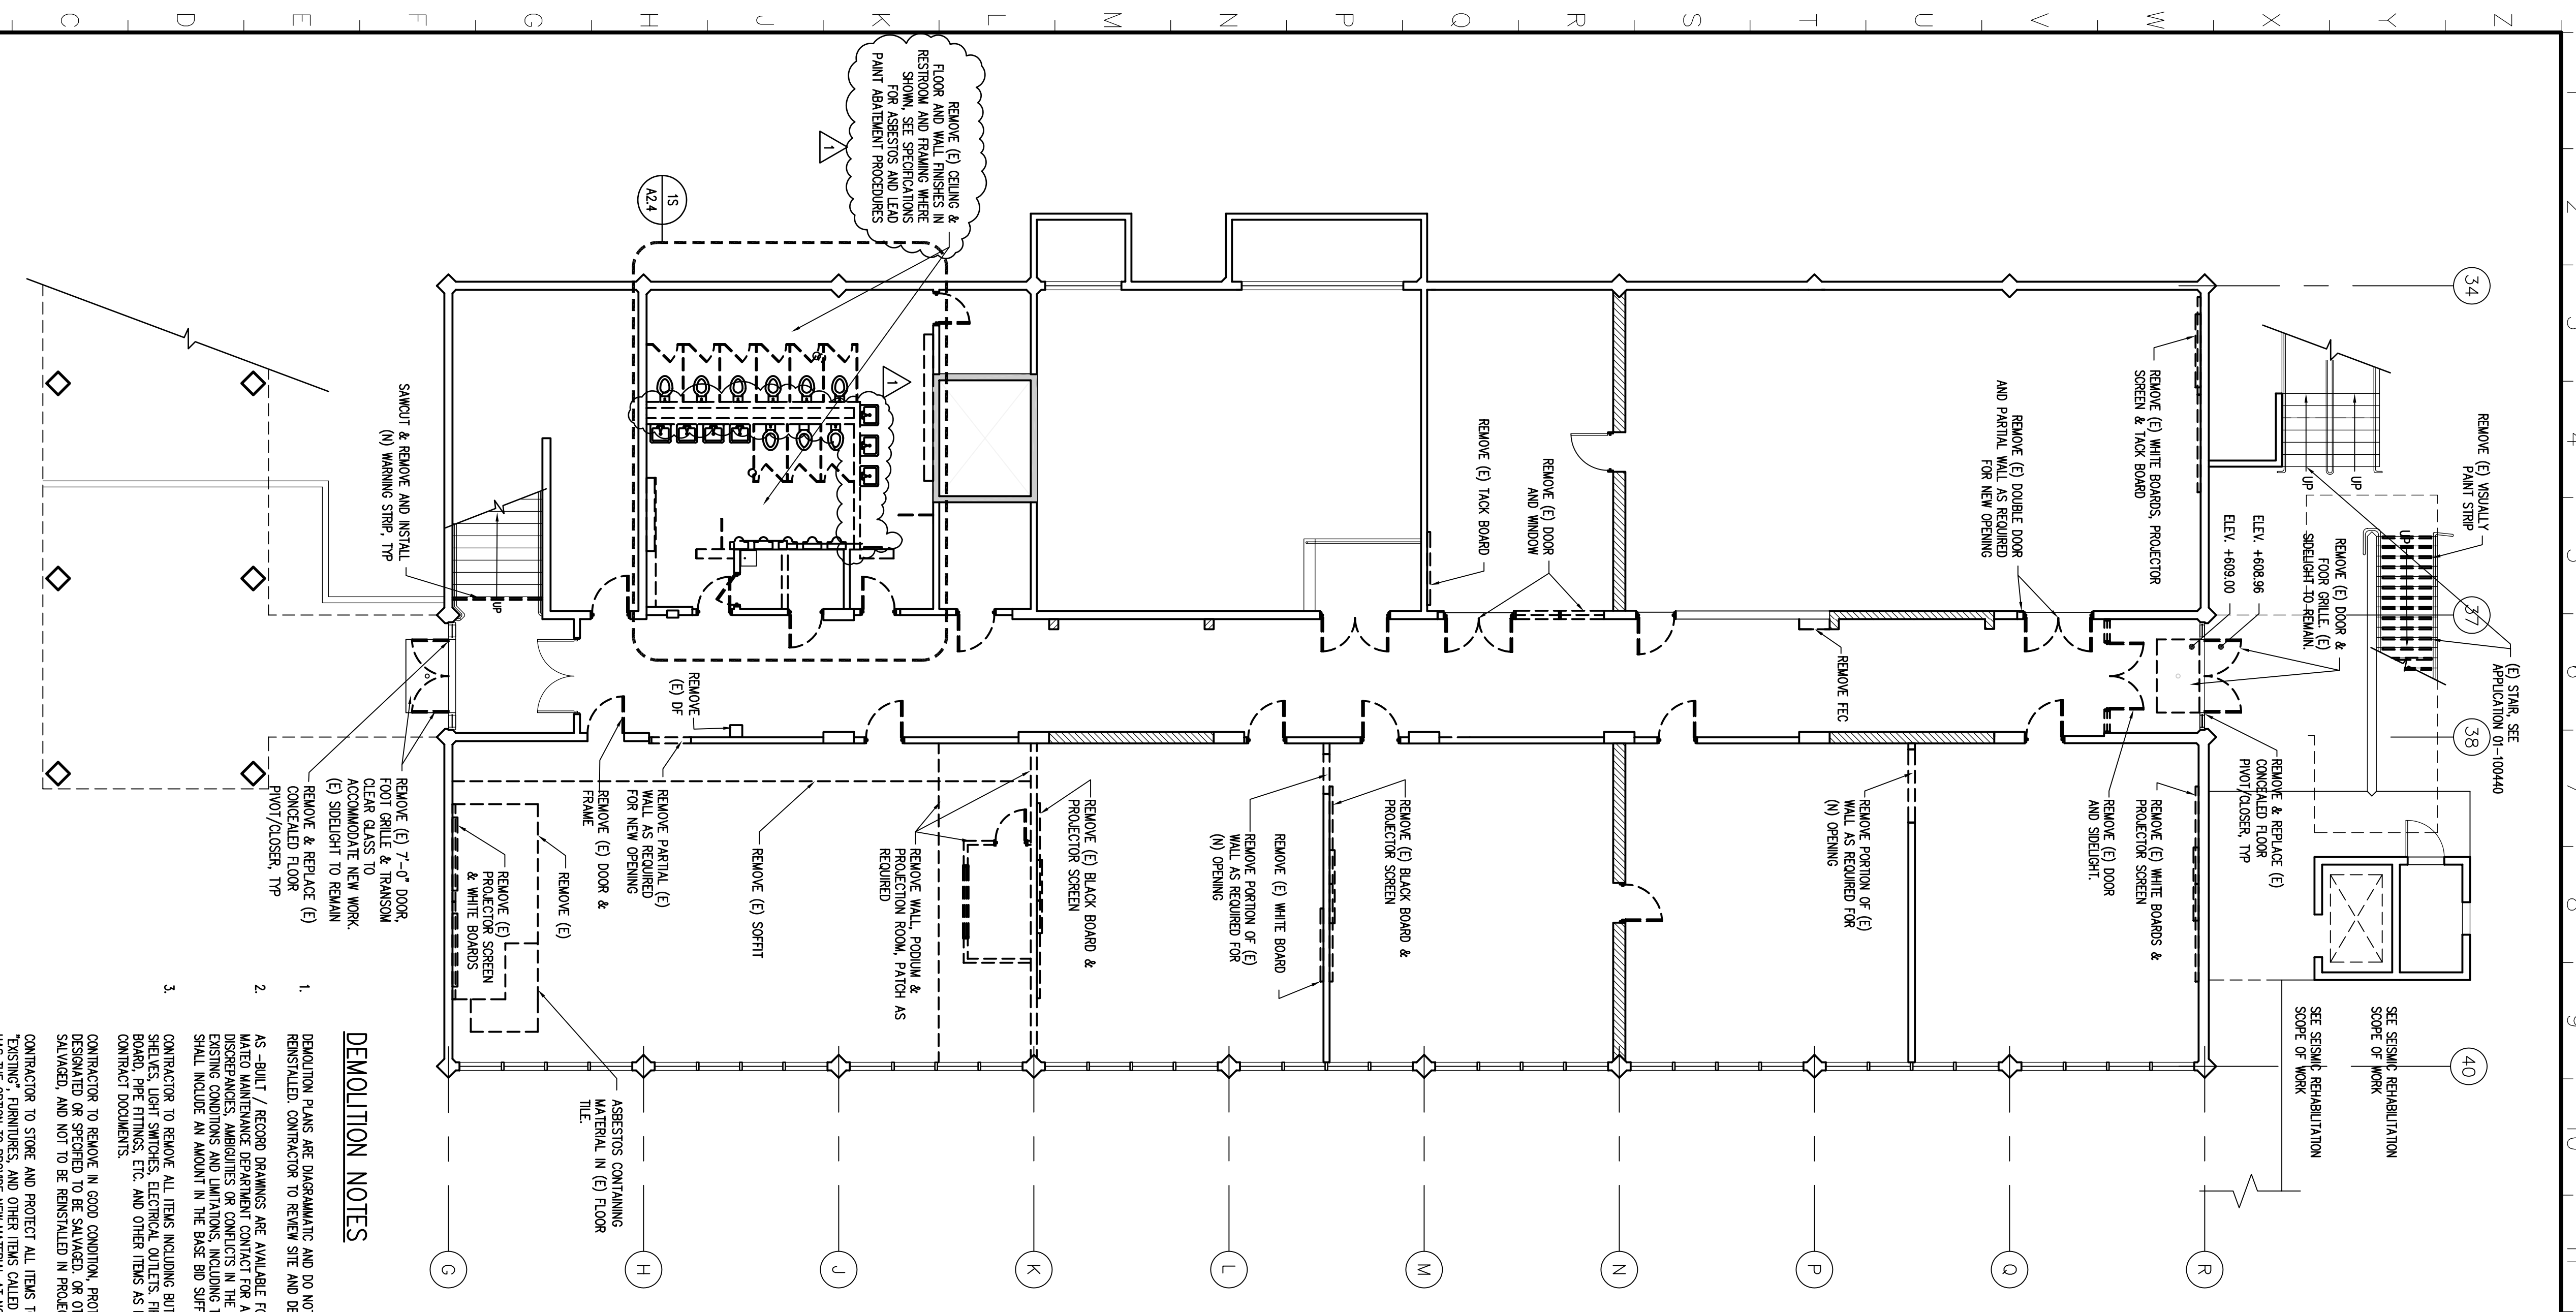

DEMOLITION NOTES

1. DEMOLITION PLANS ARE ORGANIZED AND DO NOT SHOW ALL ITEMS TO BE REMOVED AND REINSTALLED. CONTRACTOR TO REVIEW SITE AND DETERMINE EXISTING EXTENT OF WORK.
2. AS-BUILT / RECORD DRAWINGS ARE AVAILABLE FOR CONTRACTOR REVIEW AT THE OFFICE OF SAN MATEO MAINTENANCE DEPARTMENT FOR AN APPROXIMATE OF ANY FIELD SPECIFICATIONS, DISCREPANCIES, AMBIGUITIES OR CONFLICTS IN THE RECORD DOCUMENTS, CONTRACTOR TO ASCERTAIN SCHEDULE CHANGE AND TIME AND COST IMPACTS TO THE WORK. CONTRACTOR TO VERIFY ALL WORK IS AS SHOWN AND AS NOTED TO THE WORK.
3. CONTRACTOR TO REMOVE ALL ITEMS INCLUDING BUT NOT LIMITED TO PLUMBING FIXTURES, WIREWORK, ELECTRICAL, MECHANICAL, AND OTHER ITEMS NOTED TO BE REMOVED. CONTRACTOR TO VERIFY ALL ITEMS ARE REMOVED AND TO BE REINSTALLED. CONTRACTOR TO REMOVE ALL ITEMS IN GOOD CONDITION, PROTECT AND DELIVER TO THE OWNER THOSE ITEMS DESIGNATED AND SPECIFIED TO BE SALVAGED, OR OTHER ITEMS SUBSEQUENTLY INDICATED TO BE SALVAGED, AND NOT TO BE REINSTALLED IN PROJECT.

1A
CONDITIONS AFTER SEISMIC UPGRADE WORK AND DEMOLITION PLAN

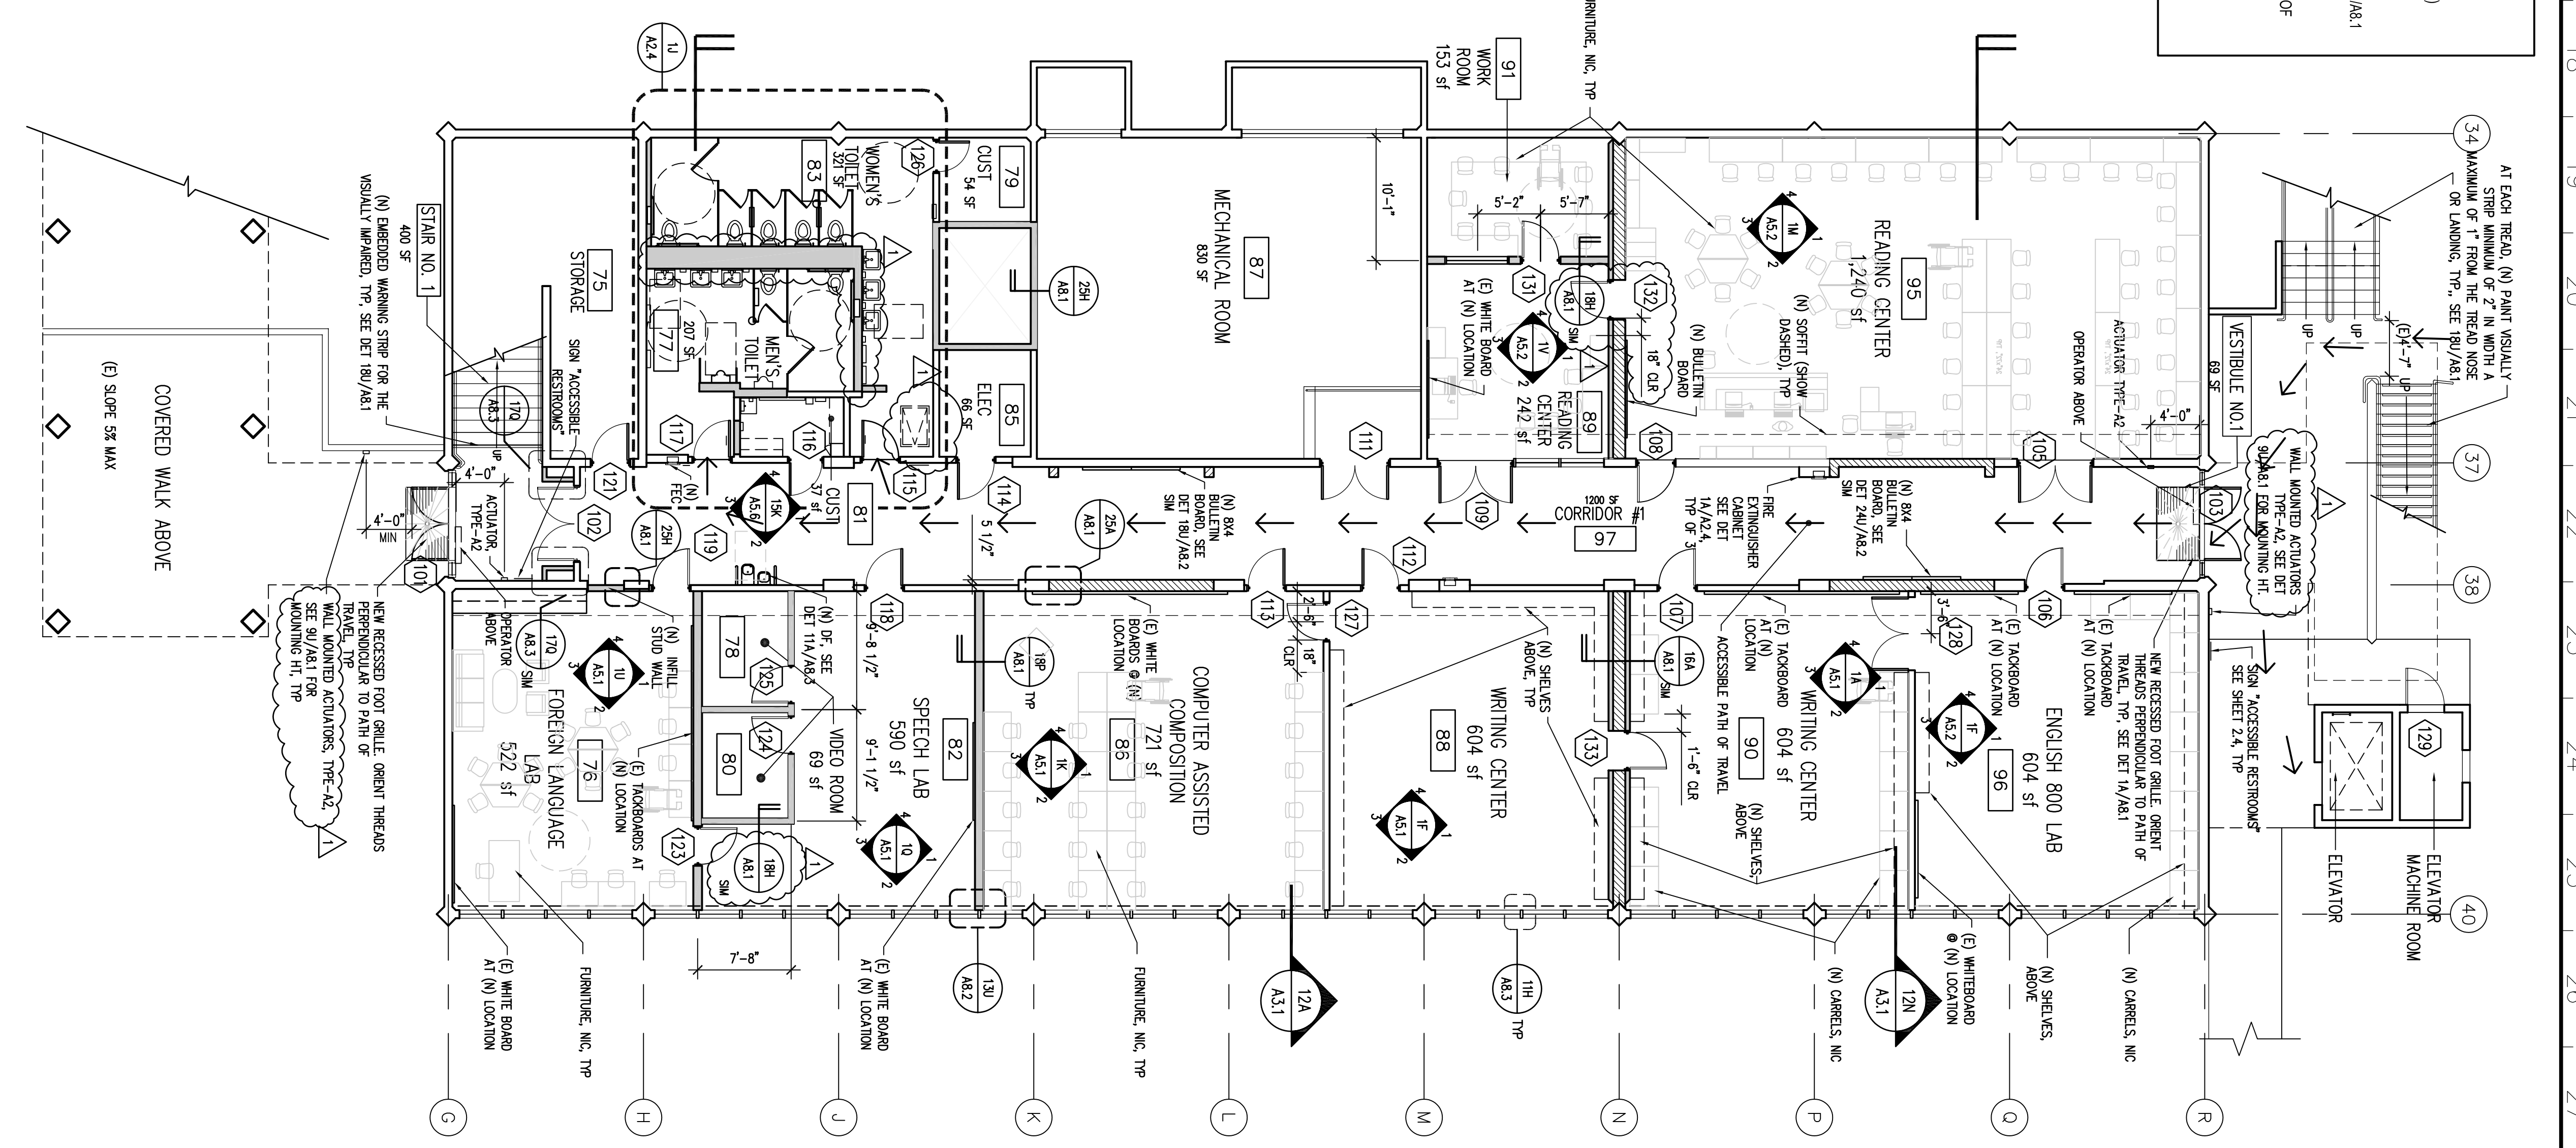

GENERAL NOTES

1. CLOCK IN THE BACK OF TYPICAL CLASSROOM.
2. SMART CLASSROOM. COMPUTER ASSISTED COMPOSITION RM. 86

17A
PLAN AFTER SEISMIC UPGRADE/ SHOWING MODERNIZATION WORK

REVISION DESCRIPTION INITIAL DATE

APPENDUM T&B 4/7/04

PRE-APPLICATION REVIEW 02/26/04

ISSUED FOR PLAN CHECK 03/03/04

ISSUED FOR PERMIT 03/03/04

ISSUED FOR BID

ISSUED FOR CONSTRUCTION

SCALE

CONSULTANT:

INTERACTIVE ARCHITECTURE • PLANNING • ENGINEERING

117 PARK PLACE
POINT RICHMOND
CALIFORNIA 94801
(910) 238-7435
(FAX) 232-5325
http://www.interactive.com

PROJECT:
BUILDING NO. 18 (NORTH HALL) MODERNIZATION

SAN MATEO CO. COMMUNITY COLLEGE DISTRICT

COLLEGE OF SAN MATEO
1700 WEST HILLSDALE BLVD,
SAN MATEO, CA 94402

SHEET TITLE:
BLDG 18 - GROUND FLOOR PLAN MODERNIZATION WORK

DR. JAMES S. MAYER
OFFICE OF RESOLUTION SERVICES
APPL 106047
DATE: 11-13-03

APPROVED
DW. OF THE STATE ARCHITECT
APPL 106047
DATE: 11-13-03

PROJ. NO. 2002-066-02
PREPARATION AND REVIEW

DRAWN BY: BA
CHECKED BY: T&B
DESIGNED BY: T&B
PEER REVIEW:

SHEET NUMBER:
MOD A2.1

OF