

Numbered Notes: THIS SHEET ONLY

- 1 (N) REIN. CONC. LANDING & TRANSITION @ (N) DOOR-MATCH (E) CONC. WALK COLOR & FINISH.
 - 2 REUSE (E) FRAME & AUTOMATIC OPENER- ADD (N) DOORS & (N) HARDWARE SCHEDULED. RELOCATE (E) CONTROL WIRING TO (N) PUSH BUTTON CONTROL (PB) @ (N) WINDOW MULLION. (N) EXTERIOR ALUM. STOREFRONT GLAZING SYSTEM.
 - 3 (N) INTERIOR ALUM. STOREFRONT GLAZING SYSTEM.
 - 4 (N) 3 1/2" HIGH RAISED ACCESS FLOOR OVER (E) CONC. SLAB ON GRADE.
 - 5 (N) 2"-3 1/2" HIGH RAISED ACCESS FLOOR OVER (E) CONC. SLAB ON GRADE.
 - 6 (N) OPERABLE WALL SYSTEM.
 - 7 (N) CASEWORK BASE UNIT. SEE *AR 22* & *AR 37*.
 - 8 (N) WALL UNITS. SEE -/- & -/-
 - 9 (N) CASEWORK SHELF UNITS.
 - 10 (N) ACCESS FLOOR TRANSITION RAMP W/ WALL MOUNTED HANDRAILS. SEE -/-
 - 11 (N) HOLLOW METAL FRAMED GLAZING, 45 MIN. RATED.
 - 12 (N) SERVICE COUNTER & OPENING W/ 1HR. RATED WALL ABOVE AND BELOW COUNTER.
 - 13 (N) OVERHEAD, 20 MIN. FIRE RATED, ROLL DOWN COUNTER DOOR.
 - 14 (E) ELEC. PANEL TO REMAIN.
 - 15 (E) F.H. CABINET TO REMAIN.
 - 16 (N) HIGH STRENGTH CONC. TOPPING- SEE DET. *AR 37*.
 - 17 (N) FLOOR DRAIN - SEE MECH.
 - 18 FACE OF (E) SERVICE DOCK TO REMAIN.
 - 19 LINE OF (E) CONC. RAMP UNDER (N) ACCESS FLOOR. SEE *AR 15*.
 - 20 (N) HORIZONTAL SLIDING PANEL MARKER BOARDS UNIT.
 - 21 (E) PAY TELEPHONE TO REMAIN.
 - 22 (E) D.F. TO REMAIN.
 - 23 (N) SERVICE DOCK EXTENSION & SLOPING CONC. WALK SEE DET. 3/A1.1
 - 24 (N) H.V.A.C. UNIT- SEE MECH.
- 25 Notes New Room Numbers, changed after construction.

Legend: THIS SHEET ONLY

- (E) REIN. CONC. WALL OR COL. TO REMAIN.
- (E) 4" METAL STUD W/ GYP. BD. PARTITION TO REMAIN.
- (E) 6" METAL STUD W/ GYP. BD. PARTITION TO REMAIN.
- (E) 2" METAL FURRING CHANNELS W/ GYP. BD. OR CERAMIC TILE TO REMAIN.
- (E) 2 HR. RATED 6" METAL STUD W/ GYP. BD. SHAFT WALL TO REMAIN.
- (N) 4" METAL STUD W/ GYP. BD.
- (N) RAISED ACCESS FLOOR.

NOTE: FOR REQUIRED ACCESS CLEARANCES AT DOORS AND FURNITURE SEE FURNITURE PLAN A2.3

KRUGER BENSEN ZIEMER ARCHITECTS, INC.
30 W. ARRELLAGA
805/963.1726
SANTA BARBARA, CA 93101

STEVE DOWTY, A.I.A.
PRINCIPAL IN CHARGE

GERALD SHUSTA
PROJECT ARCHITECT

All ideas, design arrangements and plans included or referenced by this drawing are owned by and for the property of Kruger-Bensen-Ziemer, Inc. Architects and are to be used only for the project and site as indicated on the drawing. No part of this drawing, in whole or in part, may be reproduced, stored in a retrieval system, or transmitted in any form or by any means, electronic, mechanical, photocopying, recording, or by any information storage and retrieval system, without the written permission of Kruger-Bensen-Ziemer.

**CENTER FOR ADVANCED LEARNING TECHNOLOGY
SKYLINE COLLEGE**



SAN MATEO COUNTY COMMUNITY COLLEGE DISTRICT
3300 COLLEGE DRIVE
SAN BRUNO, CALIFORNIA 94066

ASBUILTS

ADDENDUM #2	11-20-01	GS
BID SET REVISIONS	10-25-01	GS
NO. DESCRIPTION	DATE	BY
REVISION		

DRAWN	G.S.
CHECKED	S.D.
DATE	3/21/01
JOB NO.	98-03
SHEET TITLE	
FLOOR PLAN: REMODEL FLOOR PLAN	
SHEET 6	
A 2.1	
of 21	

1 Floor Plan: Remodel Floor Plan
SCALE: 1/8"=1'-0"

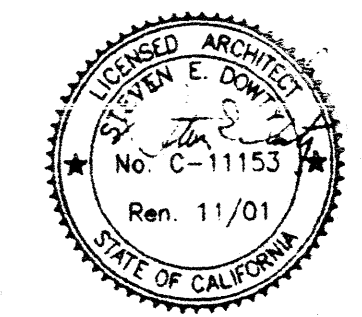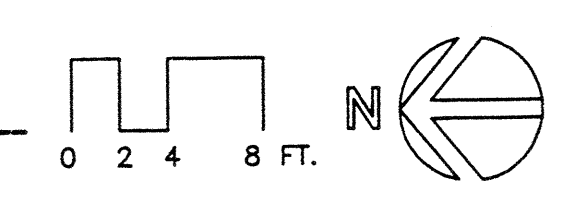

IDENTIFICATION STAMP
DIV. OF THE STATE ARCHITECT
OFFICE OF REGULATION SERVICES

APPL. **01-103735**

DATE: 06/12/01

c:\s803\9803a2_1.dwg Tue Mar 20 12:43:24 2001