

WALL SYMBOL LEGEND

- FOR ALL WALLS, SEE SCHEDULE ON SHEET A31 FOR FINISHES.
- ◇ ROOF HIGH - NON RATED SEE DETAIL 2/A1.2
 - ◇ ROOF HIGH - NON RATED SEE DETAIL 4/A1.2
 - ◇ CEILING HIGH - 1 HR FIRE RATED SEE DETAIL 6/A1.2
 - ◇ CEILING HIGH - NON RATED SEE DETAIL 8/A1.2
 - ◇ CEILING HIGH - NON RATED SEE DETAIL 10/A1.2
 - ◇ WING WALL - NON RATED SEE DETAIL 12/A1.2
 - ◇ ROOF HIGH - 1 HR FIRE RATED SEE DETAIL 14/A1.2
 - ◇ ROOF HIGH - 1 HR FIRE RATED SEE DETAIL 16/A1.2
 - ◇ (E) ROOF HIGH WALL TO REMAIN - 1 HR FIRE RATED (E) 2"x4" WOOD STUDS W/ 5/8" GYP. TYPE 'X' BO. EACH SIDE (V.I.F.) PER CBC IT.1.3
 - ◇ (E) 2-HR. FIRE SEPARATION WALL TO REMAIN
 - ◇ (E) BRICK MASONRY WALL TO REMAIN

- LEGEND**
- DENOTES LIMIT LINE OF WORK
 - DENOTES TO REFER TO ENLARGED PLAN

- GENERAL NOTES**
- A. THE EXISTING TOILET ROOMS WITHIN THE BUILDING WILL NOT BE UPGRADED UNDER THIS CONTRACT PER TITLE 24/ ADA REGULATIONS. ALL ACCESSIBLE RESTROOMS WILL BE LOCATED WITHIN THE DETACHED MODULAR BUILDING. REFER TO DSA #01-05854
 - B. PROVIDE MATERIAL & LABOR TO RECONNECT ALL (E) DOWNSPUTS, I.E. THE G.C. SHELL FIELD SURVEY (E) CONDITION AT THE PRE-BID CONF.
 - C. REF. TO ARCHITECTURAL DWG. T-4 FOR ACCESSIBILITY SIGNAGE REQUIREMENTS.

LEGEND - WALL TYPES

- ◇ EXISTING DOOR, WINDOW AND WALL ASSEMBLY TO BE REMOVED. SEE FLOOR PLAN FOR LOCATIONS. DOOR REMOVAL INCLUDES DOOR FRAME, TRIM, HARDWARE & SIDELIGHT, U.O.N.
- ◇ EXISTING DOOR, WINDOW AND WALL ASSEMBLY TO REMAIN.
- ◇ NEW DOOR, WINDOW AND WALL

KEYED NOTES (DENOTED BY #)


1. REPAIR & PATCH (E) FLOOR WHERE (E) MECH. EQUIPMENT WAS REMOVED. MATCH ADJACENT. CAP WATER & DRAIN LINES FLUSH TO WALL OR FLOOR. W.O. SEE 8/A1.1 FOR TRENCH INFILL. INSTALL W/ MASONRY WHERE DAMAGED PLEXIGLASS PANEL OCCURS. PAINT TO MATCH BLDG. EXTERIOR. INTERIOR COLOR IS TO MATCH INTERIOR WALL COLOR. ADD ALTERNATE #1 (N) METAL PANELS AT (E) OPENING. PAINT. REF. TO 4/A1.1
2. CONSTRUCT (N) ENCLOSURE FOR (N) FURNACE. CONNECT TO GAS LINE FLUE THROUGH WALL. F.A. INSTALL HIGH/LOW LOUVER. MATCH EXISTING ENCLOSURE FOR SOUNDPROOF CONSTRUCTION.
3. INFILL WITH CONCRETE TO MATCH (E). REFER TO DETAIL 6/A1.4.
4. (N) CHASE W/ 3 5/8" MTL STUDS @ 16" O.C. 5/8" GYP. BD (I) SIDE PAINT FINISH TO MATCH ADJACENT WALL.
5. (E) METAL LOCKERS TO REMAIN.
6. PROVIDE & INSTALL (N) SIGN TO READ AS FOLLOWS: THIS IS NOT A WHEELCHAIR ACCESSIBLE EXIT! REFER TO DETAIL 13/A1.4. LOCATE SIGN TO THE STRIKE SIDE OF THE DOOR @ 60" TO CENTER LINE OF SIGN TO F.F. (E) DOOR HARDWARE & THRESHOLD ARE NOT COMPLIANT.
7. COAT HOOK. REF. TO 9/A1.5
8. (E) CHALKBOARD/TACKBOARD TO REMAIN.
9. INSTALL (N) 14" x 58" METAL LOUVERS WHERE (E) LOUVERS WERE REMOVED IN THE DEMOLITION PHASE. (N) LOUVERS TO MATCH (E).
10. PATCH & REPAIR (E) FLOOR TO RECEIVE (N) FLOOR FINISH.
11. SAW CUT (E) MASONRY WALL TO INSTALL (N) 14" x 8" METAL LOUVER. LOCATE THE OPENING BETWEEN (E) REBARS. REF. TO STRUCTURAL 2/US2 FOR ACTUAL PLACEMENT OF LOUVER. SEE 5/A2.6 FOR ADDTL. INFO.
12. INSTALL (N) SHEET METAL PANEL WITH 12" x 15" OPENING. INSTALL ON THE INSIDE FACE OF THE (E) LOUVER. REFER TO MECH. DWGS. FOR REQUIREMENTS AND LOCATION.
13. (N) SEMI-RECESSED FIRE EXTINGUISHER CABINET. REF. TO 13/A1.1. THE F.E. SHALL COMPLY W/ 4A 40B.C RATING
14. PROVIDE & INSTALL WOOD SHELF WITH FLAM FINISH. REFER TO INTERIOR ELEVATION 1/GA2.6.
15. INSTALL SELF LEVELING COMPOUND TO FILL IN AREA WHERE TILE FLOOR WAS REMOVED. MATCH (E) FLOOR ELEVATION.
16. DENOTES (N) 10" x 1" @ 6" AFF. METAL DUCT. PAINT TO MATCH GYP. BD. WALL. REFER TO MECH. DWGS FOR REQUIREMENTS.
17. DENOTES (E) FIRE EXTINGUISHER CABINET TO REMAIN.
18. INFILL AREA W/ CONCRETE TO MATCH (E). REFER TO 6/A1.4.
19. DENOTES (E) FURNACE & ENCLOSURE TO REMAIN
20. REINSTALL (E) 12"x12" ACoustICAL WALL TILES SAVED FROM DEMO PHASE TO MATCH (E). INSTALL WHERE MISSING OR DAMAGED.
21. DENOTES (E) PLATFORM ABOVE TO REMAIN.
22. DENOTES (N) WOOD COLUMN AND WALL FRAMING. INSTALL TYPE 'X' GNB ON ALL FACES. TAPE, TEXTURE & PREP. TO PAINT. REFER TO STRUCTURAL DWGS.
23. DENOTES (N) TS COLUMN BURIED INTO (N) WALL. REFER TO STRUCTURAL DWGS. FOR REQUIREMENTS.
24. (N) ACCESSIBLE FOLD DOWN SEAT. REF. TO 20/A1.5
25. MODEL # BOSBRICK B-919
26. (E) CASEWORK, SHELVES, SINK TO REMAIN.
27. (N) DRESSING ROOM CURTAIN & TRACK ABOVE. REFER TO DETAIL 5/A1.5.
28. SAWCUT (E) MASONRY WALL TO INSTALL A 15" x 10" MTL LOUVER 2" AFF. LOCATE THE OPENING BETWEEN THE (E) REBARS. REFER TO STRUCTURAL DETAIL 2/US2 FOR PLACEMENT
29. CUT 14"x8" OPENING INTO NON-STRUCTURAL INFILL PANEL FOR (N) MTL LOUVER. THE TOP OF (N) LOUVER WILL BE 12" BELOW (E) FINISH CEILING LINE.
30. INSTALL (N) BACKING PLATE TO THE (E) GYP. BD. WALL FOR (N) FOLD DOWN SEAT PER DETAIL 4/2C/A1.2. GRIND ALL EDGES SMOOTH & PAINT THE PLATE TO MATCH WALL COLORS.
31. (N) CONCRETE INFILL TO MATCH (E). REFER TO DETAIL 3/A2.4.
32. REPLACE (E) CONCRETE WALKWAY AS REQUIRED FOR UNDERGROUND SEWER PIPE INSTALLATION.

FLOOR PLAN


1/8"=1'-0" 0 2' 4' 8' 16' 24'



KEY PLAN

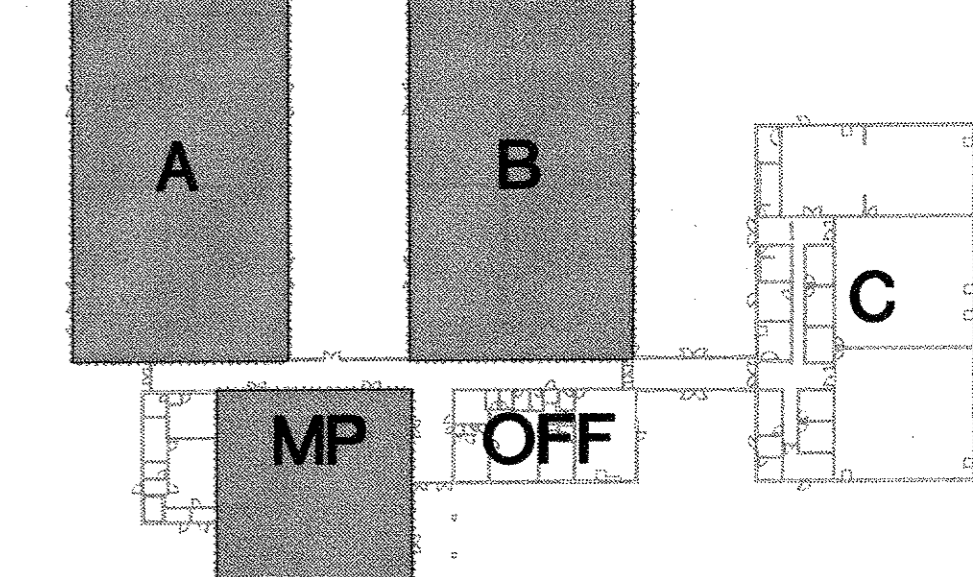

Sugimura & Associates Architects
 Architecture • Planning • Interiors
 Landscape Architecture
 2155 South Bascom Ave., Suite 200
 Campbell, CA 95008
 408-879-0600 Fax 408-377-6066
 COPYRIGHT © 2003 Sugimura & Associates Architects

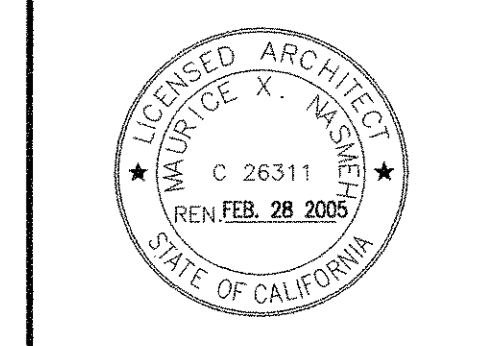

REGISTRATION STAMP
 ARCHITECT
 OFFICE OF REGULATION SERVICES
 FILE NO. _____
 APP. NO. _____
 DATE _____
 AC. NO. _____
 SS _____
 Division of the State Architect
 Regional Office
 1001 Market Street, Suite 1001
 Oakland, CA 94612

FLOOR PLAN
PACIFIC HEIGHTS
SKYLINE COLLEGE SWING SPACE
PERMIT PACKAGE #3
SKYLINE COLLEGE
3300 COLLEGE DRIVE
SAN BRUNO, CA 94066

REVISIONS

NO.	ITEM	DATE
1	DSA BACKCHECK	5/28/04
2	CONSTRUCTION ISSUE	6/10/04
3	ADDENDUM #5	7/31/04
4	CONFORM SET	9/1/04
5	As-Built	3/14/05

CLIENT APPROVAL:
 DRAWN BY: NK
 CHECKED BY: NK
 JOB NO: 2145.002 DATE: 13 FEB 2004