

LOUVER SCHEDULE - BLDG 30


LOUVER	TYPE	SIZE	RATE	DETAILS			REMARKS	LOUVER COLOR
				HEAD	JAMB	SILL		
L-1	AL	6'-0"RO X 7'-4"RO	NA	6/A7.12	2/A7.12	7/A7.12	W/DRIP CAP	KELLY MOORE 09-1005-1102 HICKORY WIND PER SPEC SECTION 099000 2.02 C.1.A
L-2	AL	5'-4"RO X 2'-8"RO	NA	1/A7.11	2/A7.12	2/A7.11	NA	
L-3	AL	8'-0"RO X 3'-4"RO	NA	4/A7.11	2/A7.12	5/A7.11	NA	
L-4	AL	8'-4"RO X 3'-4"RO	NA	4/A7.11	2/A7.12	5/A7.11	NA	

LOUVER TYPE LEGEND

DOOR SCHEDULE - BLDG 30

DOOR	TYPE	SIZE	DR	FR	RATE	DETAILS			HDW	REMARKS
						HEAD	JAMB	SILL		
30A	HM-1	PR 8'-0" X 9'-10"	HM	HM	NA	5/A7.11	3/A7.12	6/A7.11	01	NA
30B	HM-2	PR 6'-4" X 7'-10"	HM	HM	NA	5/A7.11 SIM	3/A7.12	6/A7.11 SIM	02	NA

DOOR TYPE LEGEND

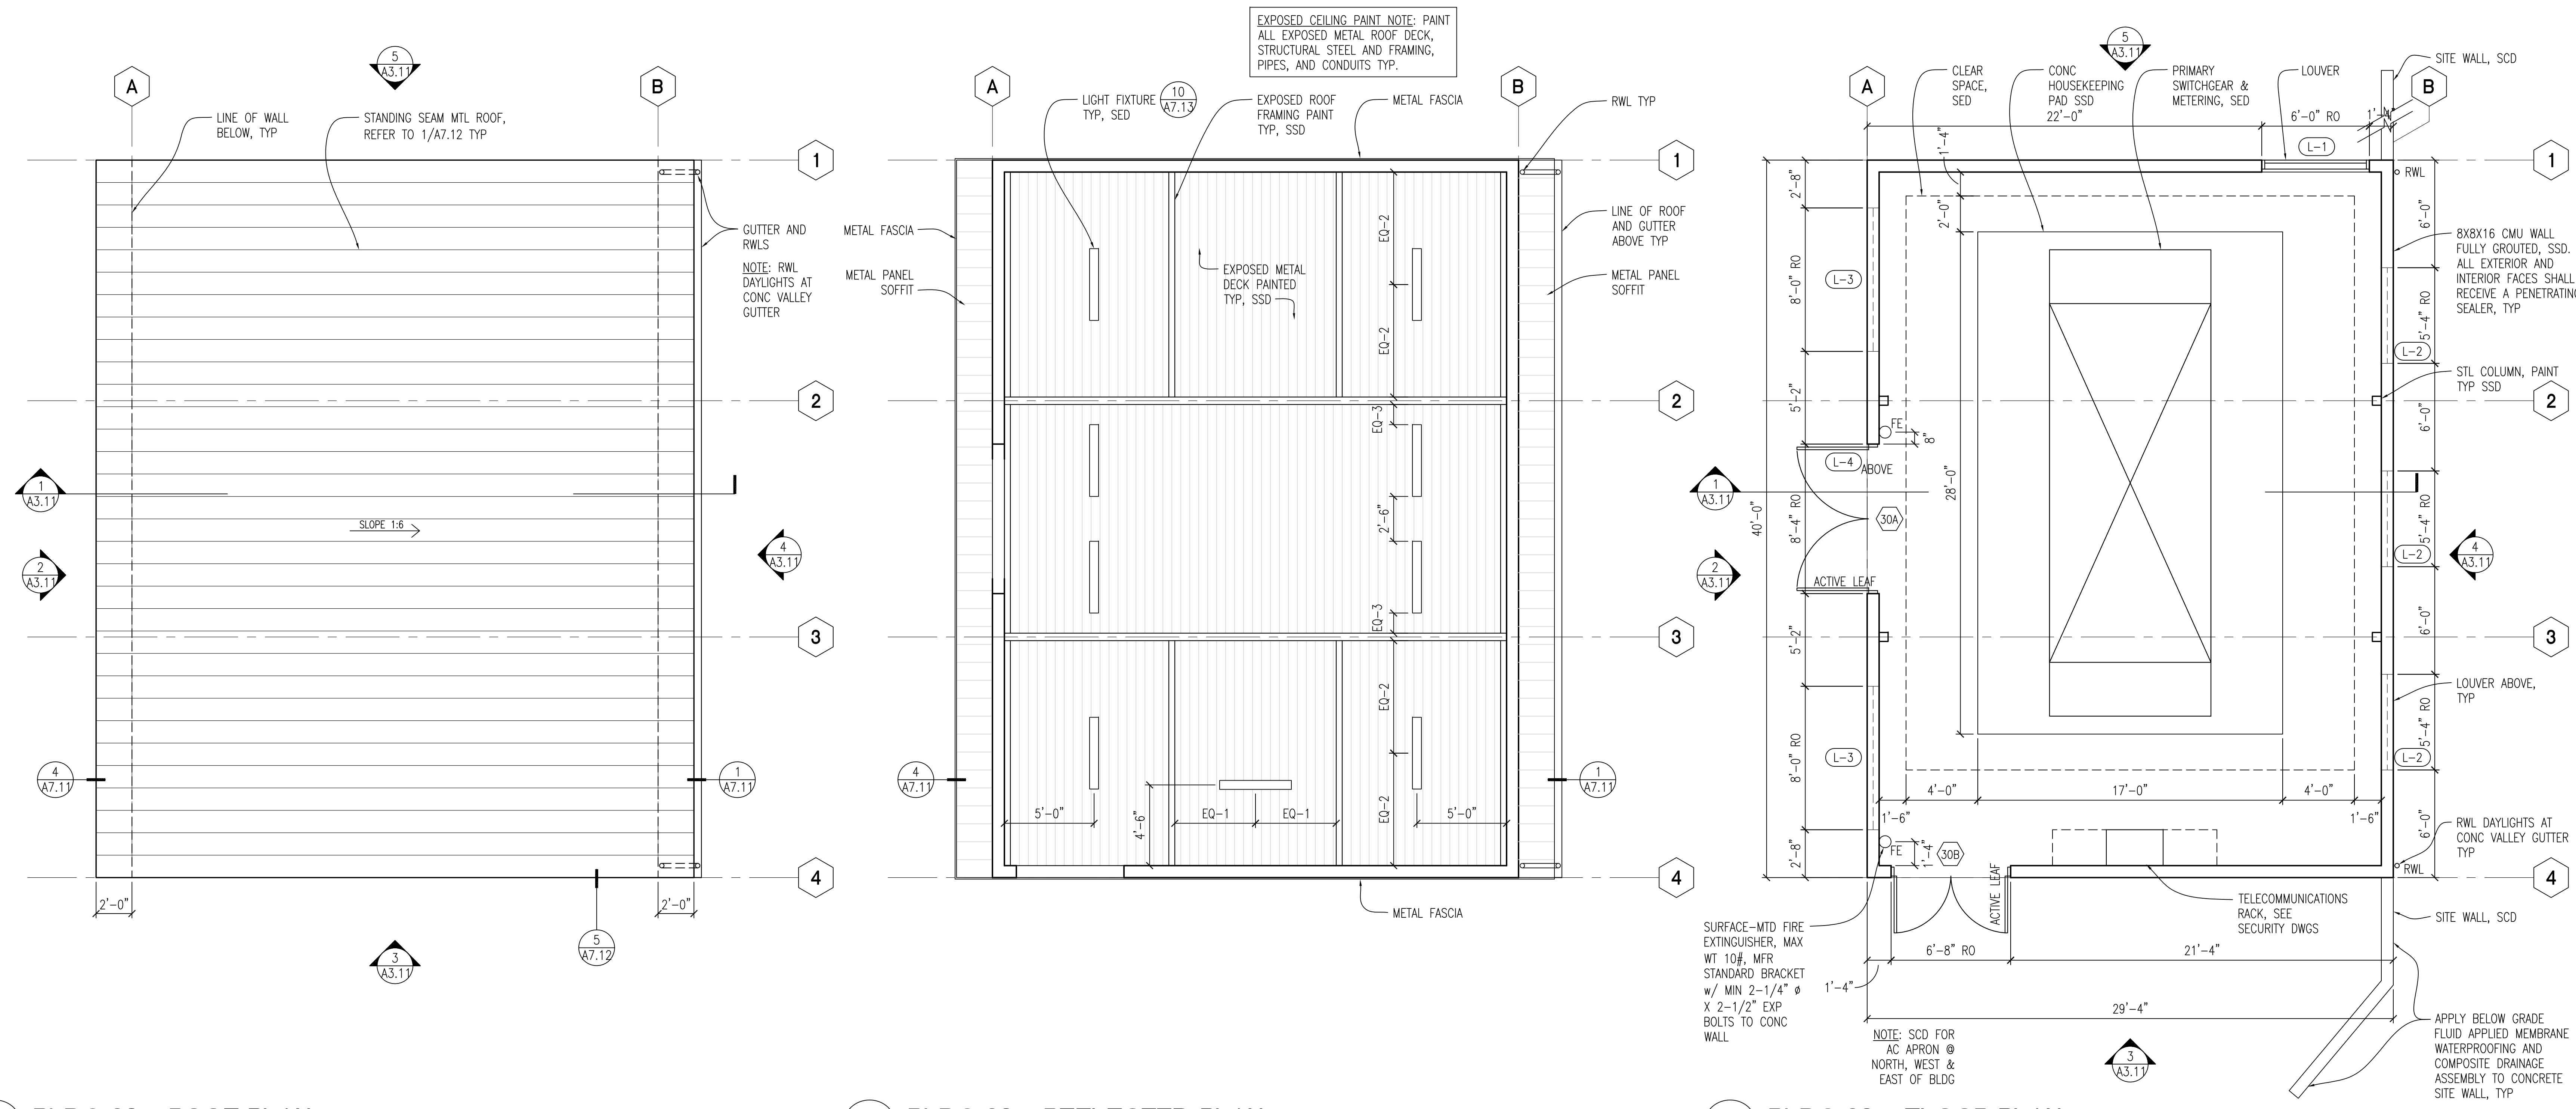

IDENTIFICATION STAMP
 DIVISION OF THE STATE ARCHITECT
 APPLICATION NUMBER 01-111618
 AC _____ FS _____ SS _____
 DATE _____

CALIFORNIA STATE FIRE MARSHAL
 APPROVED

APPROVAL OF THIS PLAN DOES NOT AUTHORIZE OR APPROVE ANY
 CONSTRUCTION OR DEVIATION FROM APPLICABLE REGULATIONS. FINAL
 APPROVAL IS SUBJECT TO REGISTRATION. ONE SET OF APPROVED
 PLANS SHALL BE AVAILABLE ON THE PROJECT SITE AT ALL TIMES.
 REVIEWED BY: _____ DATE: _____

CAÑADA COLLEGE
 Electrical
 Infrastructure
 Replacement
 Project
 4200 Farm Hill Blvd
 Redwood City, CA 94061

REGISTERED ARCHITECT
 CHRISTOPHER NOLL
 REN. 12/31/11
 C15916
 STATE OF CALIFORNIA

RECORD DRAWING

SHEET TITLE
**Bldg 30-
 Plans, Schedule**

REVISIONS		
NO.	DATE	DESCRIPTION

DATE July 9, 2012
 DRAWN TC/AL
 CHECKED MM
 SCALE 1/4" = 1'-0"
 JOB NO. 2921.01

SHEET NUMBER
A2.11

3 BLDG 30 - ROOF PLAN 1/4" = 1'-0" **2 BLDG 30 - REFLECTED PLAN** 1/4" = 1'-0" **1 BLDG 30 - FLOOR PLAN** 1/4" = 1'-0"

