


20A WALL SECTION
 1/2"=1'-0"

AS-BUILTS

NO.	DATE	REASON	BY

ISSUE FOR PROGRESS REVIEW 01/15/01
 ISSUE FOR PLAN CHECK 01/25/01
 ISSUE FOR FINAL REVIEW 05/09/01
 ISSUE FOR BID
 ISSUE FOR CONSTRUCTION

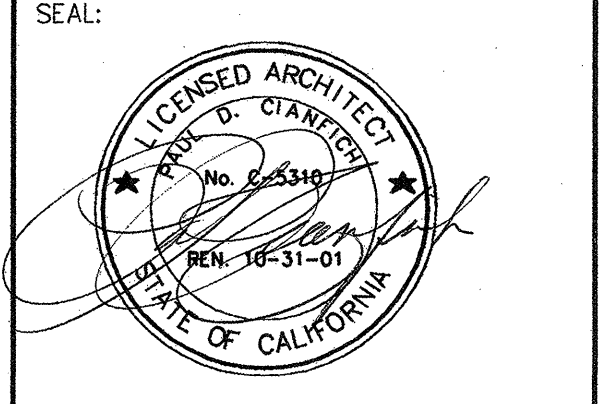

CONSULTANT:
 ARCHITECT:
 CONSULTANT:

ARCHITECT:
CIANFICHI
 ARCHITECTURE + PLANNING
 30 ANNE COURT
 WALNUT CREEK, CA 94598
 TEL: (925) 256-8638
 FAX: (925) 256-8652

PROJECT:
CHILD DEVELOPMENT CENTER
CANADA COLLEGE
 4200 FARM HILL BLVD.
 REDWOOD CITY, CA 94061
SAN MATEO COUNTY COMMUNITY COLLEGE DISTRICT

STAMP: IDENTIFICATION STAMP
 DIVISION OF THE STATE ARCHITECT
 APPL 103529
 AC: *WJ* FLS: *MS* DATE: *5/14/01*
 APPL. NUMBER:
 KEY PLAN:

SHEET TITLE:
WALL SECTIONS
 DRAWN BY: GL PROJECT NO.: 304.99
 CHECKED BY: BA DATE: 01-25-2001
 APPL. NO.: SHEET:
 DATA NO.: **A3.1**
 NO. OF: