



1 SECTION A-A  
SCALE: 1/8"=1'-0"

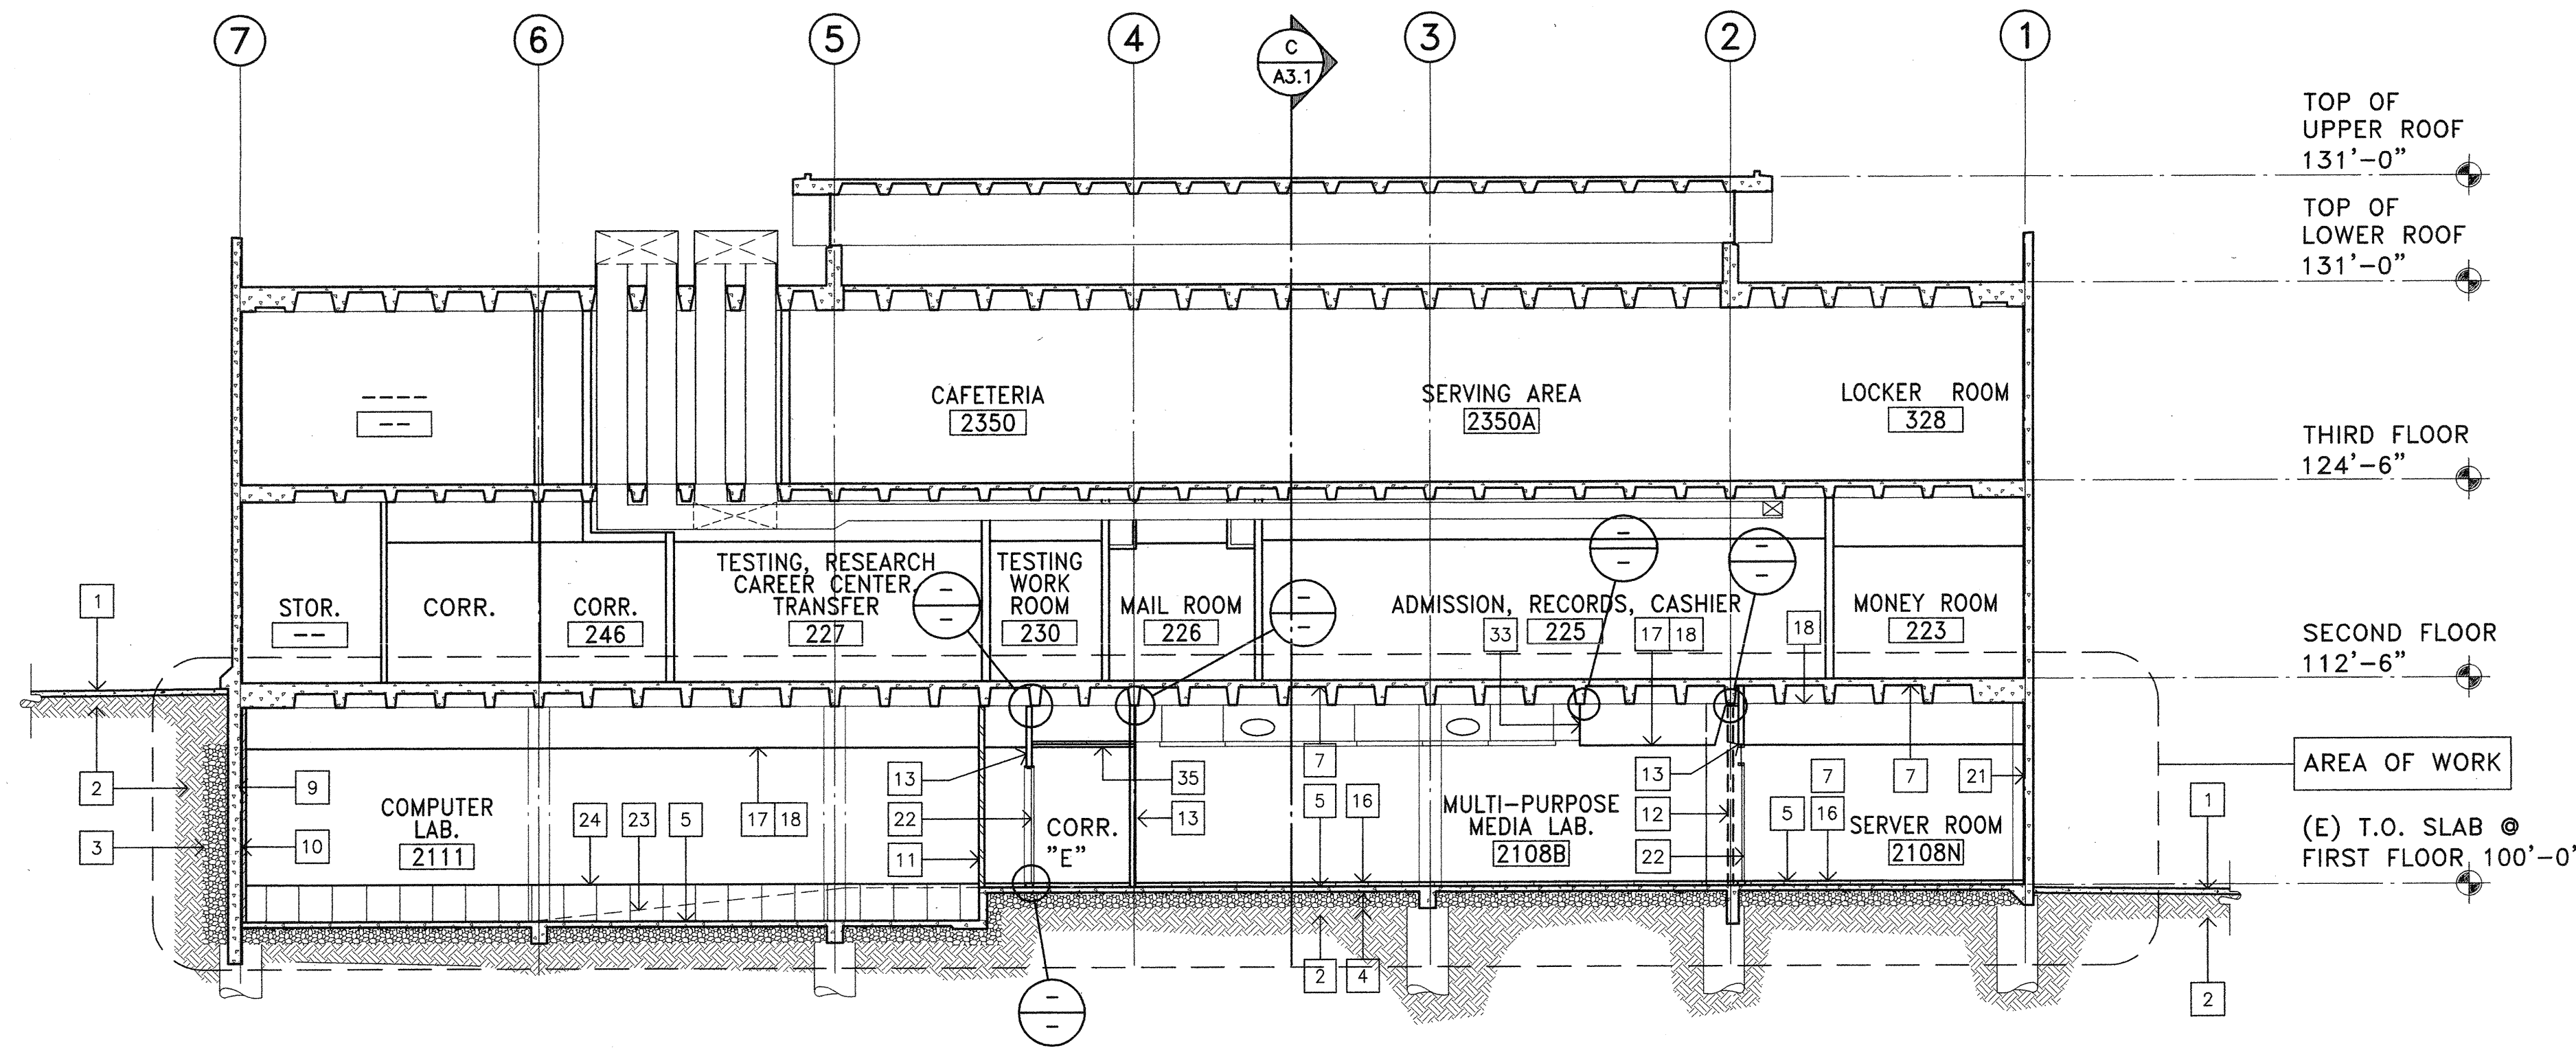


2 SECTION B-B  
SCALE: 1/8"=1'-0"

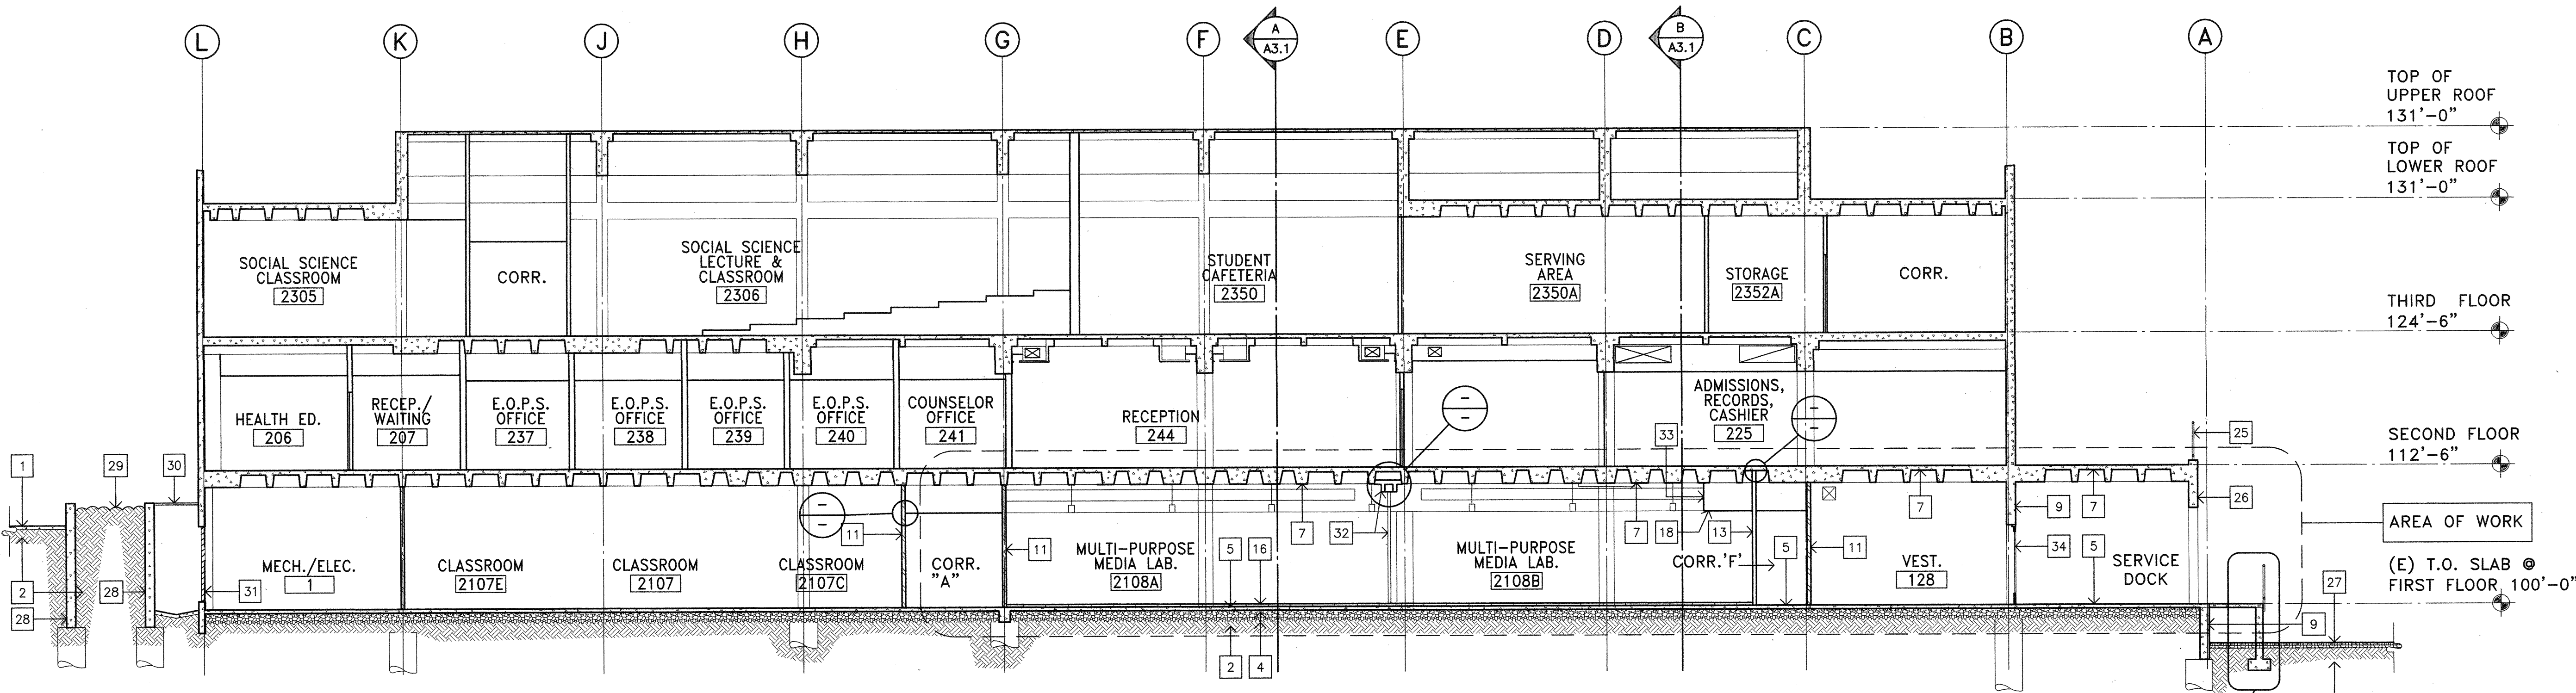

3 SECTION C-C  
SCALE: 1/8"=1'-0"

NUMBERED NOTES: THIS SHEET ONLY

- 1 (E) CONC. WALK PAVING
- 2 (E) ENGINEERED FILL
- 3 (E) DRAIN ROCK.
- 4 (E) 2" SAND OVER W.P. MEMBRANE & DRAIN ROCK.
- 5 (E) 4" CONC. SLAB ON GRADE W/ #3 BARS @ 15" O.C. EA. WAY- TYP.
- 6 (E) SLOPING 4" CONC. SLAB ON GRADE W/ #3 BARS @ 15" O.C. EA. WAY- TYP.
- 7 (E) CONC. WAFFLE SLAB- SANDBLAST CLEAN, REMOVE ALL (E) ACoustICAL MATERIAL, PATCH ROCK POCKETS, VOIDS, & SPALLED CORNERS. PRIME & PAINT P.
- 8 (E) CONC-FILLED METAL DECK OVER STEEL FRAMING W/ GEMENTITIOUS SPRAYED FIREPROOFING.
- 9 (E) 10" REINF. CONC. WALL.
- 10 (E) 2 1/2" WALL FURRING W/ 5/8" GYP. BD. ON 3/4" METAL CHANNELS @ 16" O.C.
- 11 (E) 4" METAL STUD PARTITION W/ 2-LAYERS 5/8" GYP. BD. EA. SIDE.
- 12 REMOVE (E) 4" METAL STUD PARTITION W/ 5/8" GYP. BD. EA. SIDE.
- 13 (N) METAL STUD PARTITION FROM CONC. SLAB ON GRADE TO UNDERSIDE OF CONC. WAFFLE SLAB ABOVE.
- 14 (N) ALUM. INTERIOR STOREFRONT GLAZING SYSTEM, NON-RATED.
- 15 (N) METAL FRAMED GLAZING, 45 MIN. RATED.
- 16 (N) 3" HIGH RAISED ACCESS FLOOR OVER (E) CONC. SLAB ON GRADE.
- 17 REMOVE (E) "T" BAR SUSPENDED ACOUSTIC CLG. SYSTEM.
- 18 (N) "T" BAR SUSPENDED ACOUSTIC CLG. SYSTEM.
- 19 (E) METAL FRAMED & CEM. PLAS. SOFFIT BAND.
- 20 (N) ALUM. EXTERIOR STOREFRONT GLAZING SYSTEM.
- 21 (E) 7" REINF. CONC. WALL.
- 22 (N) DOOR- SEE DOOR SCHEDULE.
- 23 LINE OF (E) SLOPING CONC. SLAB BEYOND SECTION CUT.
- 24 (N) 2'-3" HIGH RAISED ACCESS FLOOR OVER (E) CONC. SLAB ON GRADE.
- 25 (E) 42" HIGH METAL GUARDRAIL.
- 26 (E) 10" REINF. CONC. FACIA BM.
- 27 (E) A.C. PAVING & BASE.
- 28 (E) 10" REINF. CONC. PLANTER WALL.
- 29 (E) PLANTER.
- 30 (E) METAL GRATE.
- 31 (E) METAL LOUVERS.
- 32 (N) OPERABLE WALL SYSTEM W/ (N) FURRED HEAD TRACK @ (E) CONC. WAFFLE SLAB ABOVE.
- 33 (E) GYP. BD. SOFFIT FACE.
- 34 (E) DOOR TO REMAIN- SEE DR SCHEDULE.
- 35 (N) RATED CLG. SEE -/-
- 36 REMOVE (E) CONC. WALK & INSTALL (N) SLOPING CONC. WALK @ (N) DOOR- SEE FLOOR PLAN.

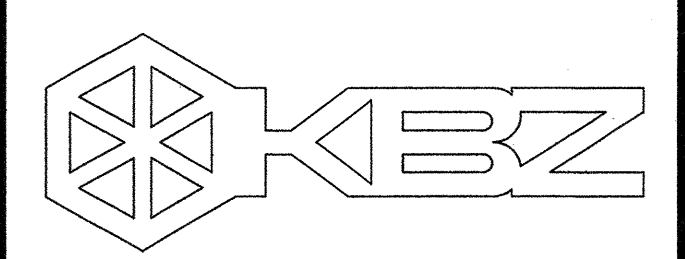

KRUGER BENSEN ZIEMER ARCHITECTS, INC. AIA  
30 W. ARRELLAGA SANTA BARBARA, CA 93101  
805/963.1726

STEVE DOWTY, A.I.A.  
PRINCIPAL IN CHARGE

GERALD SHUSTA  
PROJECT ARCHITECT


All ideas, design arrangements and plans indicated or represented by this drawing are used by and on the property of Kruger-Bensen-Ziemer, Inc. and are created, owned and developed for use on, and in connection with the specified project. None of such ideas, designs, arrangements or plans shall be used by or disclosed to any person, firm or corporation for any purpose whatsoever without the written permission of Kruger-Bensen-Ziemer.

CENTER FOR ADVANCED LEARNING TECHNOLOGY  
 SKYLINE COLLEGE  
 SAN MATEO COUNTY COMMUNITY COLLEGE DISTRICT  
 SAN BRUNO, CALIFORNIA 94066  
 3300 COLLEGE DRIVE

*ASBUILT*

NO.	DESCRIPTION	DATE	BY

DRAWN	G.S.
CHECKED	S.D.
DATE	3/21/01
JOB NO.	98-03
SHEET TITLE	BUILDING SECTIONS

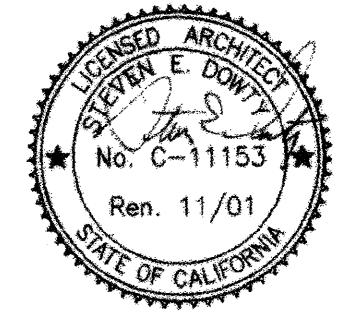

IDENTIFICATION STAMP  
DIV. OF THE STATE ARCHITECT  
OFFICE OF REGULATION SERVICES  
APPL 01-103735  
DATE 09/12/01

U:\cadproj\9803\9803a3\_1.dwg F:\ Doc 25 15:17:11 2001