


RFP-39

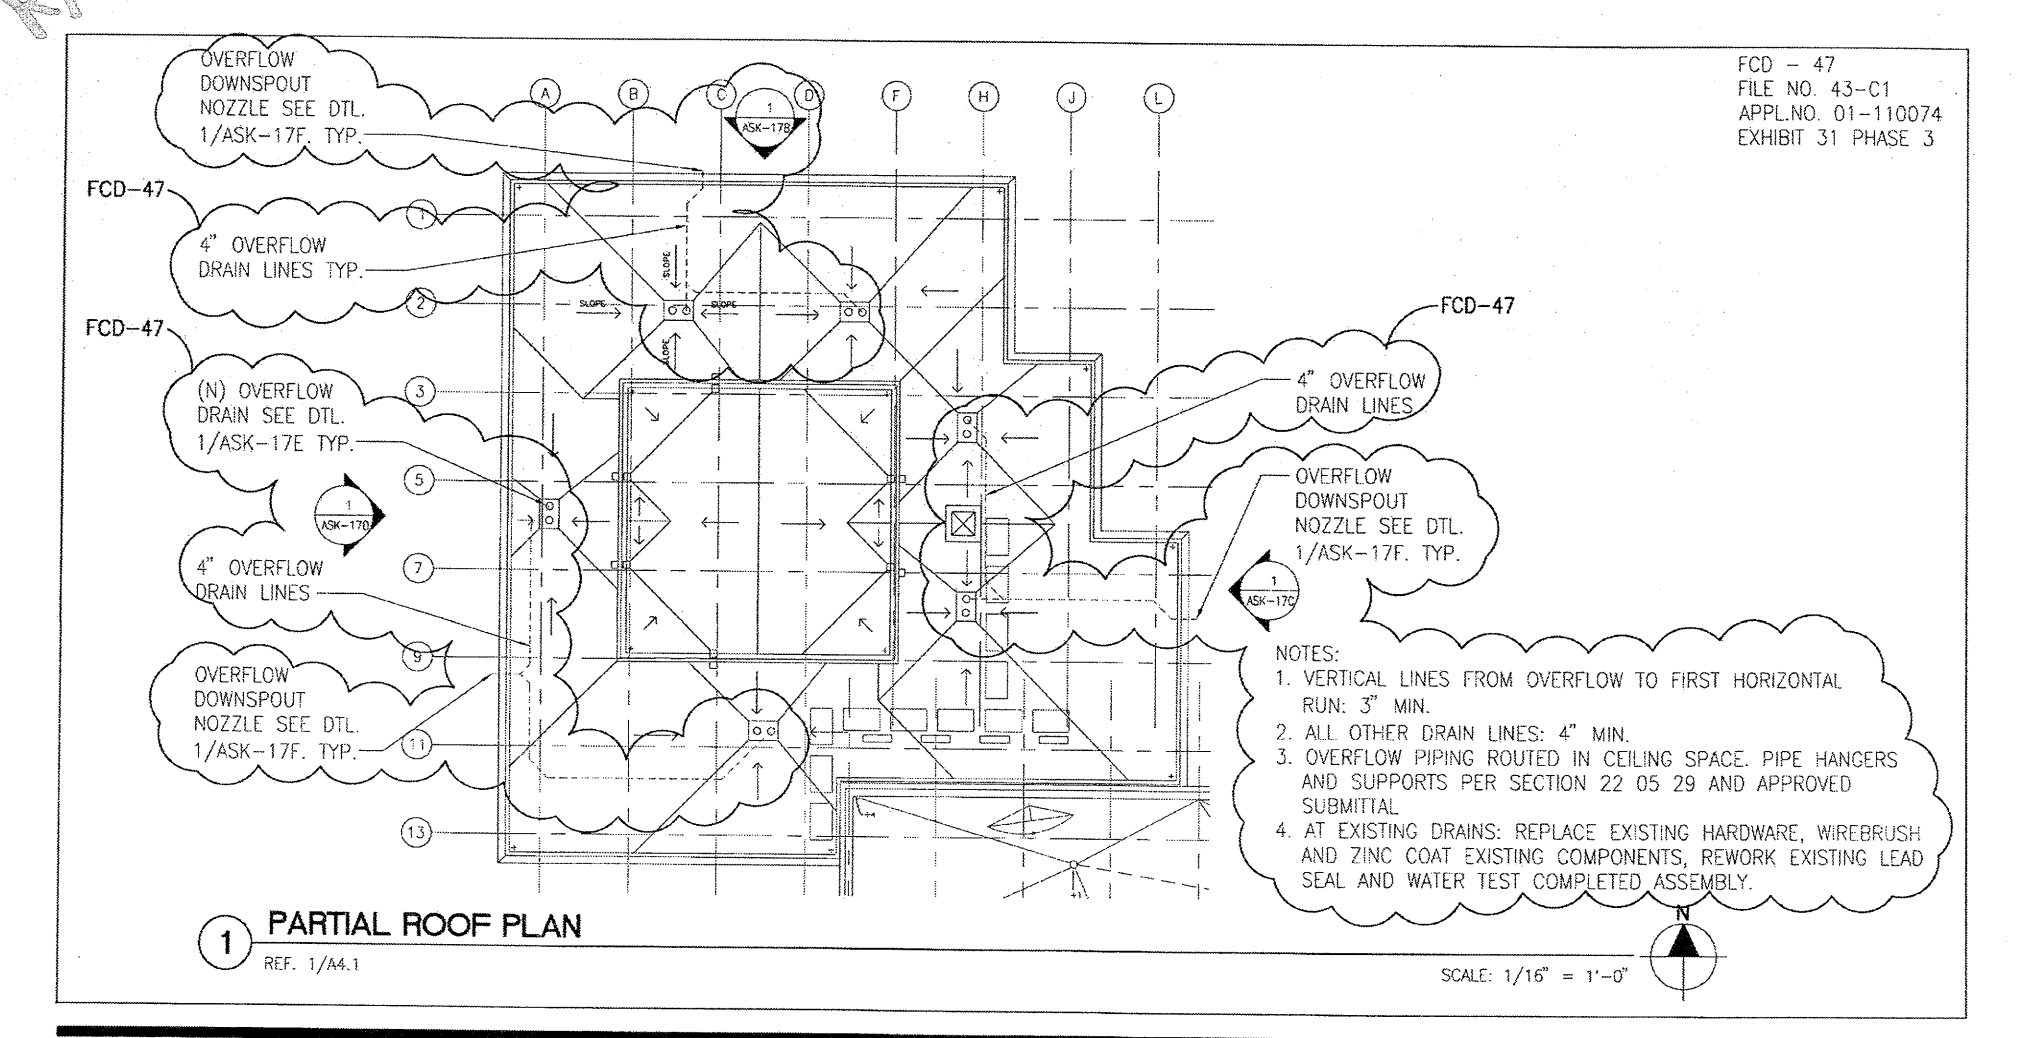


FCD - 47
FILE NO. 43-C1
APPL. NO. 01-110074
EXHIBIT 31 PHASE 3

- NOTES:
1. VERTICAL LINES FROM OVERFLOW TO FIRST HORIZONTAL RUN, 3" MIN.
 2. ALL OTHER DRAIN LINES: 4" MIN.
 3. OVERFLOW PIPING ROUTED IN CEILING SPACE. PIPE HANGERS AND SUPPORTS PER SECTION 22 05 29 AND APPROVED SUBMITTAL.
 4. AT EXISTING DRAINS: REPLACE EXISTING HARDWARE, WIREBRUSH AND TINE COAT EXISTING COMPONENTS, REWORK EXISTING LEAD SEAL AND WATER TEST COMPLETED ASSEMBLY.

BCA
NEW OVERFLOW DRAIN

ARCHITECTURE
PLANNING
ENGINEERING

CANADA COLLEGE - BURNABY, B.C. & RENOVATIONS
SAN MATEO COUNTY, CALIFORNIA, U.S.A.
FILE NO. 43-C1 APPL. NO. 01-110074
REVISION: 01/12/04
REVISION: 01/12/04

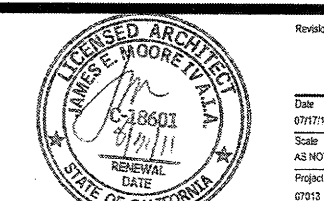

47
ASK-17A