

20N RECEPTION - 01
1/4" = 1'-0"

20J OFFICE - 02
1/4" = 1'-0"

10J OFFICE - 03
1/4" = 1'-0"

20E PERSONNEL - 04
1/4" = 1'-0"


10E COPY ROOM - 05
1/4" = 1'-0"

20A HALLWAY - 08
1/4" = 1'-0"

REVISIONS: (1) (2) (3) (100)

NO.	DATE	REASON	BY
1	10/15/01	ADDENDUM#1	

ISSUE FOR PROGRESS REVIEW 01/15/01
ISSUE FOR PLAN CHECK 01/25/01
ISSUE FOR FINAL REVIEW 05/09/01
ISSUE FOR BID
ISSUE FOR CONSTRUCTION

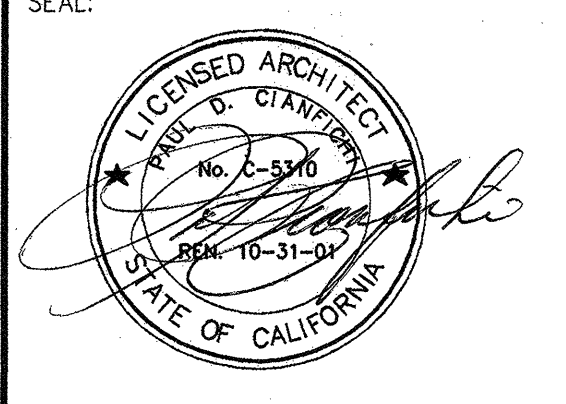

CONSULTANT:
ARCHITECT:
CONSULTANT:

ARCHITECT:
CIANFICHI
ARCHITECTURE + PLANNING
30 ANNE COURT
WALNUT CREEK, CA 94598
TEL: (925) 256-8638
FAX: (925) 256-8652

PROJECT:
CHILD DEVELOPMENT CENTER
CANADA COLLEGE
4200 FARM HILL BLVD.
REDWOOD CITY, CA 94061
SAN MATEO COUNTY COMMUNITY COLLEGE DISTRICT

STAMP:
APPROVED
DIV OF THE STATE ARCHITECT
AC BR FLS BH SS MT
APPL NO. 21-103529 DATE 3/5/12
APPL. NUMBER:

KEY PLAN:
AS-BUILT

SHEET TITLE:
INTERIOR ELEVATIONS

DRAWN BY: PROJECT NO.:
GL 304.99
CHECKED BY: DATE:
BA 01-25-2001
APPL NO.: SHEET:
DATA NO.: **A4.3a**
NO. OF: