


SOUTH ELEVATION



1

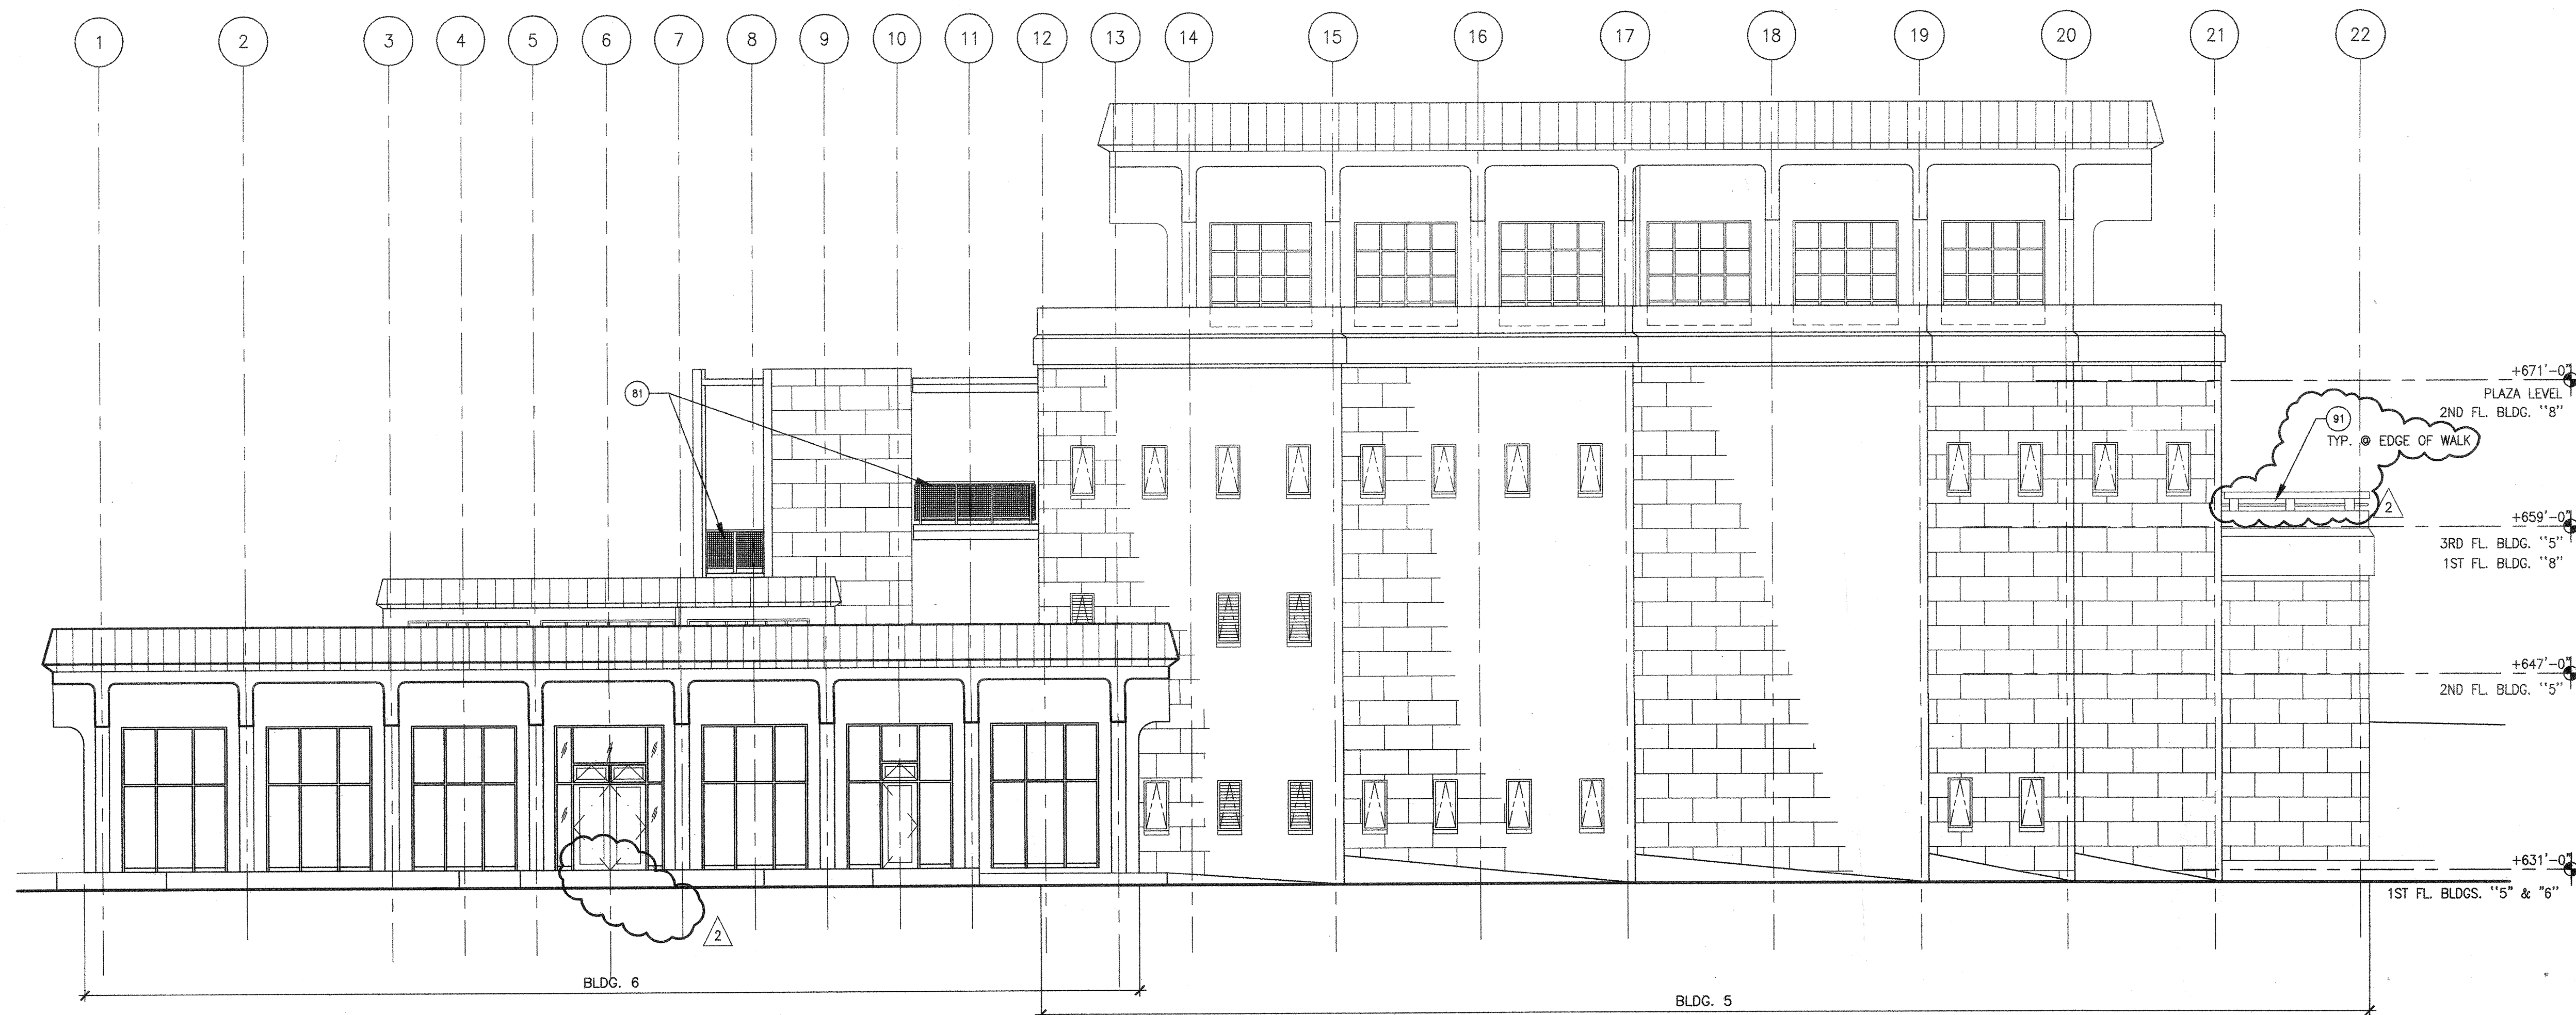

WEST ELEVATION



2

SHEET NOTES

- 47 CONCRETE STAIRS (SEE DET. 2/A7.1)
- 48 ELEVATOR
- 81 MODIFY (E) METAL GUARDRAIL (SEE DET. 8/A10.2.1). EXTEND FRAME AND MESH FABRIC TO LEAVE LESS THAN 4" OPEN SPACE TO WALLS/ FLOOR SLAB.
- 91 MODIFY (E) CONC. GUARDRAIL (SEE DET. 16/A10.2.1)

BC|A

architecture
planning
interiors

Bunton Clifford Associates, Inc.
210 Hammond Ave.
Fremont, California 94539
[T] 510.445.1000
[F] 510.445.1005
www.BCAincOnline.com

ARCHITECT	ENGINEER

- GENERAL NOTES**
1. This sheet is part of a set and is not to be used alone.
 2. This sheet is not to be used for construction unless the architect's stamp and signature appear on the drawings and the status box indicates drawings have been released for construction.
 3. These plans and prints (based) as instruments of service, are owned by the architect and are for use on this project only. Reproduction and/or distribution without the prior written consent of the architect is forbidden.
 4. Copyright Bunton Clifford Associates, 2008

REVISION	REMARKS	DATE
1	ADDENDUM NO. 1	08/18/08
2	ADDENDUM NO. 2	11/09/09

DRAWING STATUS	DATE
● DSA PLAN CHECK	08/28/08
● DSA BACK CHECK	01/22/09
● BIDDING	08/18/09
○ CONSTRUCTION	

FILE NO. 41-C1

IDENTIFICATION STAMP
DIV. OF THE STATE ARCHITECT

01- 110074

AC _____ FLS _____ SS _____

DATE _____

GENERAL NOTES



LEGEND

BUILDINGS 5 & 6 RENOVATIONS

San Mateo County Community College District

APPROVED
DIV. OF THE STATE ARCHITECT
AC 111 FLS 06 SS JES
NOV 11 2007 DATE 3/26/10

CAÑADA COLLEGE
4200 Farm Hill Boulevard
Redwood City, CA 94061

EXTERIOR ELEVATIONS

Date 08/29/08
Drawing Number
Scale AS NOTED
Project Number 07013

A5.2