

REVISION DESCRIPTION INITIAL DATE

APPENDIX TKG 4/7/04

PRE-APPLICATION REVIEW 02/05/04

ISSUED FOR PLAN CHECK 03/03/04

ISSUED FOR PERMIT 03/03/04

ISSUED FOR BID

ISSUED FOR CONSTRUCTION

SCALE

APPROVED ARCHITECT

THOMAS K. BOYD
No. C 7389
Exp. 3-31-07
STATE OF CALIFORNIA

PROJECT: INTERACTIVE
R E S O U R C E S
ARCHITECTURE • PLANNING • ENGINEERING
117 BAY PLAZA
POINT RICHMOND
CALIFORNIA 94801
(910) 236-7435
(FAX) 232-5328
http://www.intres.com

PROJECT: BUILDING NO. 18
(NORTH HALL)
MODERNIZATION
COLLEGE OF SAN MATEO
1700 WEST HILSDALE BLVD.
SAN MATEO, CA 94402

PROJECT: SAN MATEO CO. COMMUNITY
COLLEGE DISTRICT

PROJ. NO. 2002-066.02
PREPARATION AND REVIEW
DRAWN BY BA
DESIGNER TKG
PROJ. MGR. TKG
PEER REVIEW
SHEET NUMBER





APPROVED
DIV. OF THE STATE ARCHITECT
APPPL 106047
DATE RS SS

APPROVED
DIV. OF THE STATE ARCHITECT
APPPL 106047
DATE RS SS

SHEET TITLE:
INTERIOR
ELEVATIONS

PROJ. NO. 2002-066.02
PREPARATION AND REVIEW
DRAWN BY BA
DESIGNER TKG
PROJ. MGR. TKG
PEER REVIEW
SHEET NUMBER

NUMBER: OF: MOD A5.6

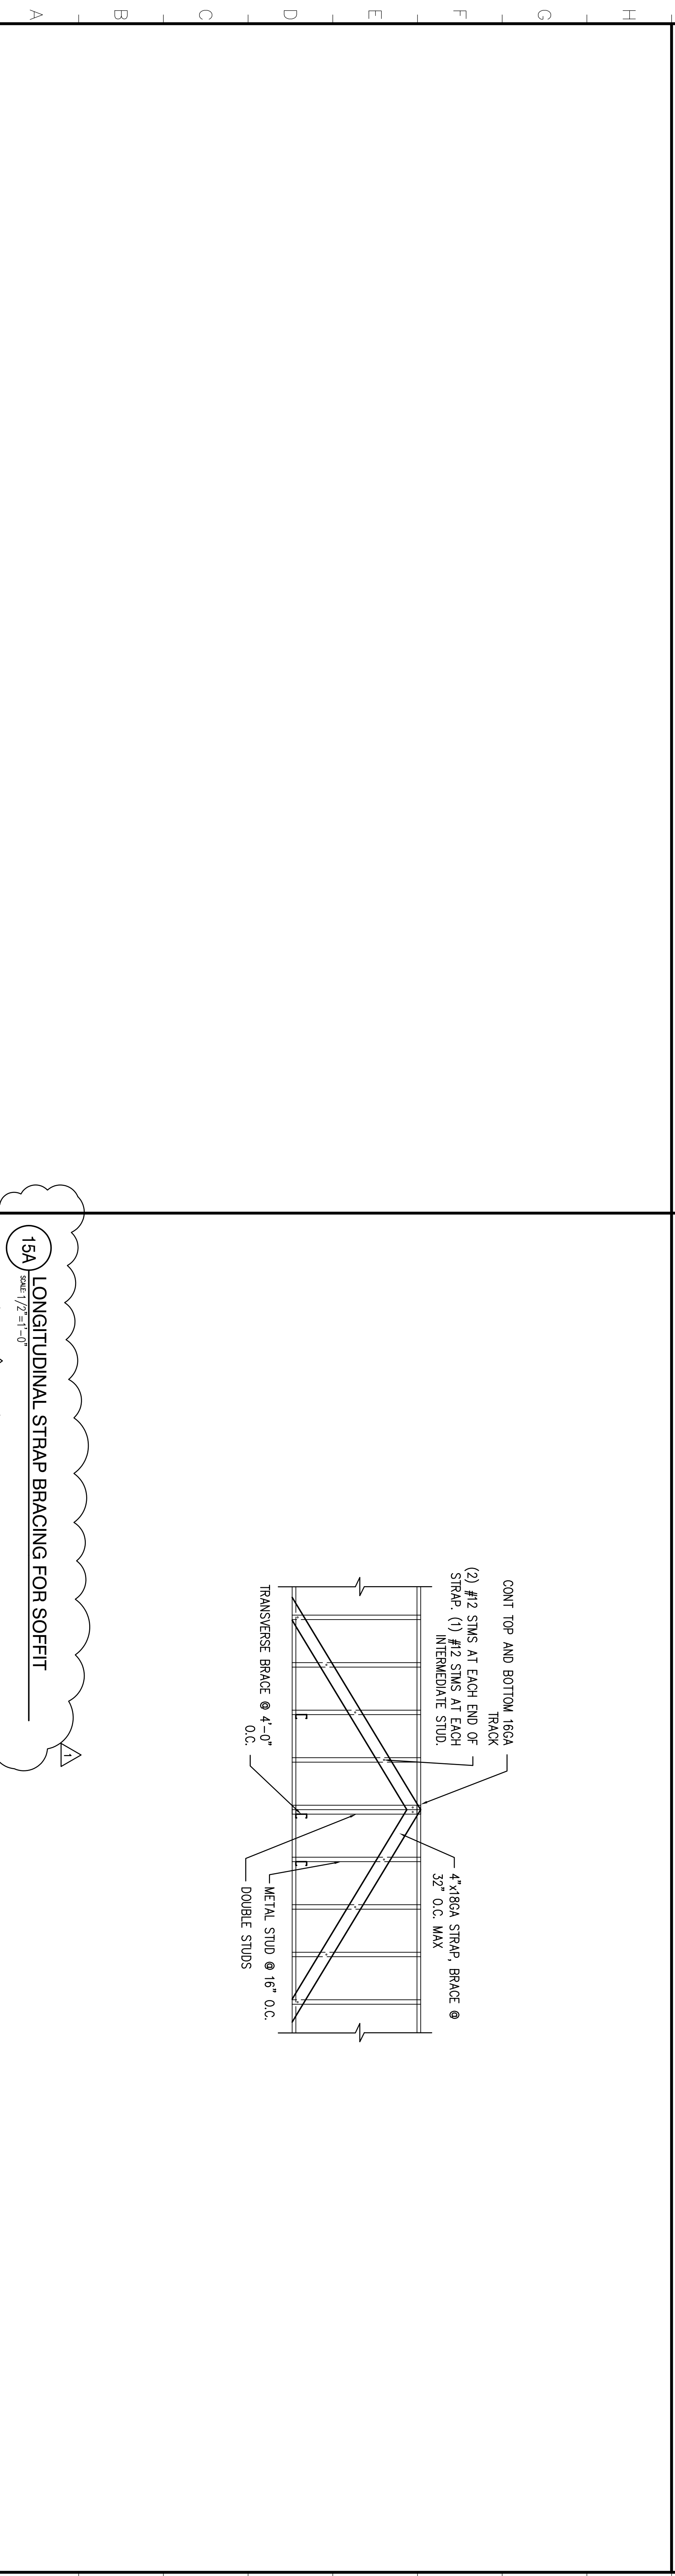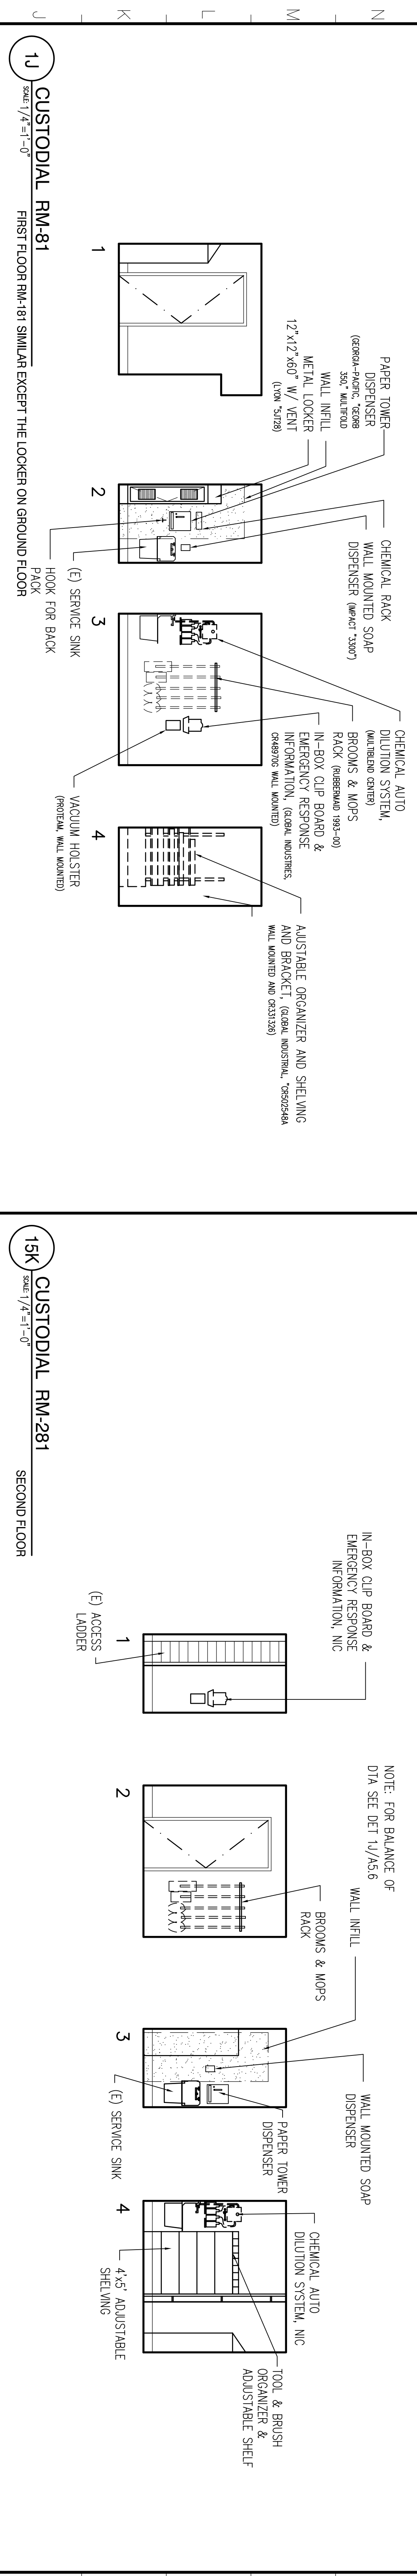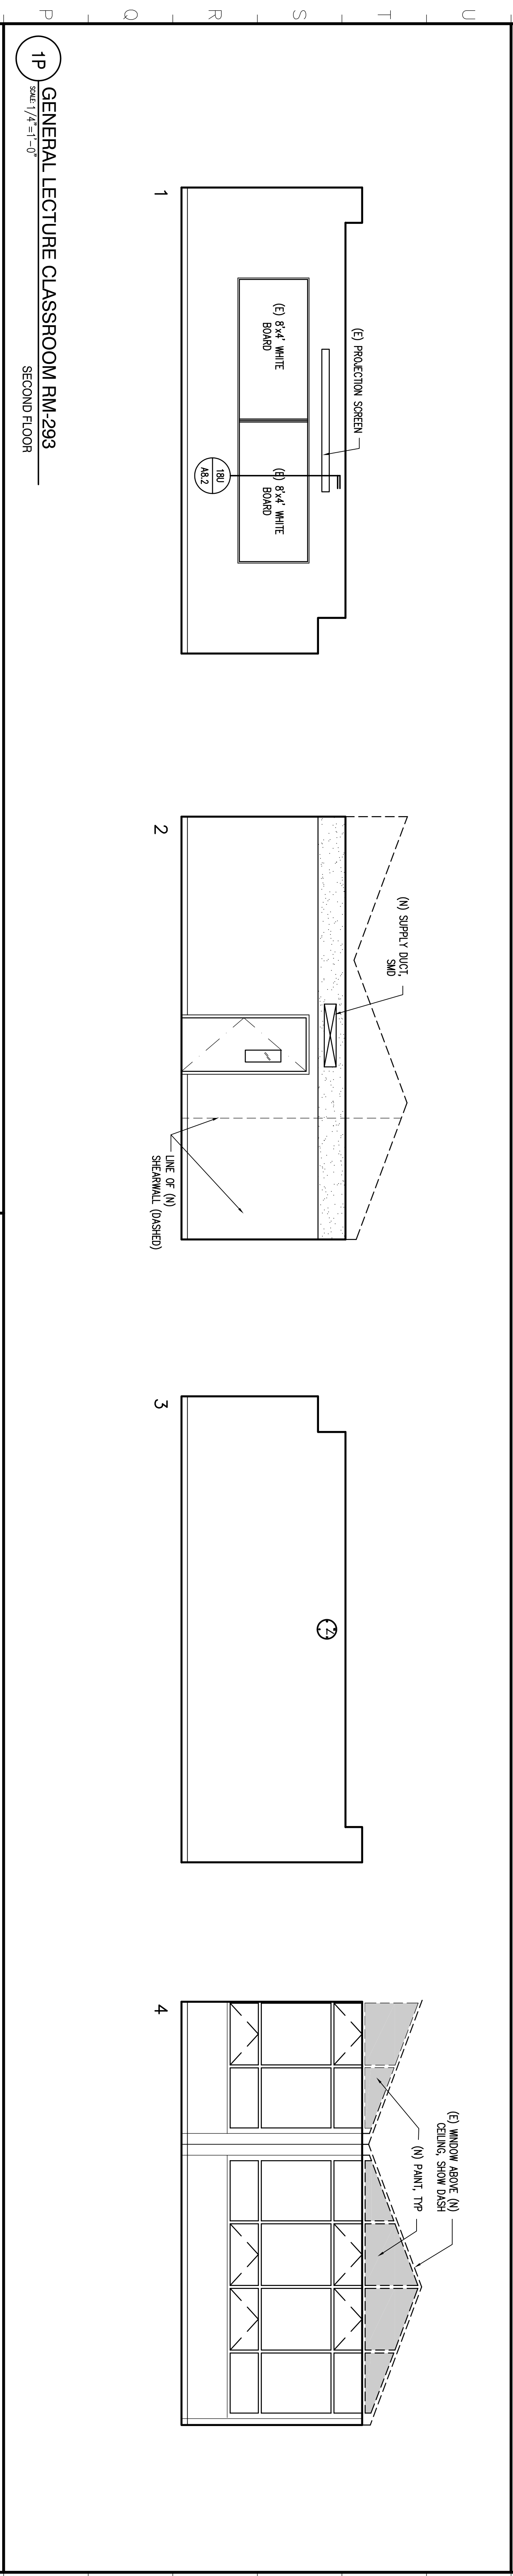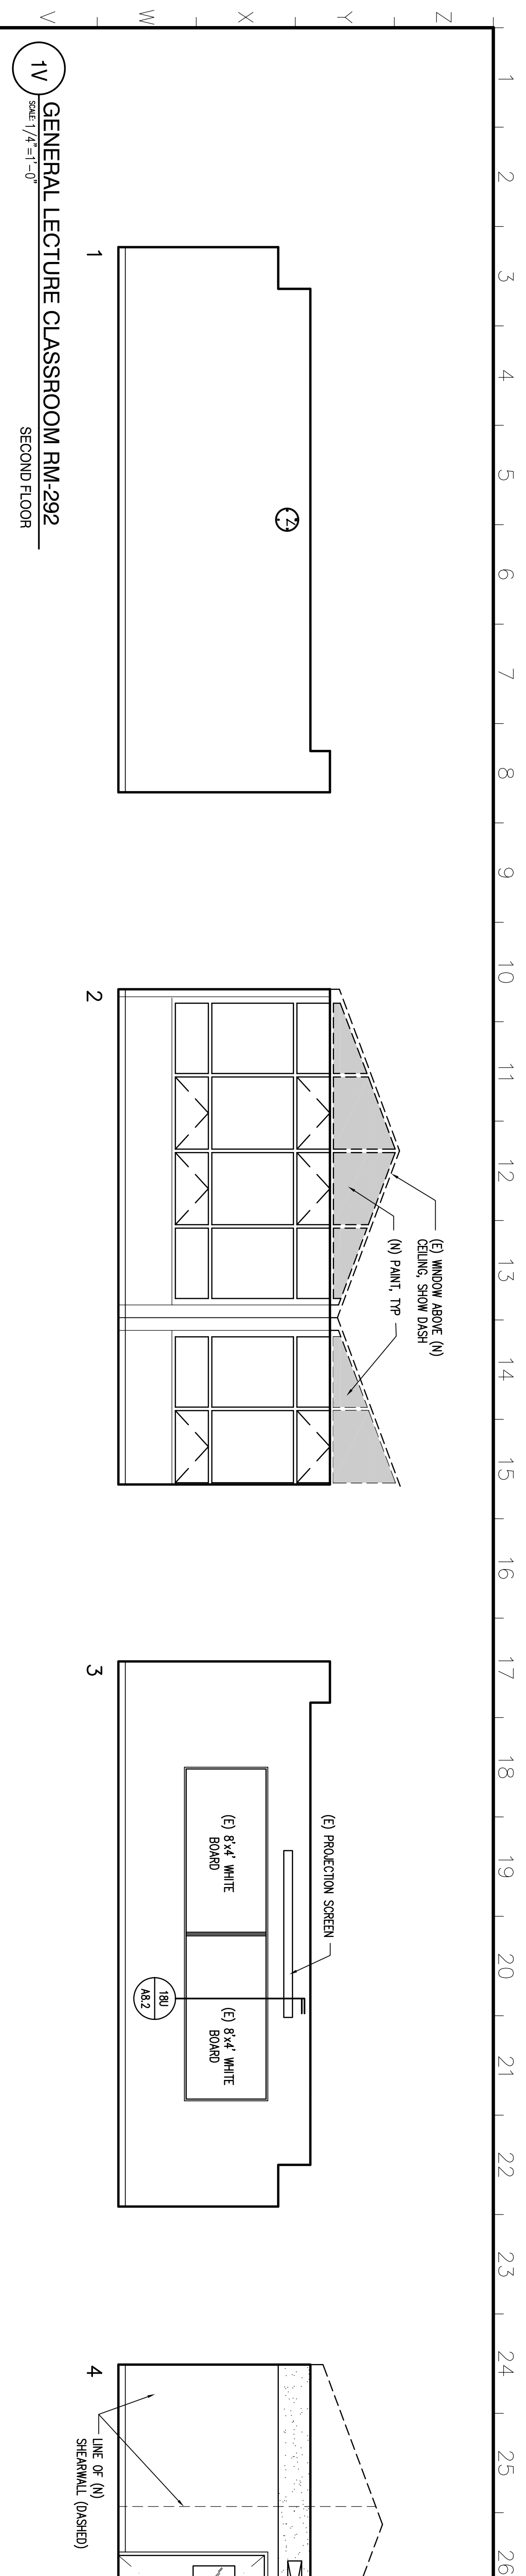

Z:\2002\0202066\02066\02066\SET OF DIVS FOR OWNER\12-23-04\ARCH\TECHNICAL\MODERNIZATION\AS INTERIOR ELEVATIONS.dwg, 12/22/2006 3:17:54 PM