


ASI-16

ASI 16  
FILE NO. 43-C1  
APPL. NO. 01-110074

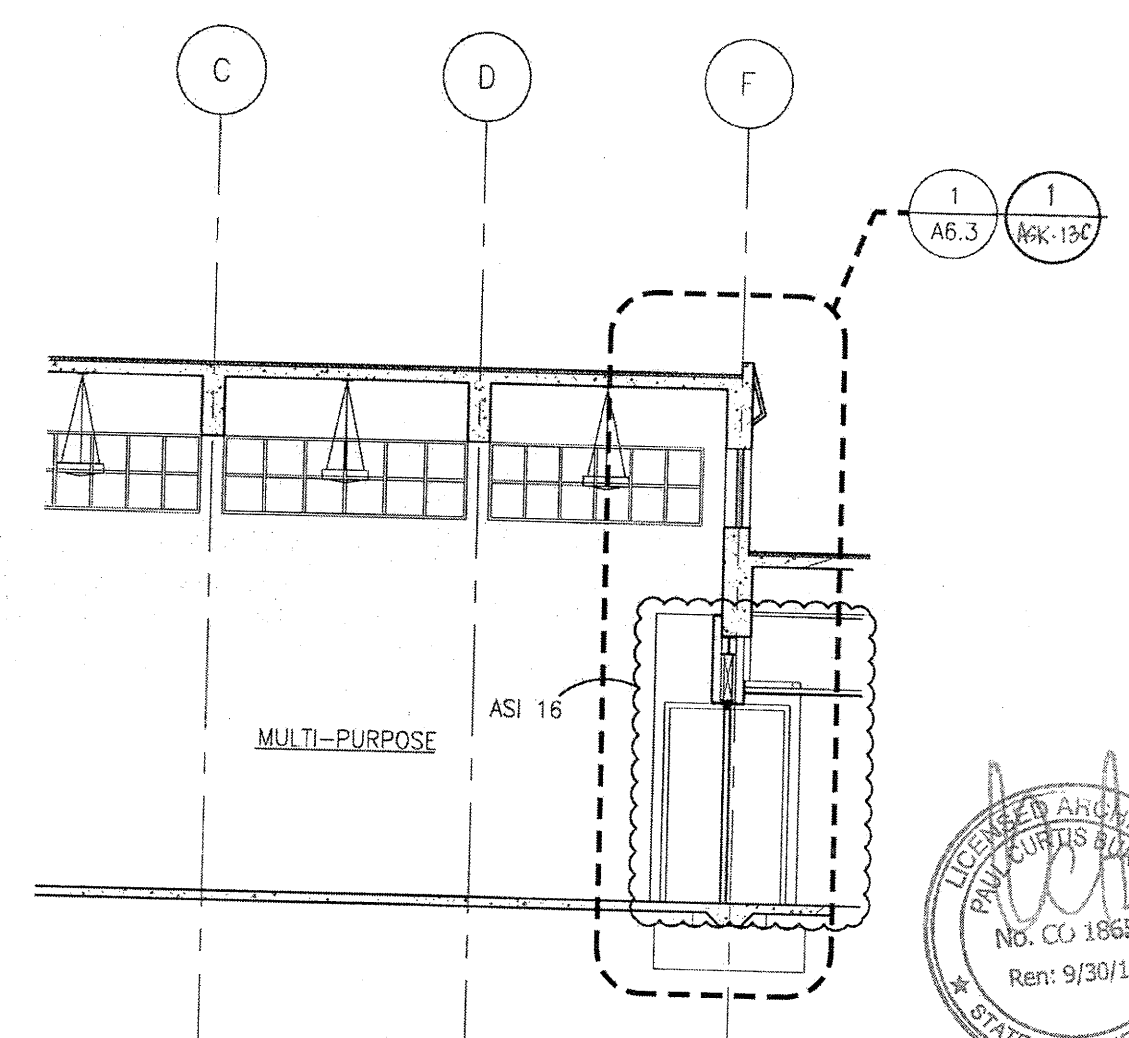

1 PARTIAL BUILDING SECTION

REF: 3/A6.2

SCALE: 1/4" = 1'-0"

<b>BCIA</b> architecture planning interiors <small>1000 University Ave.          Berkeley, CA 94702          (415) 841-8800          (415) 841-8808</small>	The <b>1ST FLOOR FOLDING PARTITION</b>	Project Name: CANADA COLLEGE - BUILDINGS 5 & 6 RENOVATIONS SAN MATEO COUNTY COMMUNITY COLLEGE DISTRICT 1200 FARM HILL BOULEVARD REDWOOD CITY, CA 94061 FILE NO. 43-C1 APPL. 01-110074	Date: 09/16/11 Scale: AS NOTED Project Number: 0703	Designer: JFC ASK-13B
	Project Name: CANADA COLLEGE - BUILDINGS 5 & 6 RENOVATIONS SAN MATEO COUNTY COMMUNITY COLLEGE DISTRICT 1200 FARM HILL BOULEVARD REDWOOD CITY, CA 94061 FILE NO. 43-C1 APPL. 01-110074		Date: 09/16/11 Scale: AS NOTED Project Number: 0703	Designer: JFC ASK-13B
