



QUAD ELEVATOR EAST ELEVATION

SCALE 1/4" = 1'-0"

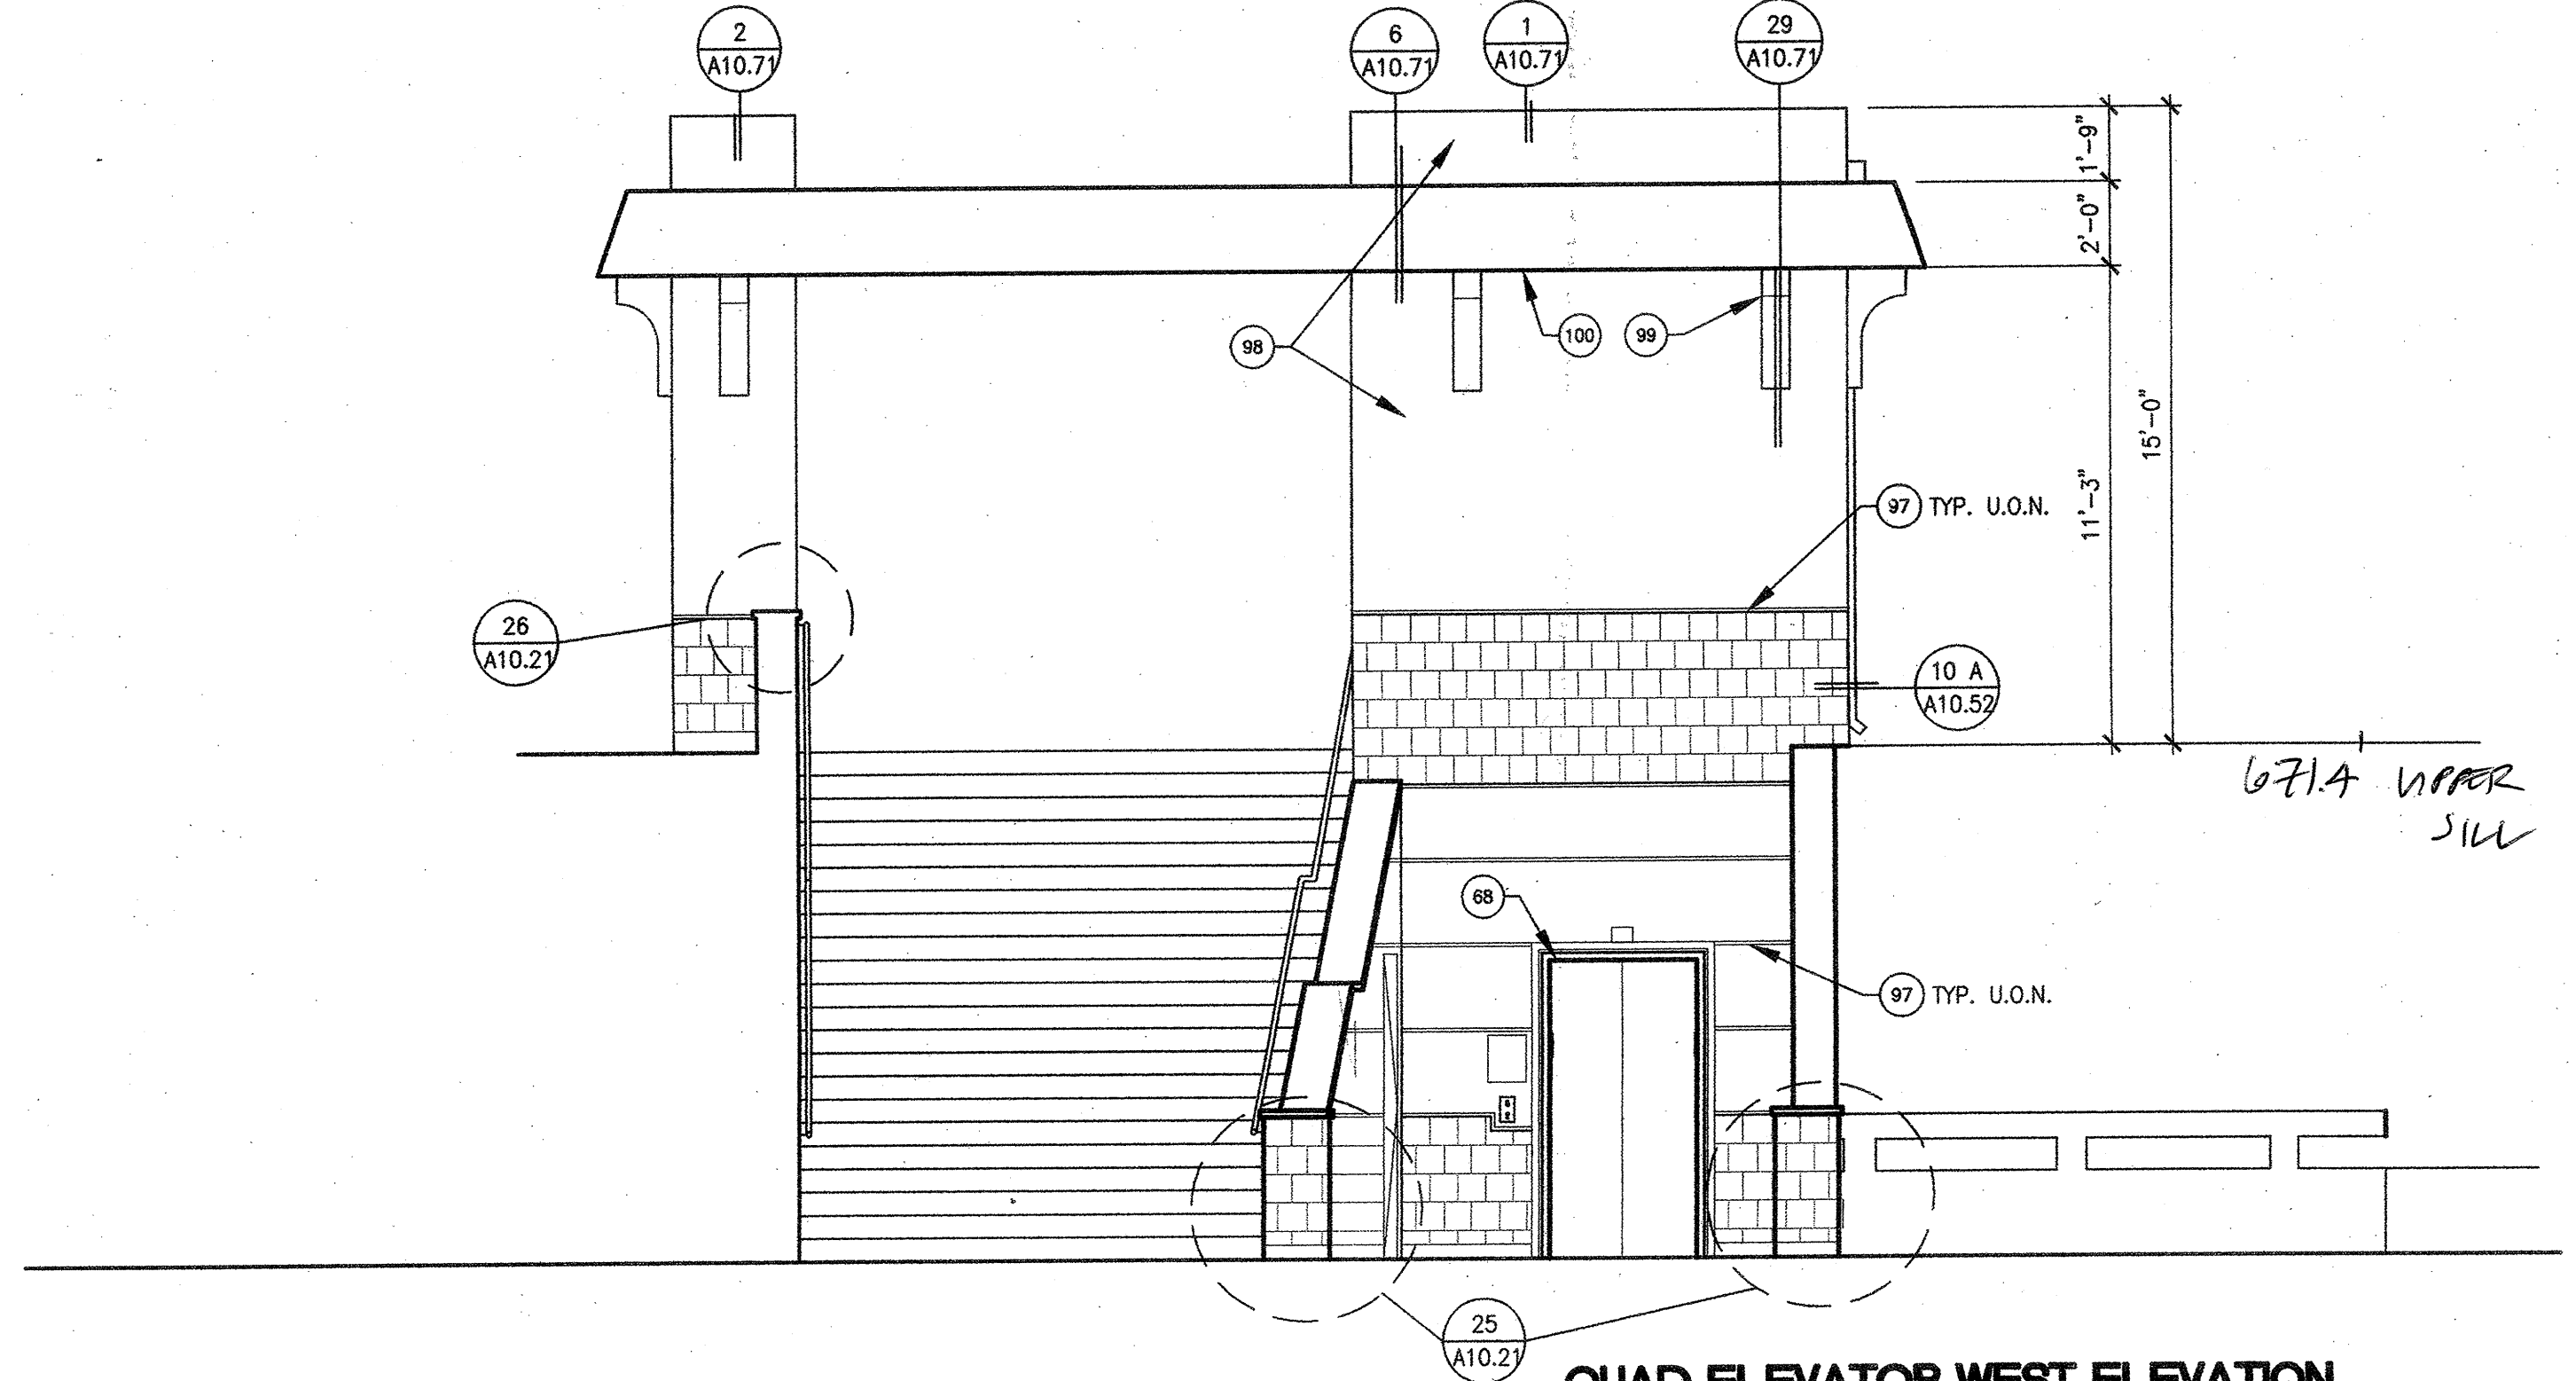

QUAD ELEVATOR WEST ELEVATION

SCALE 1/4" = 1'-0"

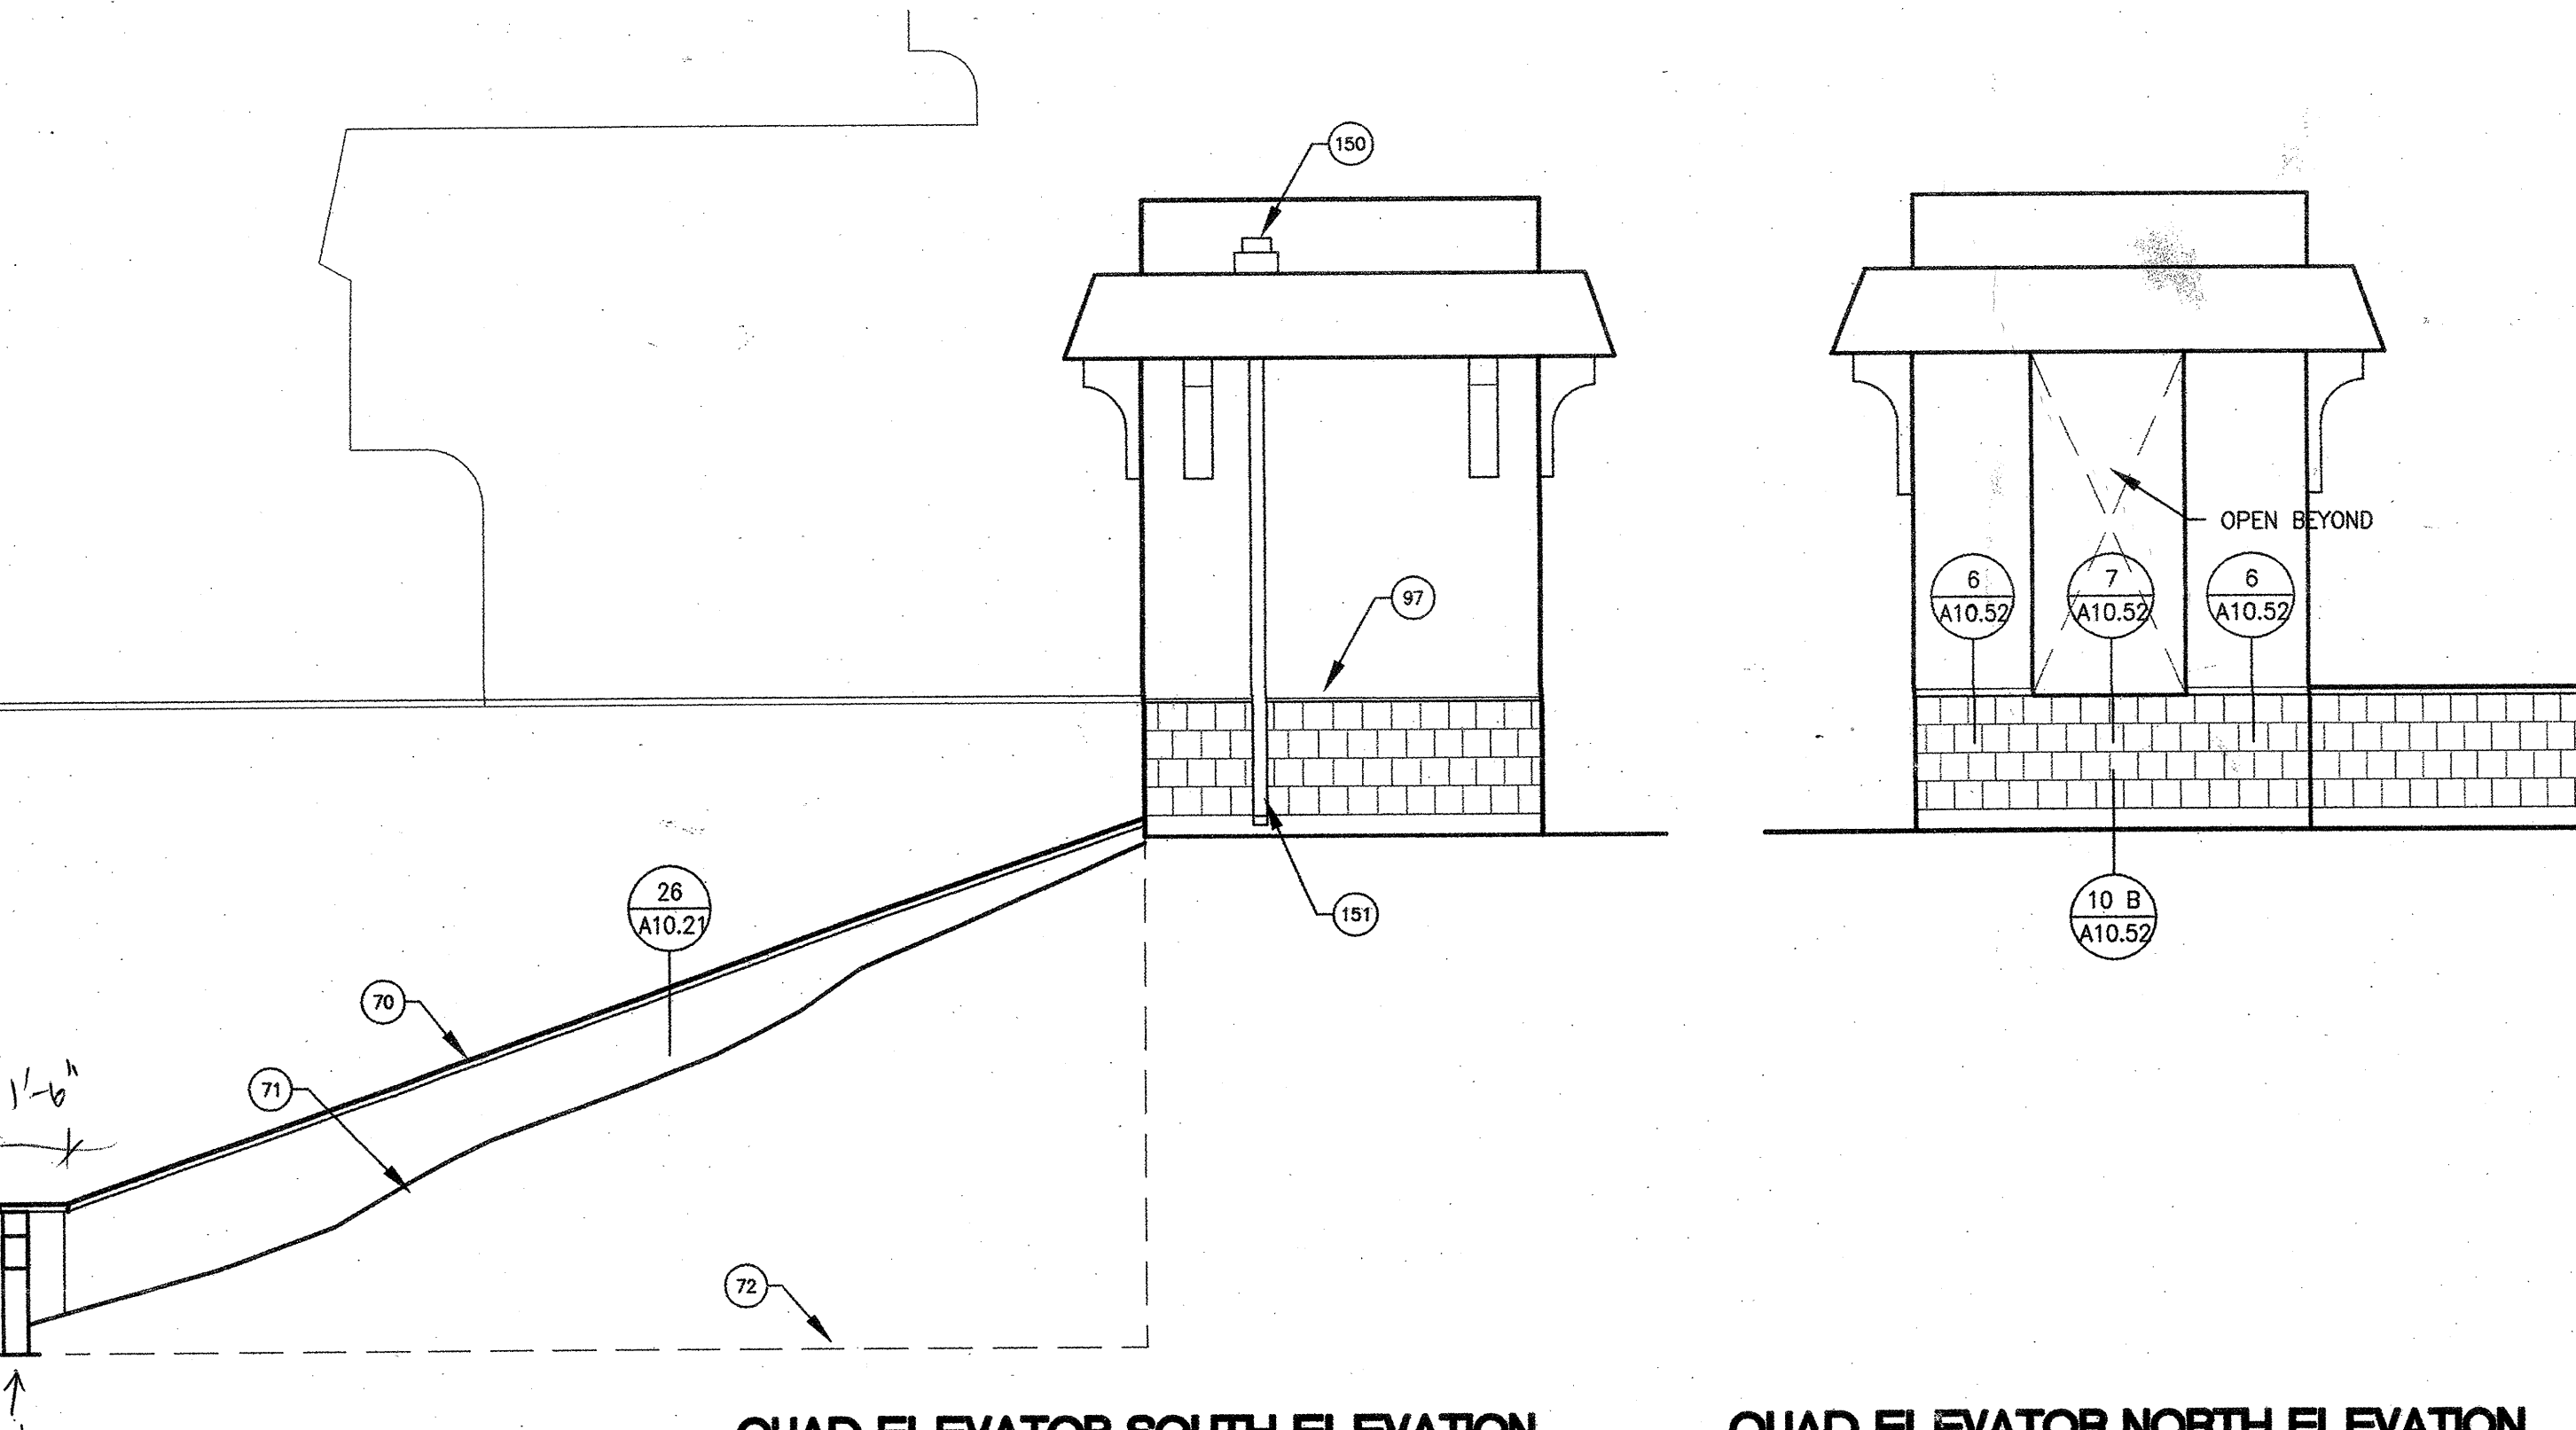


QUAD ELEVATOR SOUTH ELEVATION

SCALE 1/4" = 1'-0"


QUAD ELEVATOR NORTH ELEVATION

SCALE 1/4" = 1'-0"

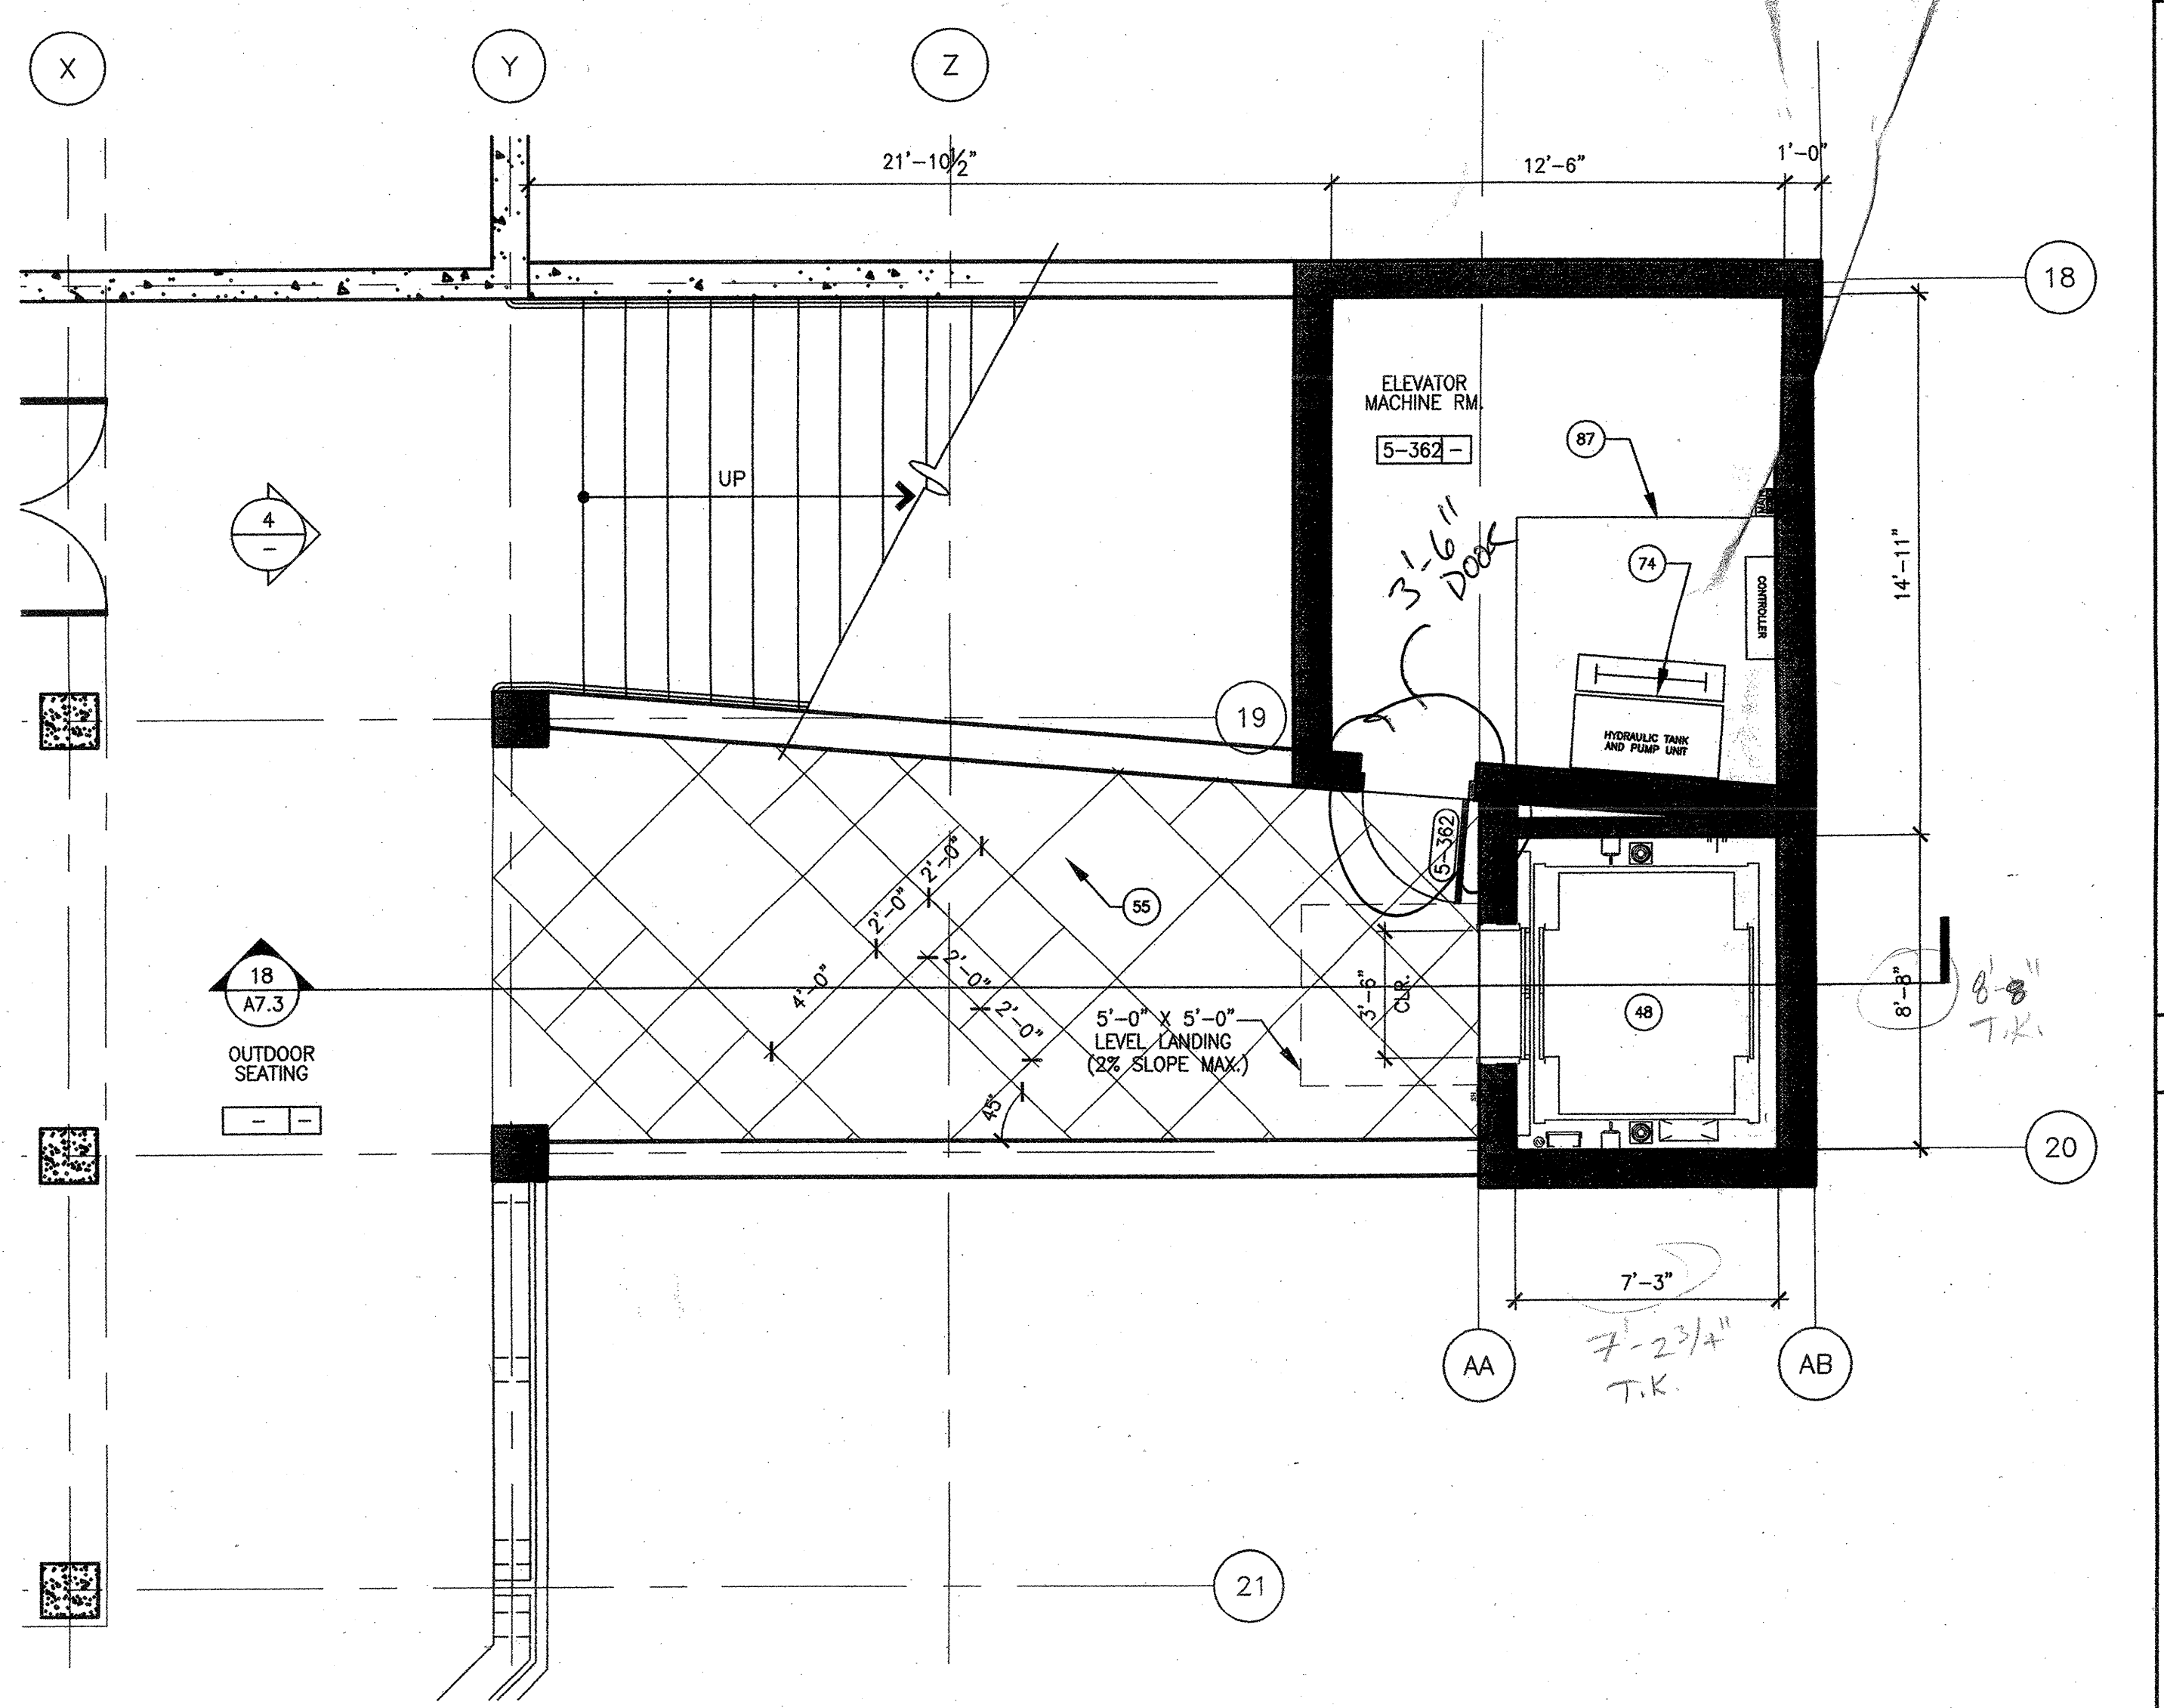

LOWER LEVEL QUAD ELEVATOR PLAN

SCALE 1/4" = 1'-0"

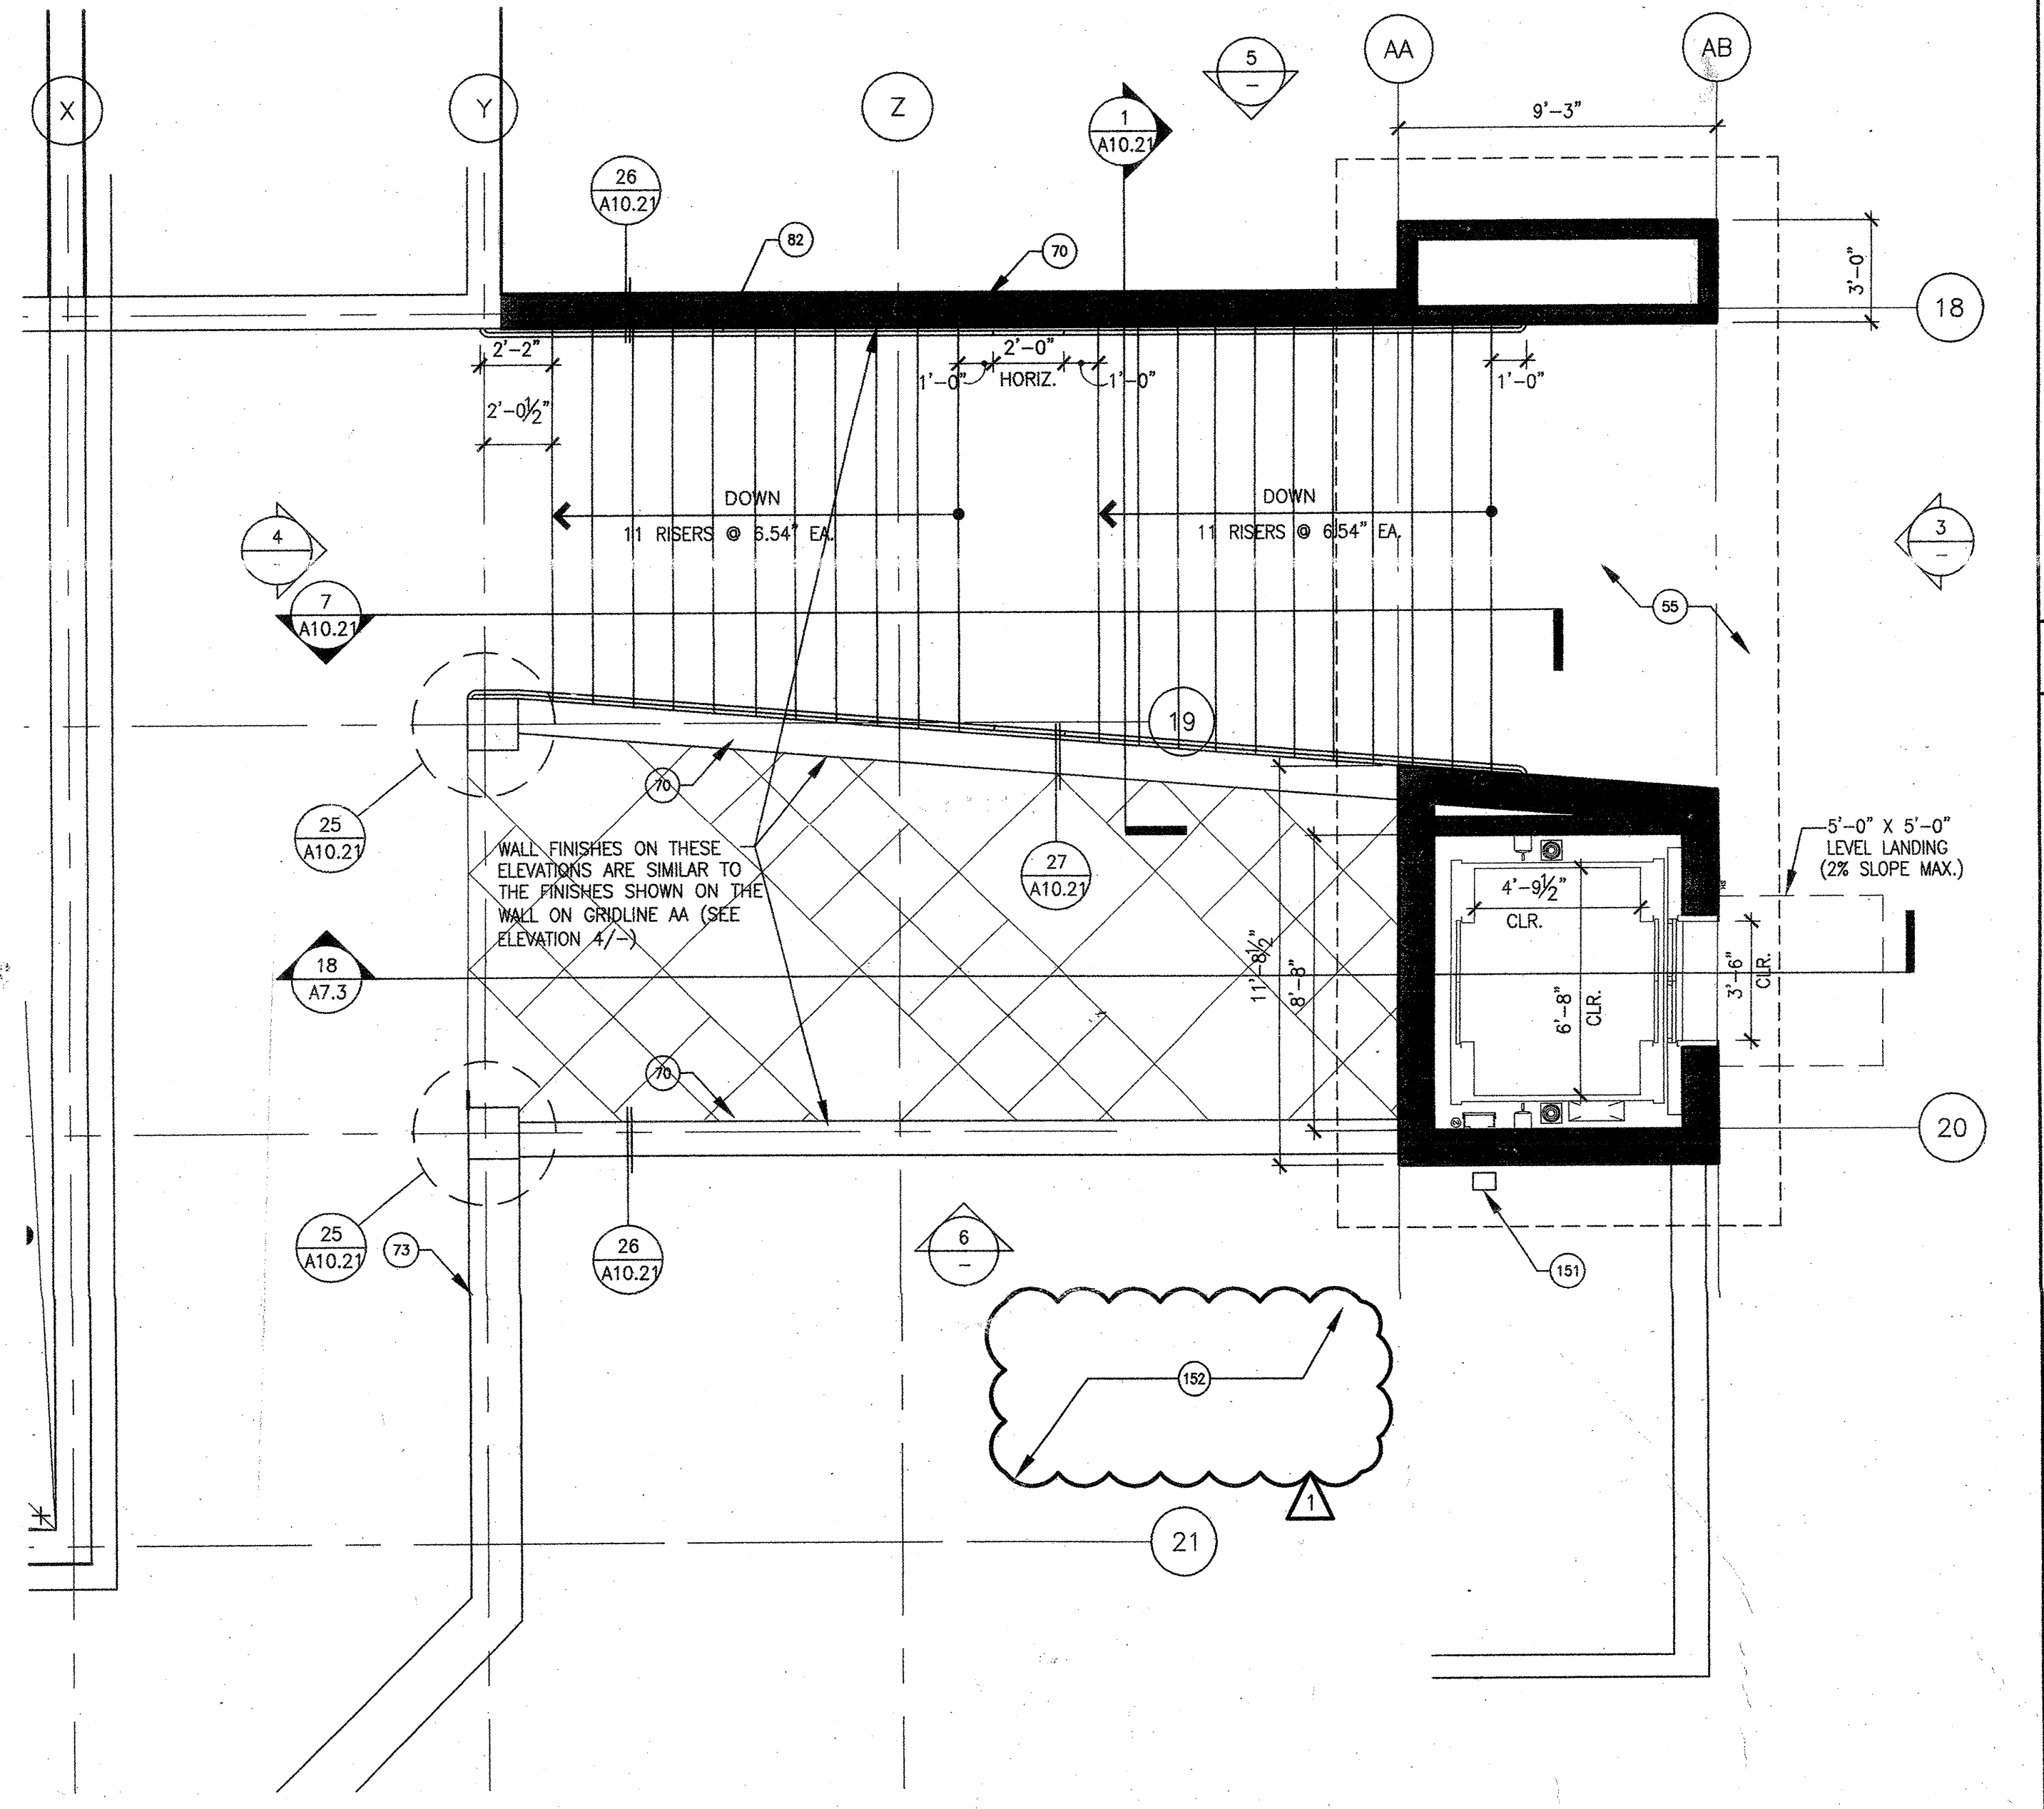

UPPER LEVEL QUAD ELEVATOR PLAN

SCALE 1/4" = 1'-0"

SHEET NOTES

- 9 MECHANICAL SHAFT
- 48 ELEVATOR (SEE SHT. A7.3)
- 55 CONCRETE PAVING AT DECK. (SEE DET. 21 & 22/A10.21)
- 68 STAINLESS STEEL ELEVATOR DOORS
- 70 CONCRETE RETAINING WALL W/ STONE TILE VENEER. (SEE DETS. 7, 8 & 10/A10.52)
- 71 FINISH GRADE
- 72 LINE OF WALK BEYOND
- 73 (E) SEAT WALL TO REMAIN
- 74 ELEVATOR MOTOR
- 78 CONCEALED SEAM METAL ROOF SYSTEM
- 82 JOINT BETWEEN (N) & (E) CONC. WALLS. (SEE DET. 13/A10.21.)
- 87 6" H. CONC. HOUSEKEEPING PAD
- 97 METAL REVEAL CHANNEL SCREED W/ 1" WIDE REVEAL. PAINT TO MATCH ROOF CORBELS.
- 98 EXTERIOR CEMENT PLASTER ASSEMBLY
- 99 ROOF CORBEL, PAINTED (ARCHITECT TO SELECT COLOR)
- 100 MANSARD ROOF TRIM, PAINTED (ARCHITECT TO SELECT COLOR)
- 101 TILE VENEER AT SIDE WALLS AND SILL OF WALL OPENING, TYP.
- 150 ROOF SCUPPER (SEE DETS. 12 & 17/A10.71)
- 151 DOWNSPOUT (SEE DET. 13/A10.71)
- 152 LANDSCAPING & IRRIGATION TO BE REPLACED OR REPAIRED TO PRE CONSTRUCTION CONDITIONS

GENERAL NOTES

- A. STANDARD DOOR DISTANCES/CLEARANCES ARE AS FOLLOWS:
- 18" CLR. @ INTERIOR DOORS
 - @ PROTRUSIONS > 8"
 - 24" CLR. @ EXTERIOR DOORS
 - @ PROTRUSIONS > 8"
- B. ALL WALL AND CEILING ACCESS DOORS SHALL BE 1-HOUR RATED IN CORRIDORS AND 2-HOUR RATED IN OCCUPANCY SEPARATION WALLS.
- C. THE FLOOR OR LANDING LENGTH ON EACH SIDE OF AN EXIT DOOR SHALL BE LEVEL (MAX. SLOPE 1/4" PER FOOT) AND CLEAR AT LEAST 60 INCHES IN THE DIRECTION OF THE DOOR SWING (PULL SIDE) AND 48 INCHES ON THE PUSH SIDE, WHEN MEASURED AT RIGHT ANGLES FROM DOOR IN CLOSED POSITION. THE CLEAR WIDTH SHALL EXTEND 24 INCHES BEYOND THE SWING ON THE PULL SIDE OF ALL EXTERIOR EXIT DOORS AND 18 INCHES FOR INTERIOR EXIT DOORS. THE CLEAR WIDTH SHALL EXTEND 12 INCHES BEYOND THE STRIKE EDGE OF THE PUSH SIDE OF ALL EXIT DOORS. DOORS SHALL BE EQUIPPED WITH BOTH A LATCH AND CLOSER.
- D. SEE SHEET A8.1 & A8.2 FOR DOOR, WINDOW AND FINISH SCHEDULES. RATED DOORS AND FINISH HARDWARE ARE INDICATED ON THE DOOR SCHEDULE.
- E. PROVIDE ADDITIONAL STUD FRAMING FOR OPENINGS AS INDICATED ON STRUCTURAL PLANS AND ON DOOR AND WINDOW DETAILS.
- F. PROVIDE BACKING IN STUD WALLS FOR ALL WALL-MOUNTED CABINETS AND ACCESSORIES, TYP.

LEGEND

- 60" DIA. CLEAR SPACE FOR SINGLE WHEELCHAIR
- 30" x 48" ACCESSIBLE CLEAR SPACE
- (E) CONC. RETAINING WALL. SEE STRUCTURAL DWGS FOR SIZE
- EXISTING CONSTRUCTION TO REMAIN
- NEW CONSTRUCTION
- WALL TYPE, SEE DET. 15/A10.51
- RECESSED FIRE EXTINGUISHER CABINET. SEE DET. 25/A10.51
- F.E.C. WALL MOUNTED FIRE EXTINGUISHER
- F.E. FLOOR DRAIN, SEE PLUMBING DWGS

BC|A
 architecture
 planning
 interiors

Bunton Clifford Associates, Inc.
 210 Hammond Ave.
 Fremont, California 94539
 [T] 510.445.1000
 [F] 510.445.1005
 www.BCAincOnline.com

ARCHITECT: **BCA**
 ENGINEER: **BCA**

1. This sheet is part of a set and is not to be used alone.
 2. This sheet is not to be used for construction unless the architect's stamp and signature appear on the drawings and the status box indicates drawings have been released for construction.
 3. These plans and prints thereof, as instruments of service, are owned by the architect and are for use on this project only. Reproduction and/or distribution without the prior written consent of the architect is forbidden.
 4. Copyright Bunton Clifford Associates, 2008

REMARKS	DATE
ADDDDDDD DD	DD/BB/YY

DRAWING STATUS	DATE
DDA PLAN CHECK	DD/BB/YY
DDA BOOK CHECK	DD/BB/YY
BIDDING	DD/BB/YY
CONSTRUCTION	

FILE NO. 41-C1
 IDENTIFICATION STAMP
 DIV. OF THE STATE ARCHITECT
 01- 110074
 AC, PLS, SS
 DATE

BUILDINGS 5 & 6 RENOVATIONS
 San Mateo County Community College District

BID ADDENDA

APPROVED BY DIV. OF THE STATE ARCHITECT
 AC, PLS, SS
 APPL. NO. 10074 DATE 2/2/08

CAÑADA COLLEGE
 4200 Farm Hill Boulevard
 Redwood City, CA 94061

ENLARGED EXTERIOR ELEVATOR PLANS AND ELEVATIONS

Date	08/29/08	Drawing Number	A7.1
Scale	AS NOTED		
Project Number	07013		