


REVISION	DESCRIPTION	INITIAL	DATE
1	RECORD DRAWINGS	TGB	10/10/05
2	ADDENDUM	TGB	4/1/04
3	PRE-APPLICATION REVIEW		02/06/04
4	ISSUED FOR PLAN CHECK		03/03/04
5	ISSUED FOR PERMIT		03/03/04
6	ISSUED FOR BID		03/03/04
7	ISSUED FOR CONSTRUCTION		

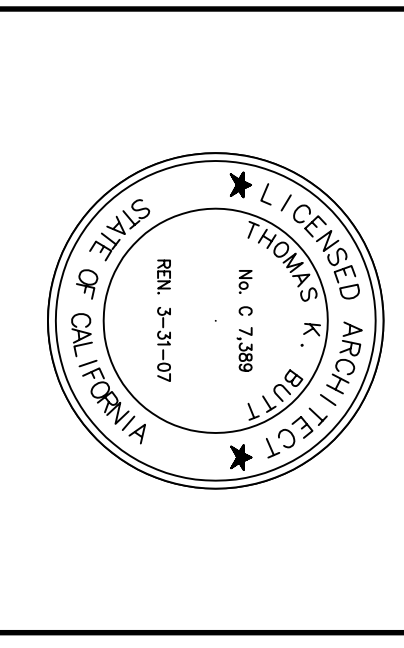

CONSULTANT:  
**INTERACTIVE**  
 ARCHITECTURE • PLANNING • ENGINEERING  
 117 PARK PLACE  
 POINT RICHMOND  
 CALIFORNIA 94801  
 (910) 238-7435  
 (FAX) 232-5325  
 http://www.interactive.com

PROJECT:  
**BUILDING NO. 18**  
**(NORTH HALL)**  
**MODERNIZATION**  
 COLLEGE OF SAN MATEO  
 1700 WEST HILLSDALE BLVD,  
 SAN MATEO, CA 94402  
 SAN MATEO CO. COMMUNITY  
 COLLEGE DISTRICT

DR. ROBERTA L. SIMONE OFFICE OF RESILIENT SERVICES	APPROVED APPL 106047
DATE: 1/5/05	DATE: 1/5/05
DR. OF THE STATE ARCHITECT	APPROVED APPL 106047
DATE: 1/5/05	DATE: 1/5/05

SHEET TITLE:  
**DETAILS**  
**MOD**  
**A8.3**  
 OF