


PROJECT
RECORD SET

BUILDING 4
SKYLINE COLLEGE


SAN MATEO COUNTY
COMMUNITY COLLEGE
DISTRICT

CIP2 DESIGN-BUILD
PROJECT
BUILDING 4

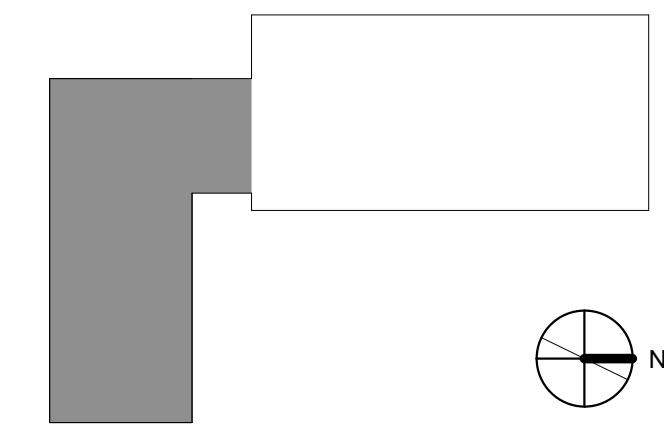

PROJECT NO.: 07012.00 DRAWN BY: LT
DATE: 05/01/08 CHECKED BY: LG
SCALE: As indicated

SHEET TITLE:
LEVEL 2 -
ENLARGED
FLOOR PLAN -
SECTOR A

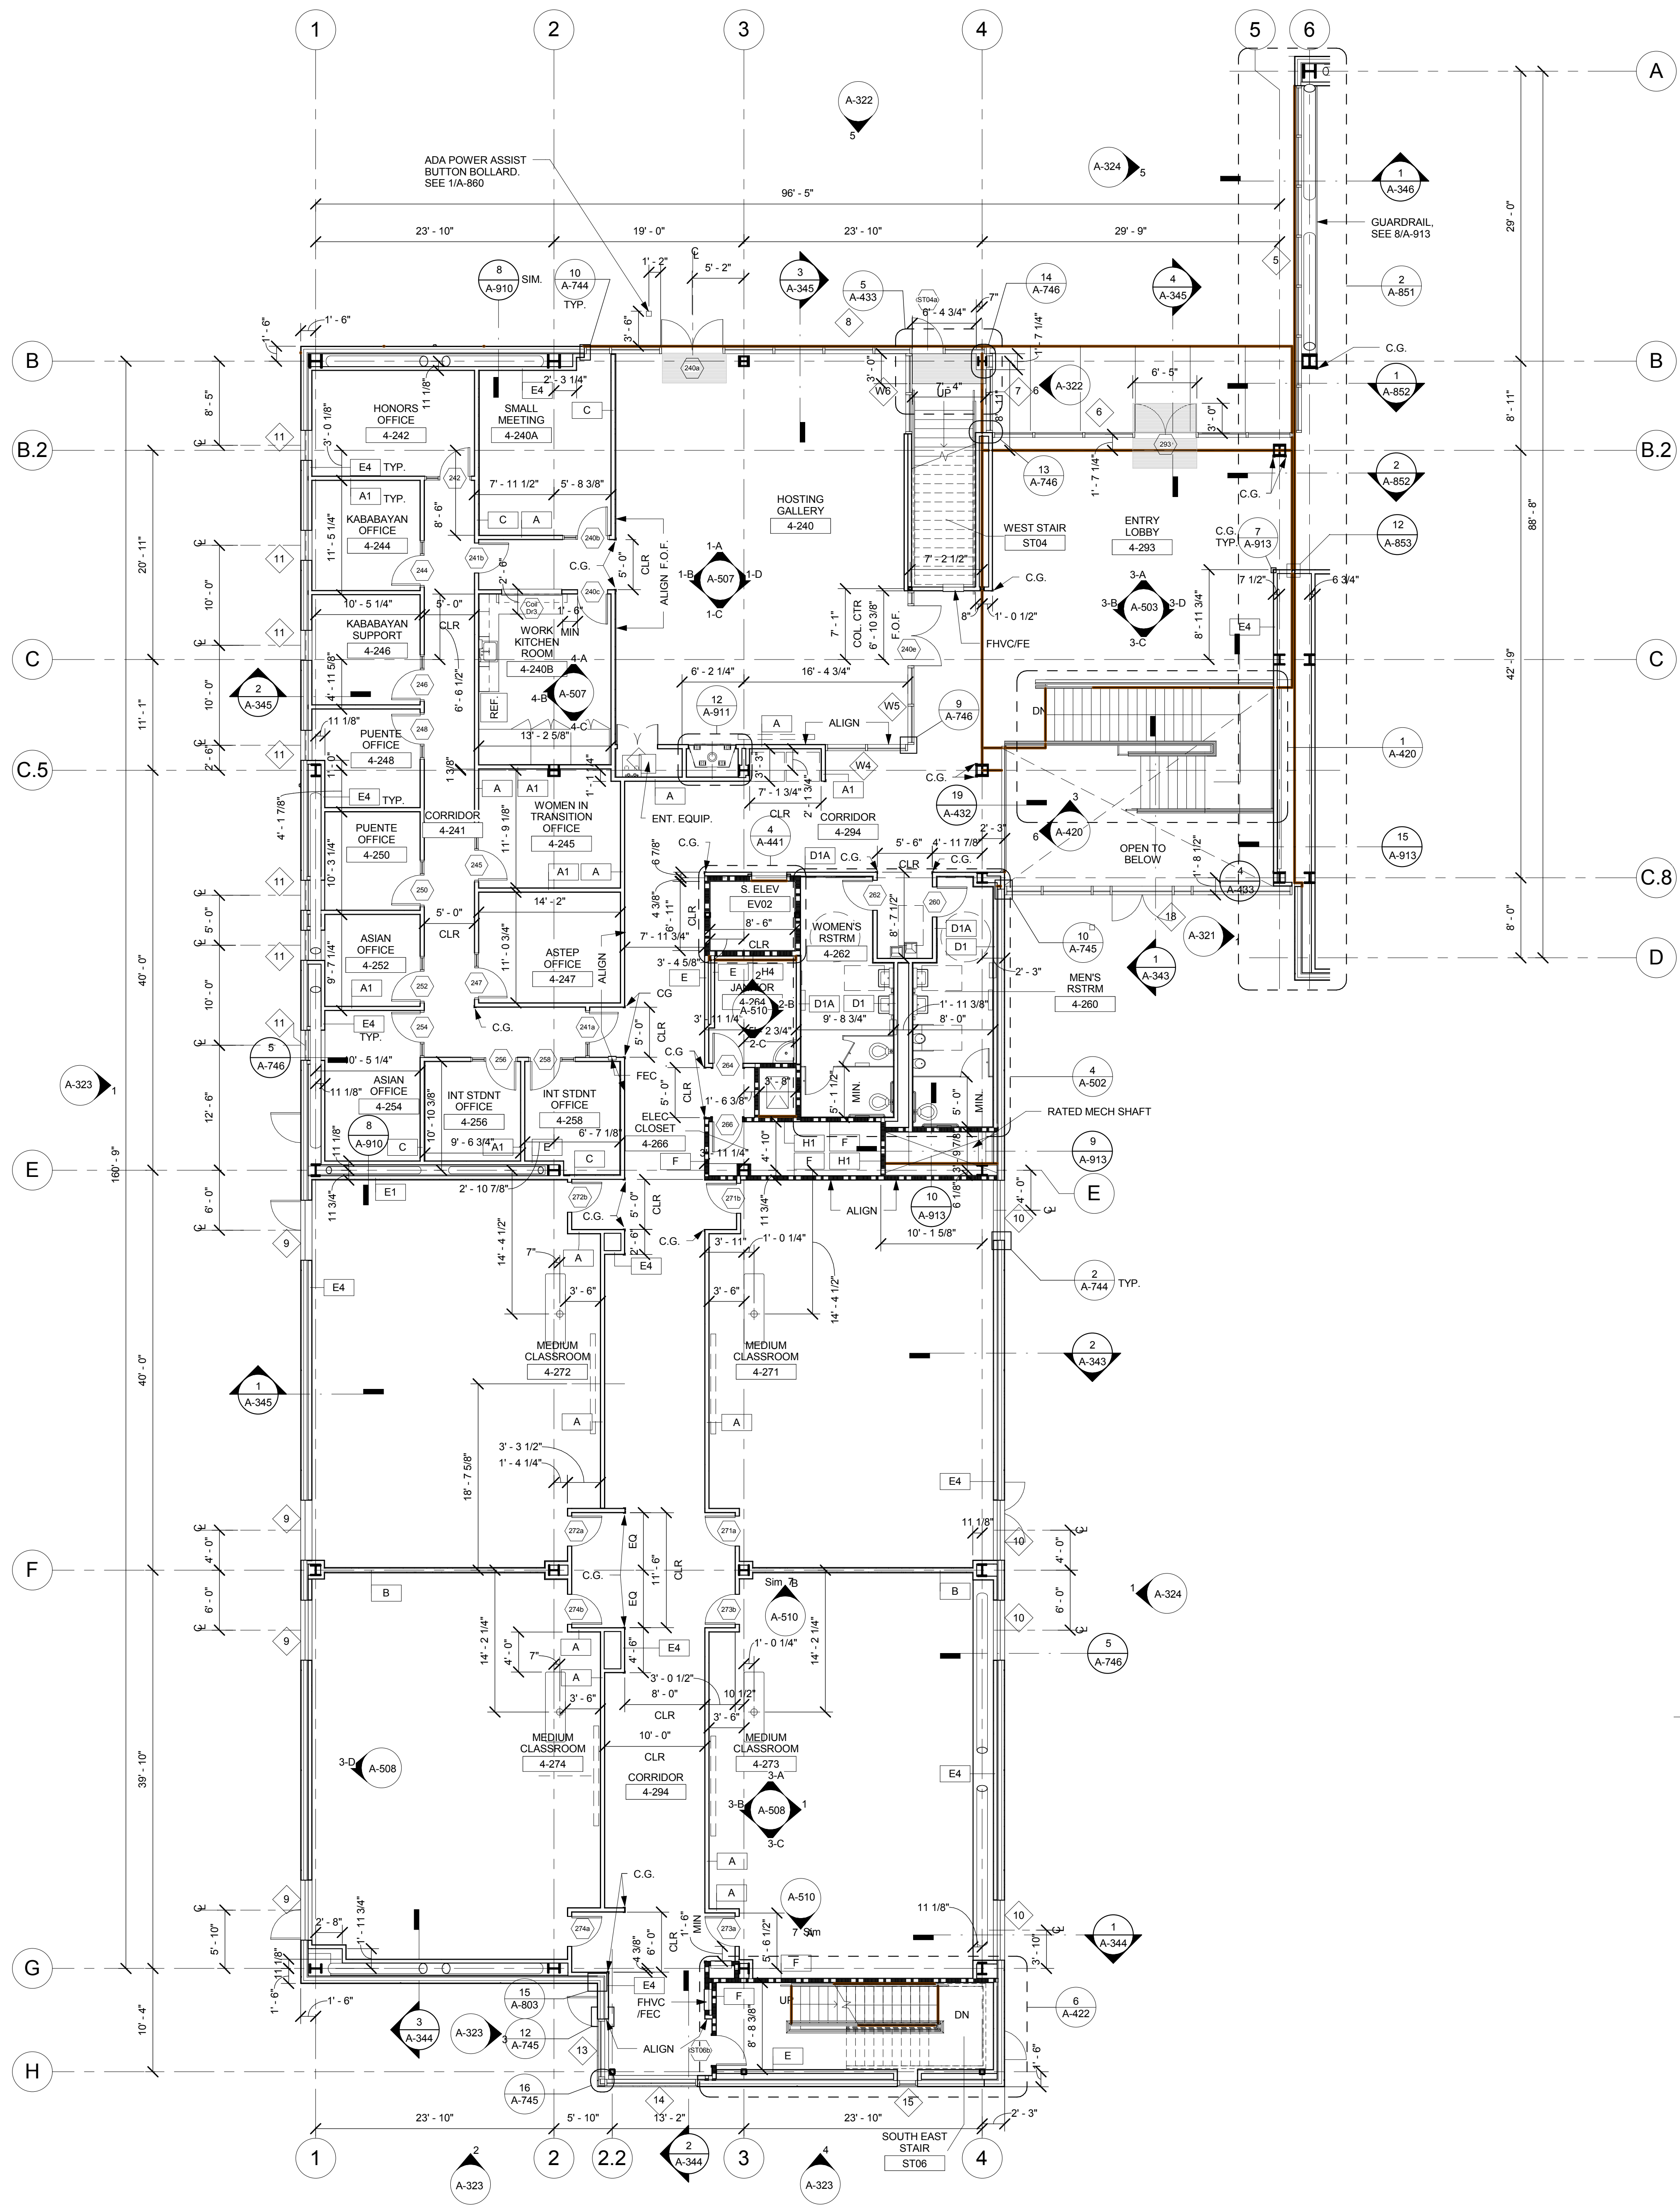

1 LEVEL 2 - ENLARGED FLOOR PLAN - SECTOR A
1/8" = 1'-0"

LEGEND

	CONCRETE WALL; S.S.D.
	METAL STUD WALL FOR INTERIOR PARTITION SCHEDULE, SEE A-902
	RATED PARTITION FOR INTERIOR PARTITION SCHEDULE, SEE A-902

- GENERAL NOTES**
- SEE INTERIOR ELEVATIONS FOR EXTENT OF SPECIAL WALL FINISHES.
 - SEE INTERIOR ELEVATIONS FOR ACCESSORIES AND EQUIPMENT LOCATIONS.
 - ALL ITEMS NEW UNLESS OTHERWISE NOTED.
 - ALL DIMENSIONS ARE TO FACE OF FINISH U.O.N.
 - SEE SHEET A-900 FOR ACCESSIBILITY STANDARDS.
 - LOCATE DOOR OPENING FROM ADJACENT PERPENDICULAR WALLS, AS SHOWN, U.O.N.
18" MIN. INT.
24" MIN. EXT.
 - SEE A SERIES FOR ACOUSTICAL WALL PANEL, WALL PROTECTION, AND CORNER GUARD LOCATIONS AND TYPES.
 - S.S.D. FOR EDGE OF SLAB LOCATION AND DIMENSIONS
 - FURNITURE SHOWN FOR REFERENCE ONLY
 - DIMENSIONS OF TIERS IN LARGE CLASSROOM 4-70 IS SIMILAR TO LARGE CLASSROOM 4-180.
 - FURNITURE LAYOUT IN LARGE CLASSROOMS 4-180 AND 4-148 IS SIMILAR TO LARGE CLASSROOM 4-170.