




1A WEST ELEVATION ALONG A (NORTH)
3/16" = 1'-0"

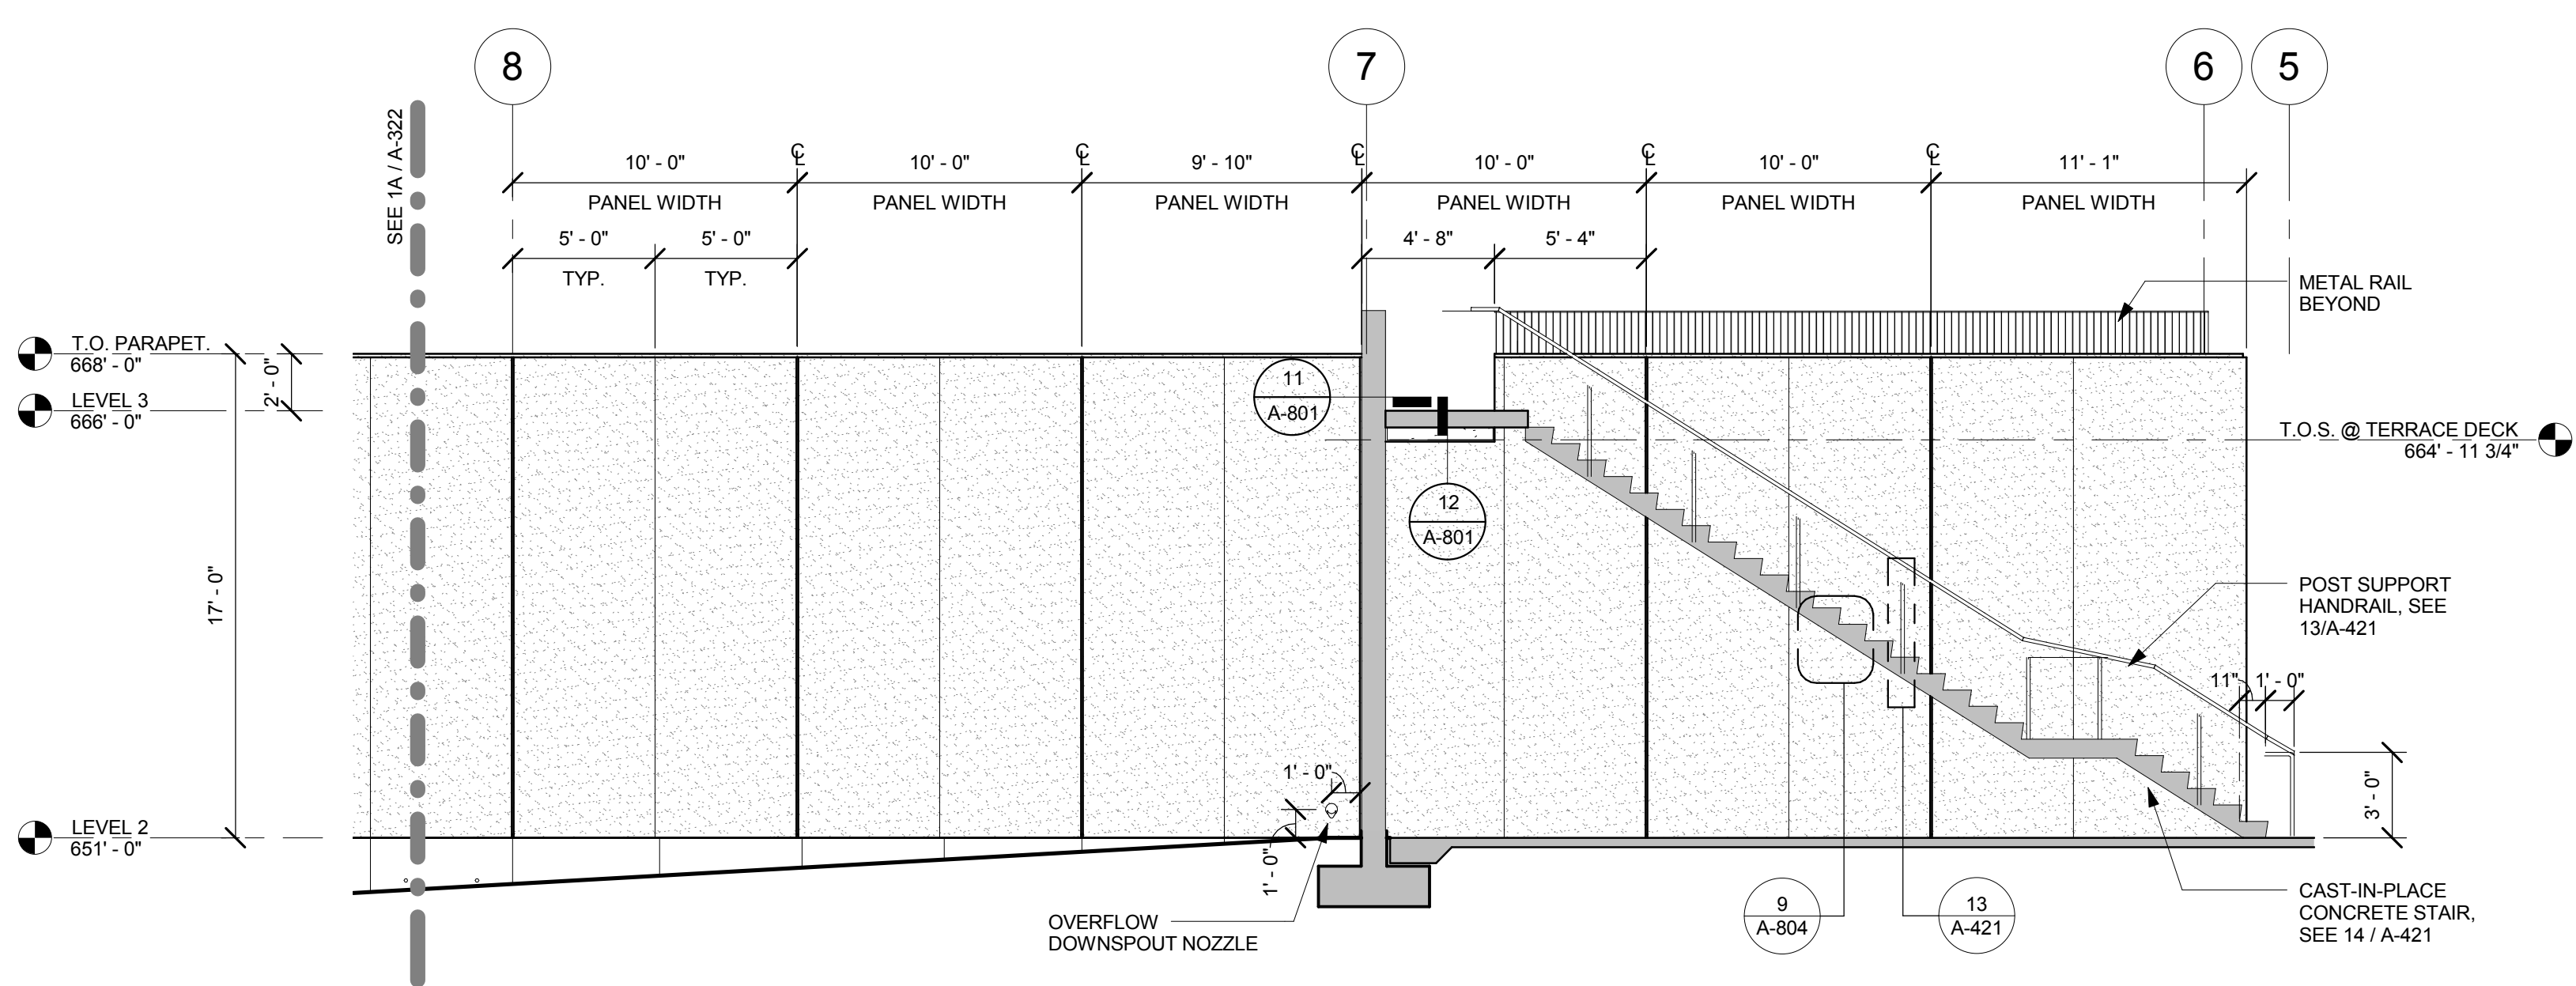


1B WEST ELEVATION ALONG A (SOUTH)
3/16" = 1'-0"

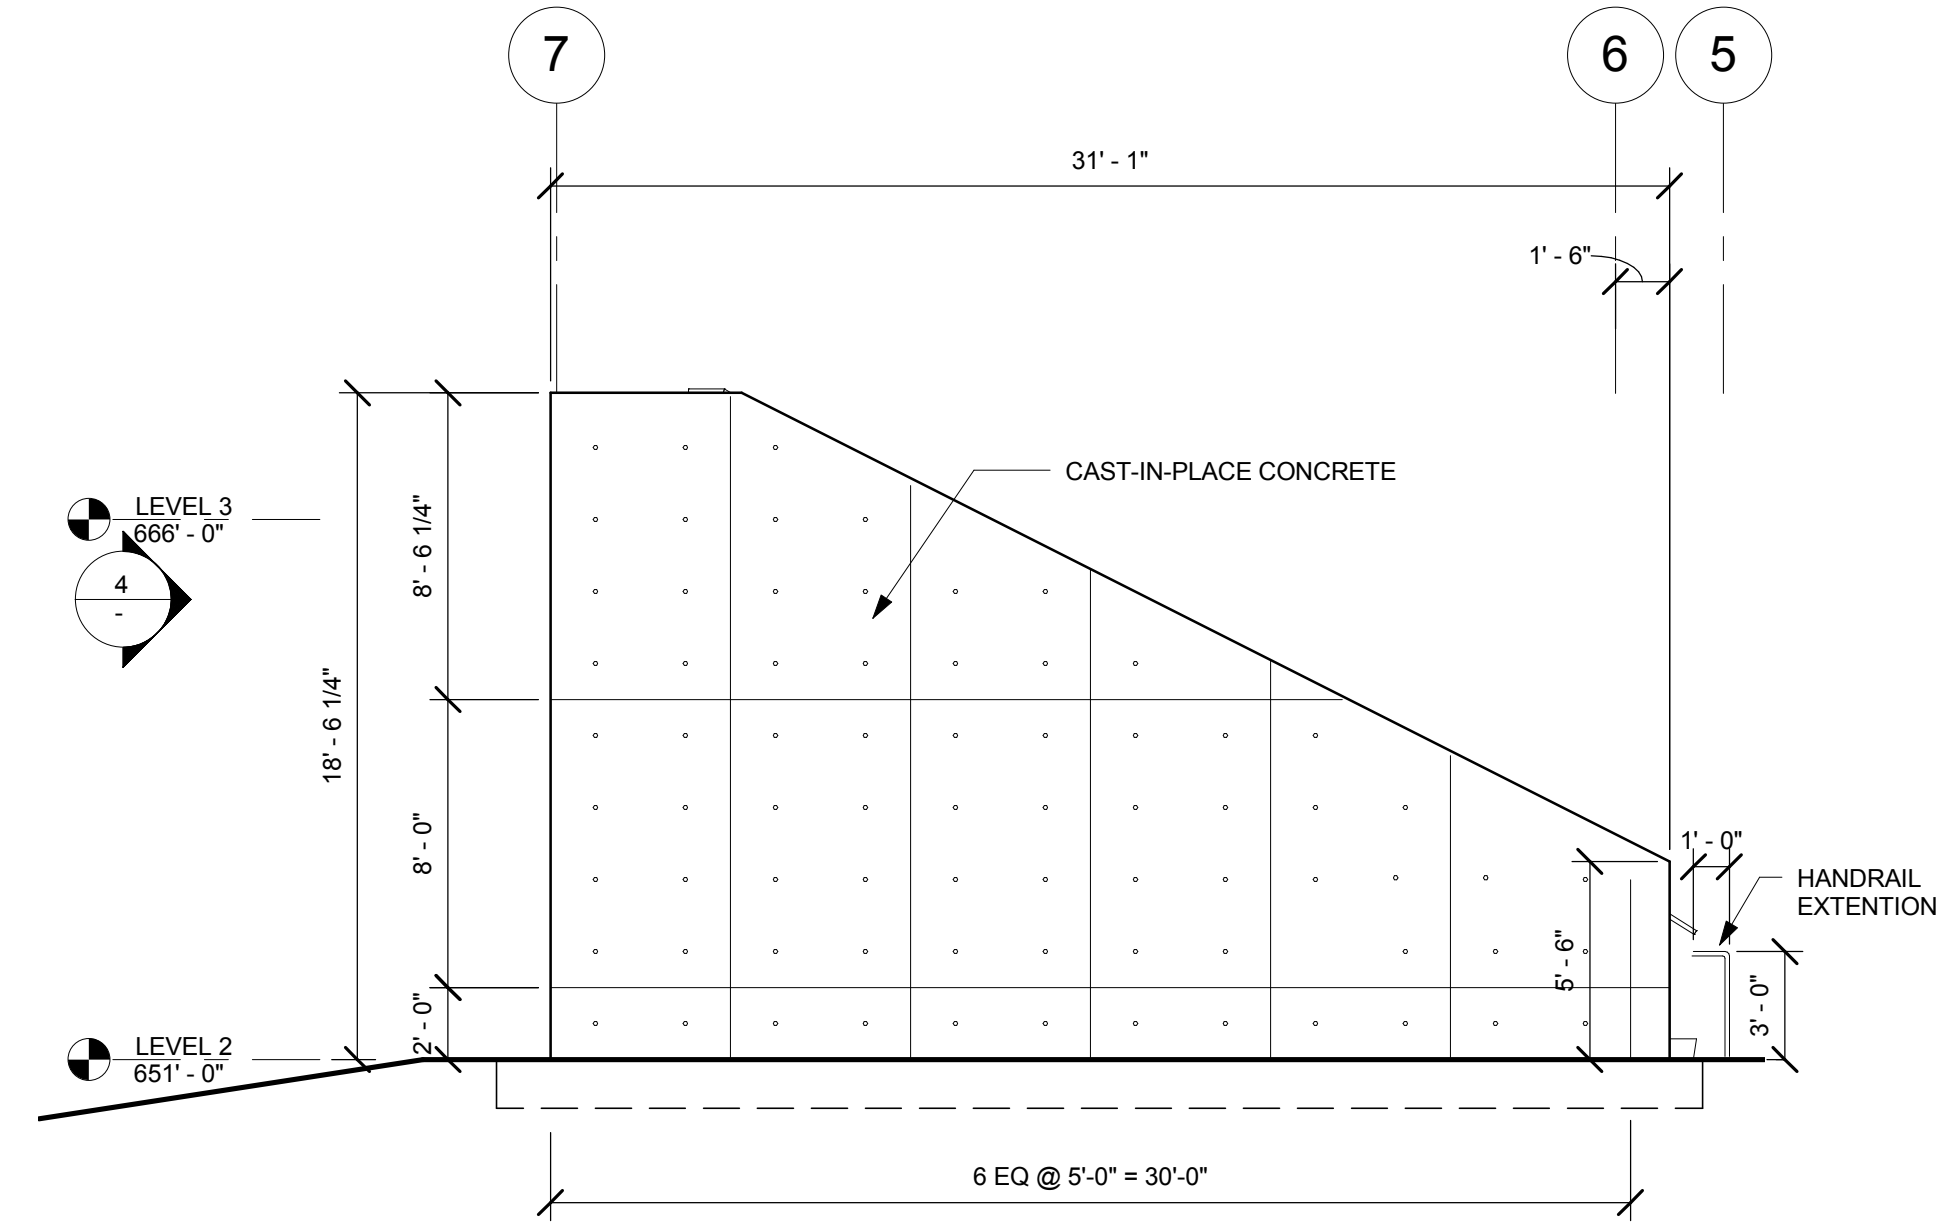


3 PARTIAL WEST ELEVATION ALONG A
3/16" = 1'-0"

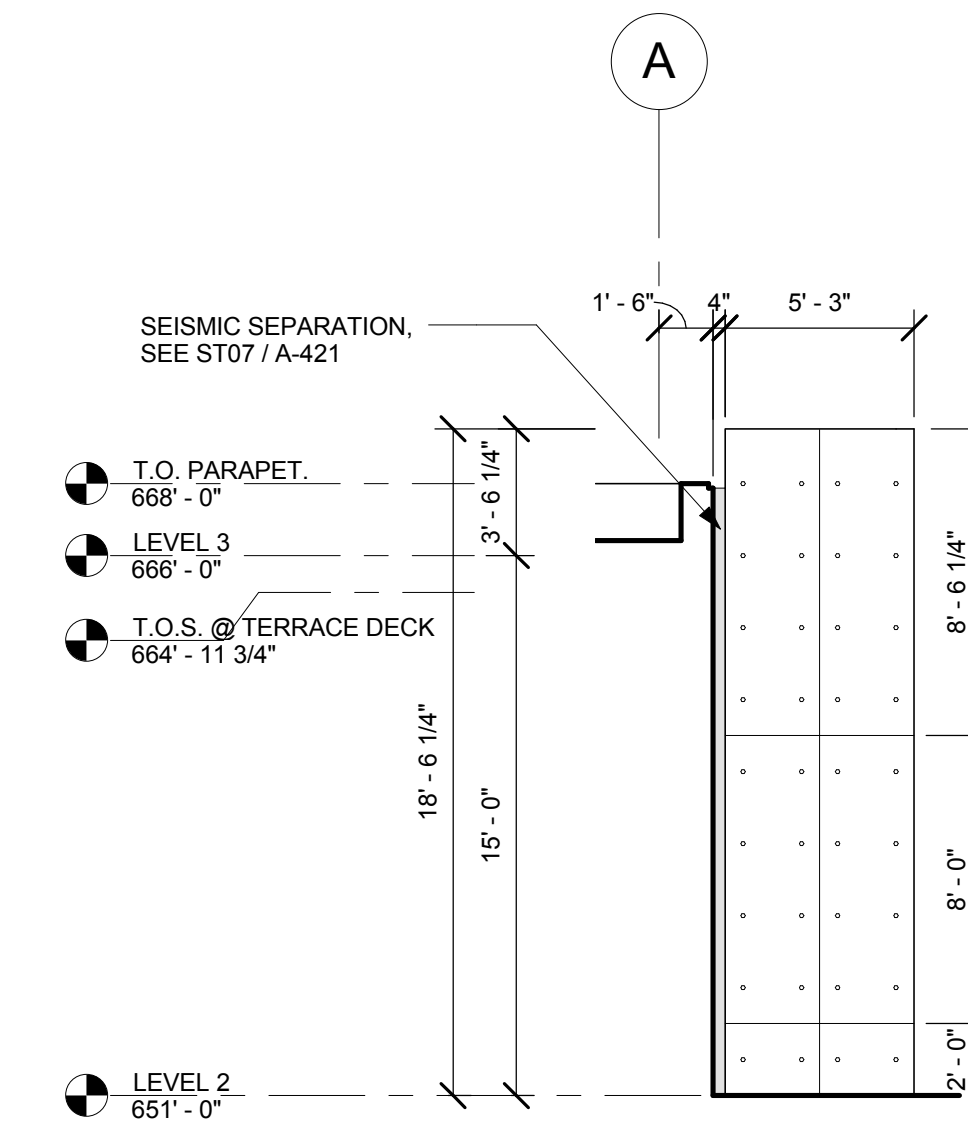

4 PARTIAL NORTH ELEVATION ALONG 7.4
3/16" = 1'-0"

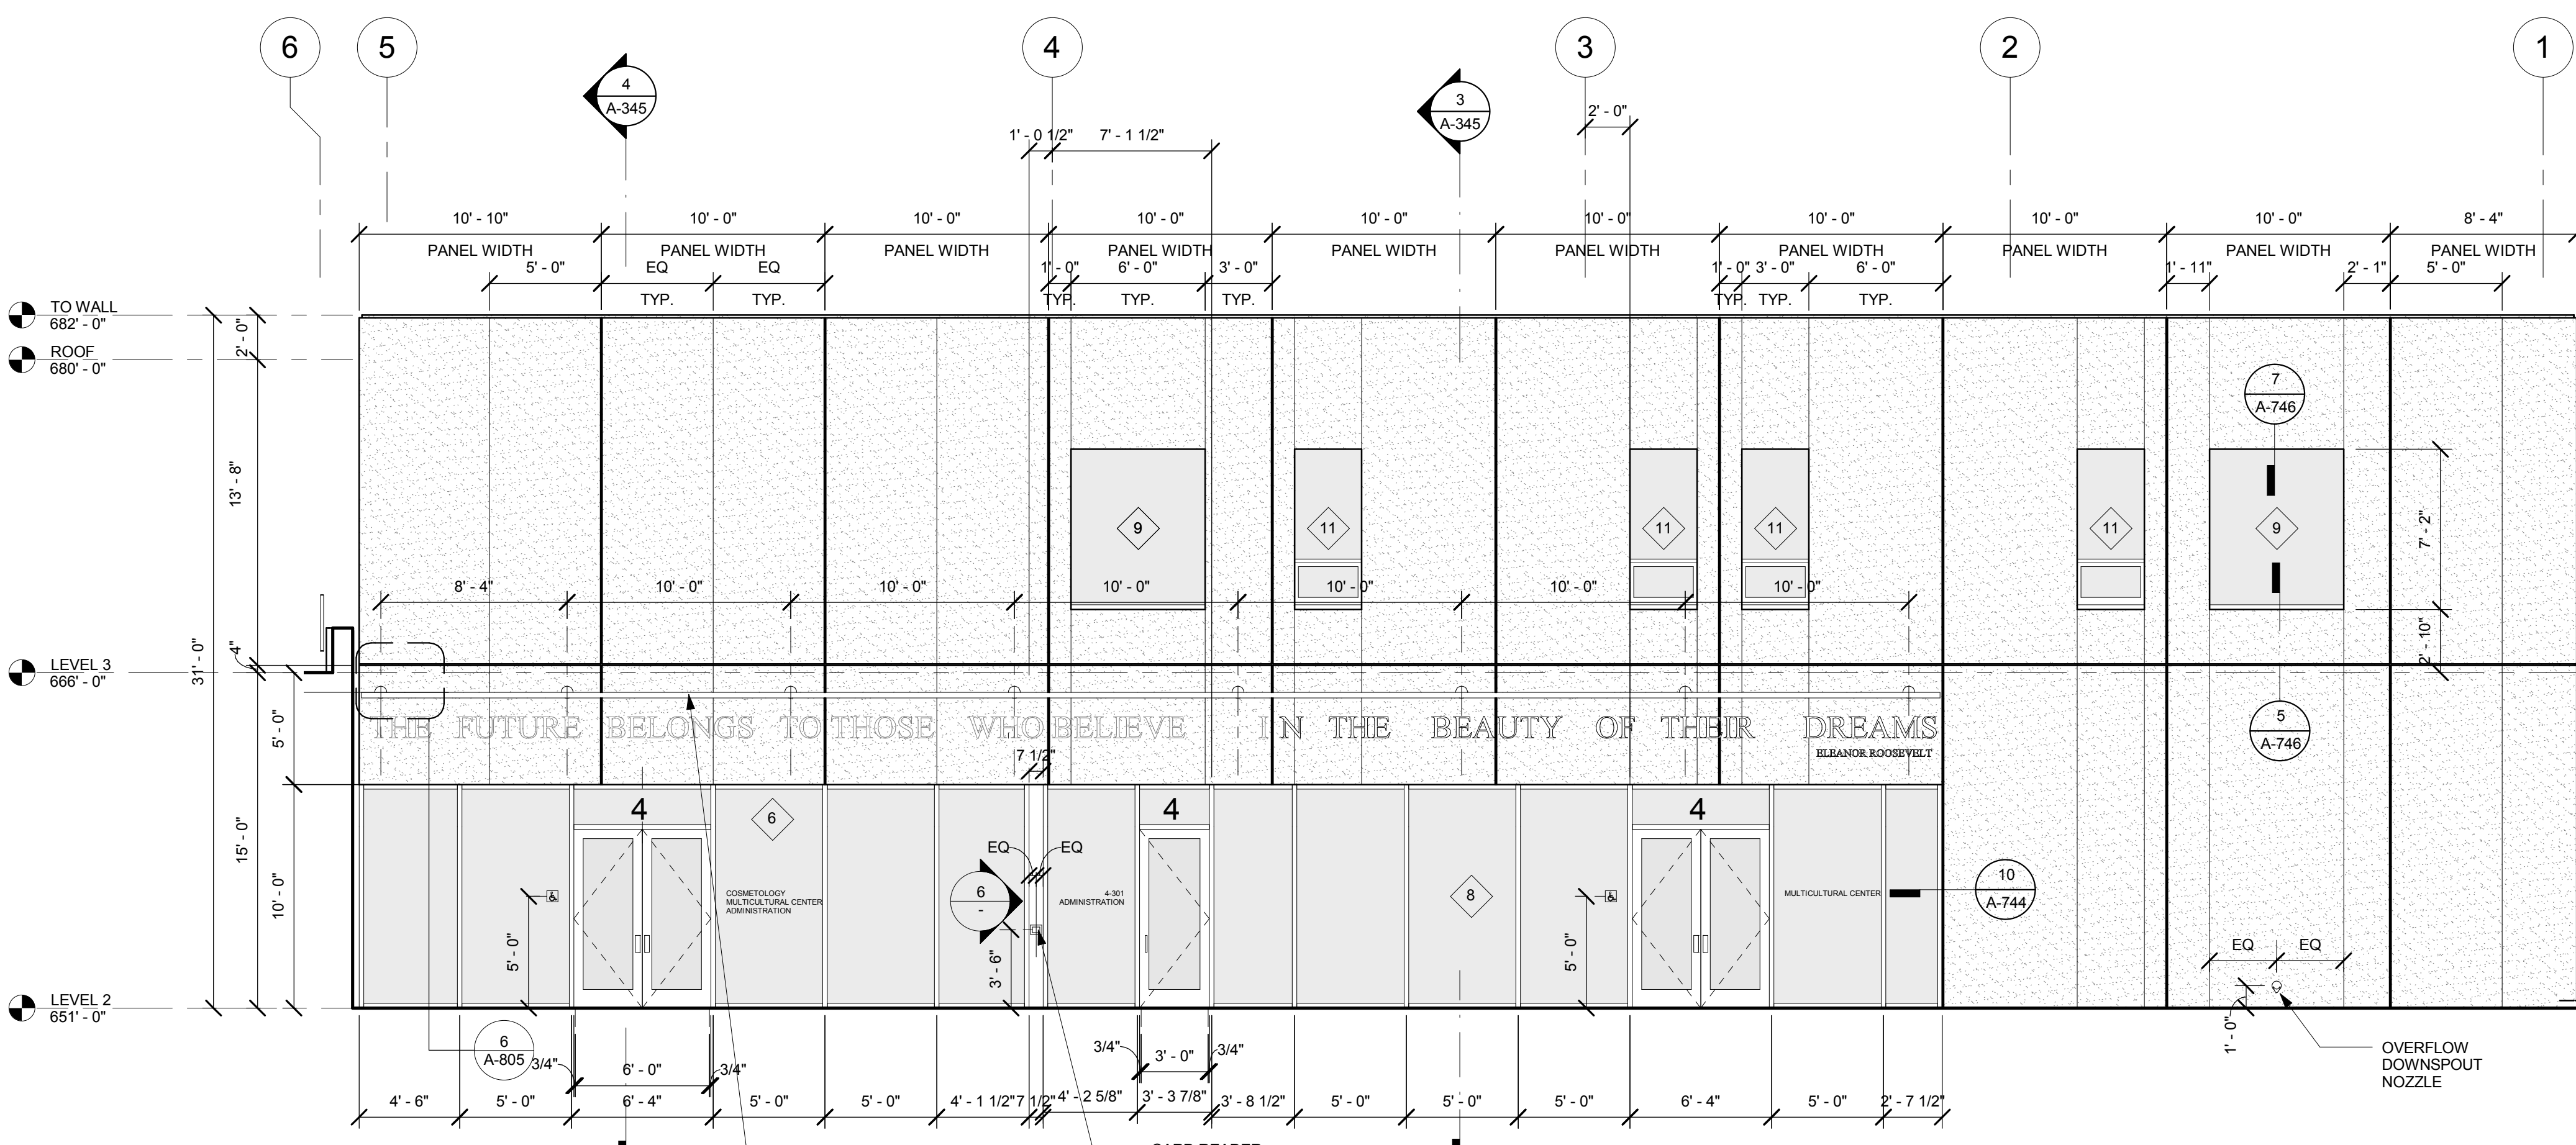

5 WEST ELEVATION ALONG B
3/16" = 1'-0"

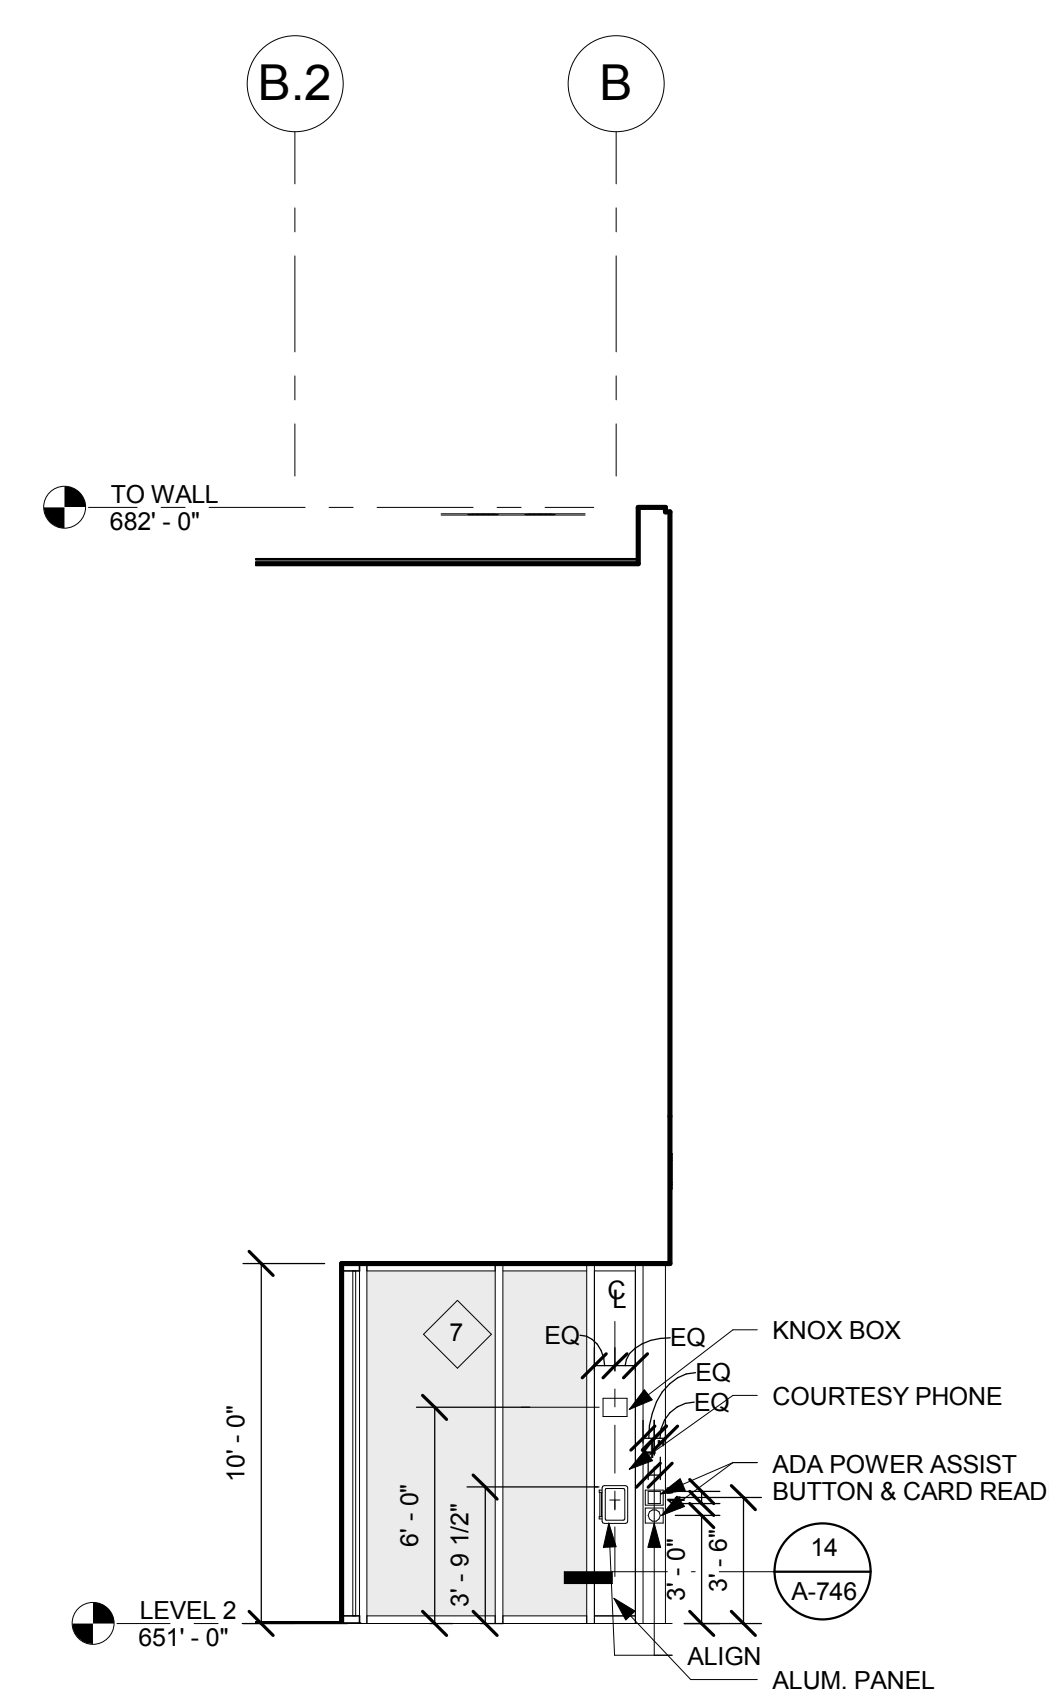

6 N ELEV ALONG 4
3/16" = 1'-0"

GENERAL NOTES:

1. SEE A-740 SERIES FOR WINDOW DETAILS

PROJECT RECORD SET

**BUILDING 4
SKYLINE COLLEGE**

SAN MATEO COUNTY
COMMUNITY COLLEGE
DISTRICT

**CIP2 DESIGN-BUILD
PROJECT
BUILDING 4**

PROJECT NO.: 07012.00 DRAWN BY: MC
DATE: 06/23/08 CHECKED BY: LG
SCALE: As indicated

**ENLARGED
ELEVATIONS**