




1 SOUTH ELEVATION ALONG 1  
3/16" = 1'-0"

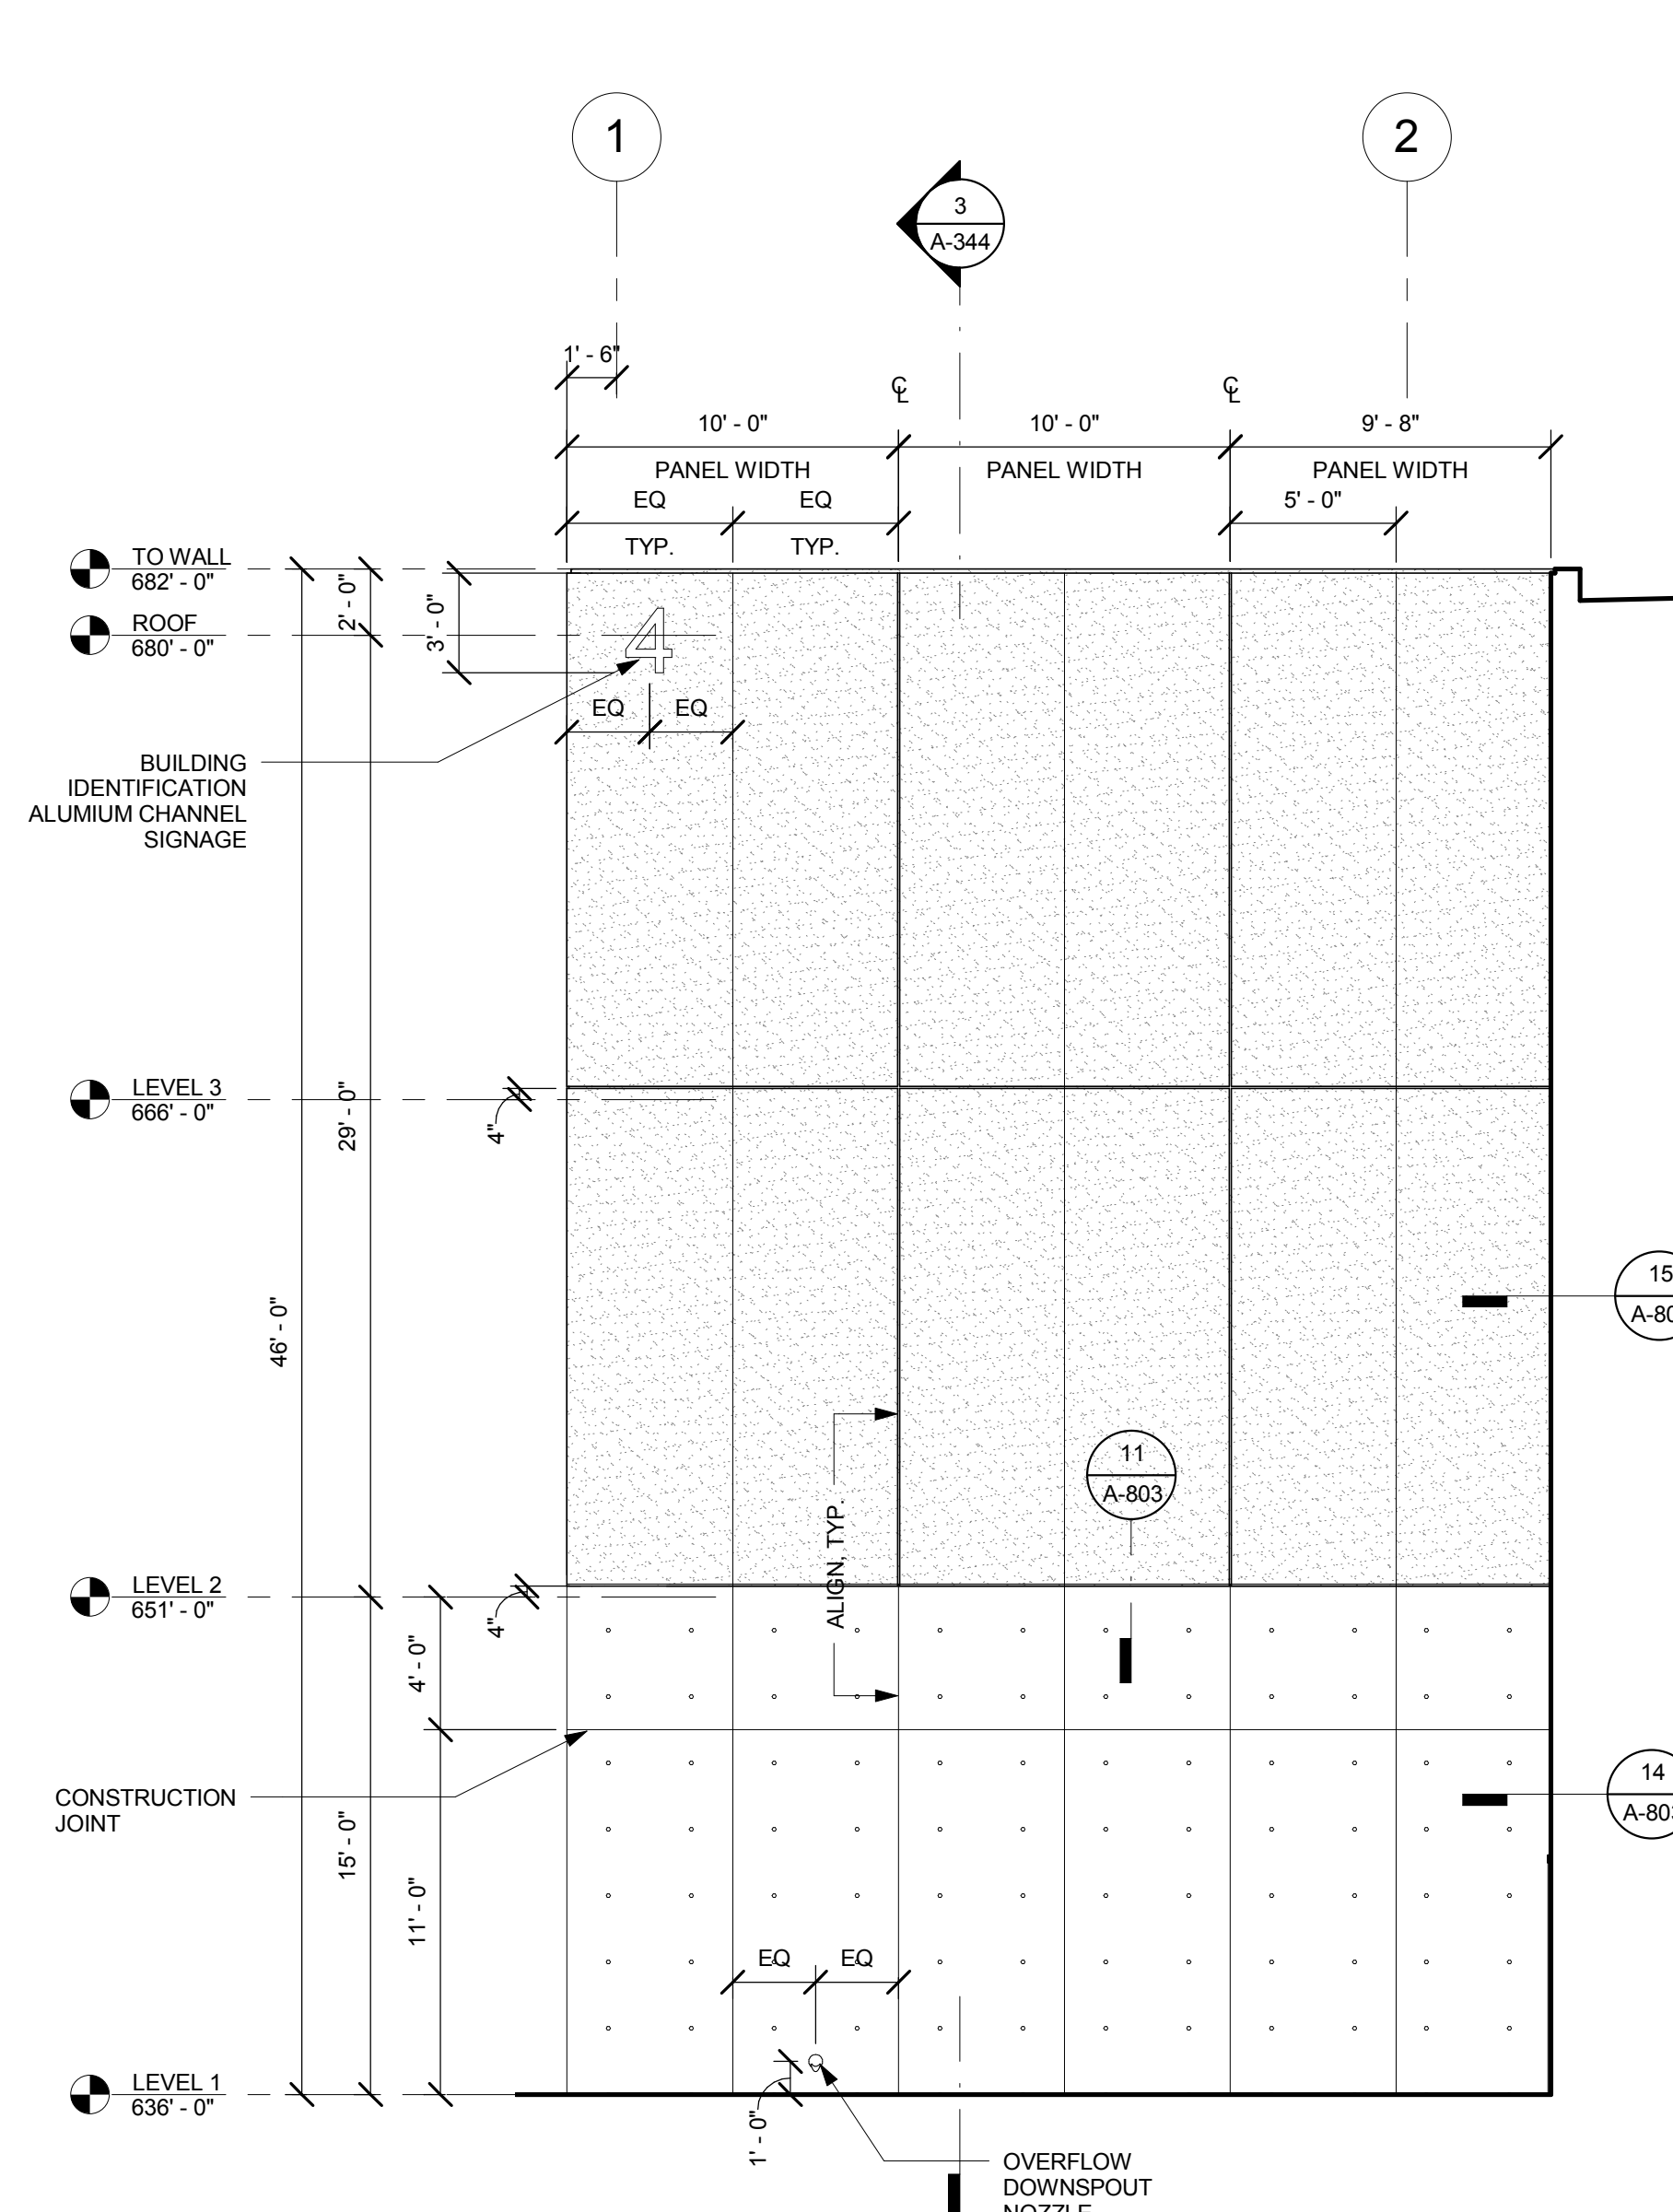

2 EAST ELEVATION ALONG G  
3/16" = 1'-0"

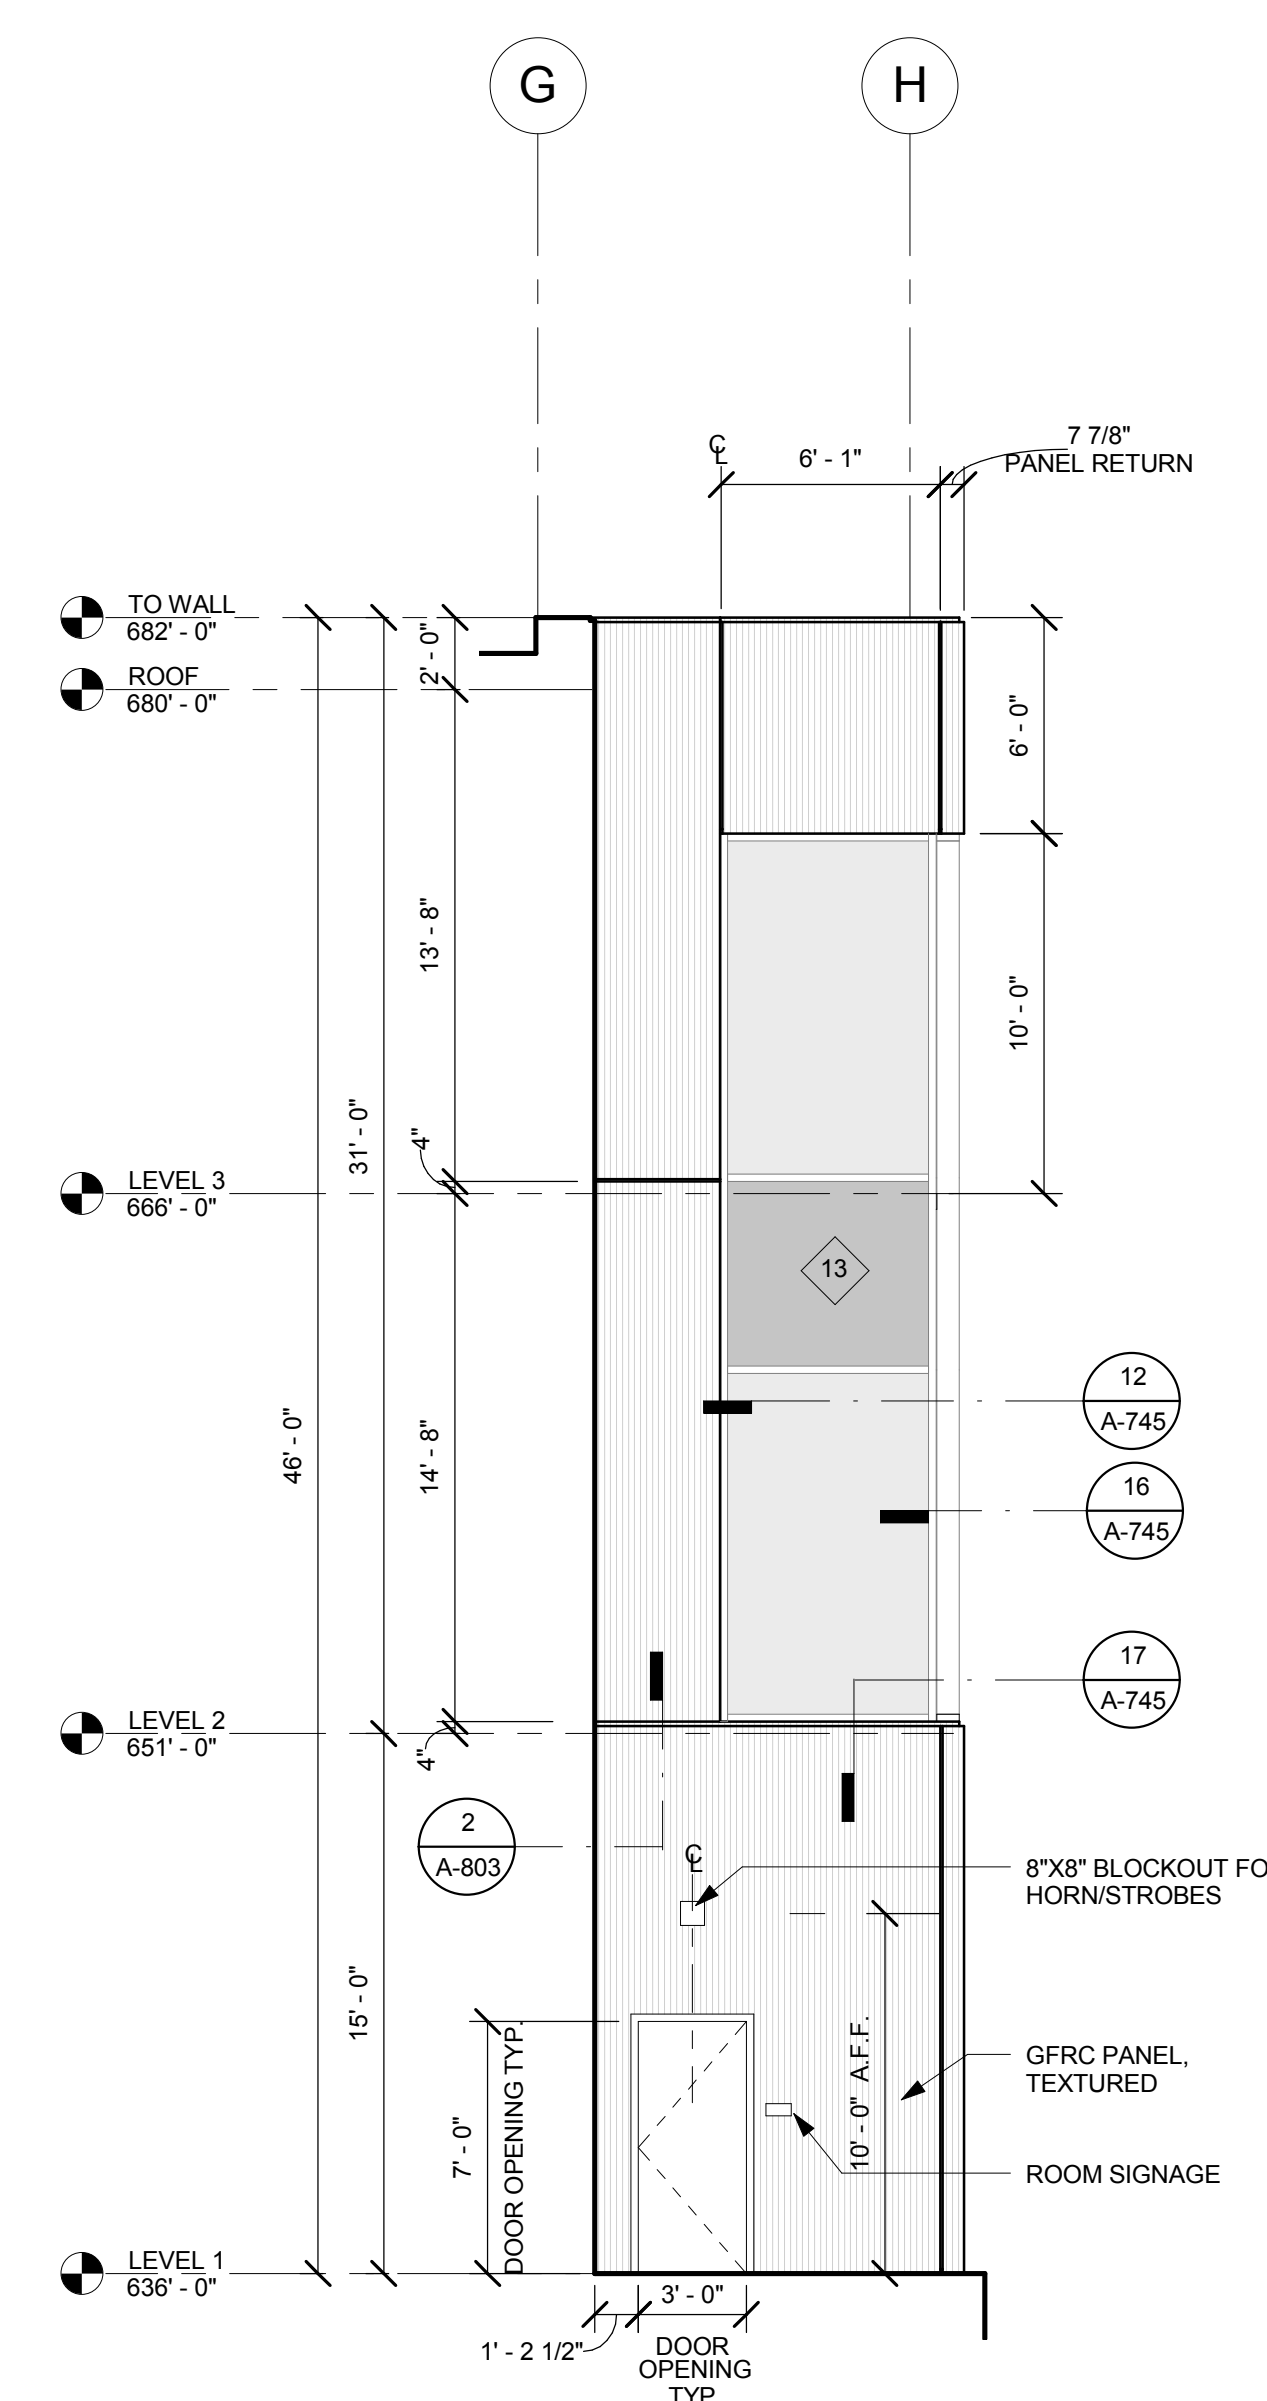

3 PARTIAL SOUTH ELEVATION ALONG 2  
3/16" = 1'-0"

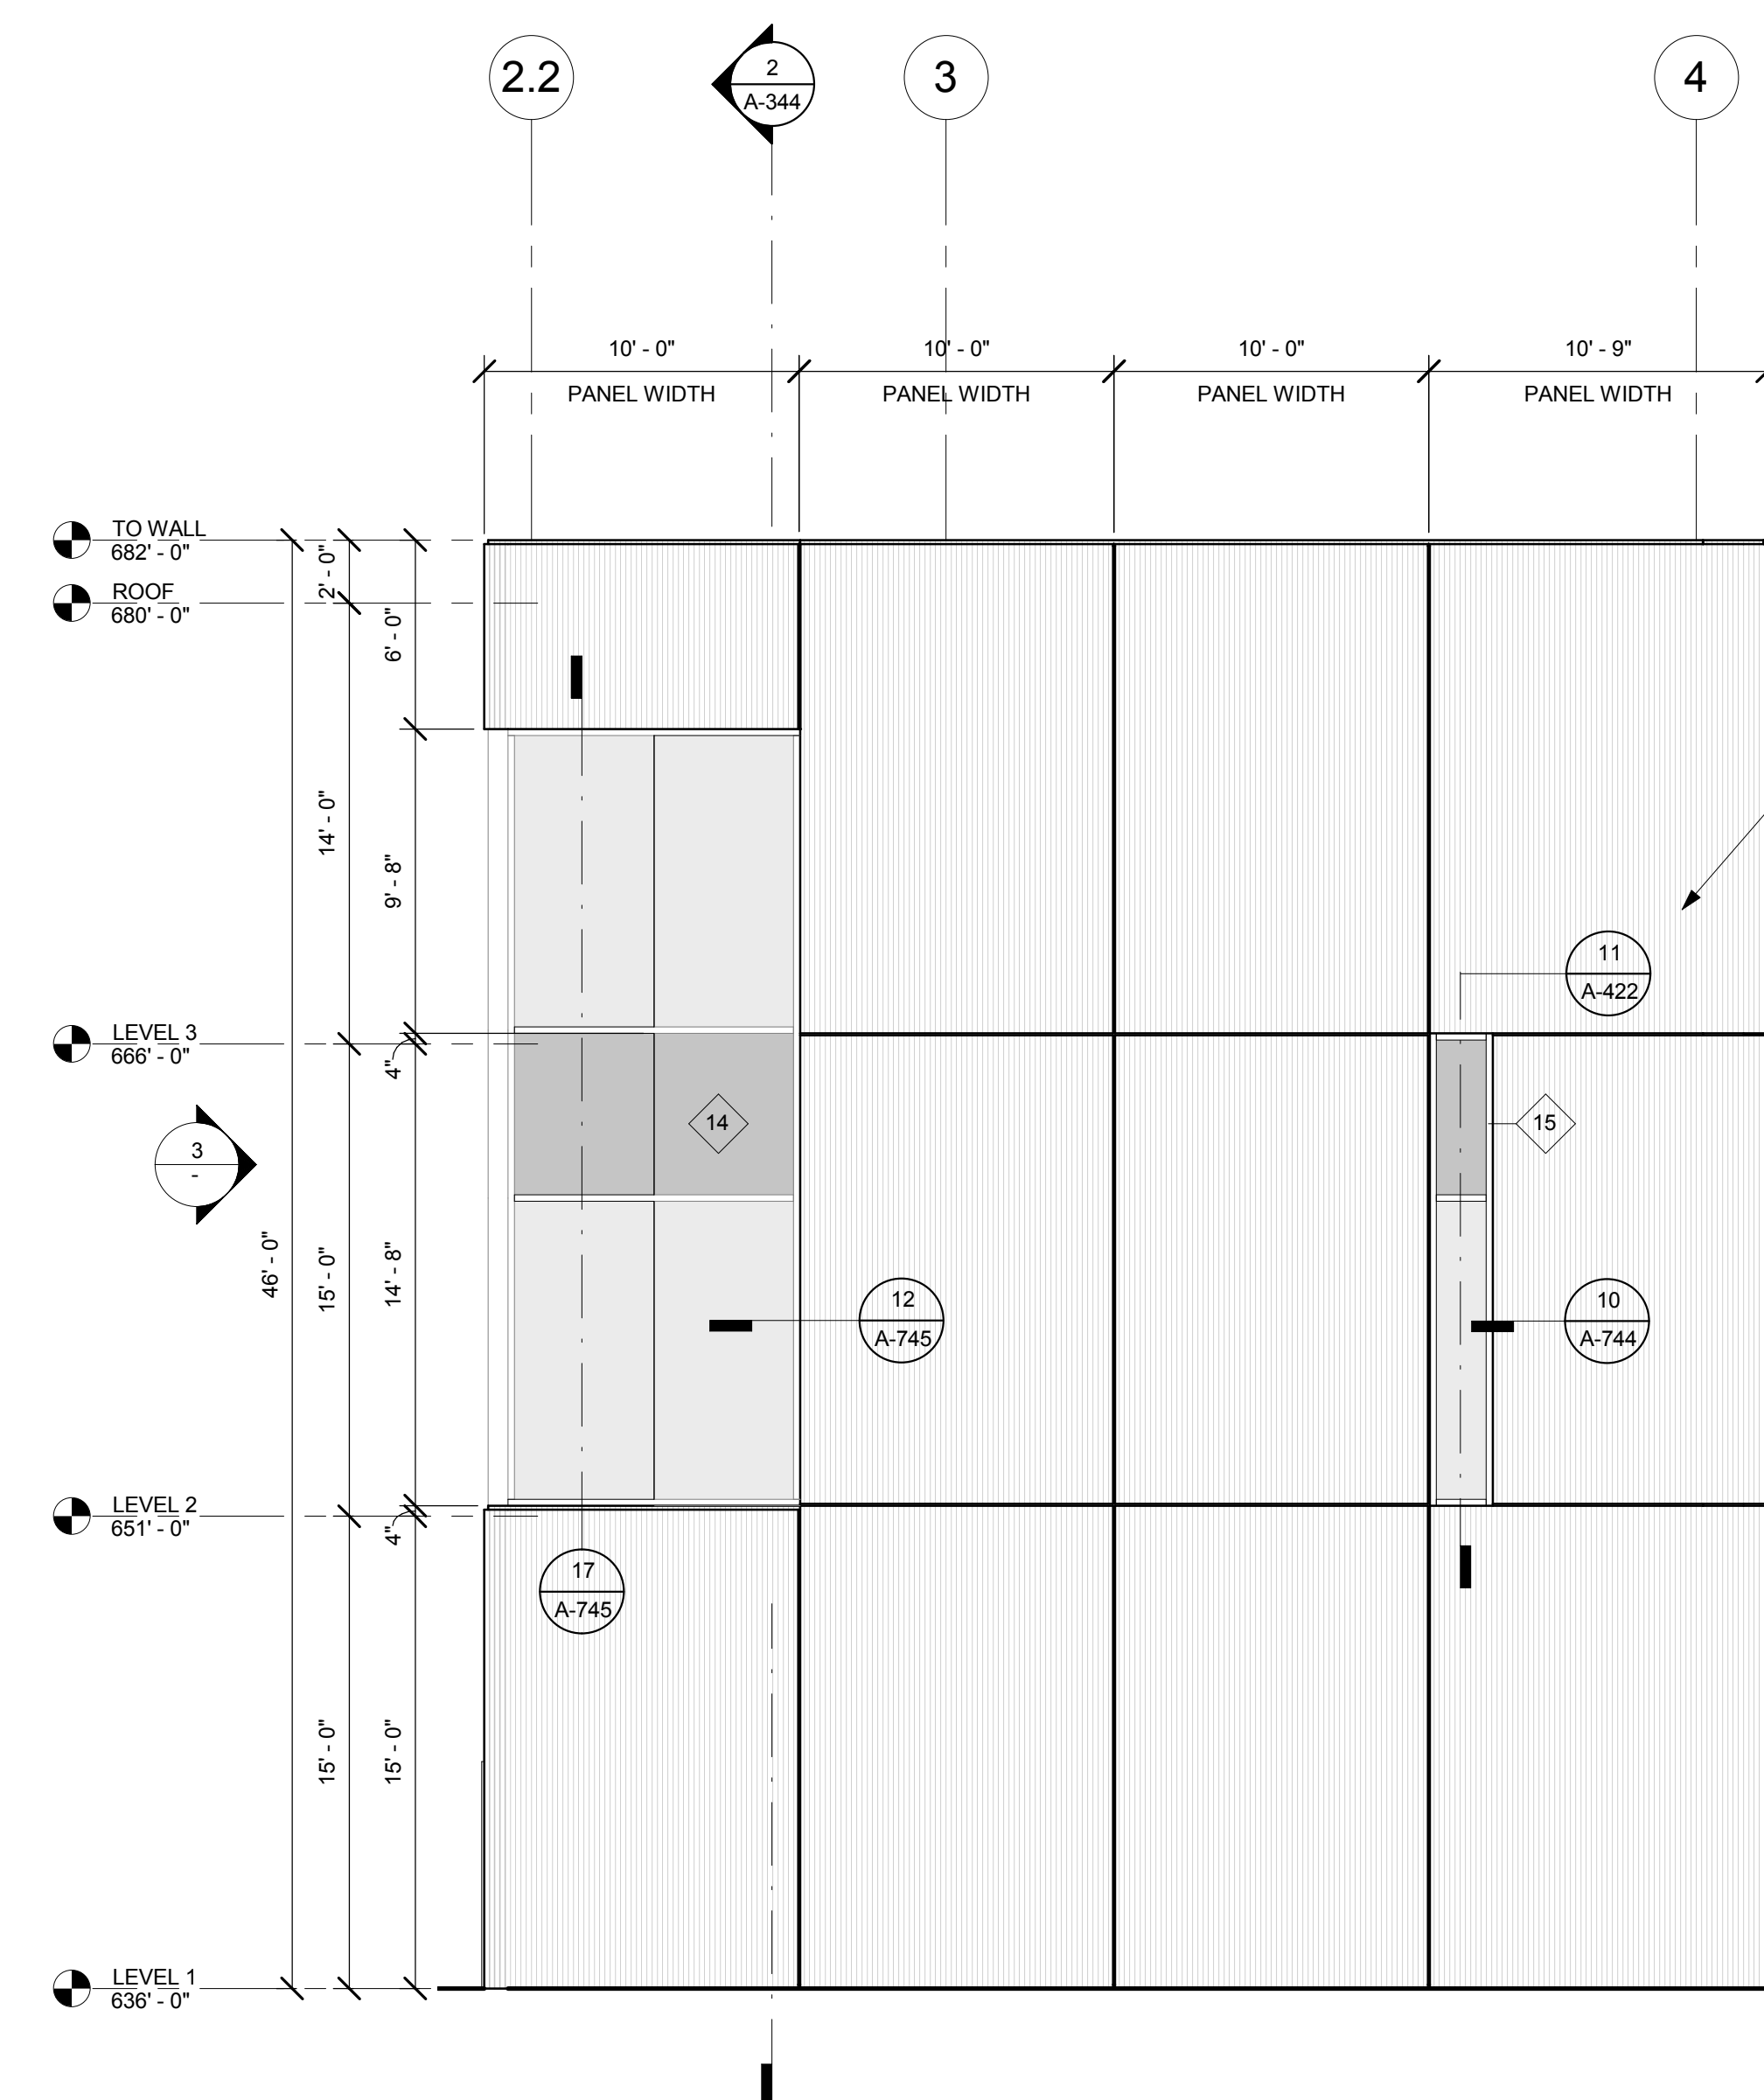

4 EAST ELEVATION ALONG H  
3/16" = 1'-0"

GENERAL NOTES:

1. SEE A-740 SERIES FOR WINDOW DETAILS

NO.	ISSUES/REVISIONS	DATE

PROJECT RECORD SET

BUILDING 4  
SKYLINE COLLEGE

SAN MATEO COUNTY  
COMMUNITY COLLEGE  
DISTRICT

CIP2 DESIGN-BUILD  
PROJECT  
BUILDING 4

PROJECT NO.: 07012.00 DRAWN BY: MC  
DATE: 06/23/08 CHECKED BY: LG  
SCALE: As indicated

SHEET TITLE:  
ENLARGED  
ELEVATIONS