




**1 NORTH ELEVATION ALONG 4**  
3/16" = 1'-0"

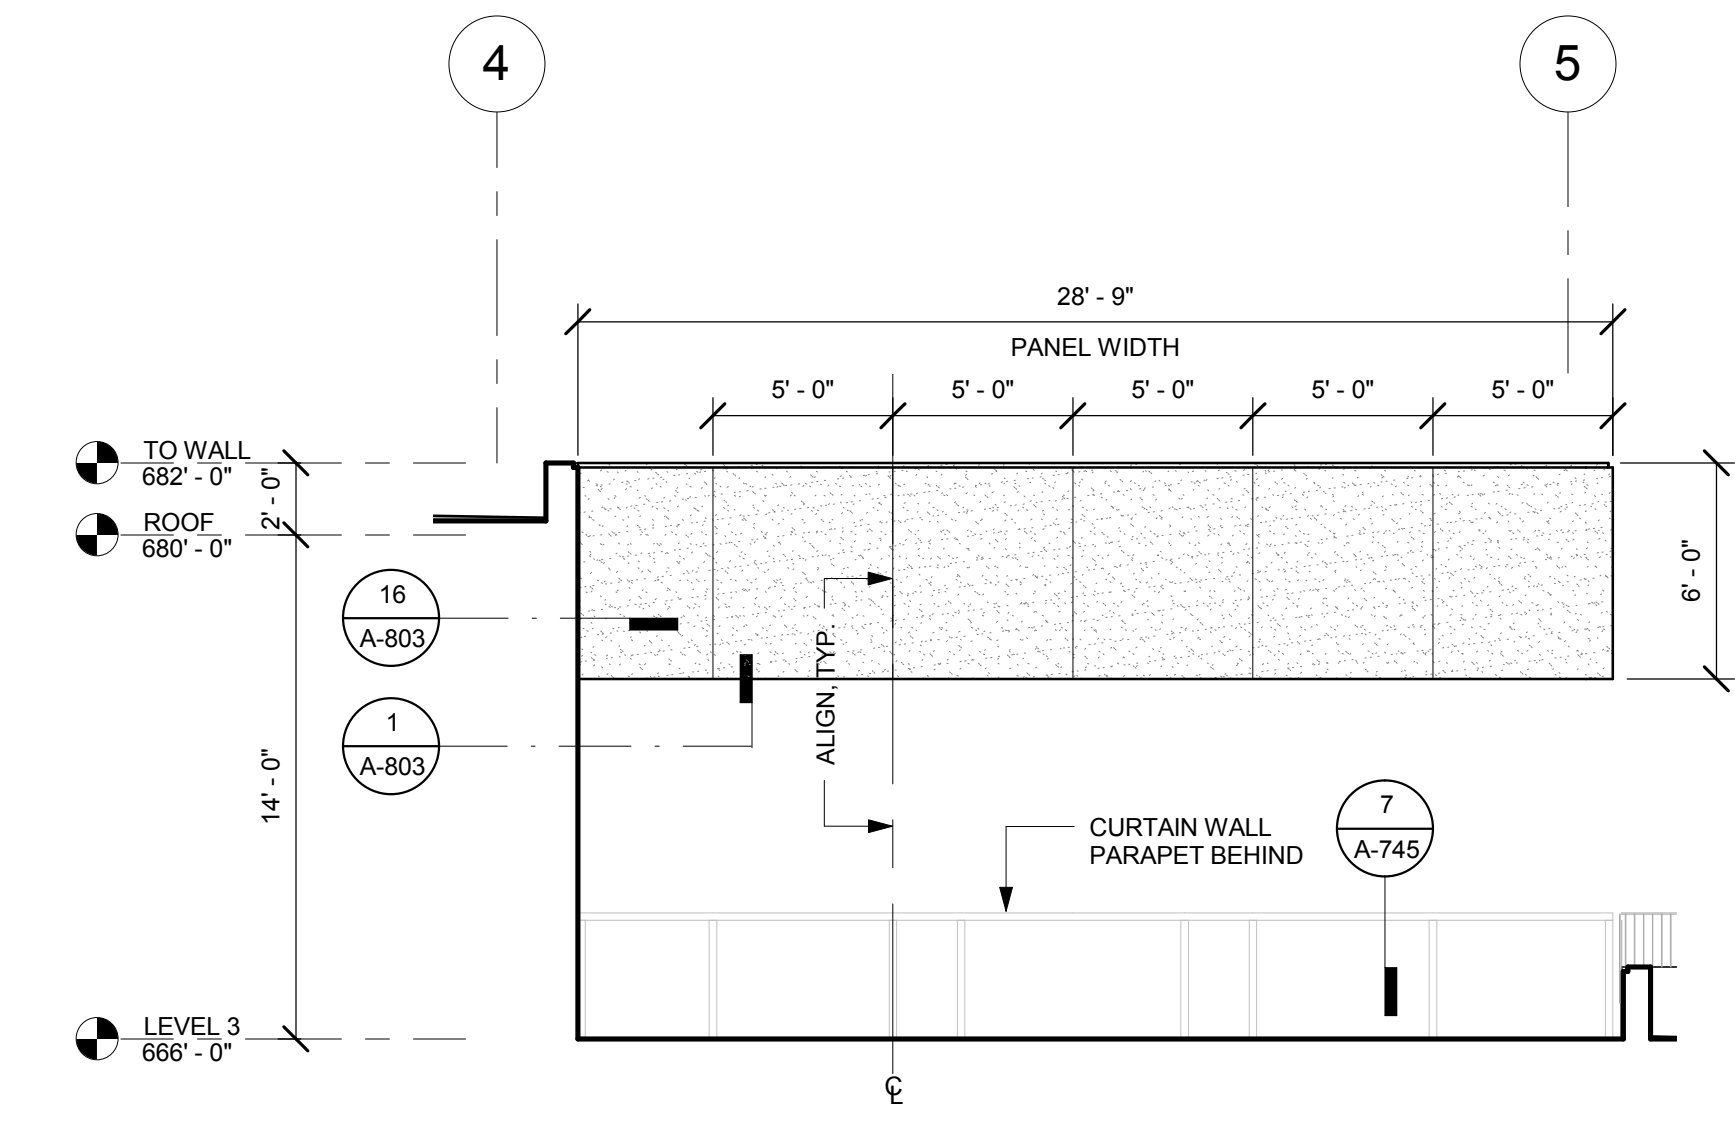


**2 PARTIAL EAST ELEVATION ALONG C.8**  
3/16" = 1'-0"

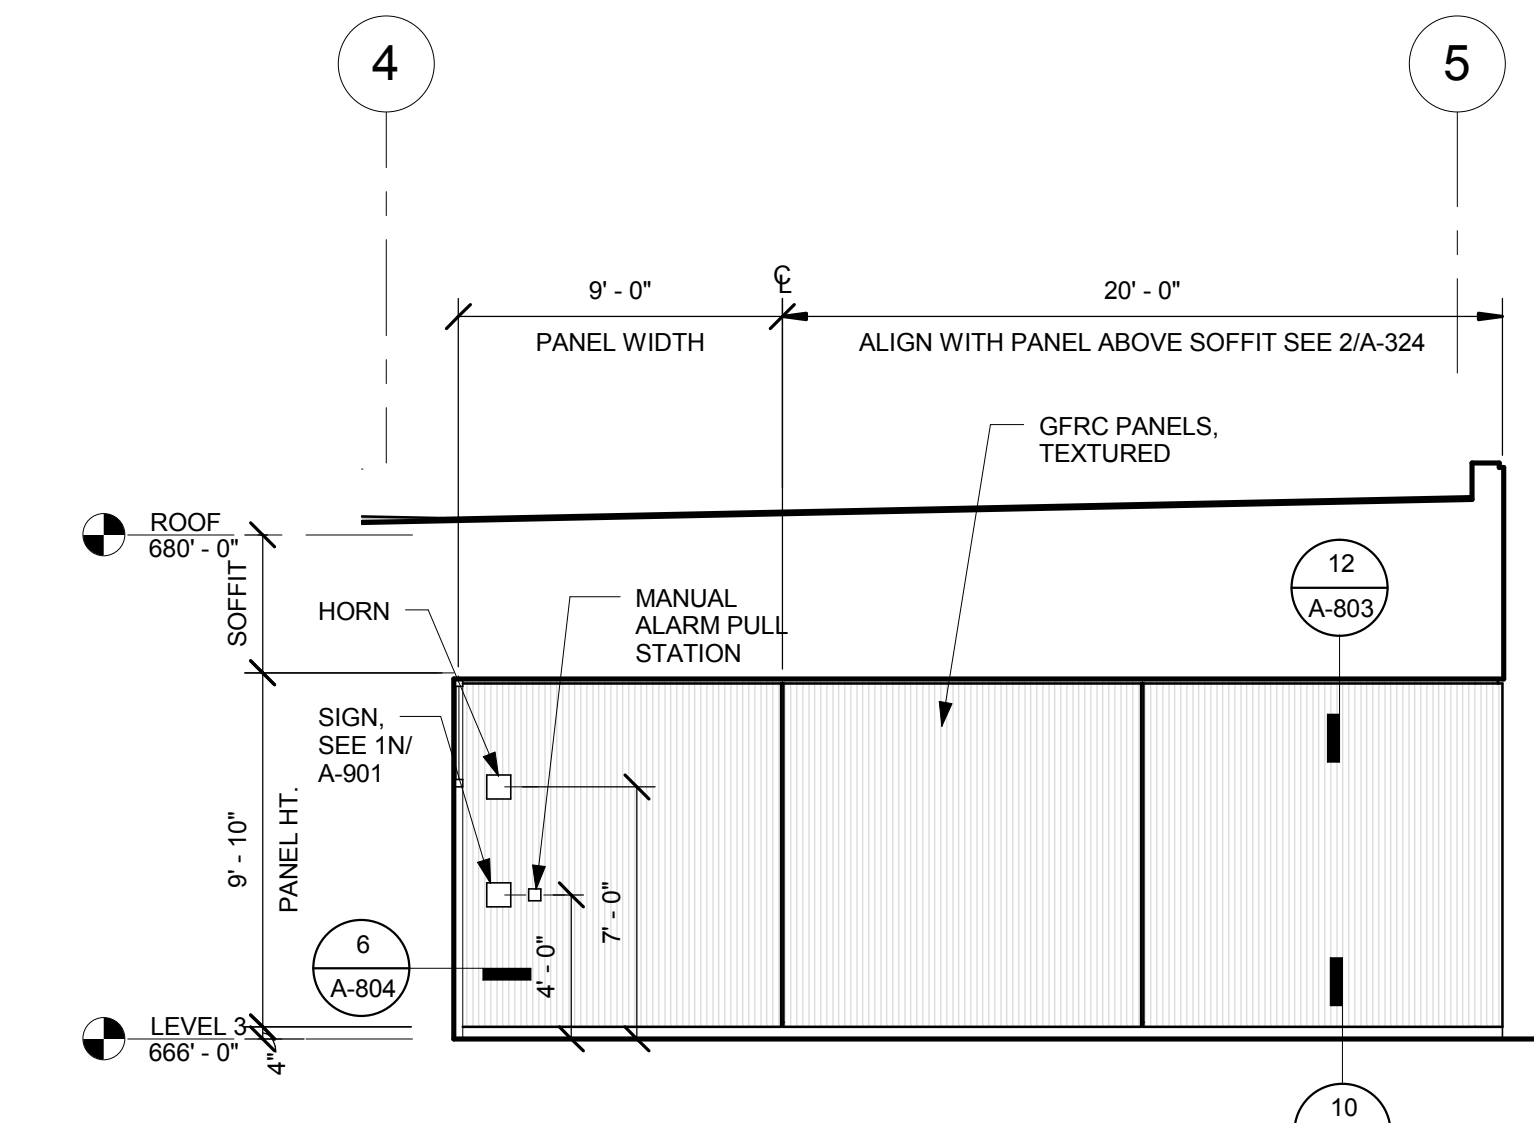

**3 PARTIAL EAST ELEVATION ALONG C.5**  
3/16" = 1'-0"

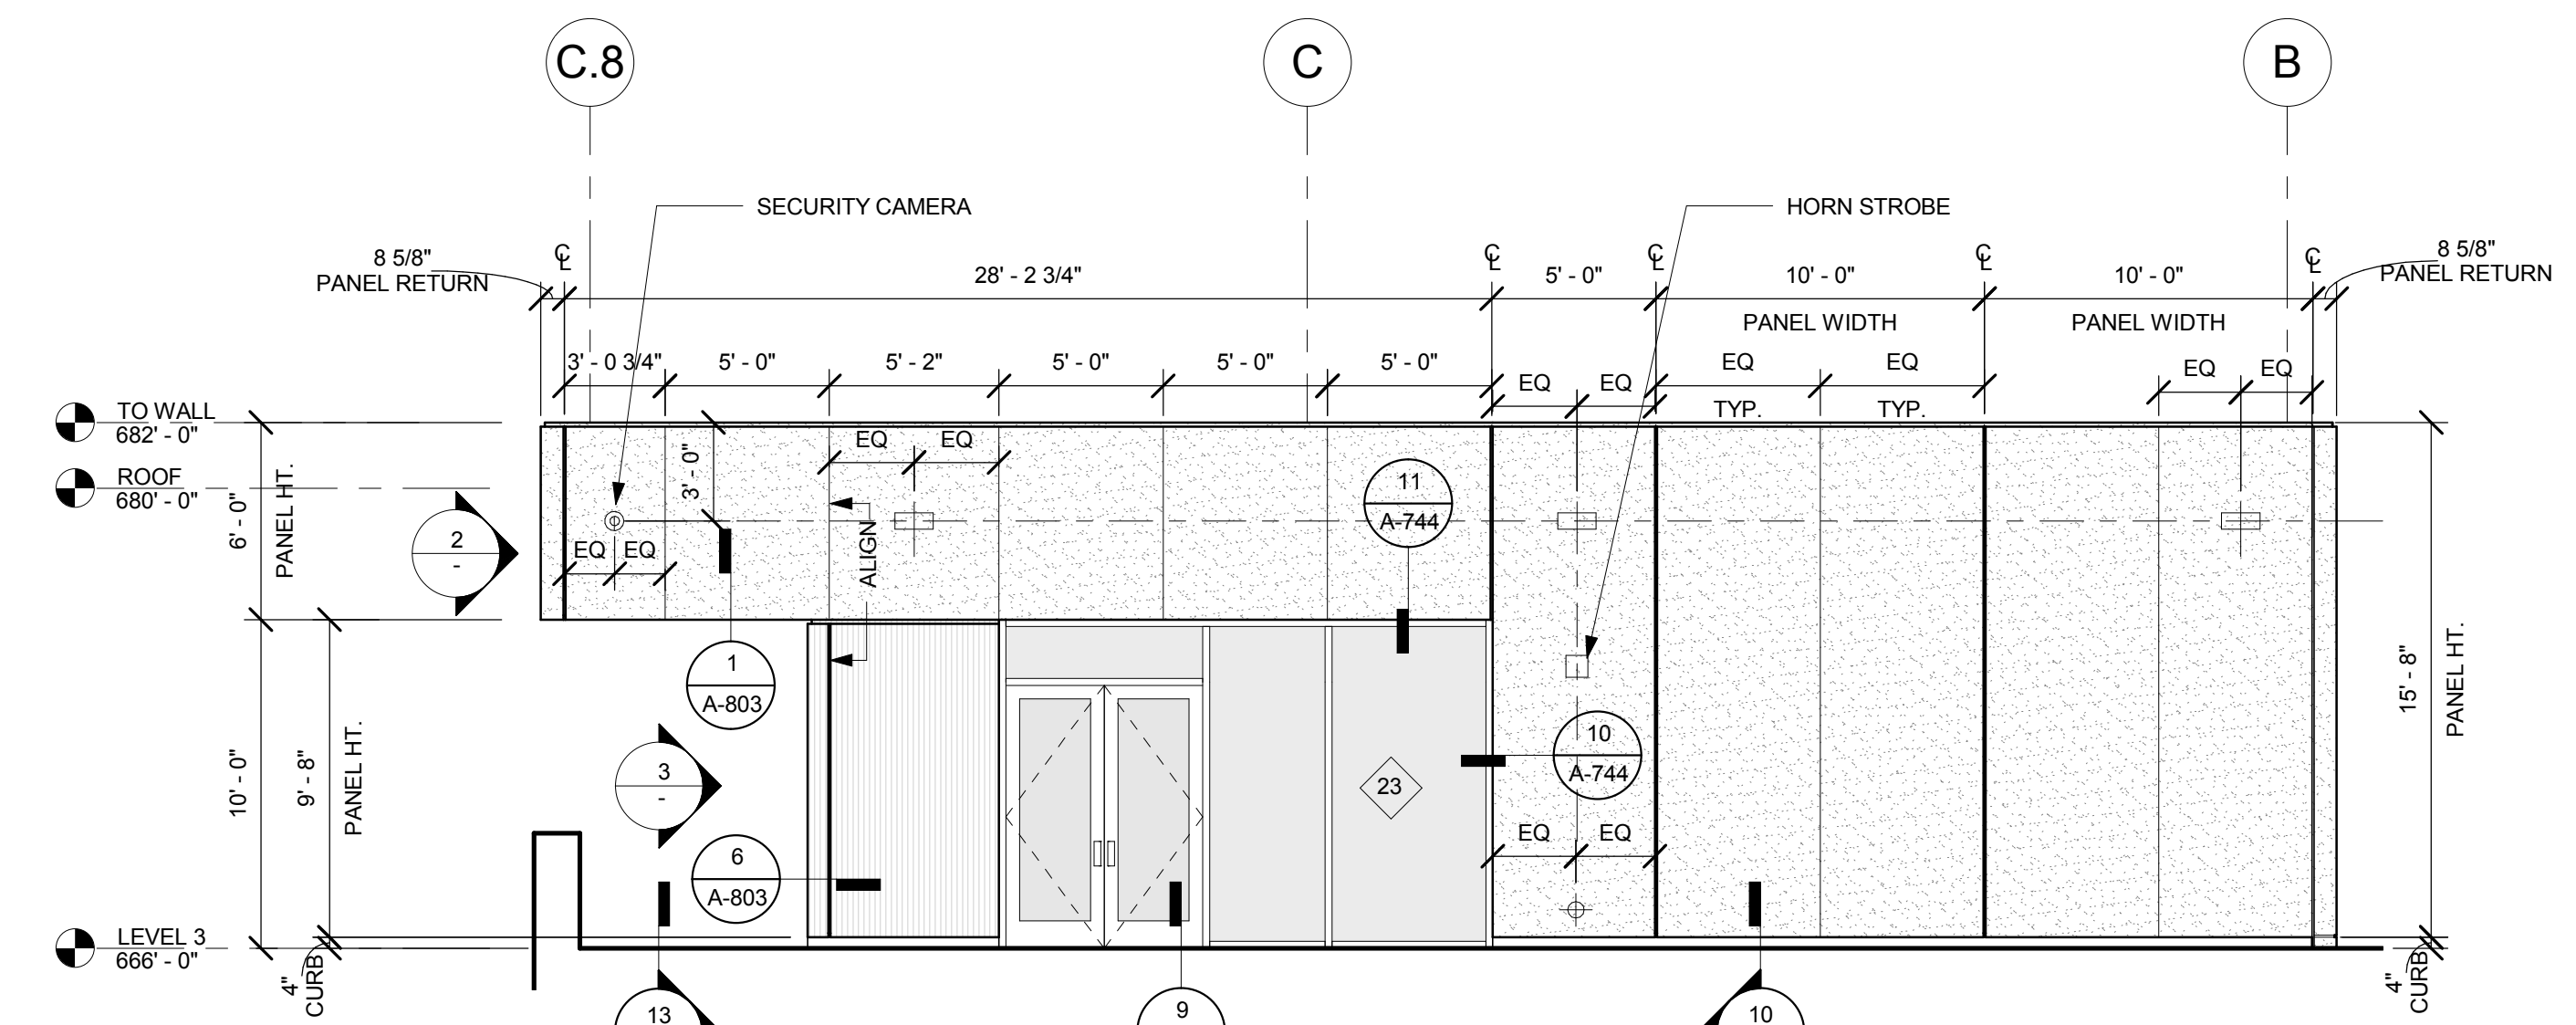

**4 PARTIAL NORTH ELEVATION ALONG 5**  
3/16" = 1'-0"

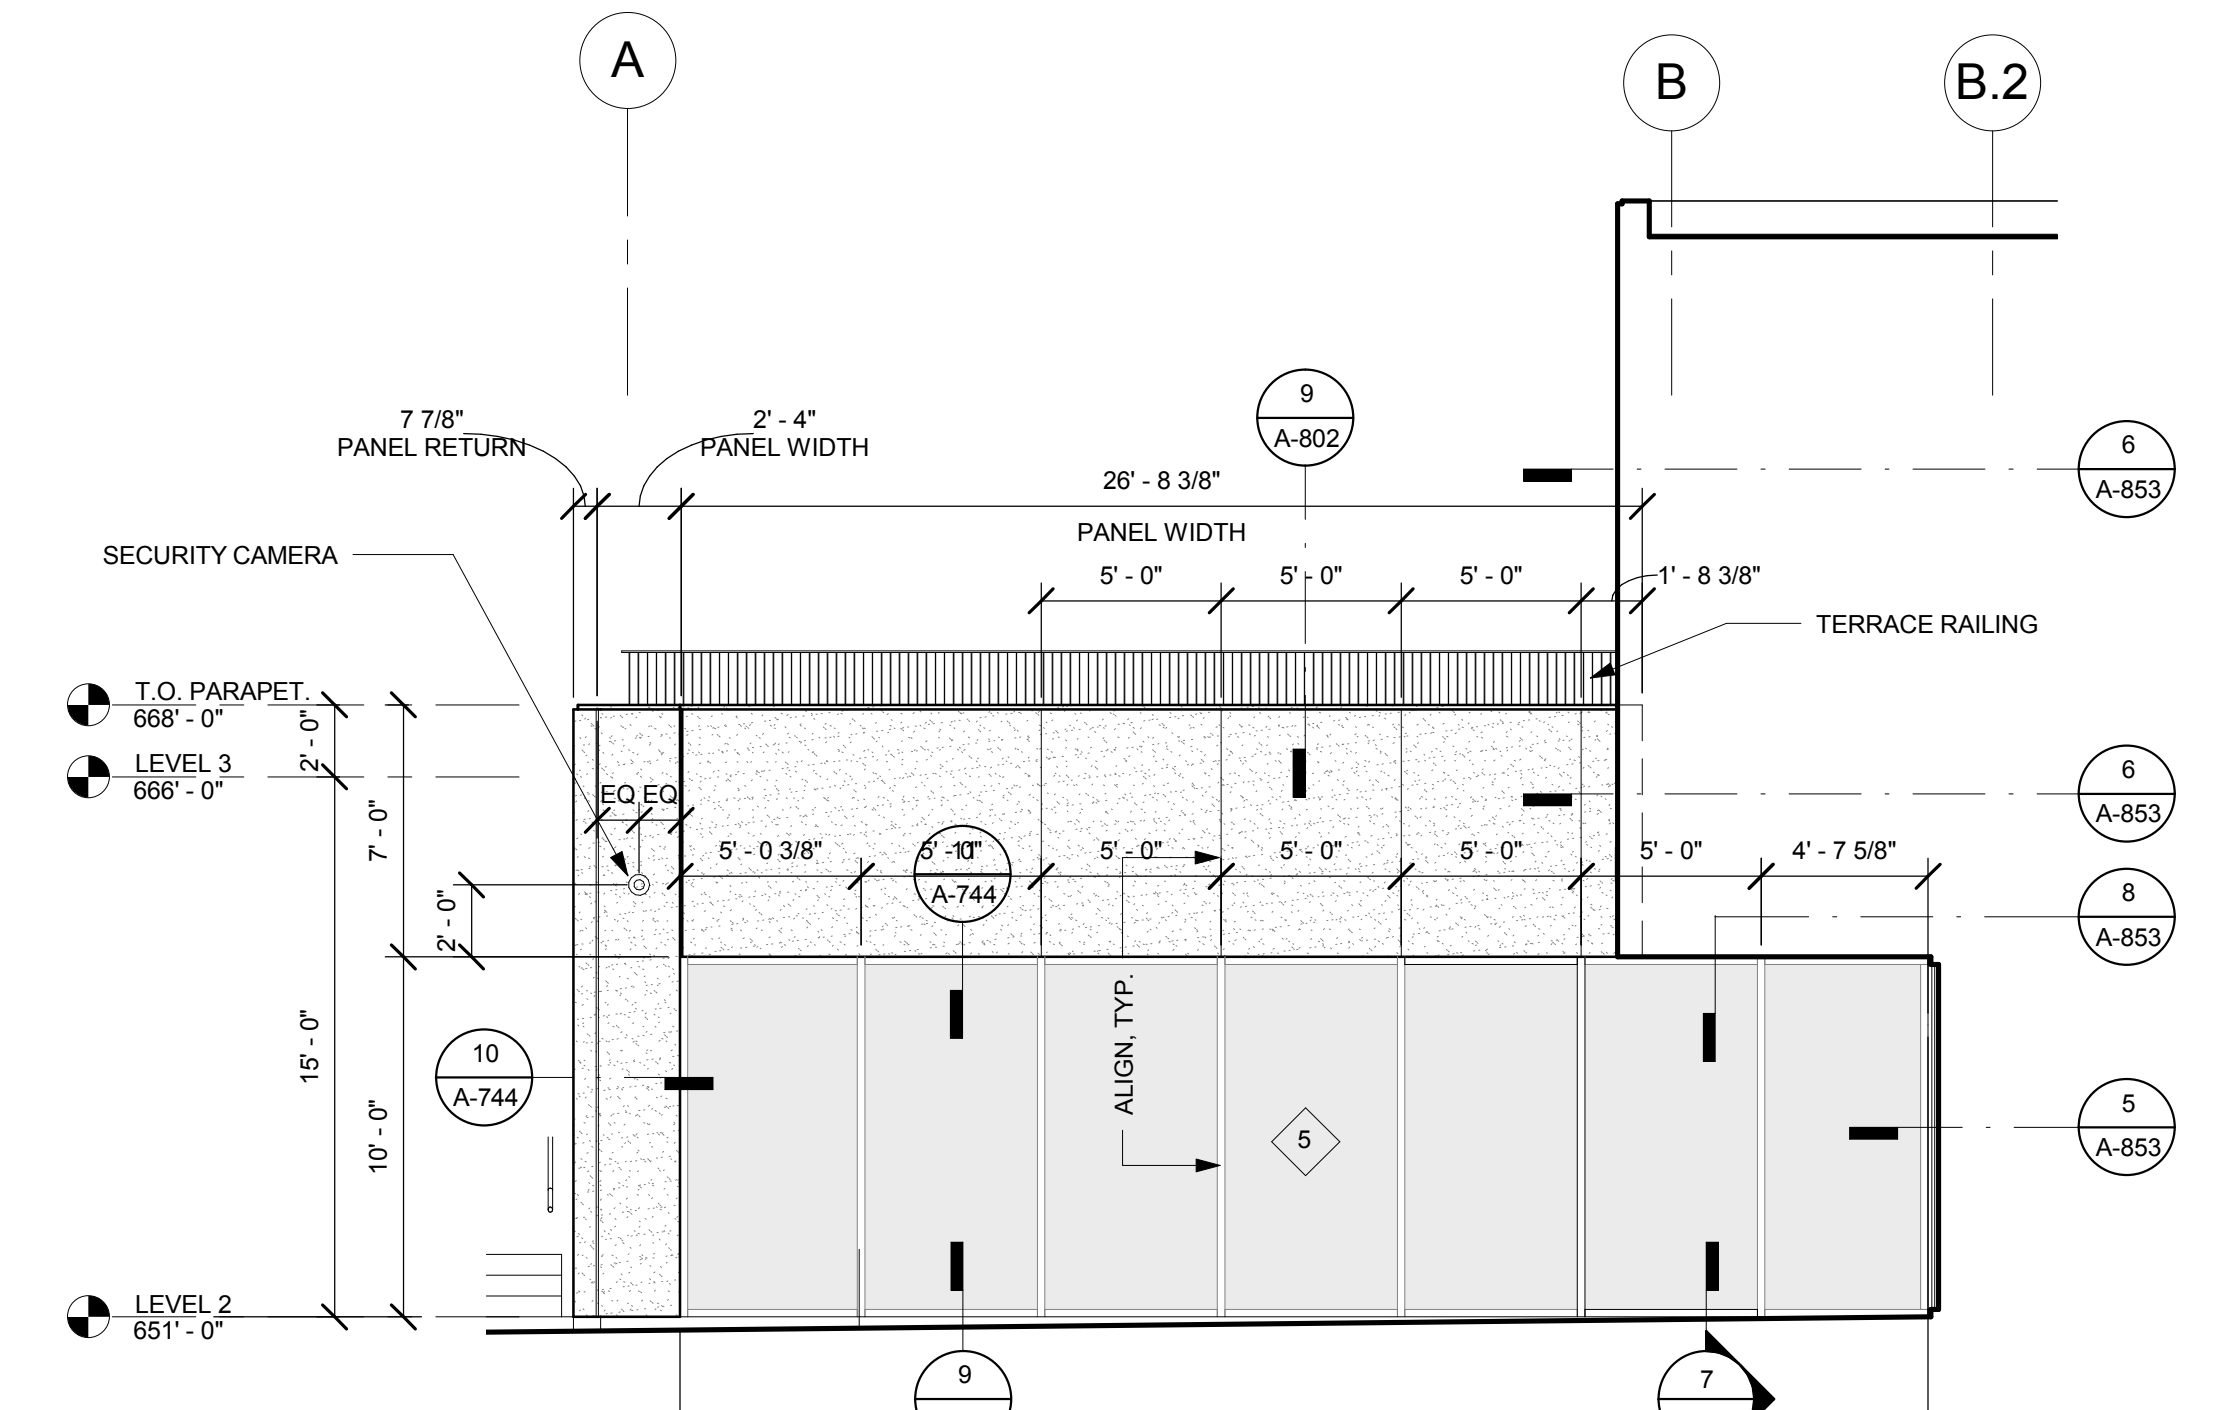

**5 SOUTH ELEVATION ALONG 6**  
3/16" = 1'-0"

**GENERAL NOTES:**  
1. SEE A-740 SERIES FOR WINDOW DETAILS

**PROJECT RECORD SET**

**BUILDING 4  
SKYLINE COLLEGE**  
SAN MATEO COUNTY  
COMMUNITY COLLEGE  
DISTRICT

**CIP2 DESIGN-BUILD  
PROJECT  
BUILDING 4**

PROJECT NO: 07012.00 DRAWN BY: MC  
DATE: 06/23/08 CHECKED BY: LG  
SCALE: As indicated

**ENLARGED  
ELEVATIONS**