


**2** SECTION BETWEEN C/C.8  
1/2" = 1'-0"

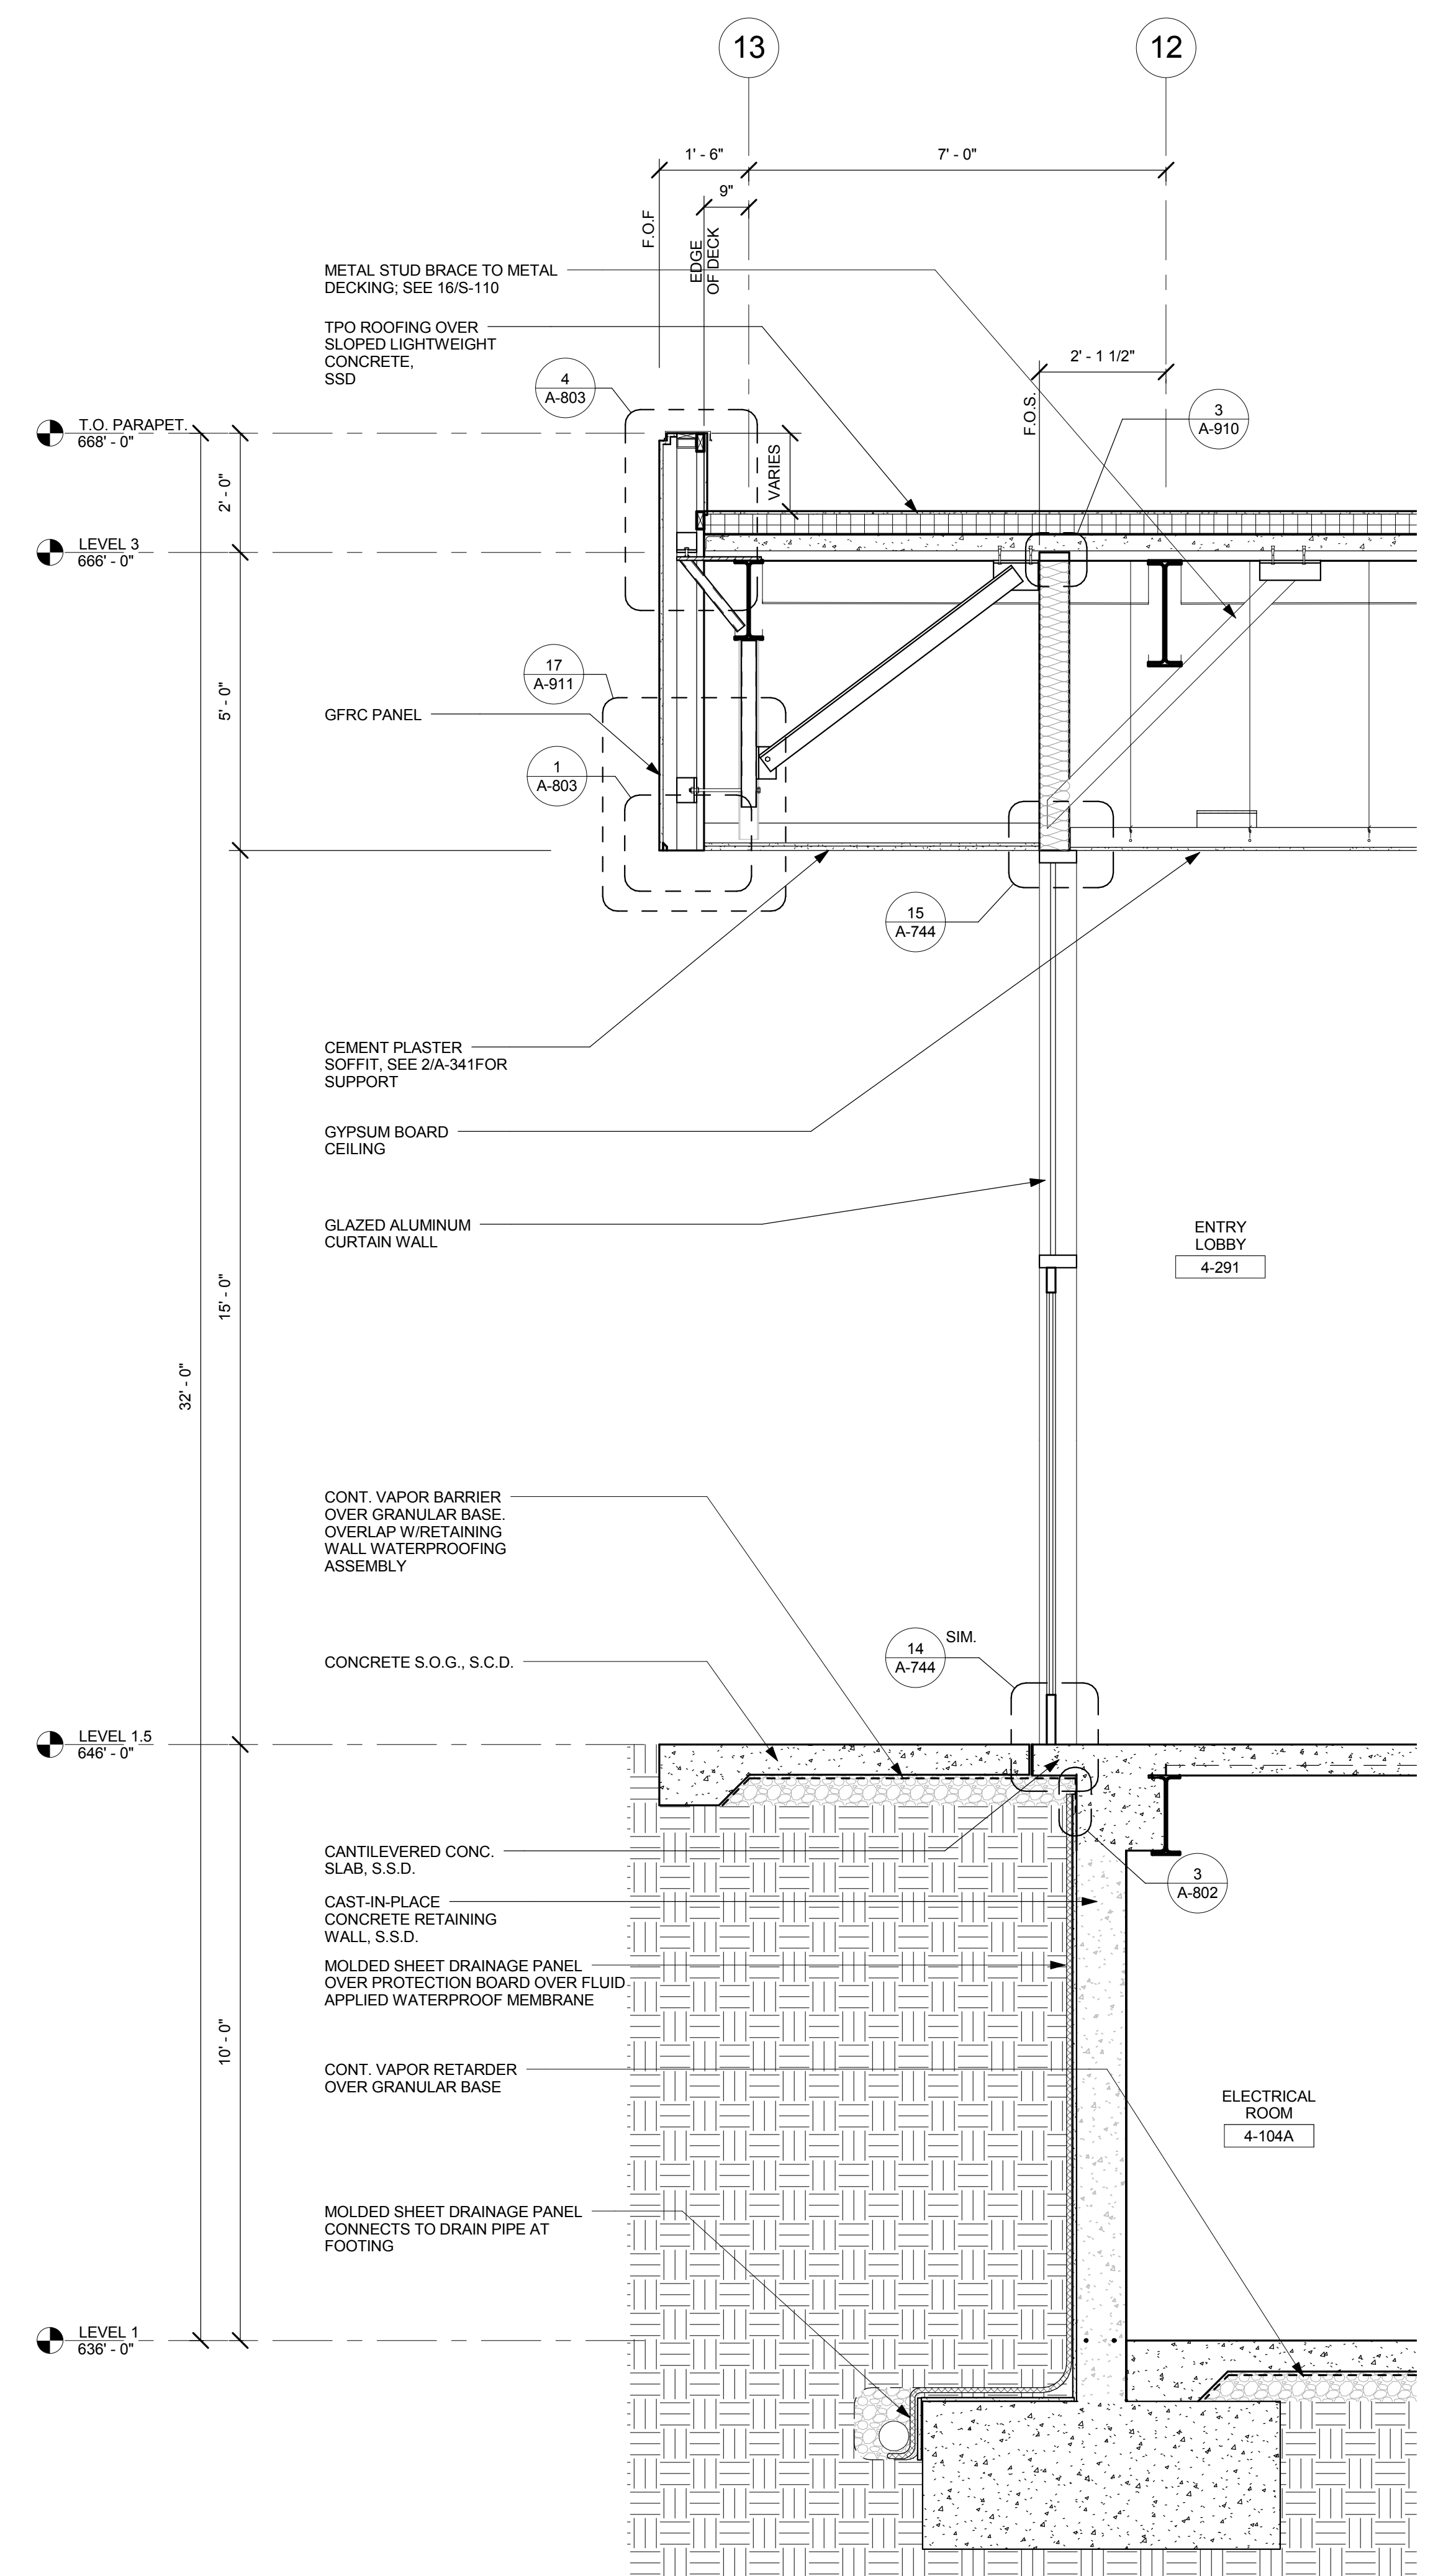


**1** SECTION BETWEEN A/B  
1/2" = 1'-0"

PROJECT  
RECORD SET

BUILDING 4  
SKYLINE COLLEGE

SAN MATEO COUNTY  
COMMUNITY COLLEGE  
DISTRICT

CIP2 DESIGN-BUILD  
PROJECT  
BUILDING 4

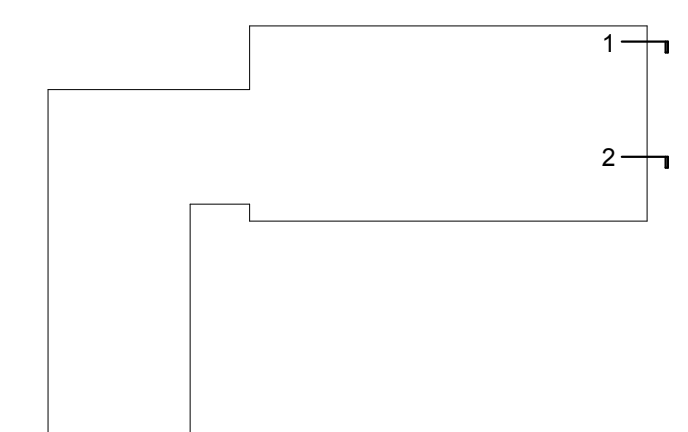

PROJECT NO.: 07012.00 DRAWN BY: MC  
DATE: 05/01/08 CHECKED BY: LG  
SCALE: As indicated

SHEET TITLE:  
WALL SECTIONS