


PROJECT  
RECORD SET

BUILDING 4  
SKYLINE COLLEGE


SAN MATEO COUNTY  
COMMUNITY COLLEGE  
DISTRICT

CIP2 DESIGN-BUILD  
PROJECT  
BUILDING 4

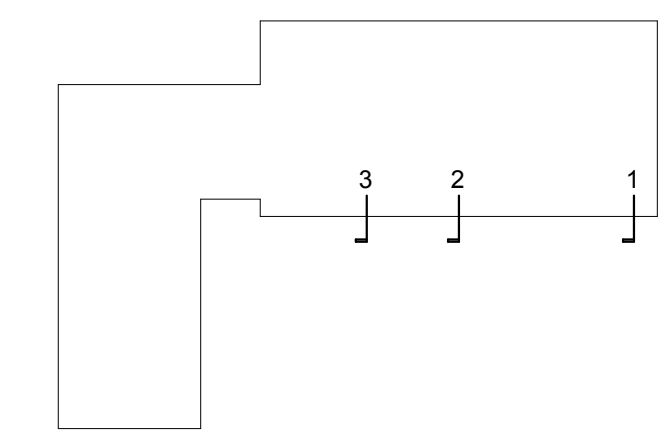


PROJECT NO.: 07012.00 DRAWN BY: MC  
DATE: 06/10/08 CHECKED BY: LG  
SCALE: As indicated


SHEET TITLE:  
WALL SECTIONS

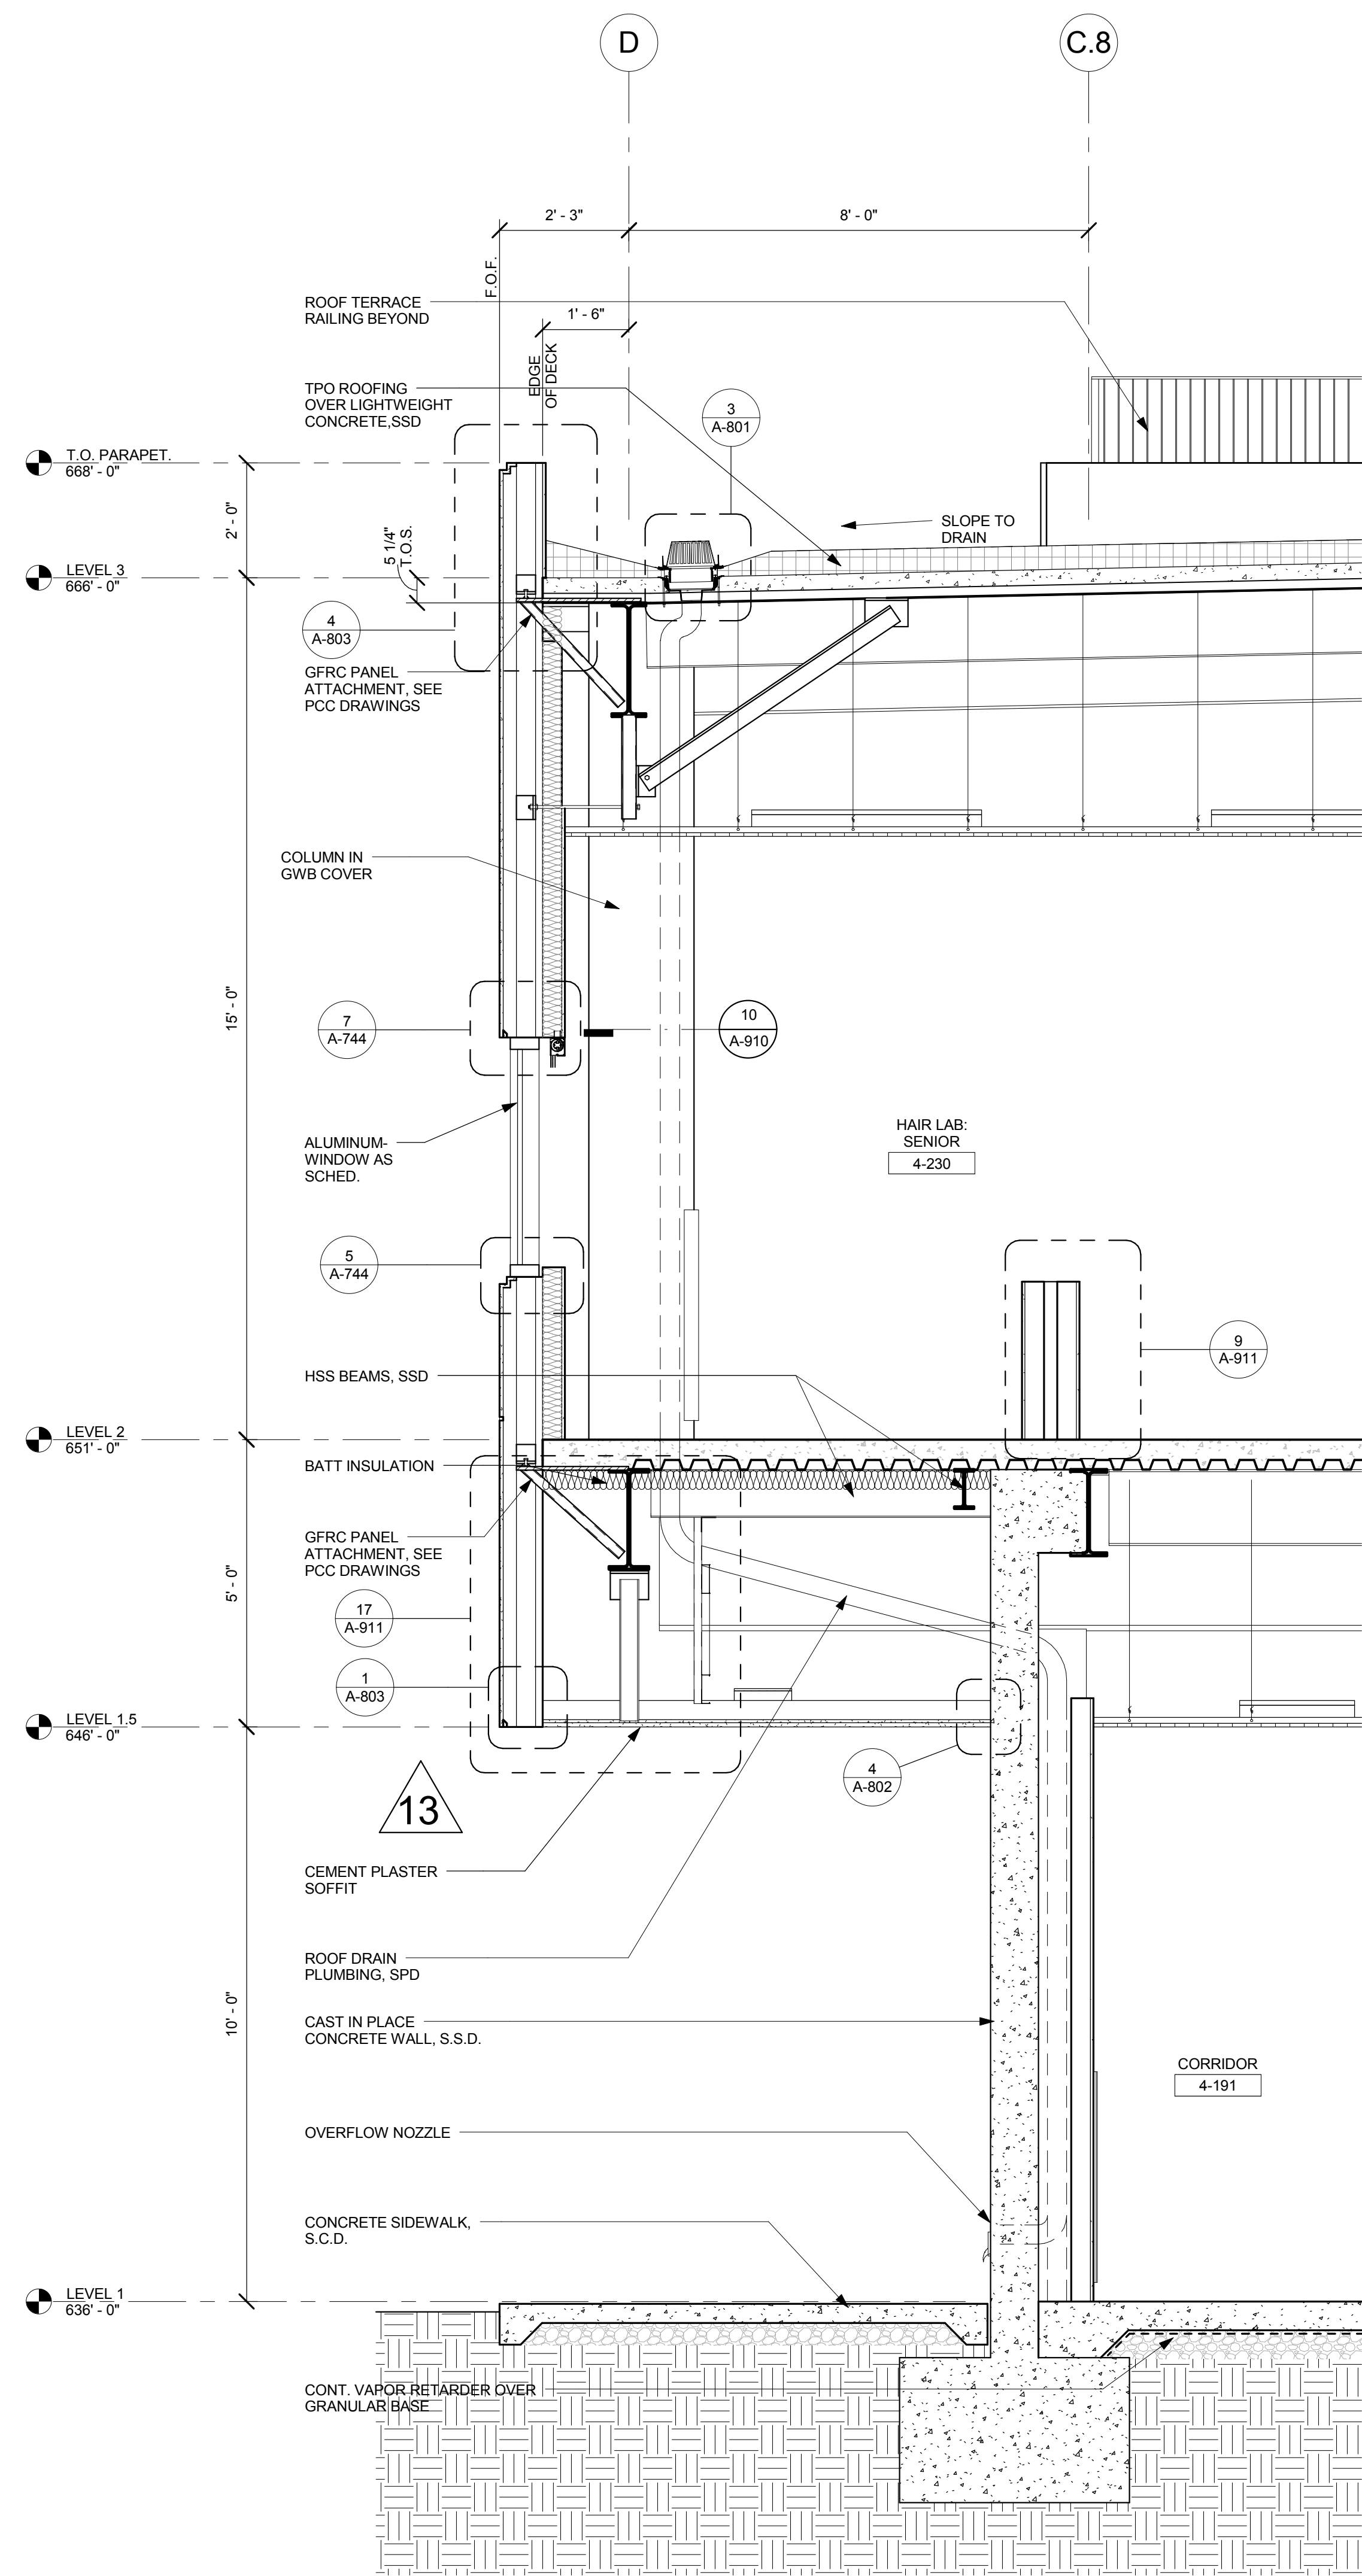

**3** WALL SECTION BTWN 7&8  
1/2" = 1'-0"

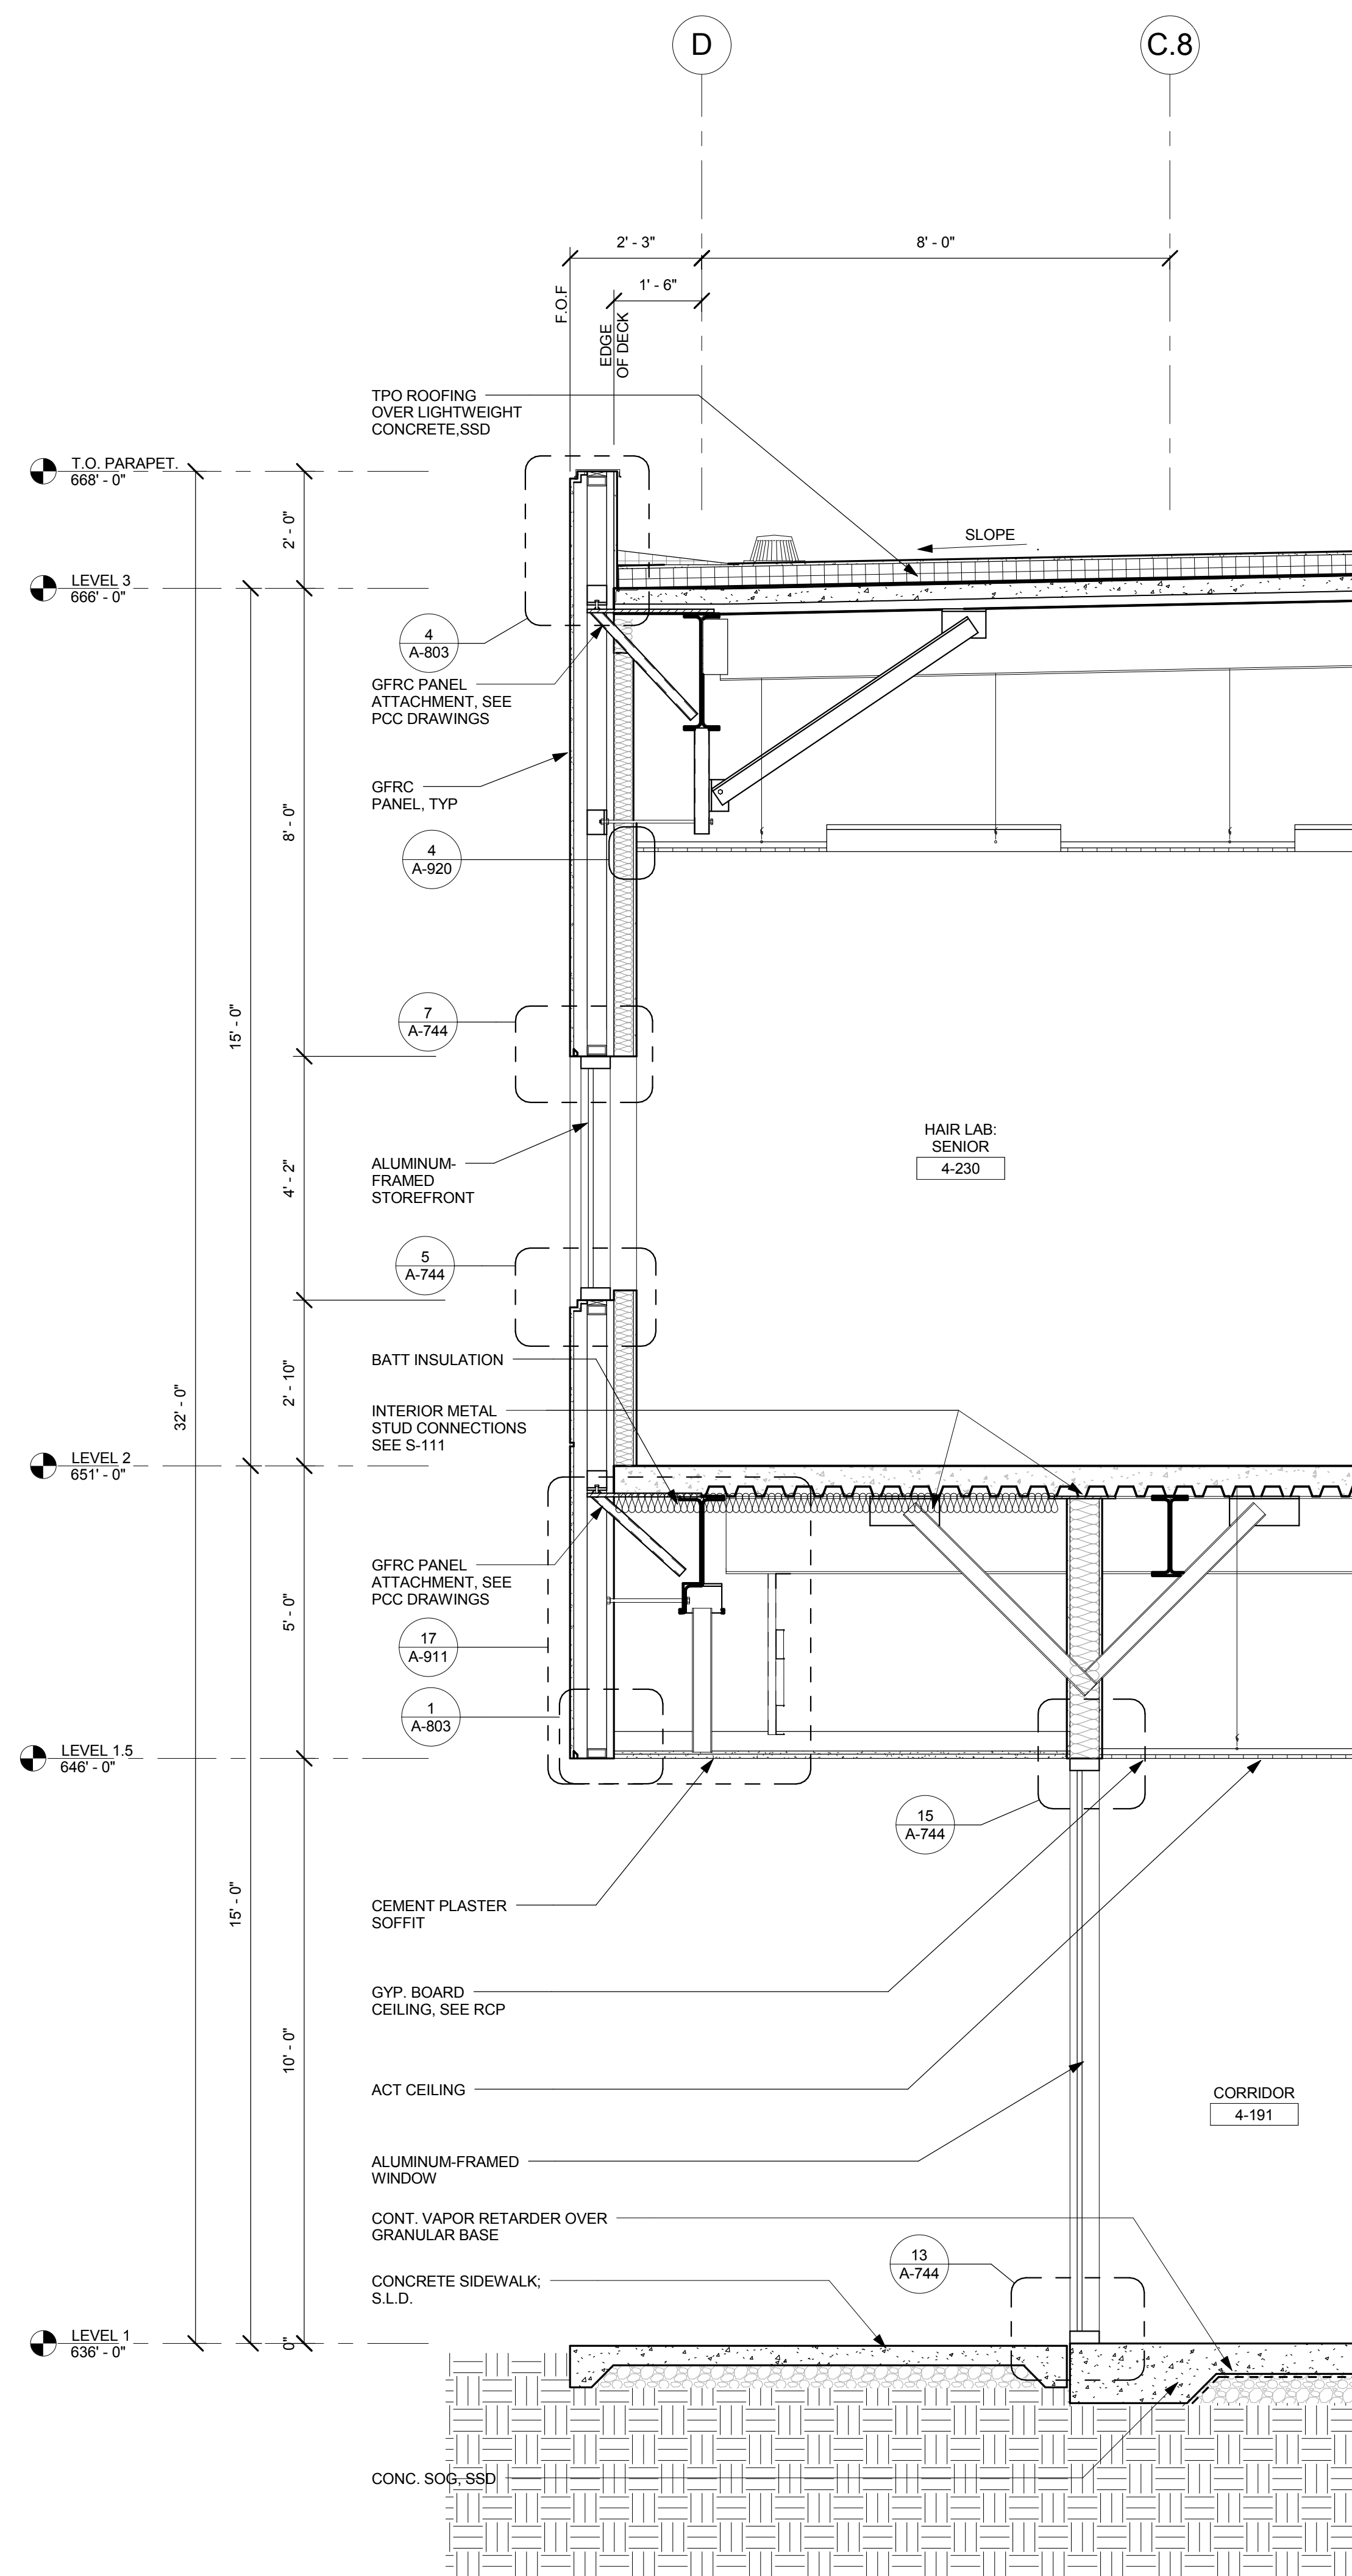

**2** SECTION BETWEEN 8/9  
1/2" = 1'-0"

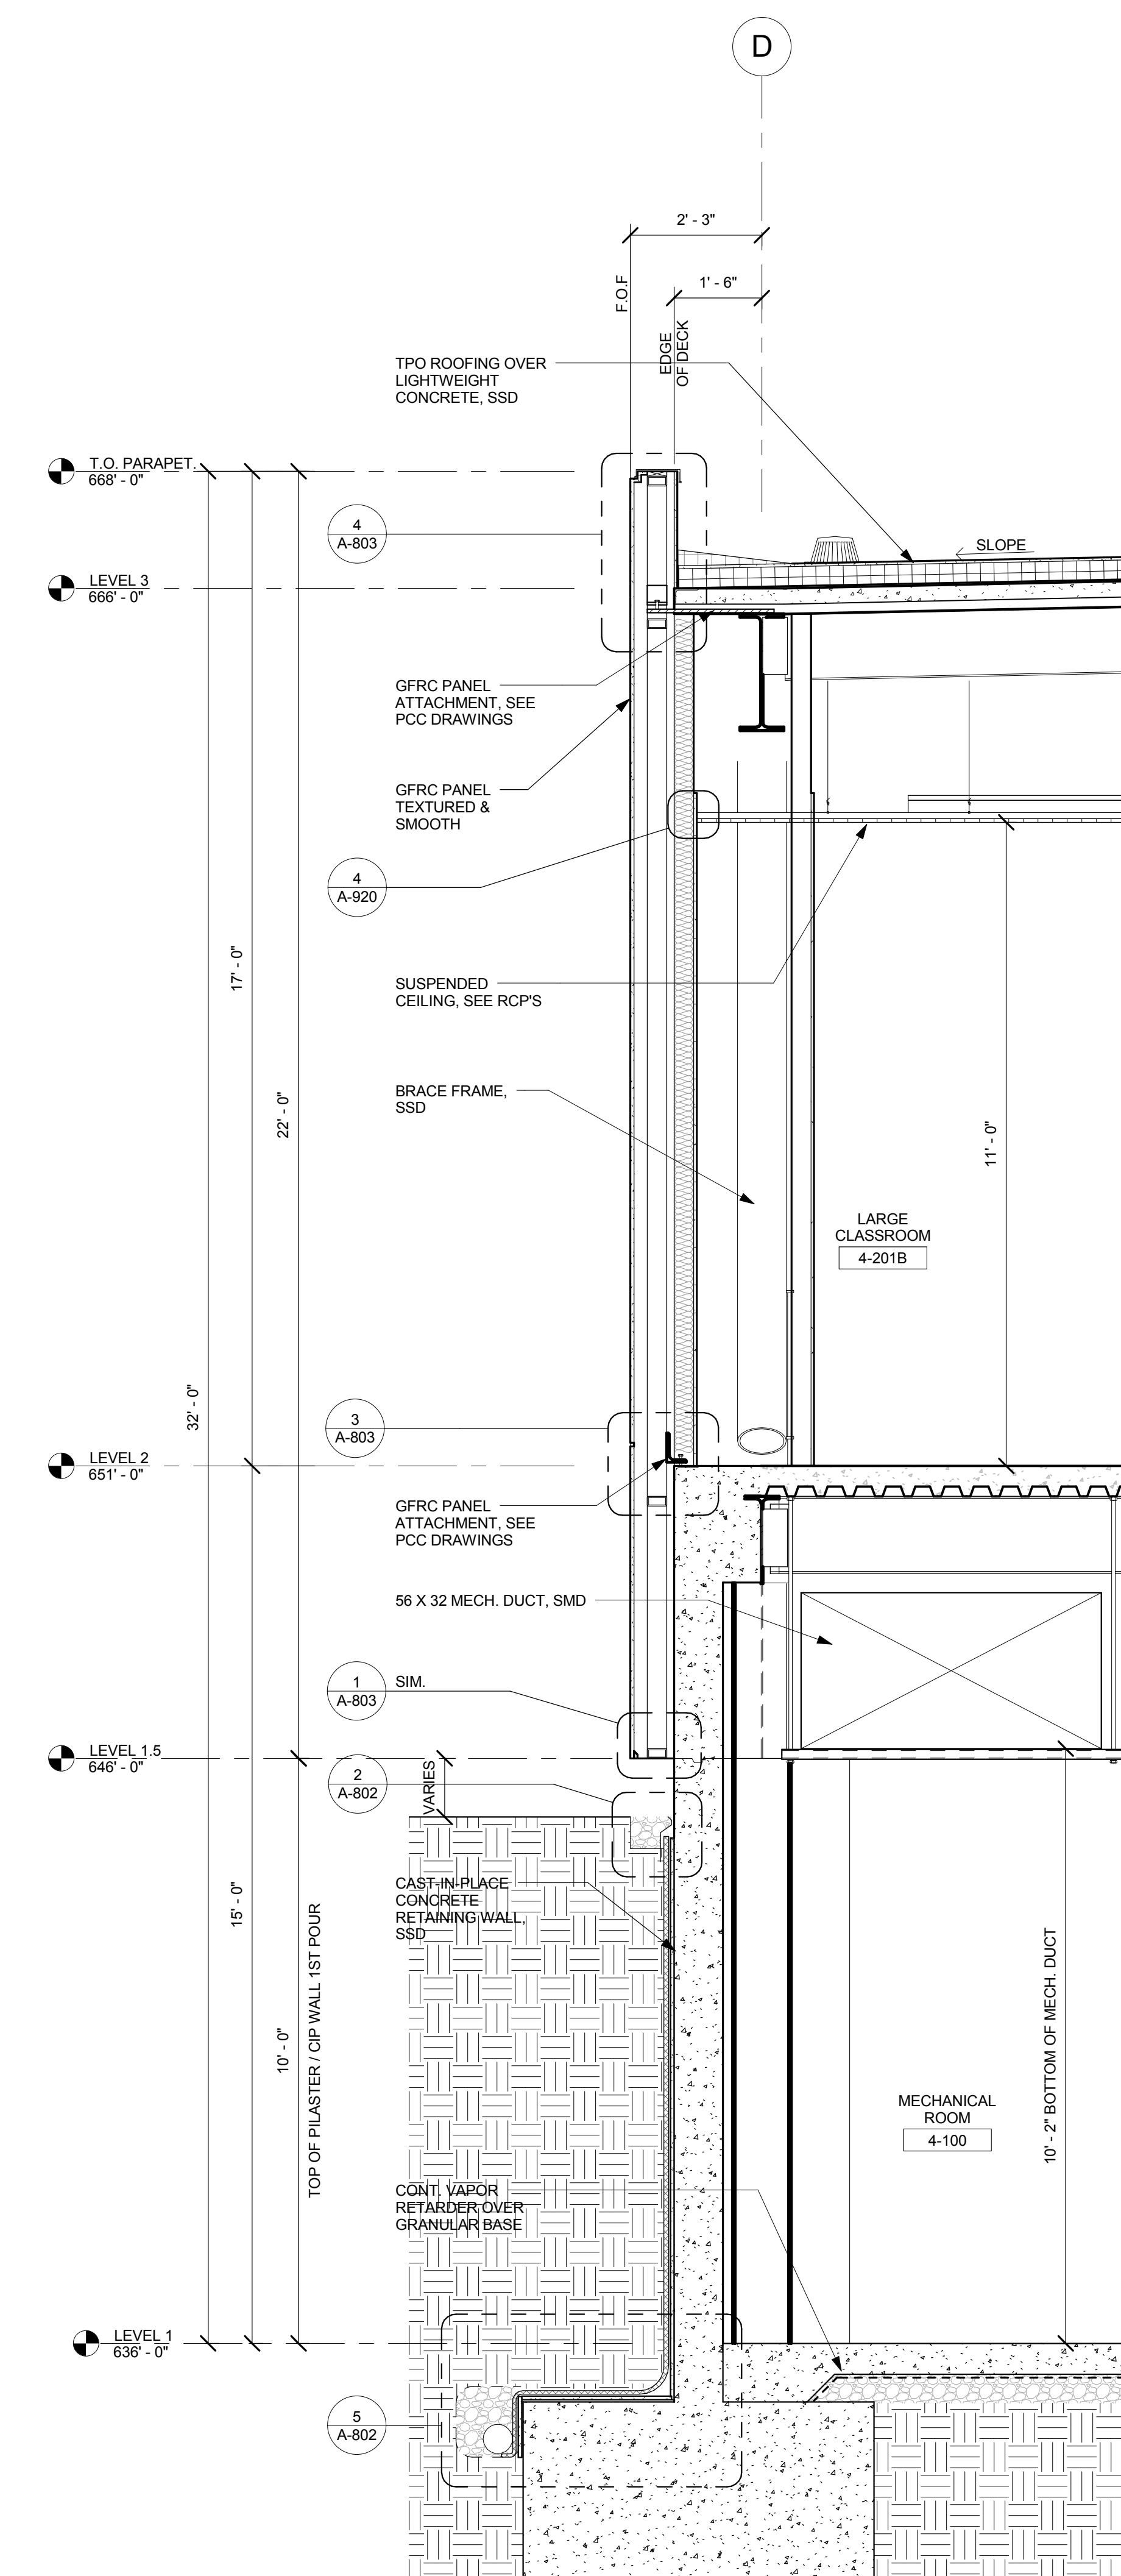

**1** SECTION BETWEEN 11.5/12  
1/2" = 1'-0"