




19 SALON INT. WINDOW JAMB-FASCIA, TYP.
3" = 1'-0"

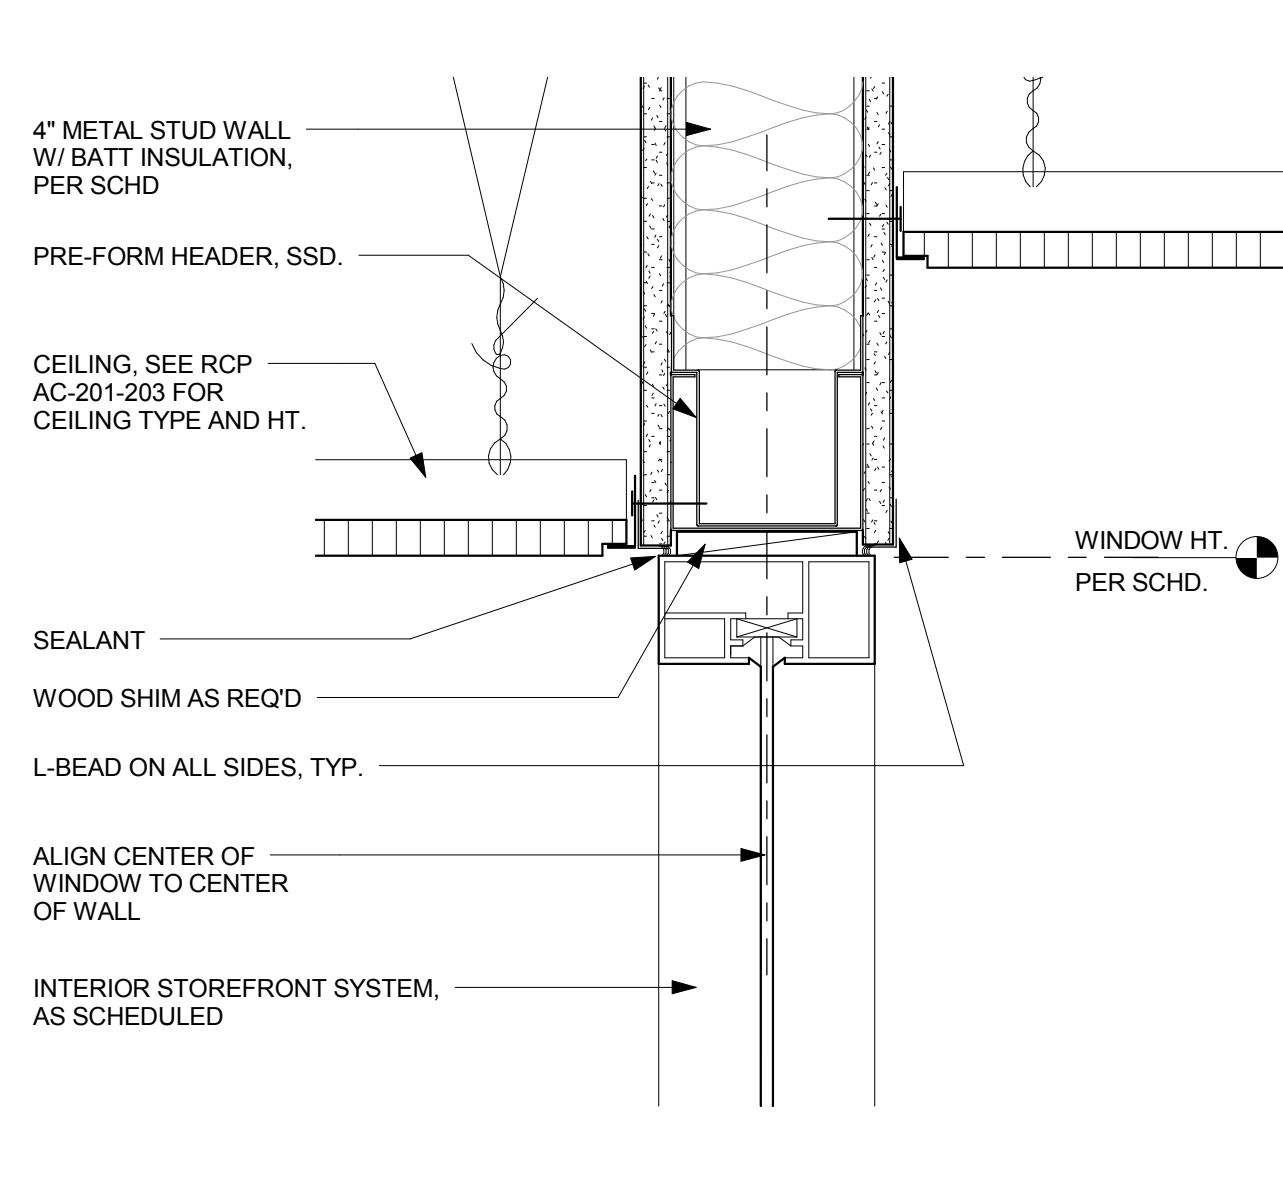


16 INTERIOR STOREFRONT HEAD TYP.
3" = 1'-0"

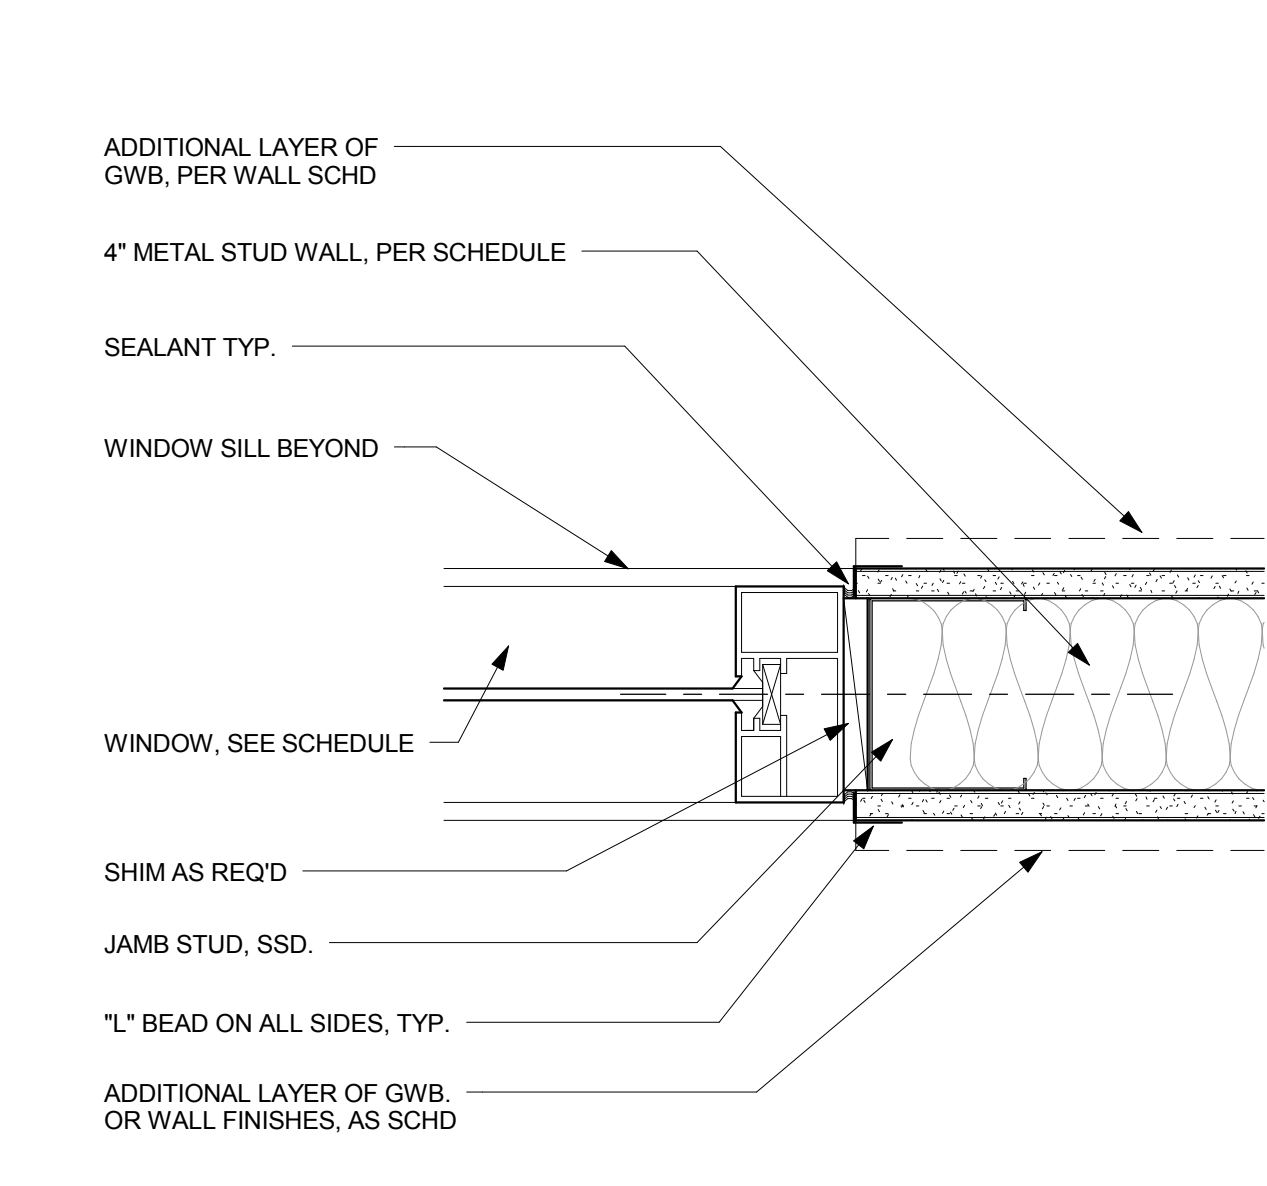


12 INTERIOR WINDOW JAMB, TYP.
3" = 1'-0"

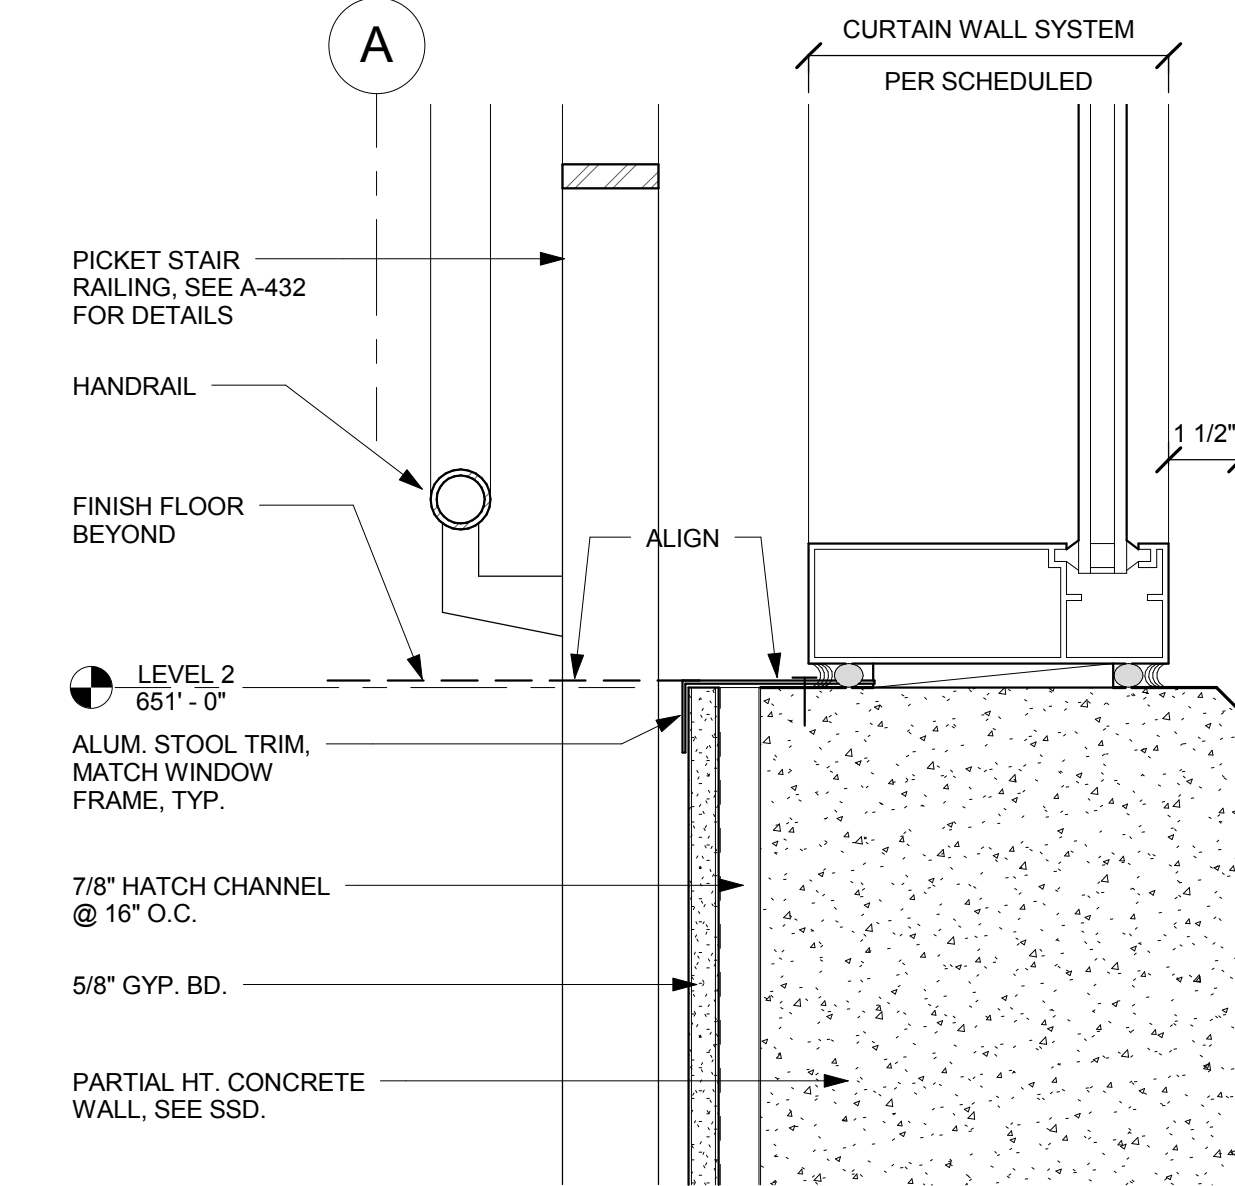


8 WIND. WALL SILL @ STAIR 1
3" = 1'-0"

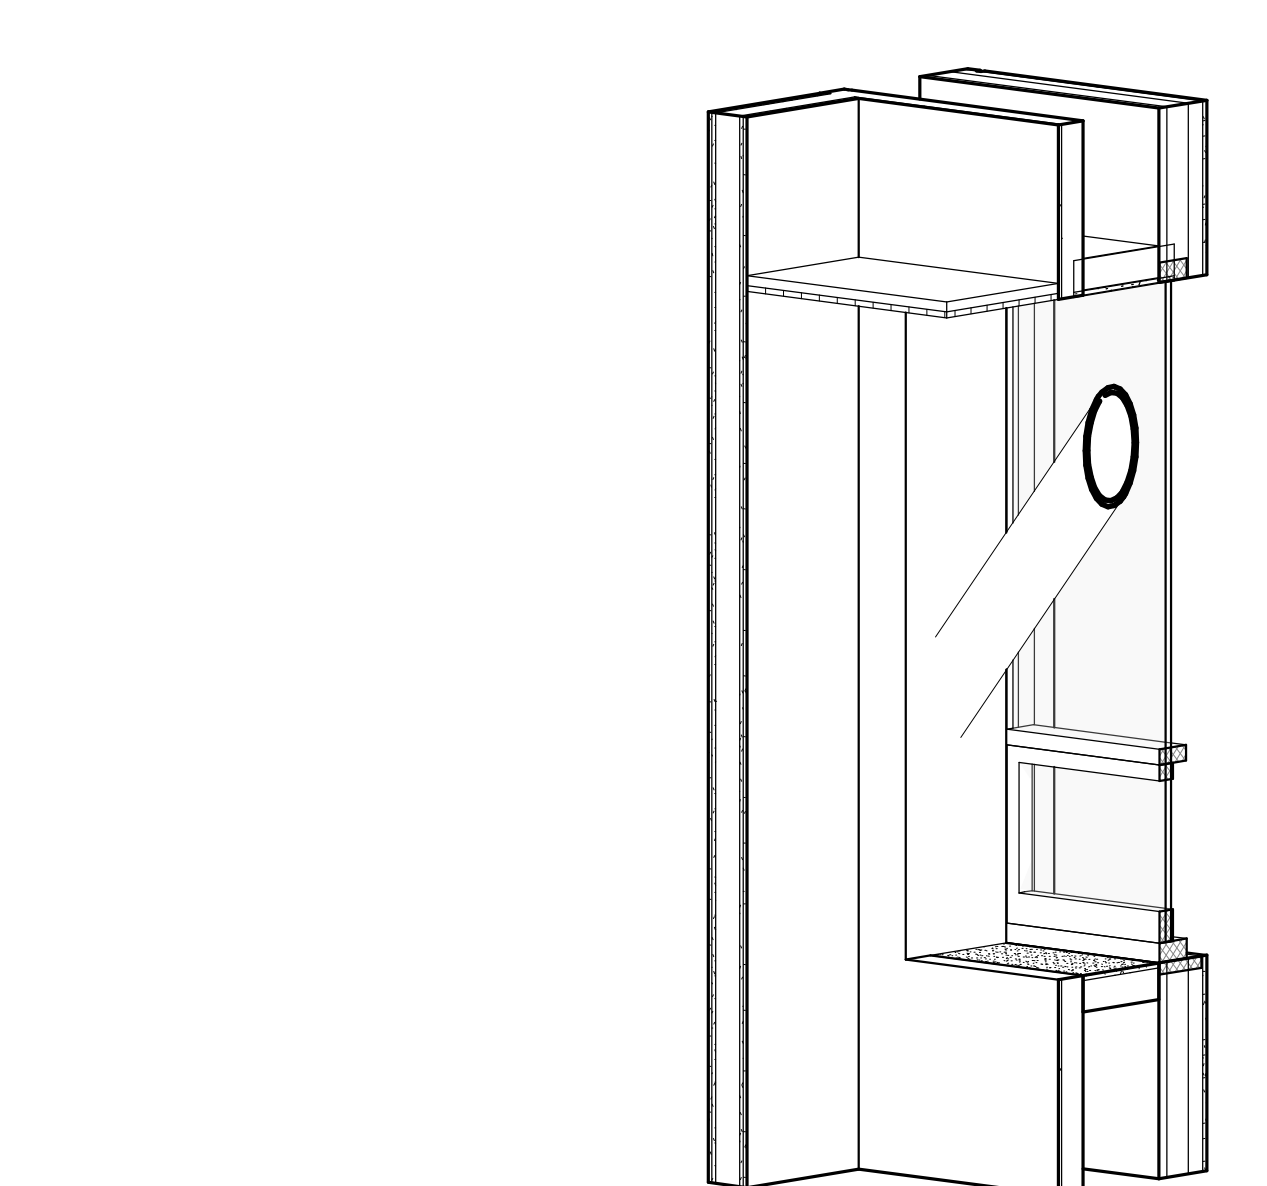


4 WINDOW FURRING AT BRACE - ISO.
3" = 1'-0"

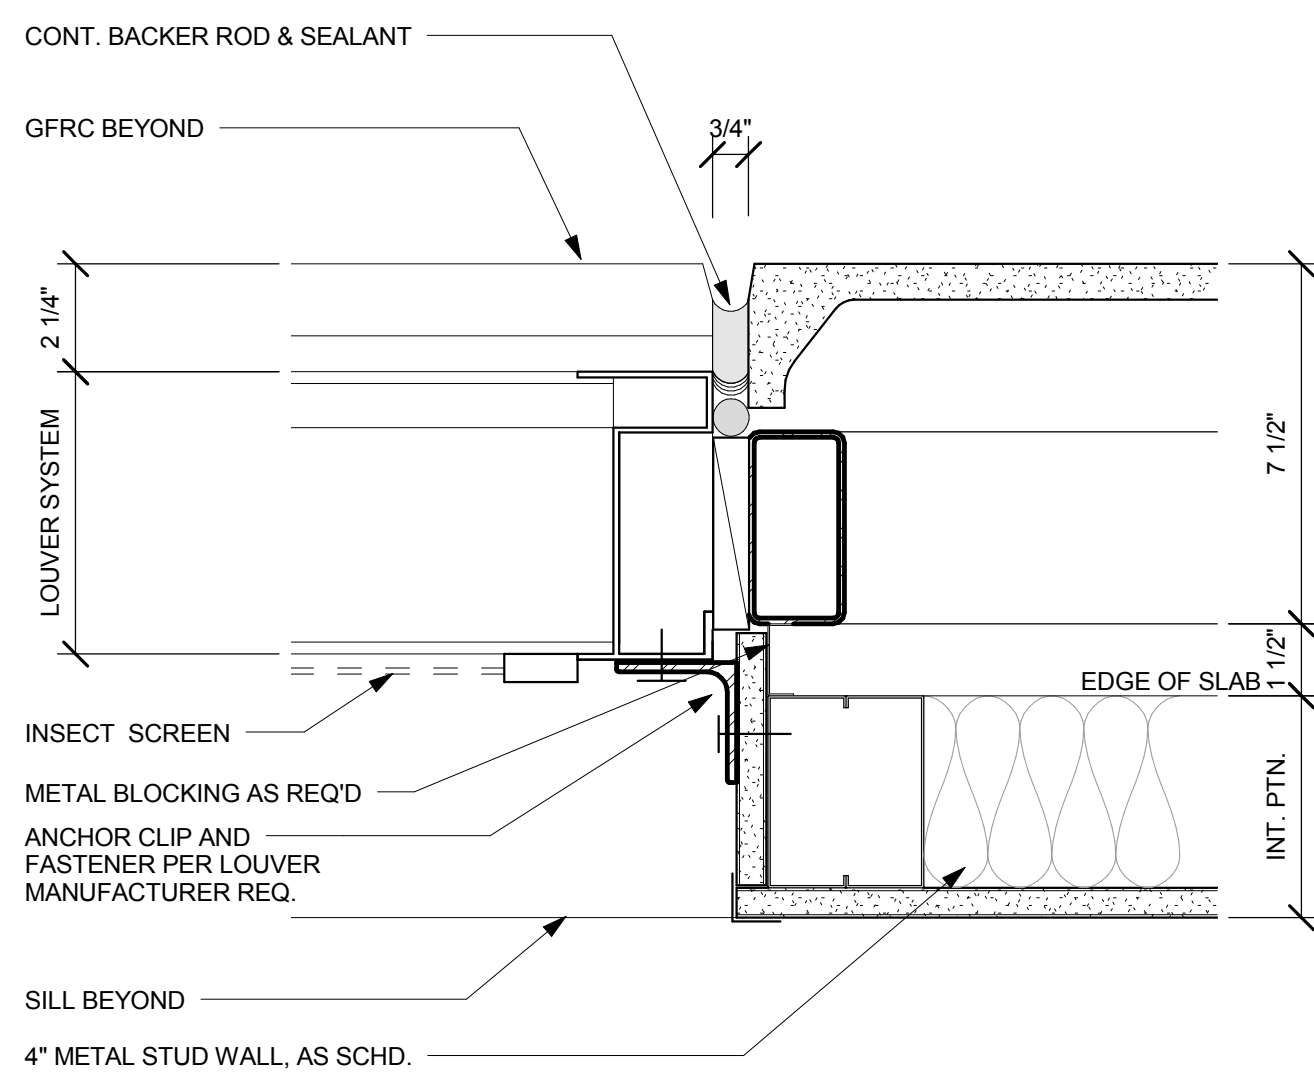


18 LOUVER JAMB AT GFRG
3" = 1'-0"

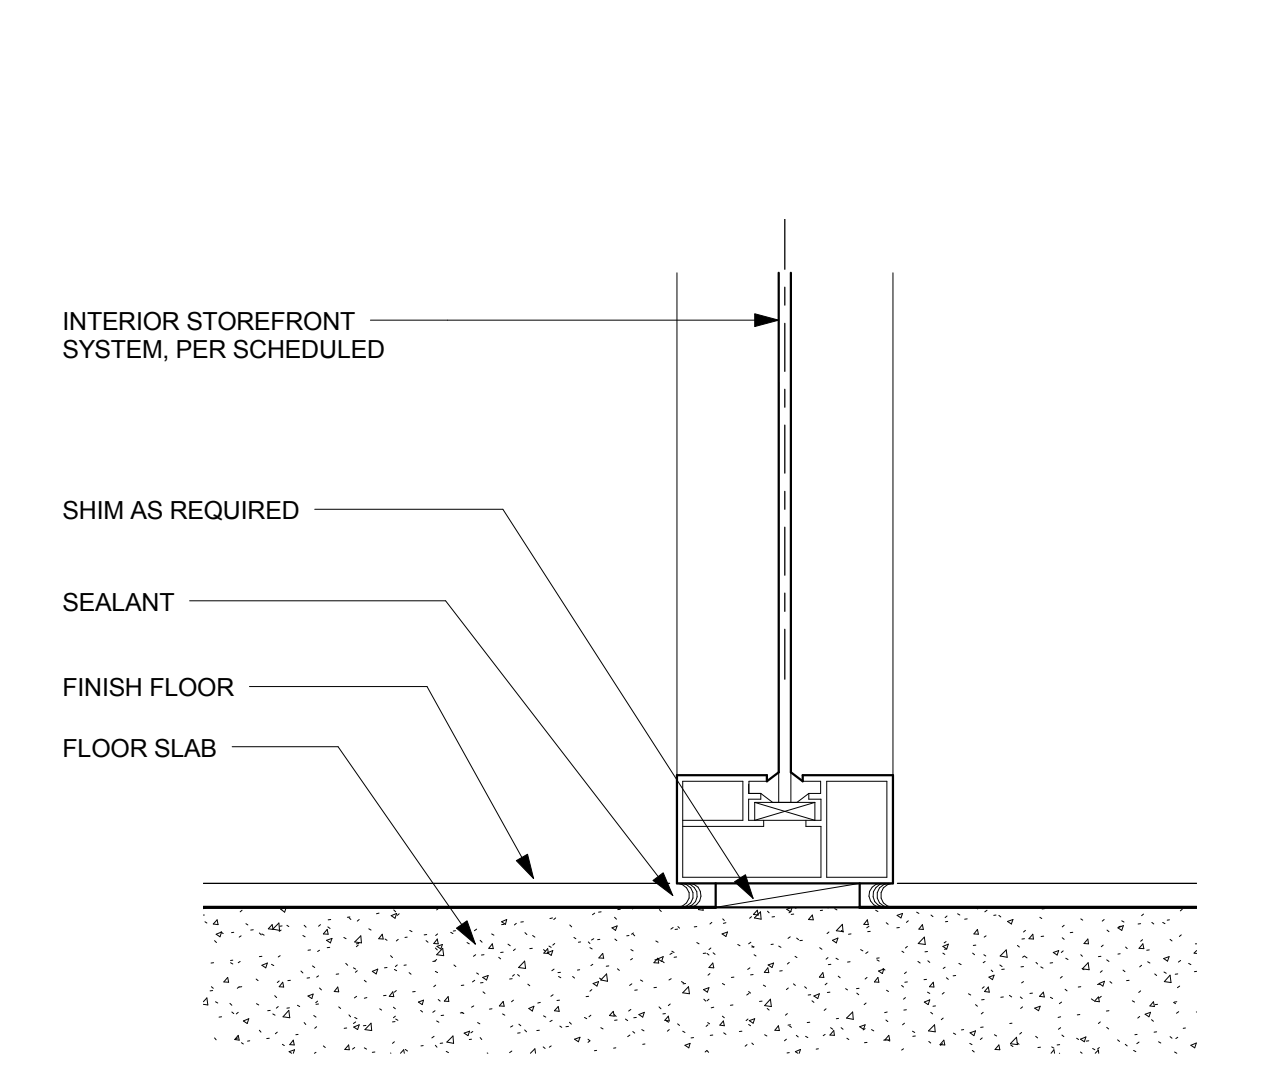



15 INT. STOREFRONT SILL TYP.
3" = 1'-0"

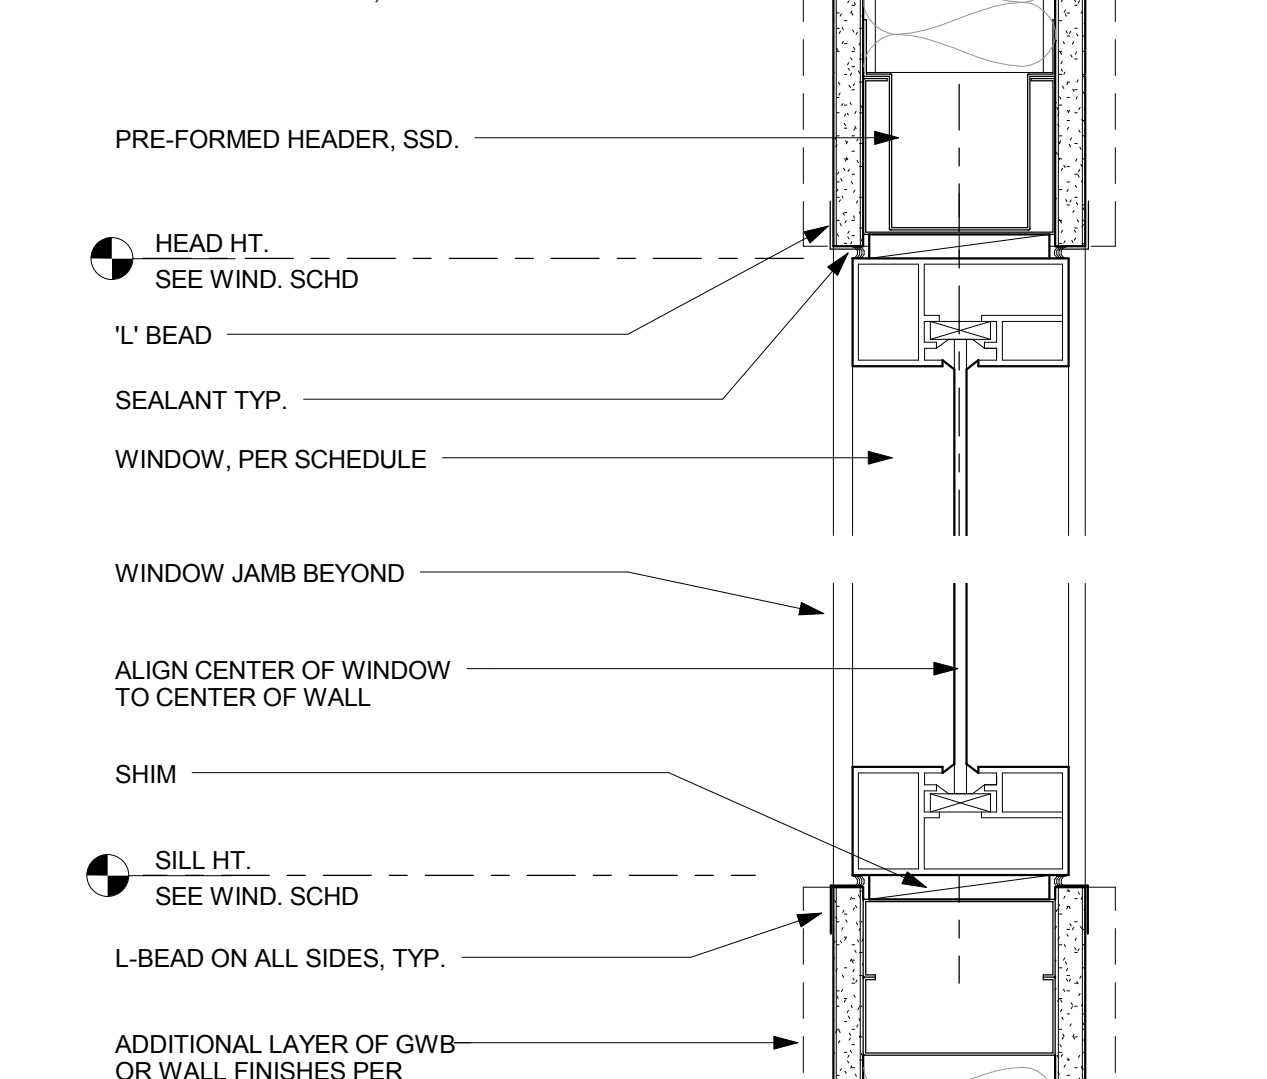


11 INTERIOR WINDOW HEAD/SILL TYP.
3" = 1'-0"

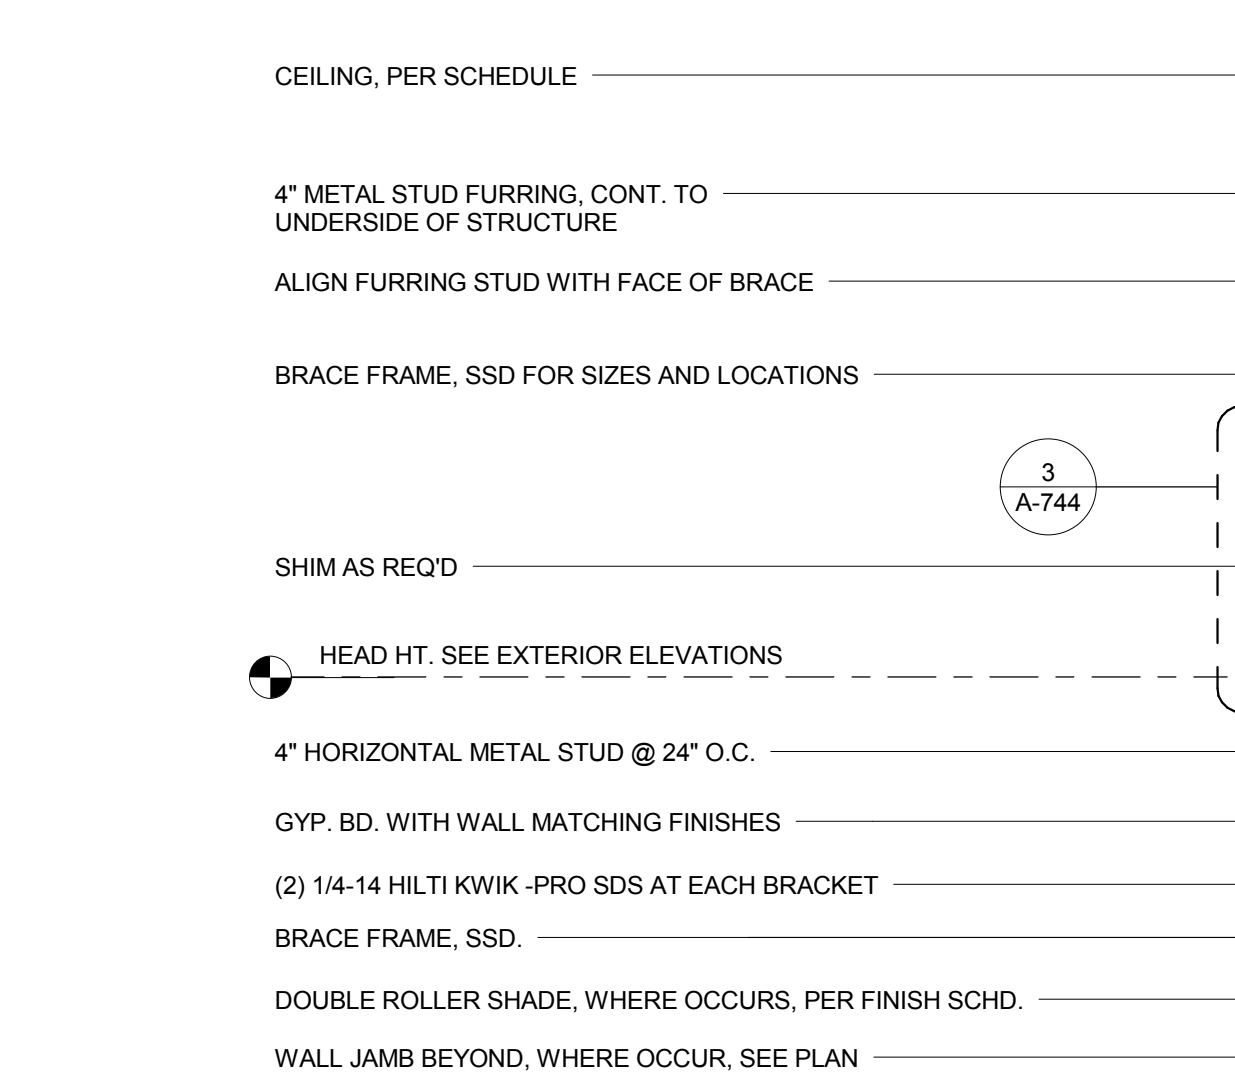


7 WINDOW HEAD - AT BRACES
3" = 1'-0"

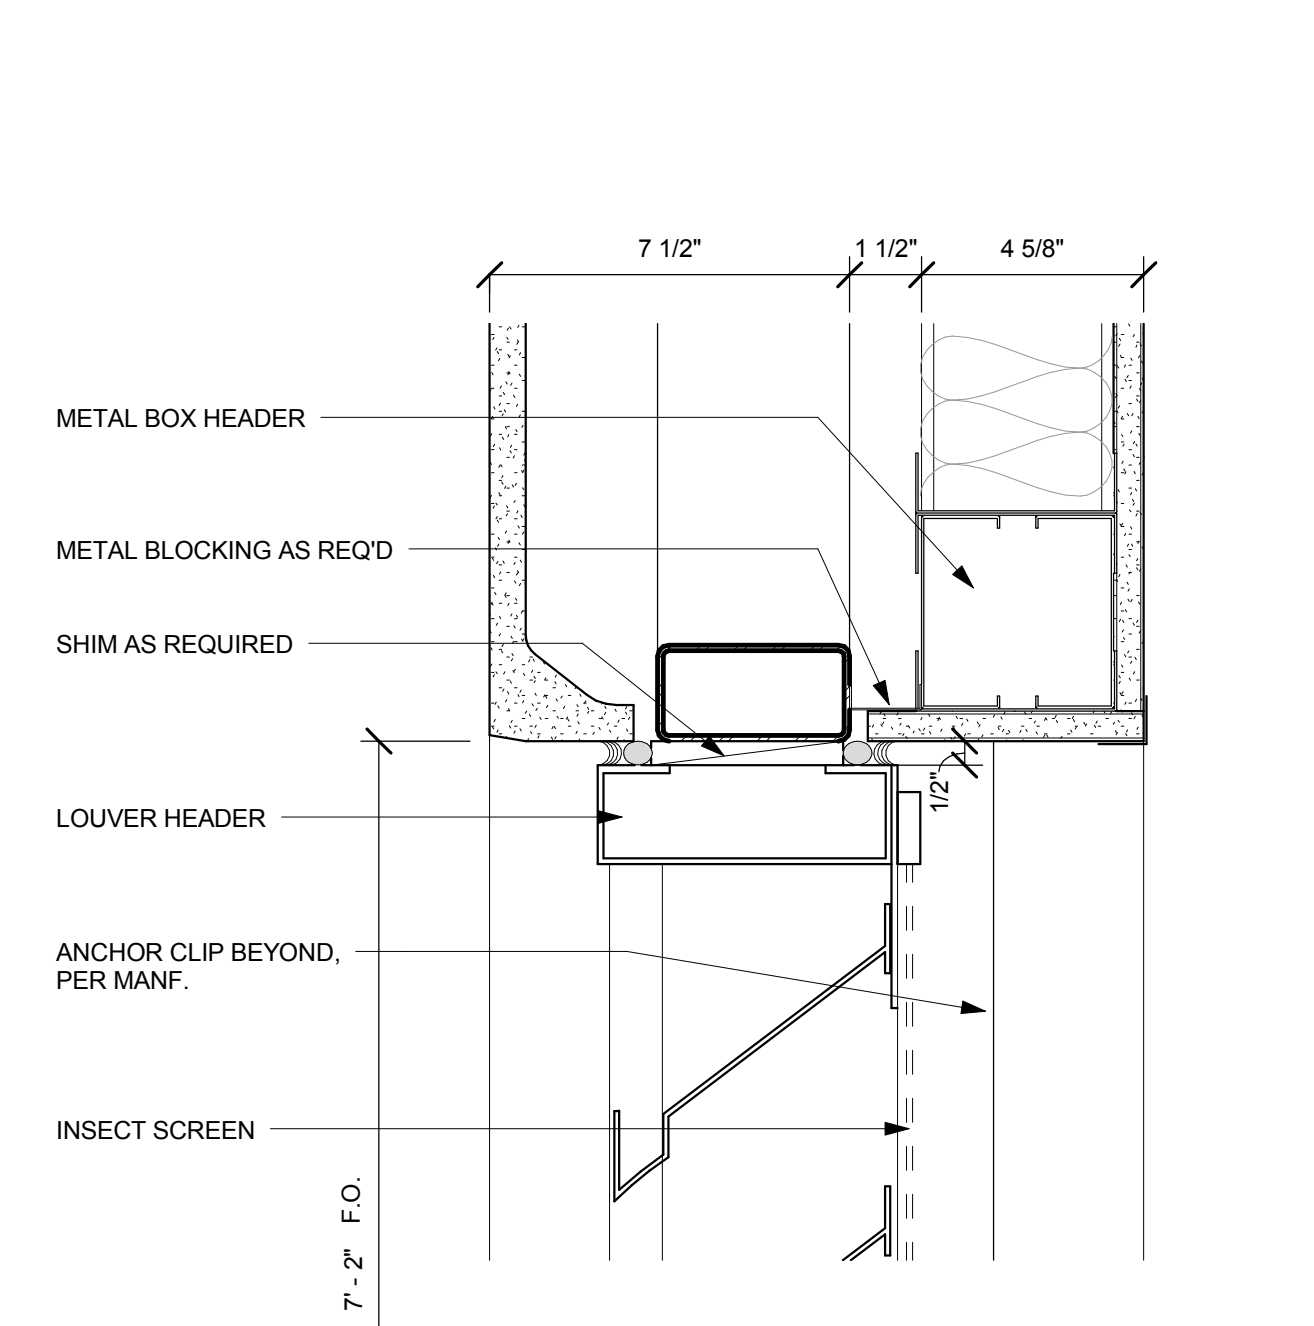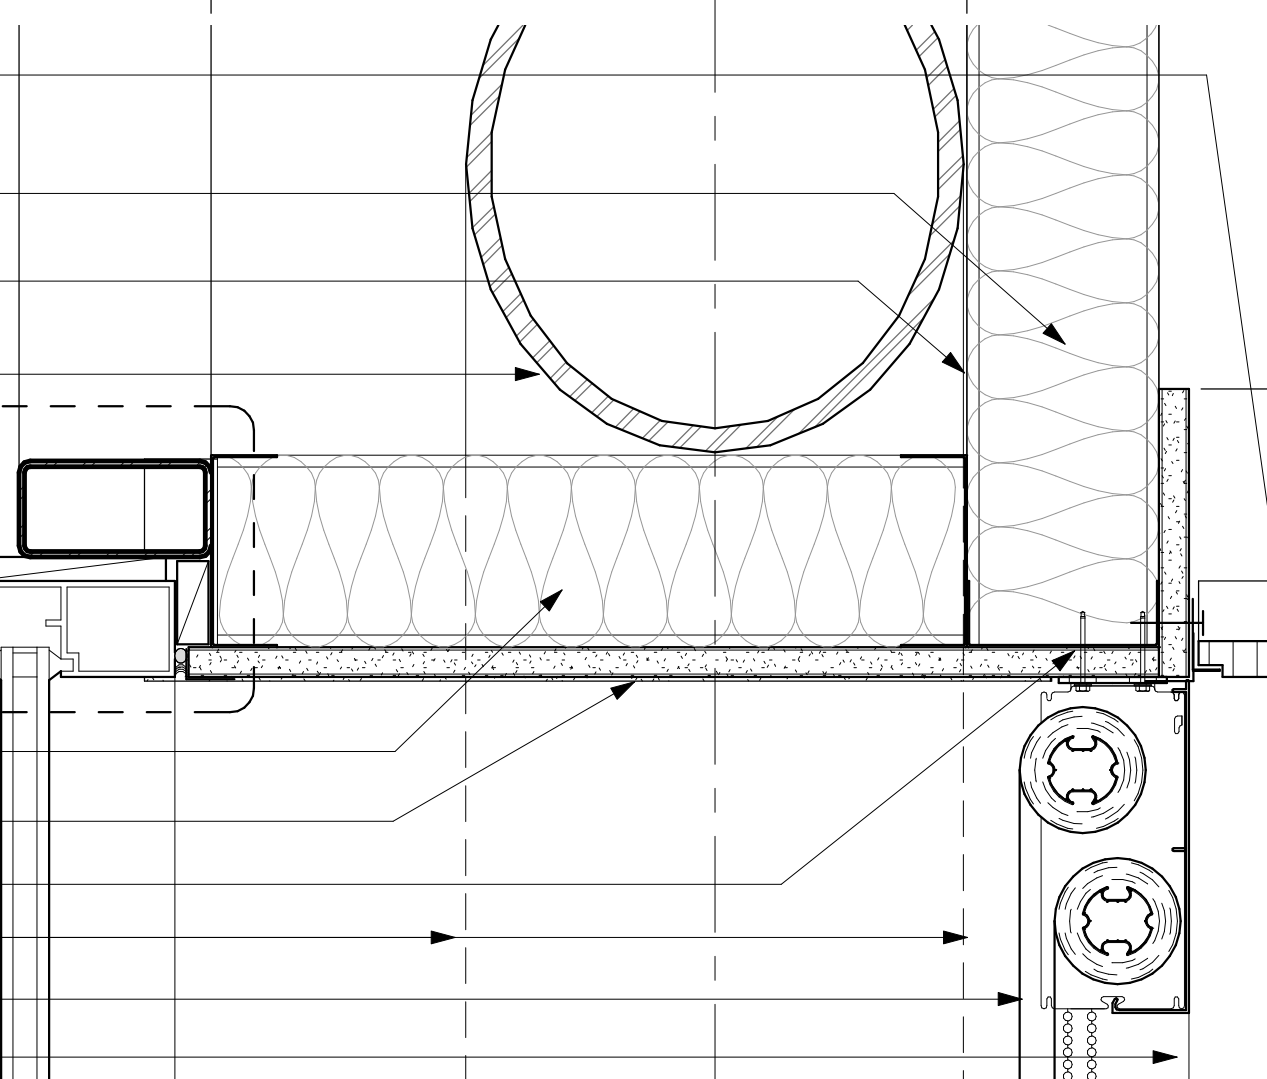


17 LOUVER HEAD/SILL
3" = 1'-0"

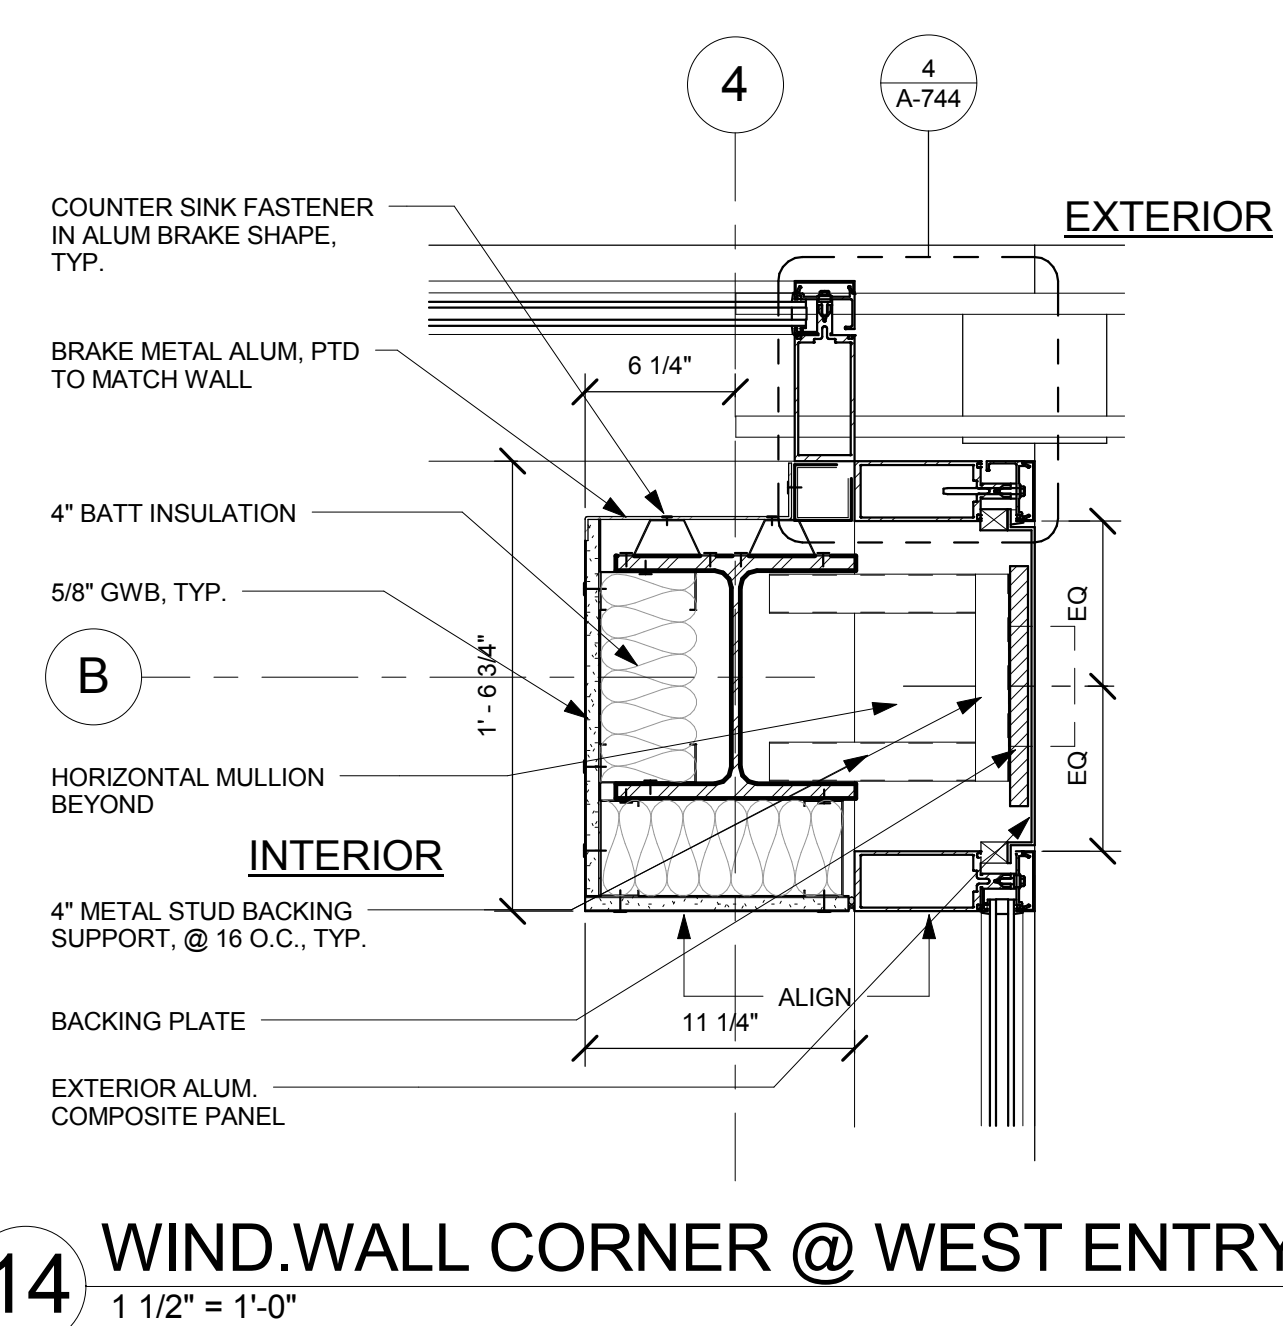



14 WIND.WALL CORNER @ WEST ENTRY
1 1/2" = 1'-0"

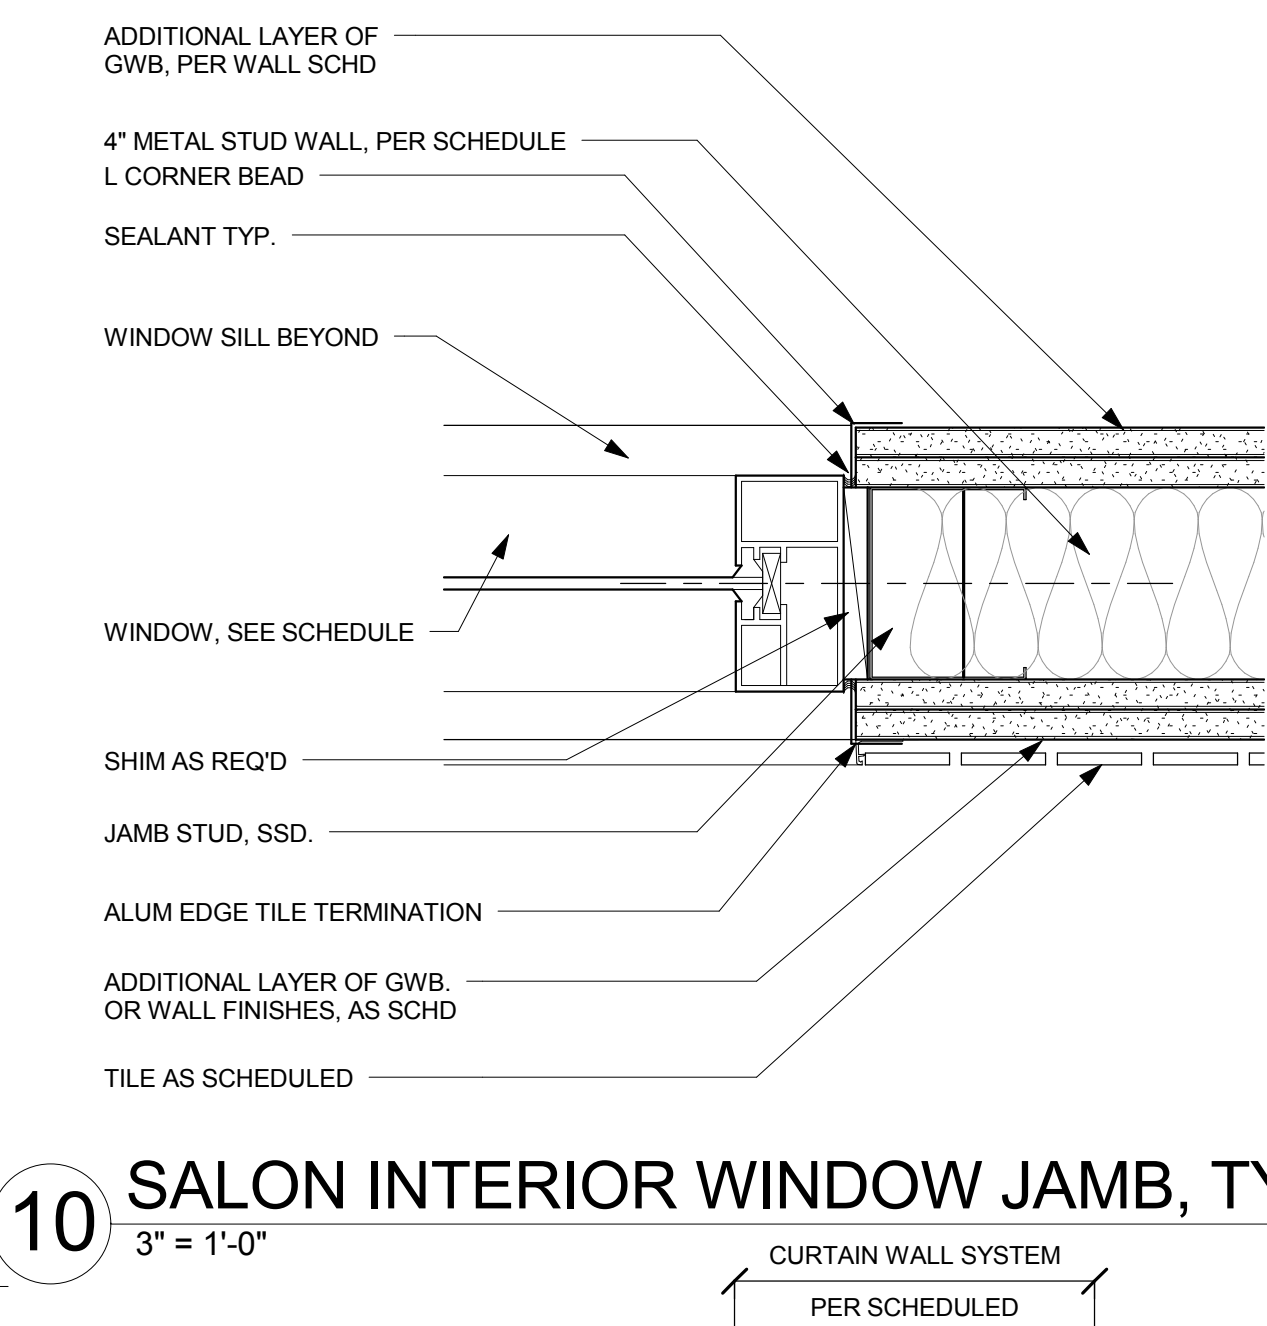


10 SALON INTERIOR WINDOW JAMB, TYP.
3" = 1'-0"

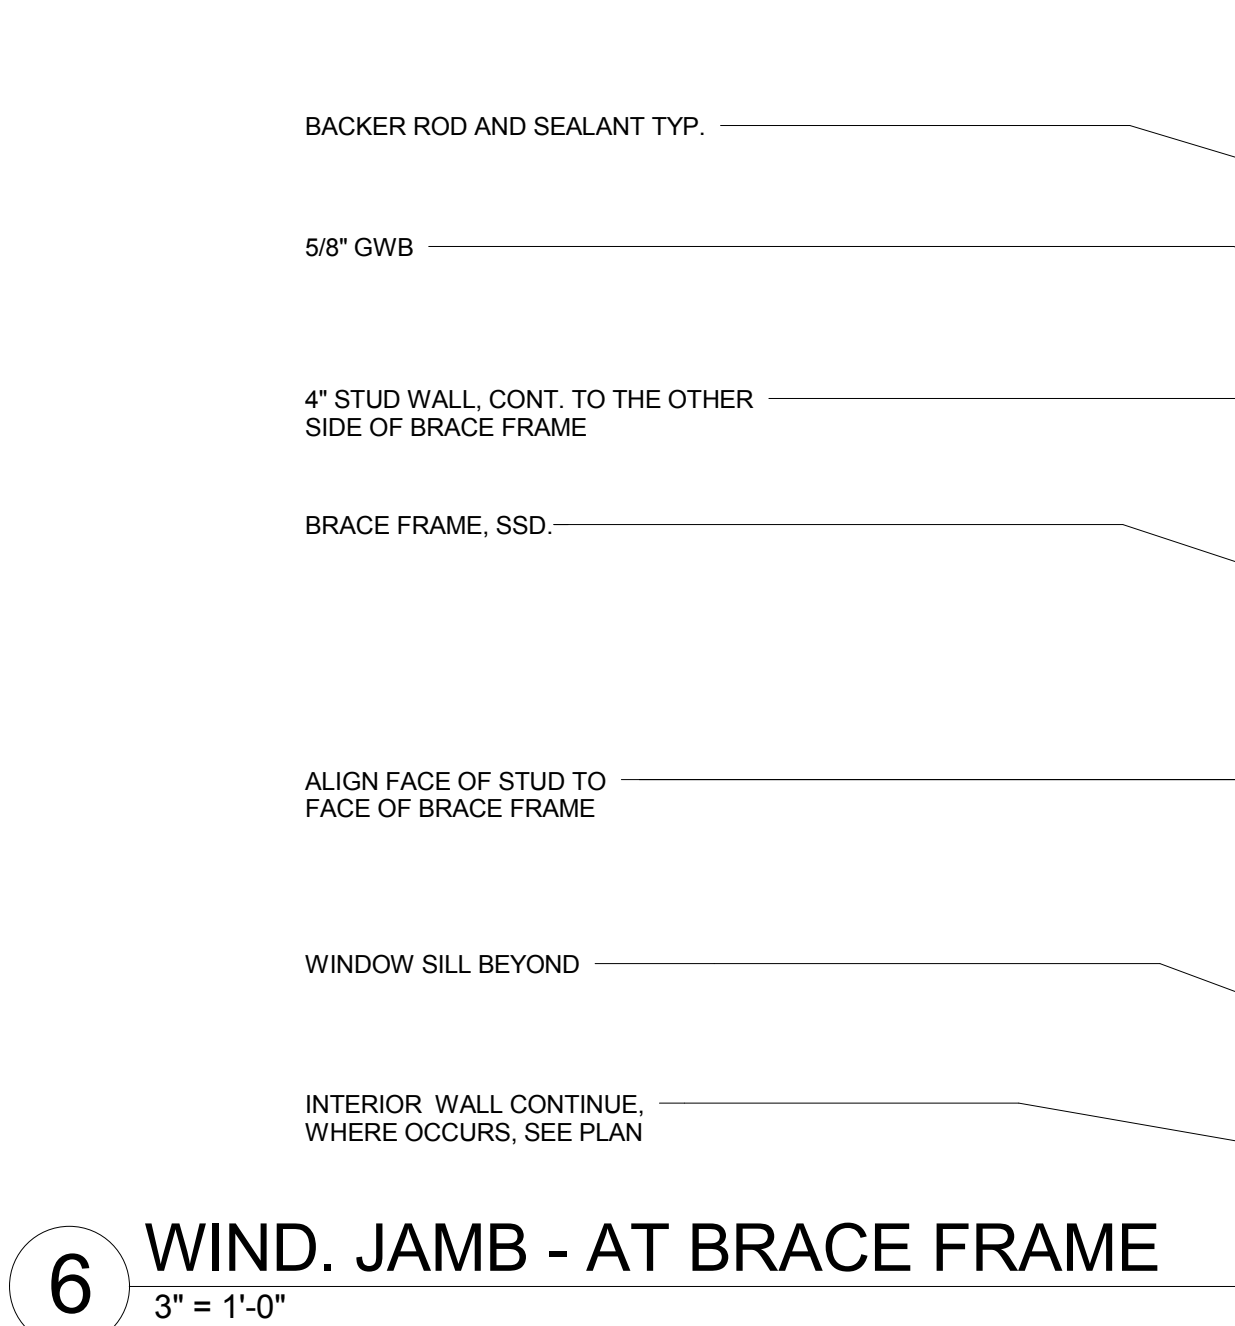


6 WIND. JAMB - AT BRACE FRAME
3" = 1'-0"

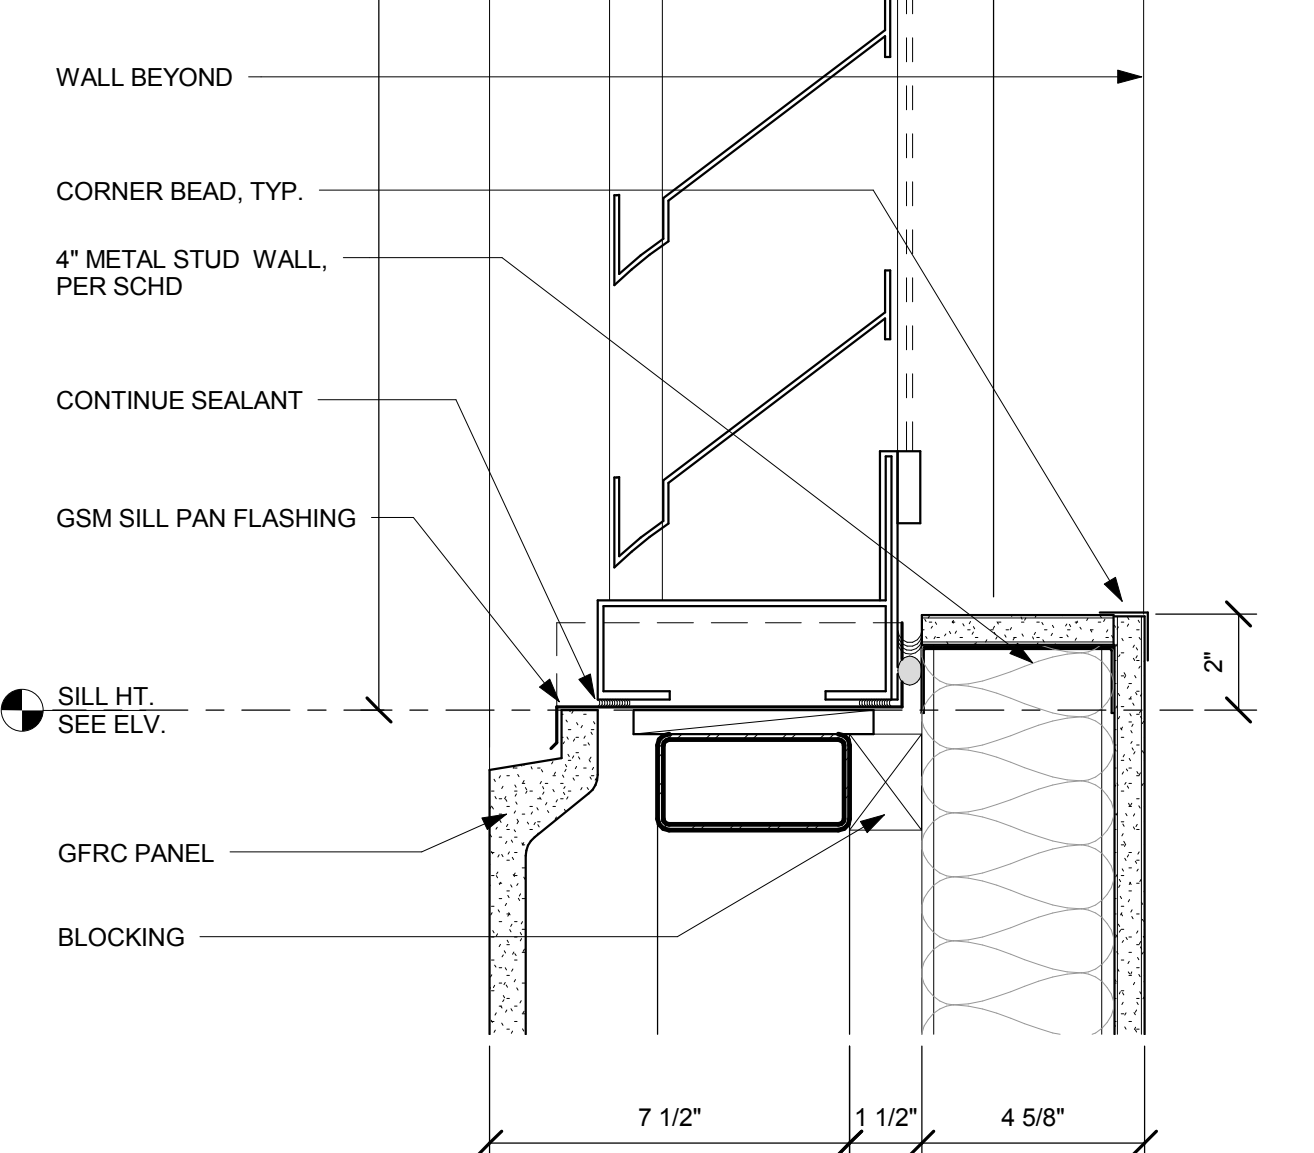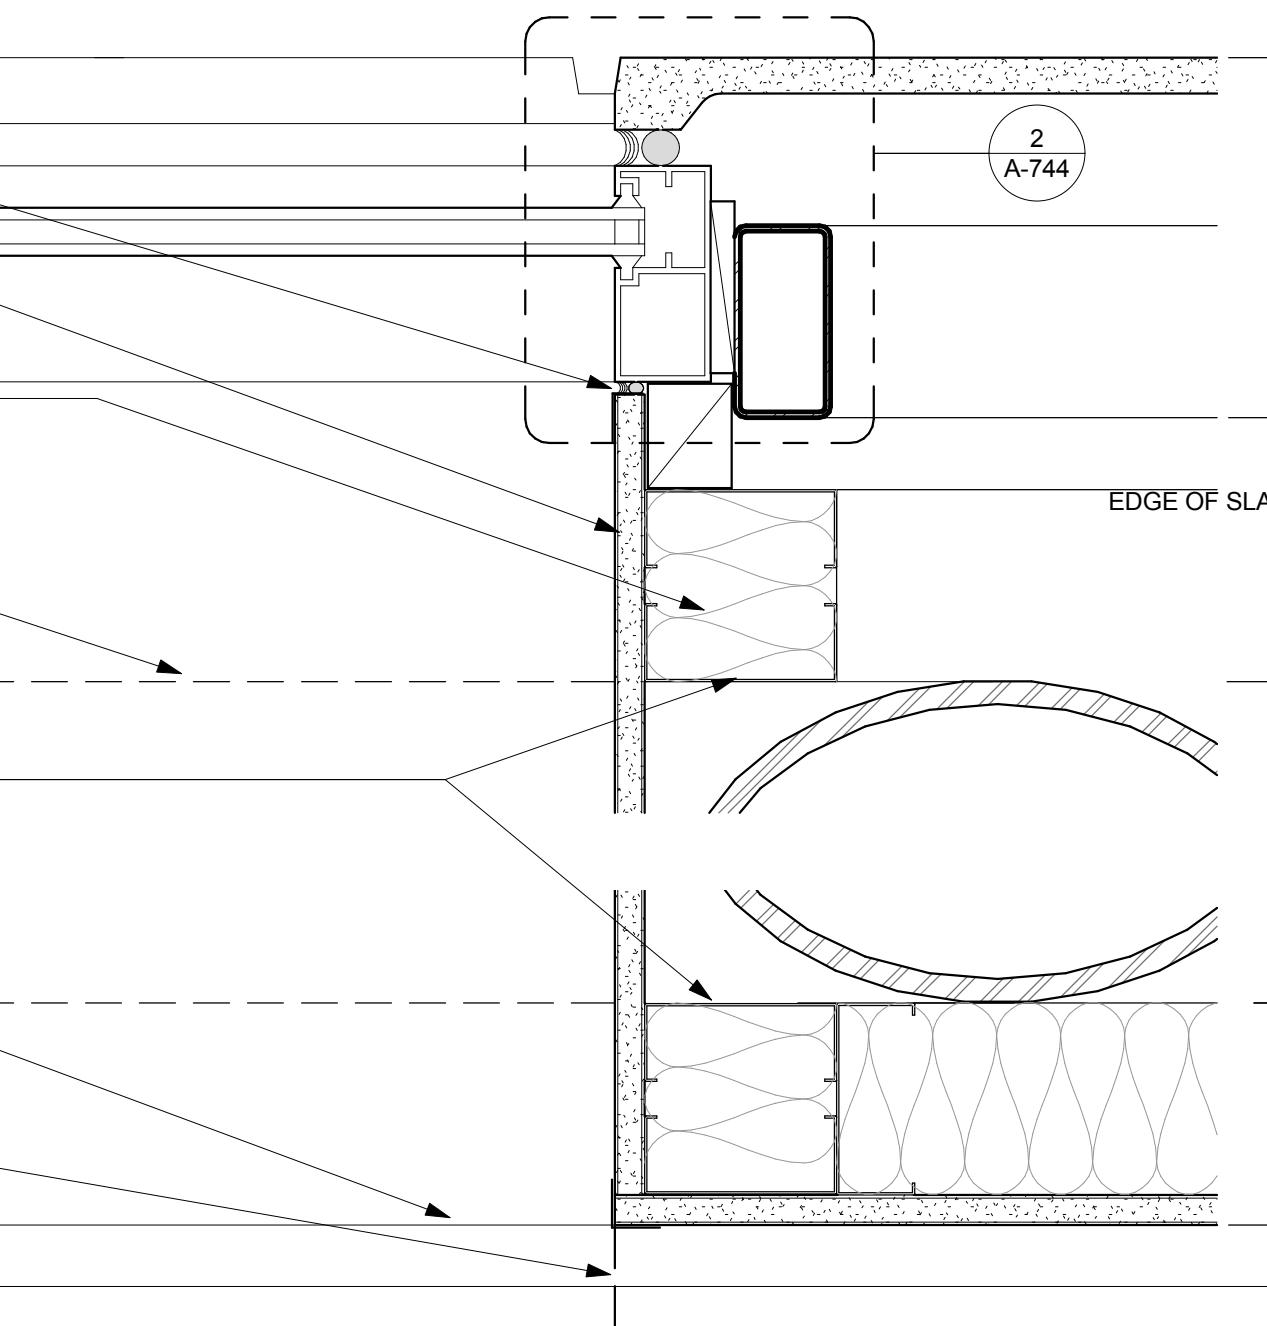


13 STOREFRONT INSIDE CORNER
1 1/2" = 1'-0"

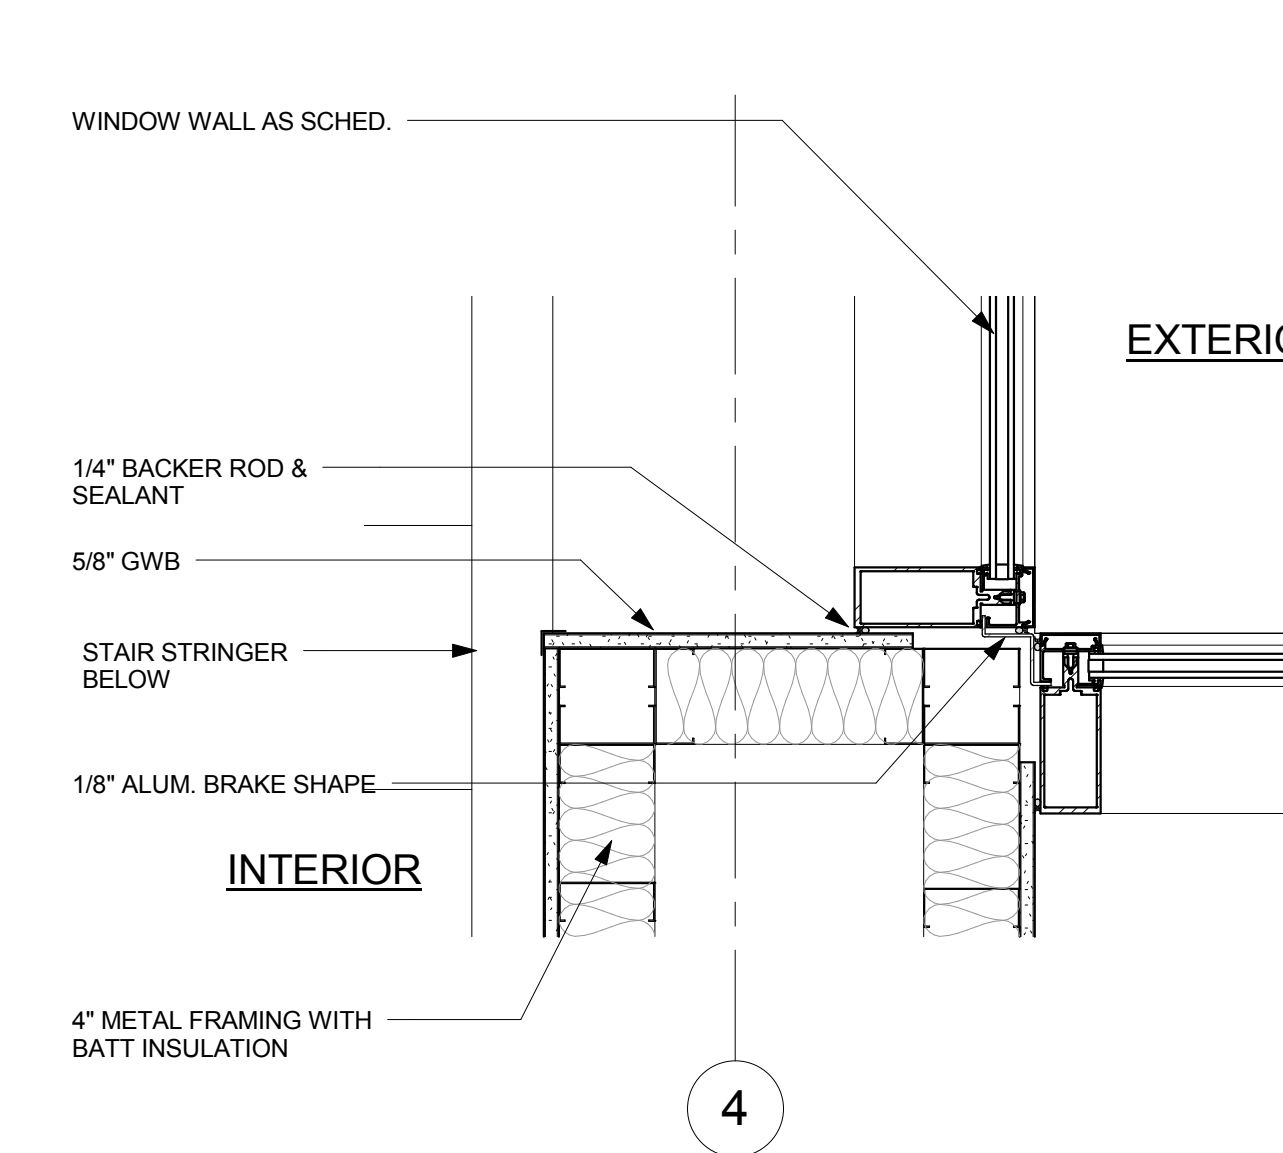


9 INT. STOREFRONT CORNER
3" = 1'-0"

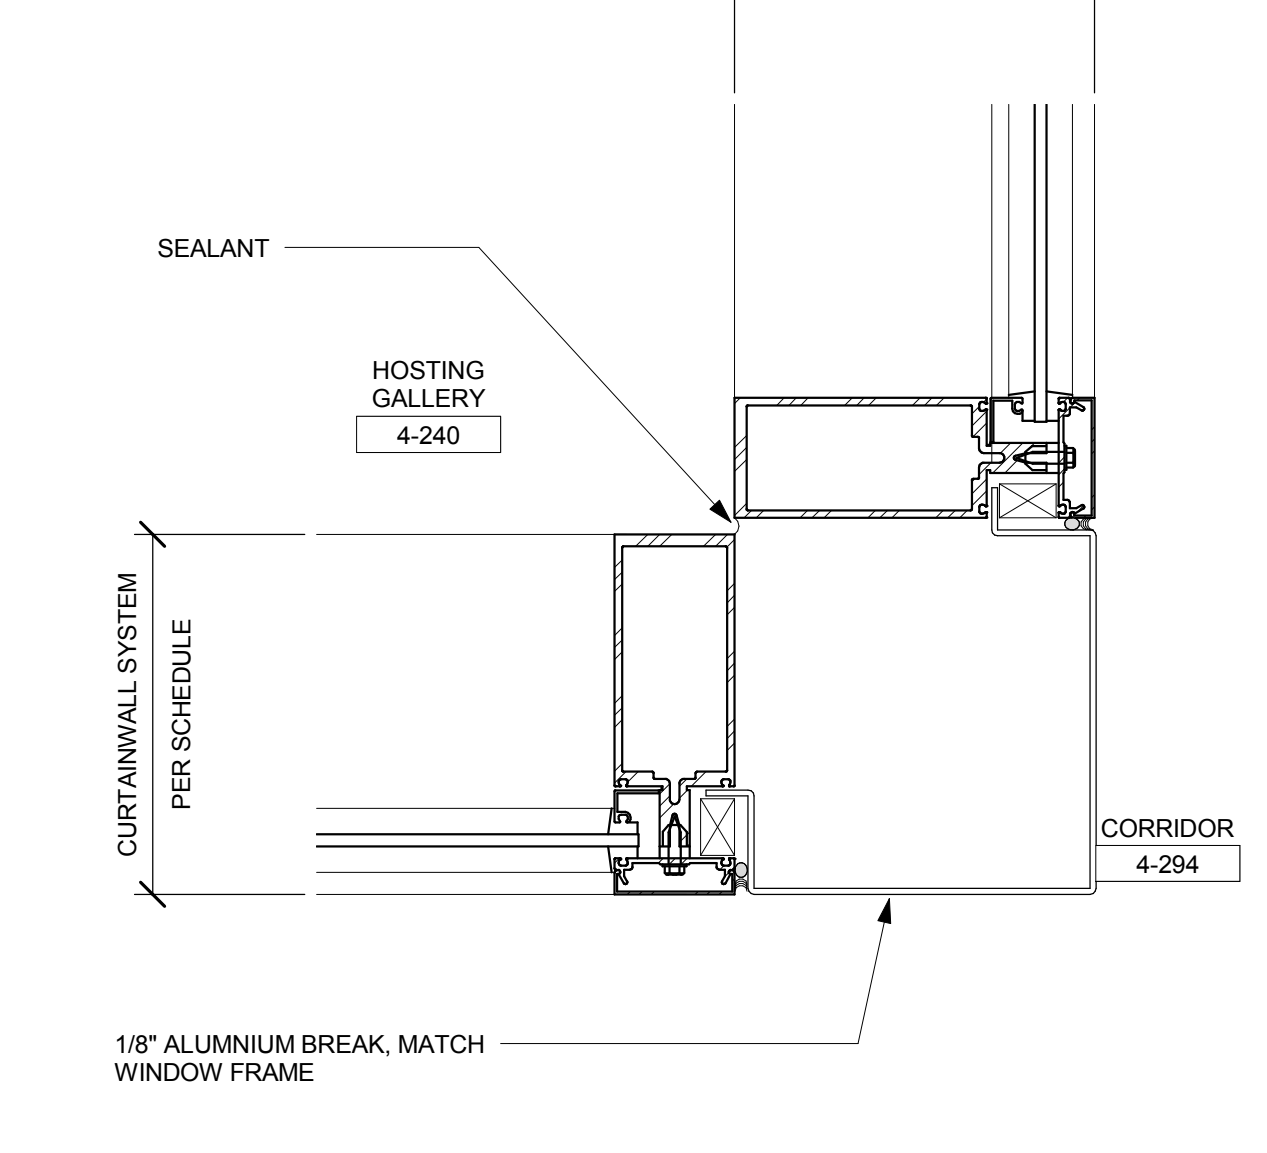

5 WINDOW SILL @ BRACE
3" = 1'-0"

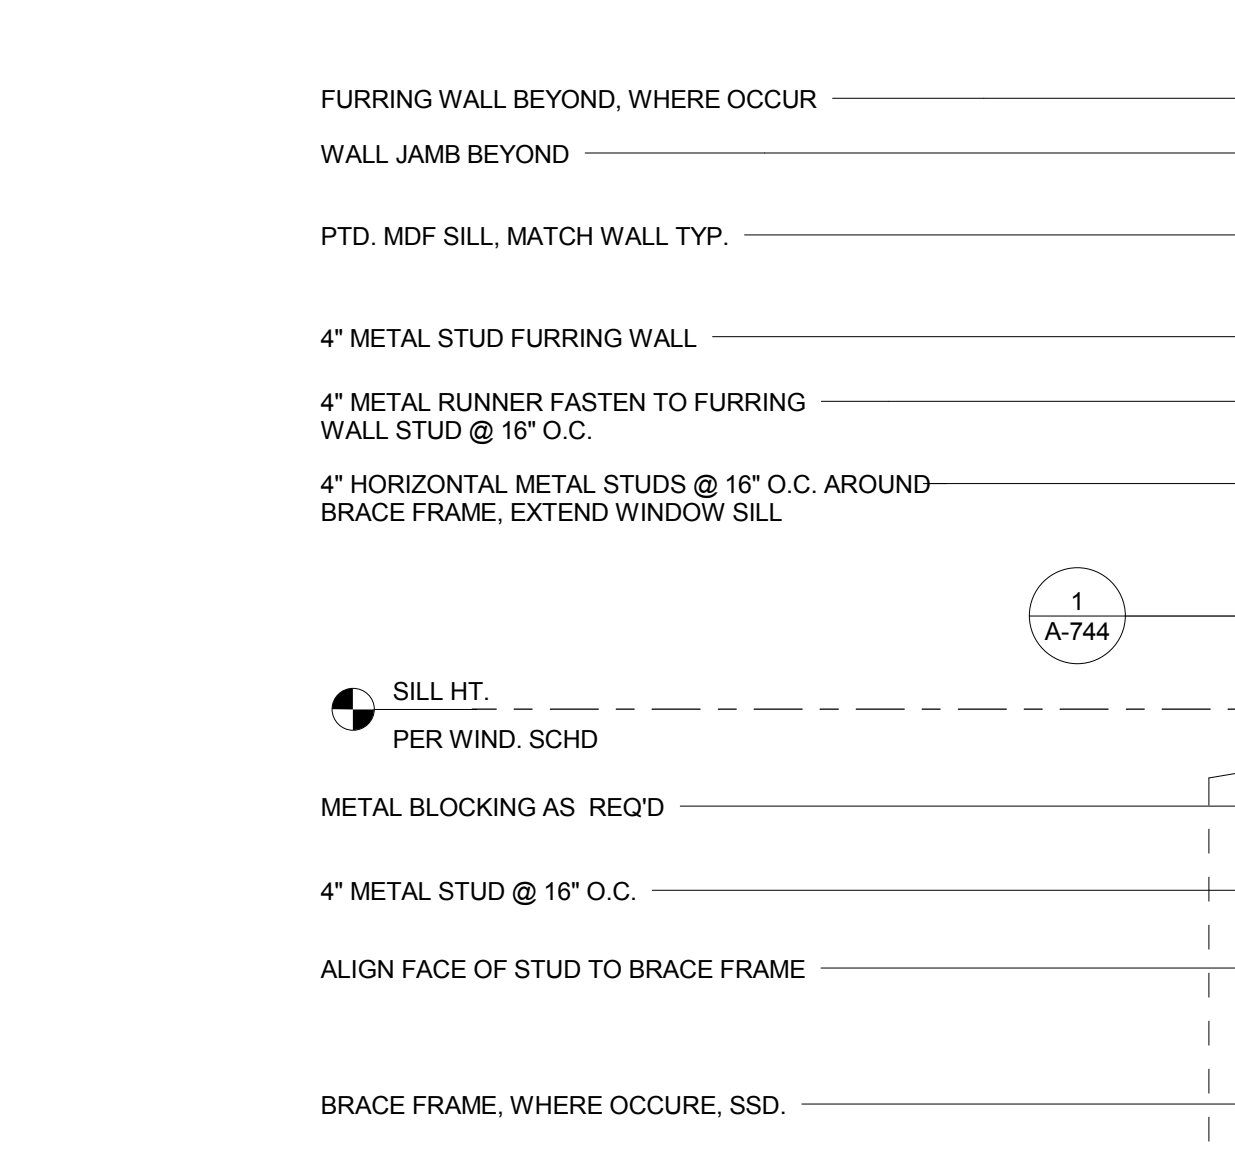

1 WINDOW SILL @ BRACE
3" = 1'-0"

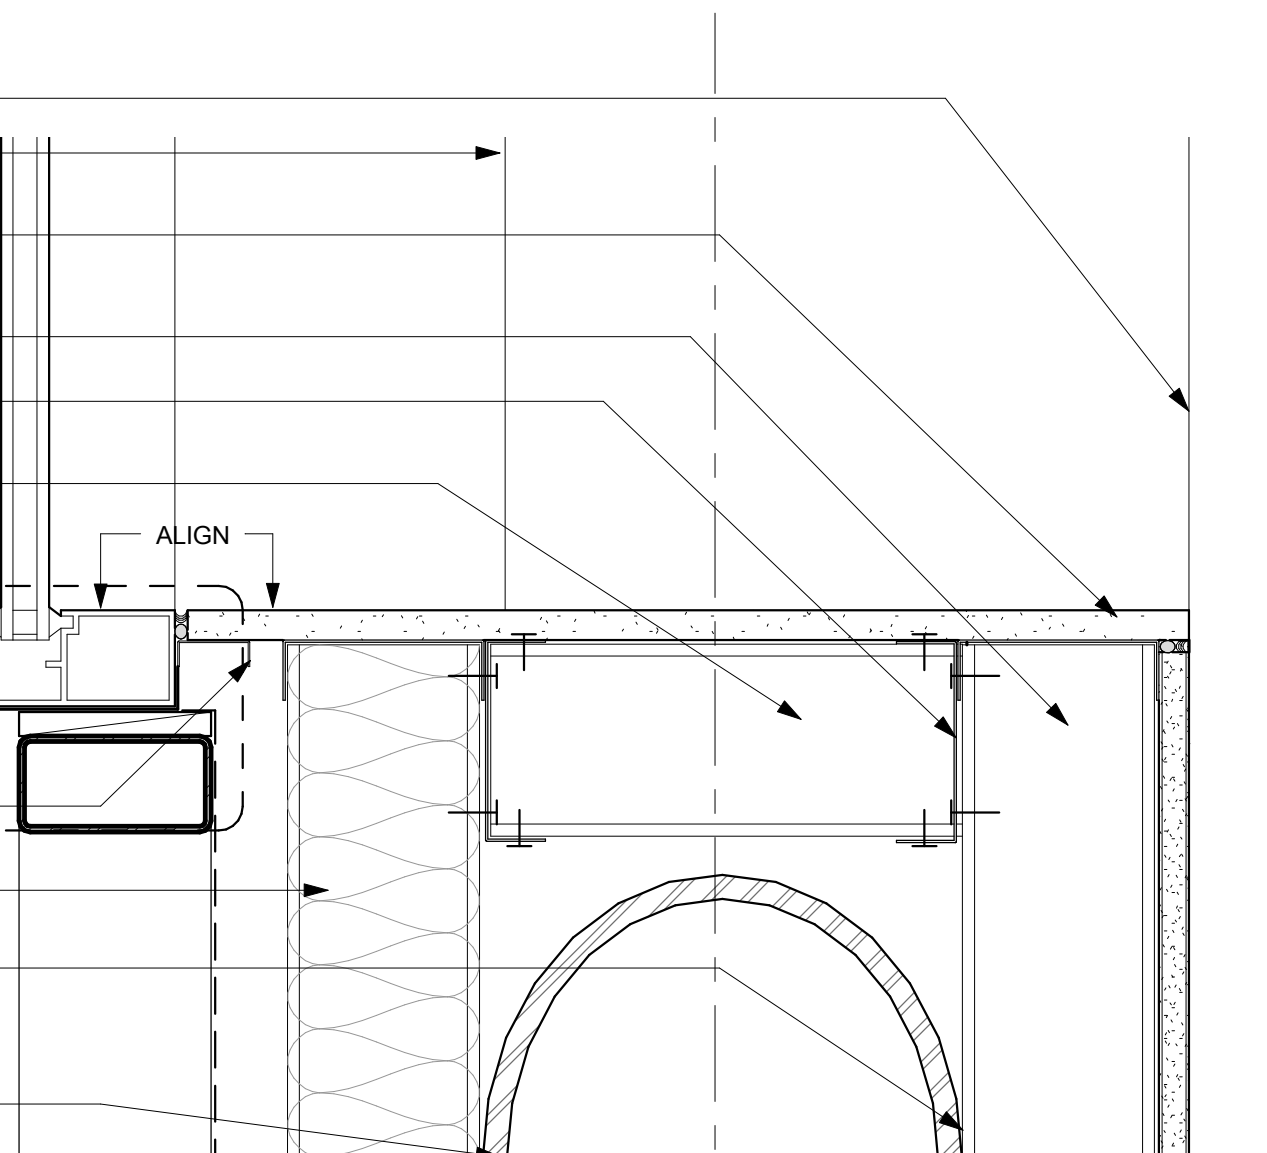

1 WINDOW SILL @ BRACE
3" = 1'-0"