




20 TYP. CONCRETE ROOF CURB
3" = 1'-0"

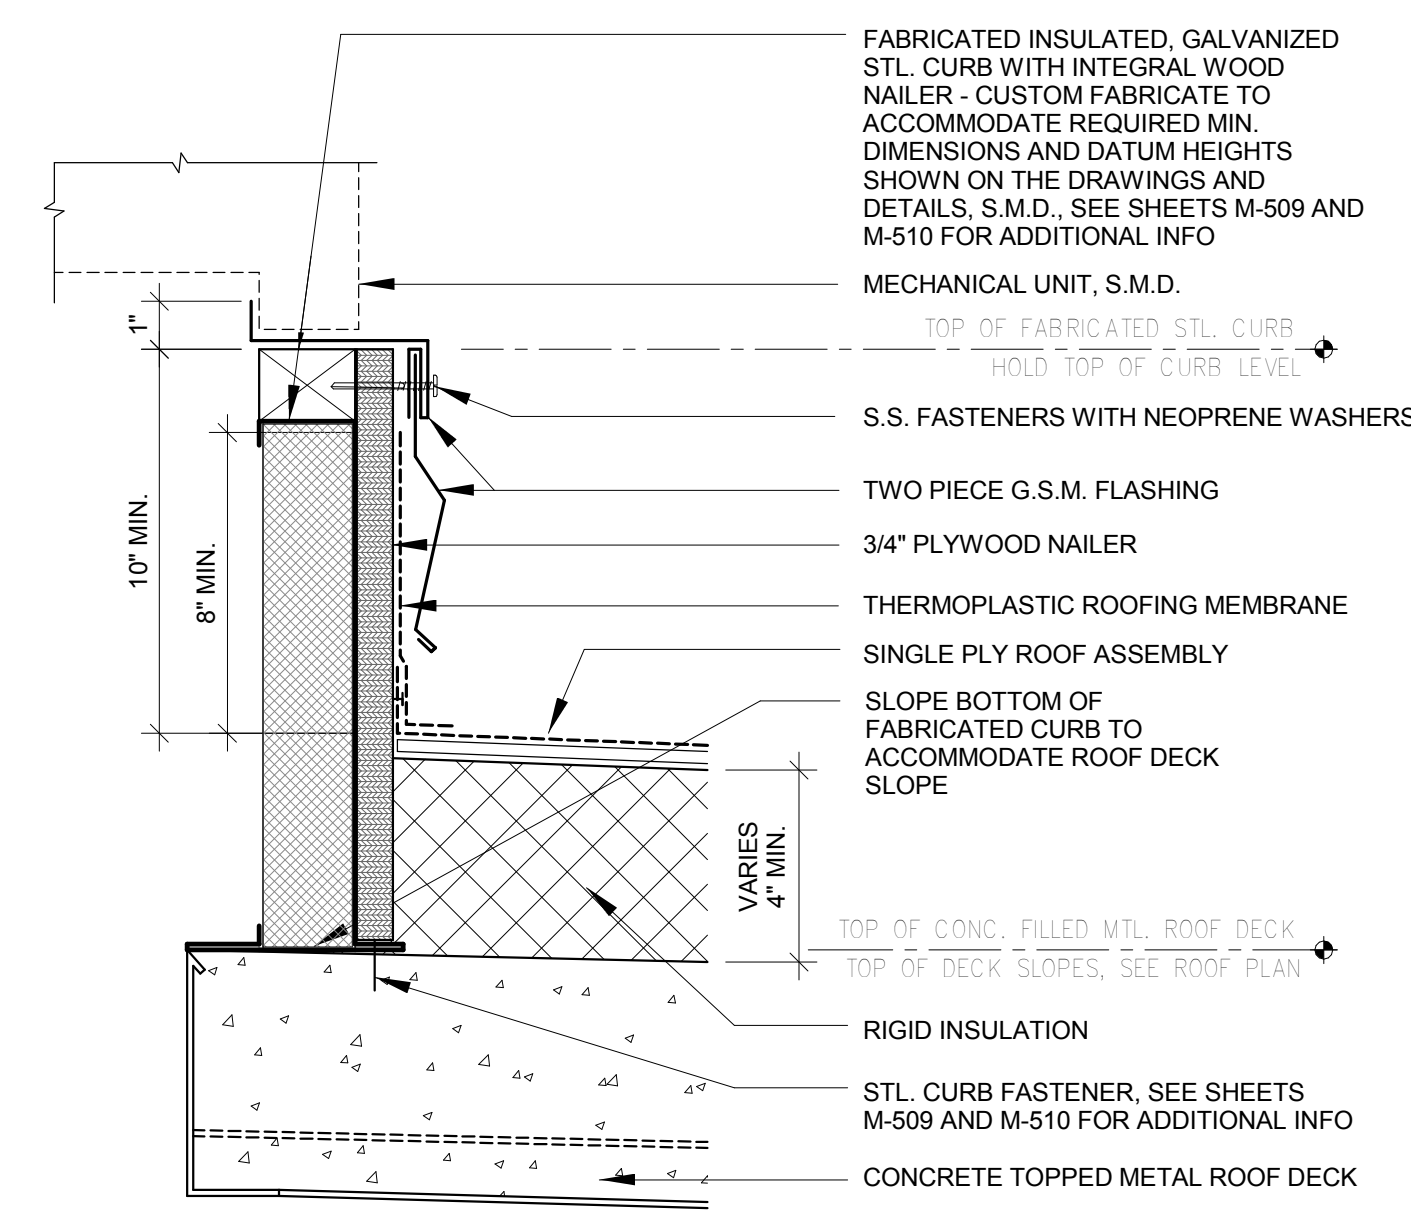


16 TYP. FABRICATED ROOF CURB
3" = 1'-0"

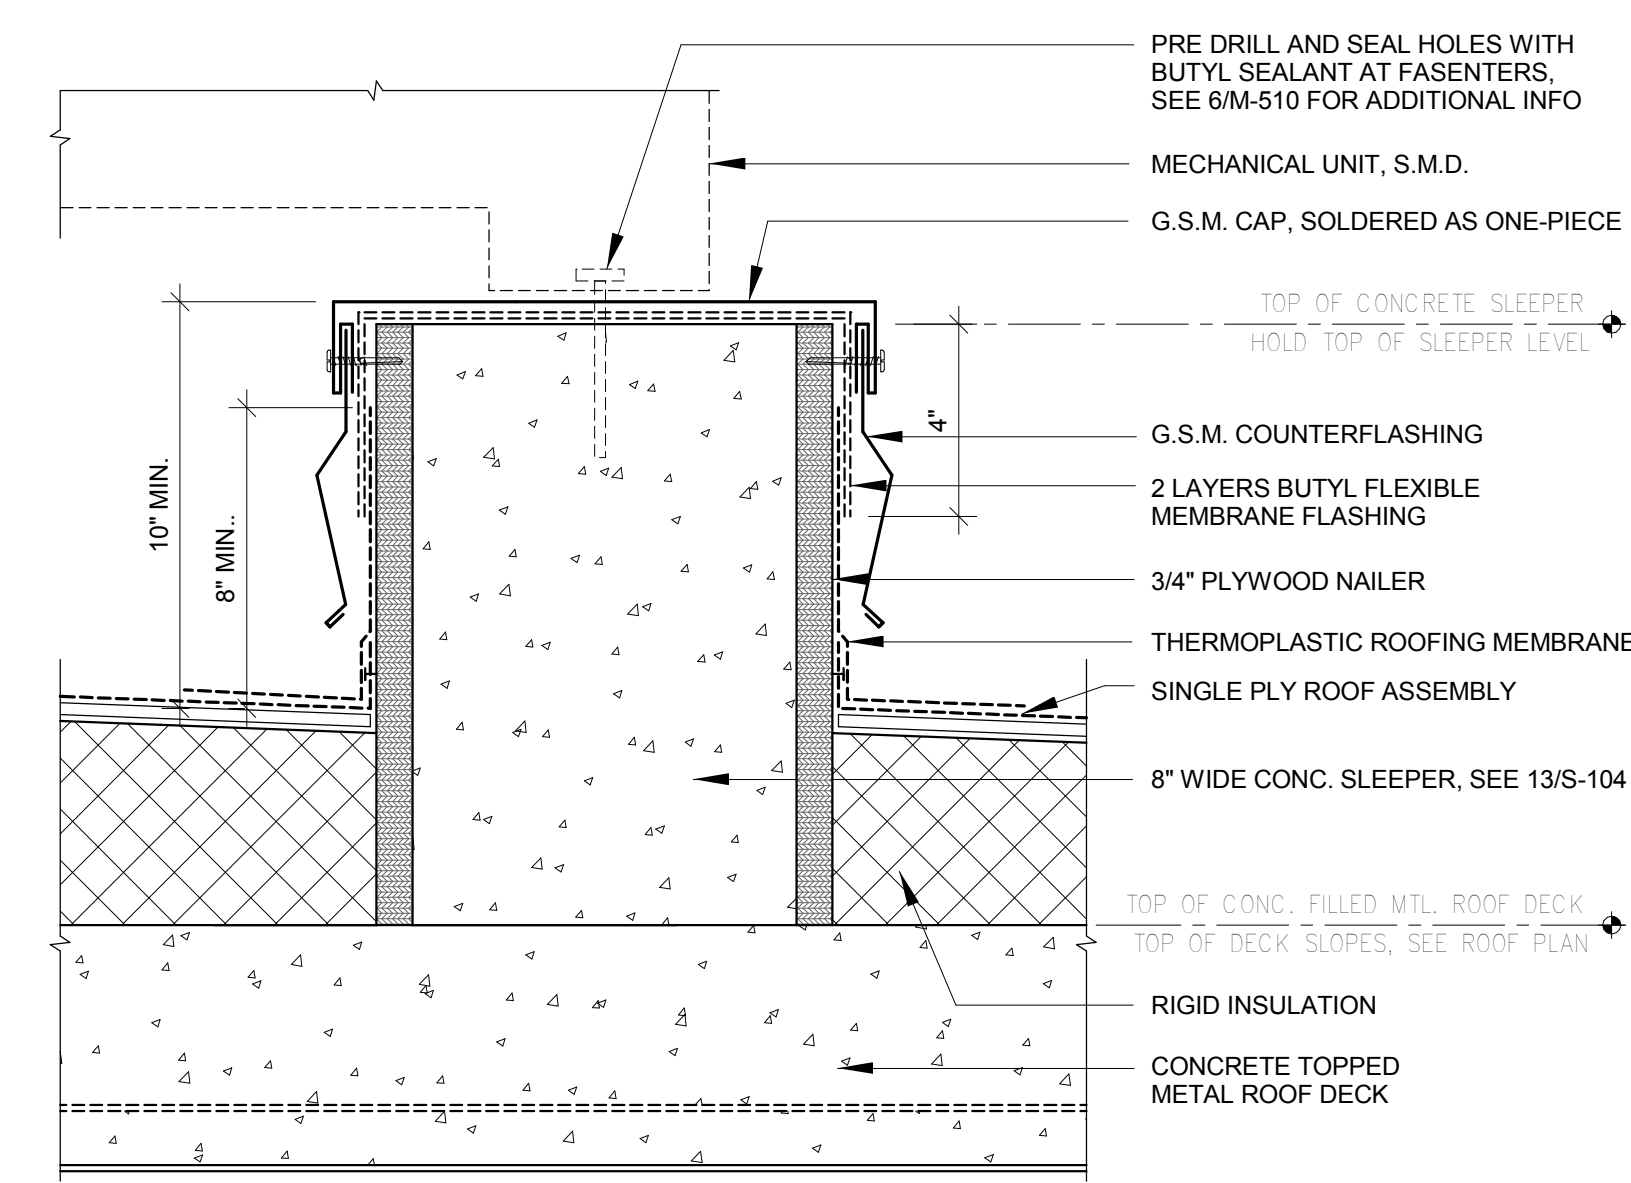


8 TYP. CONCRETE ROOF SLEEPER
3" = 1'-0"

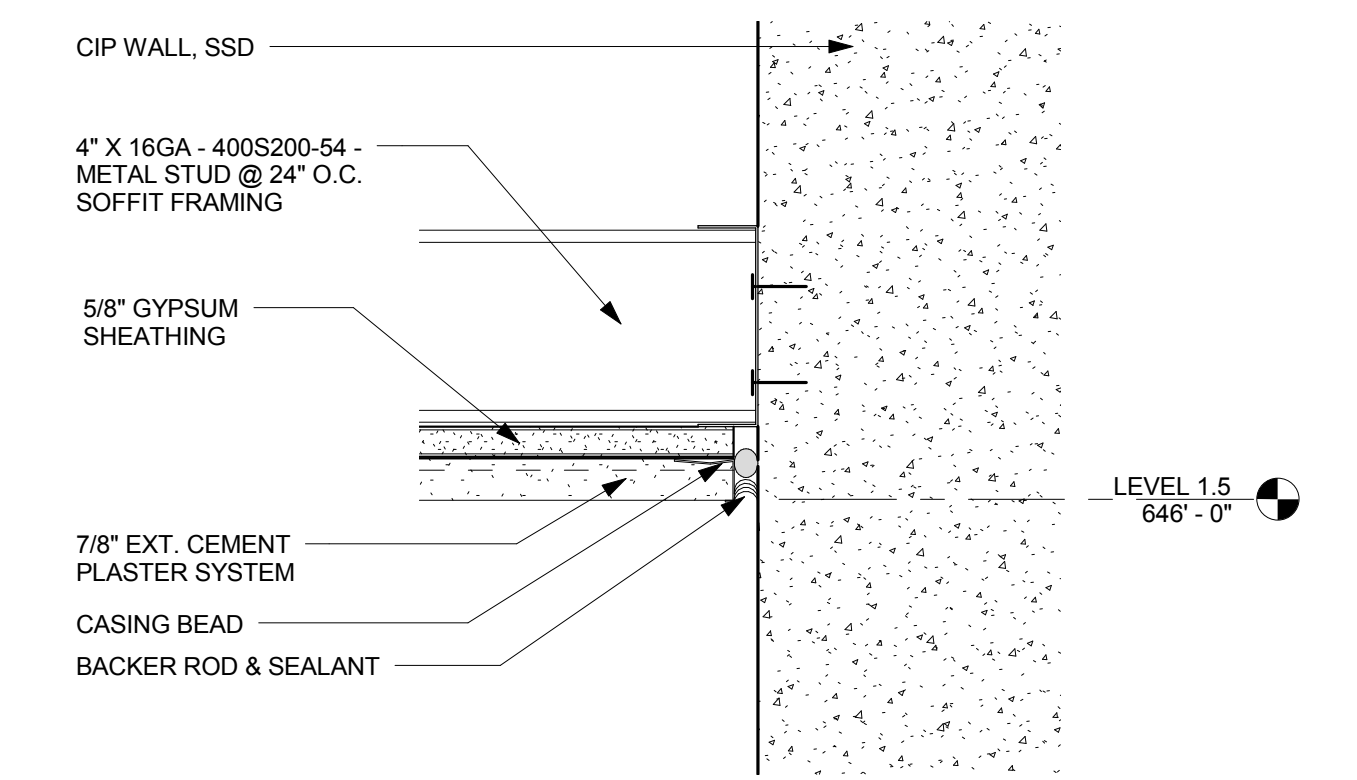


4 SOFFIT AT CIP WALL
3" = 1'-0"

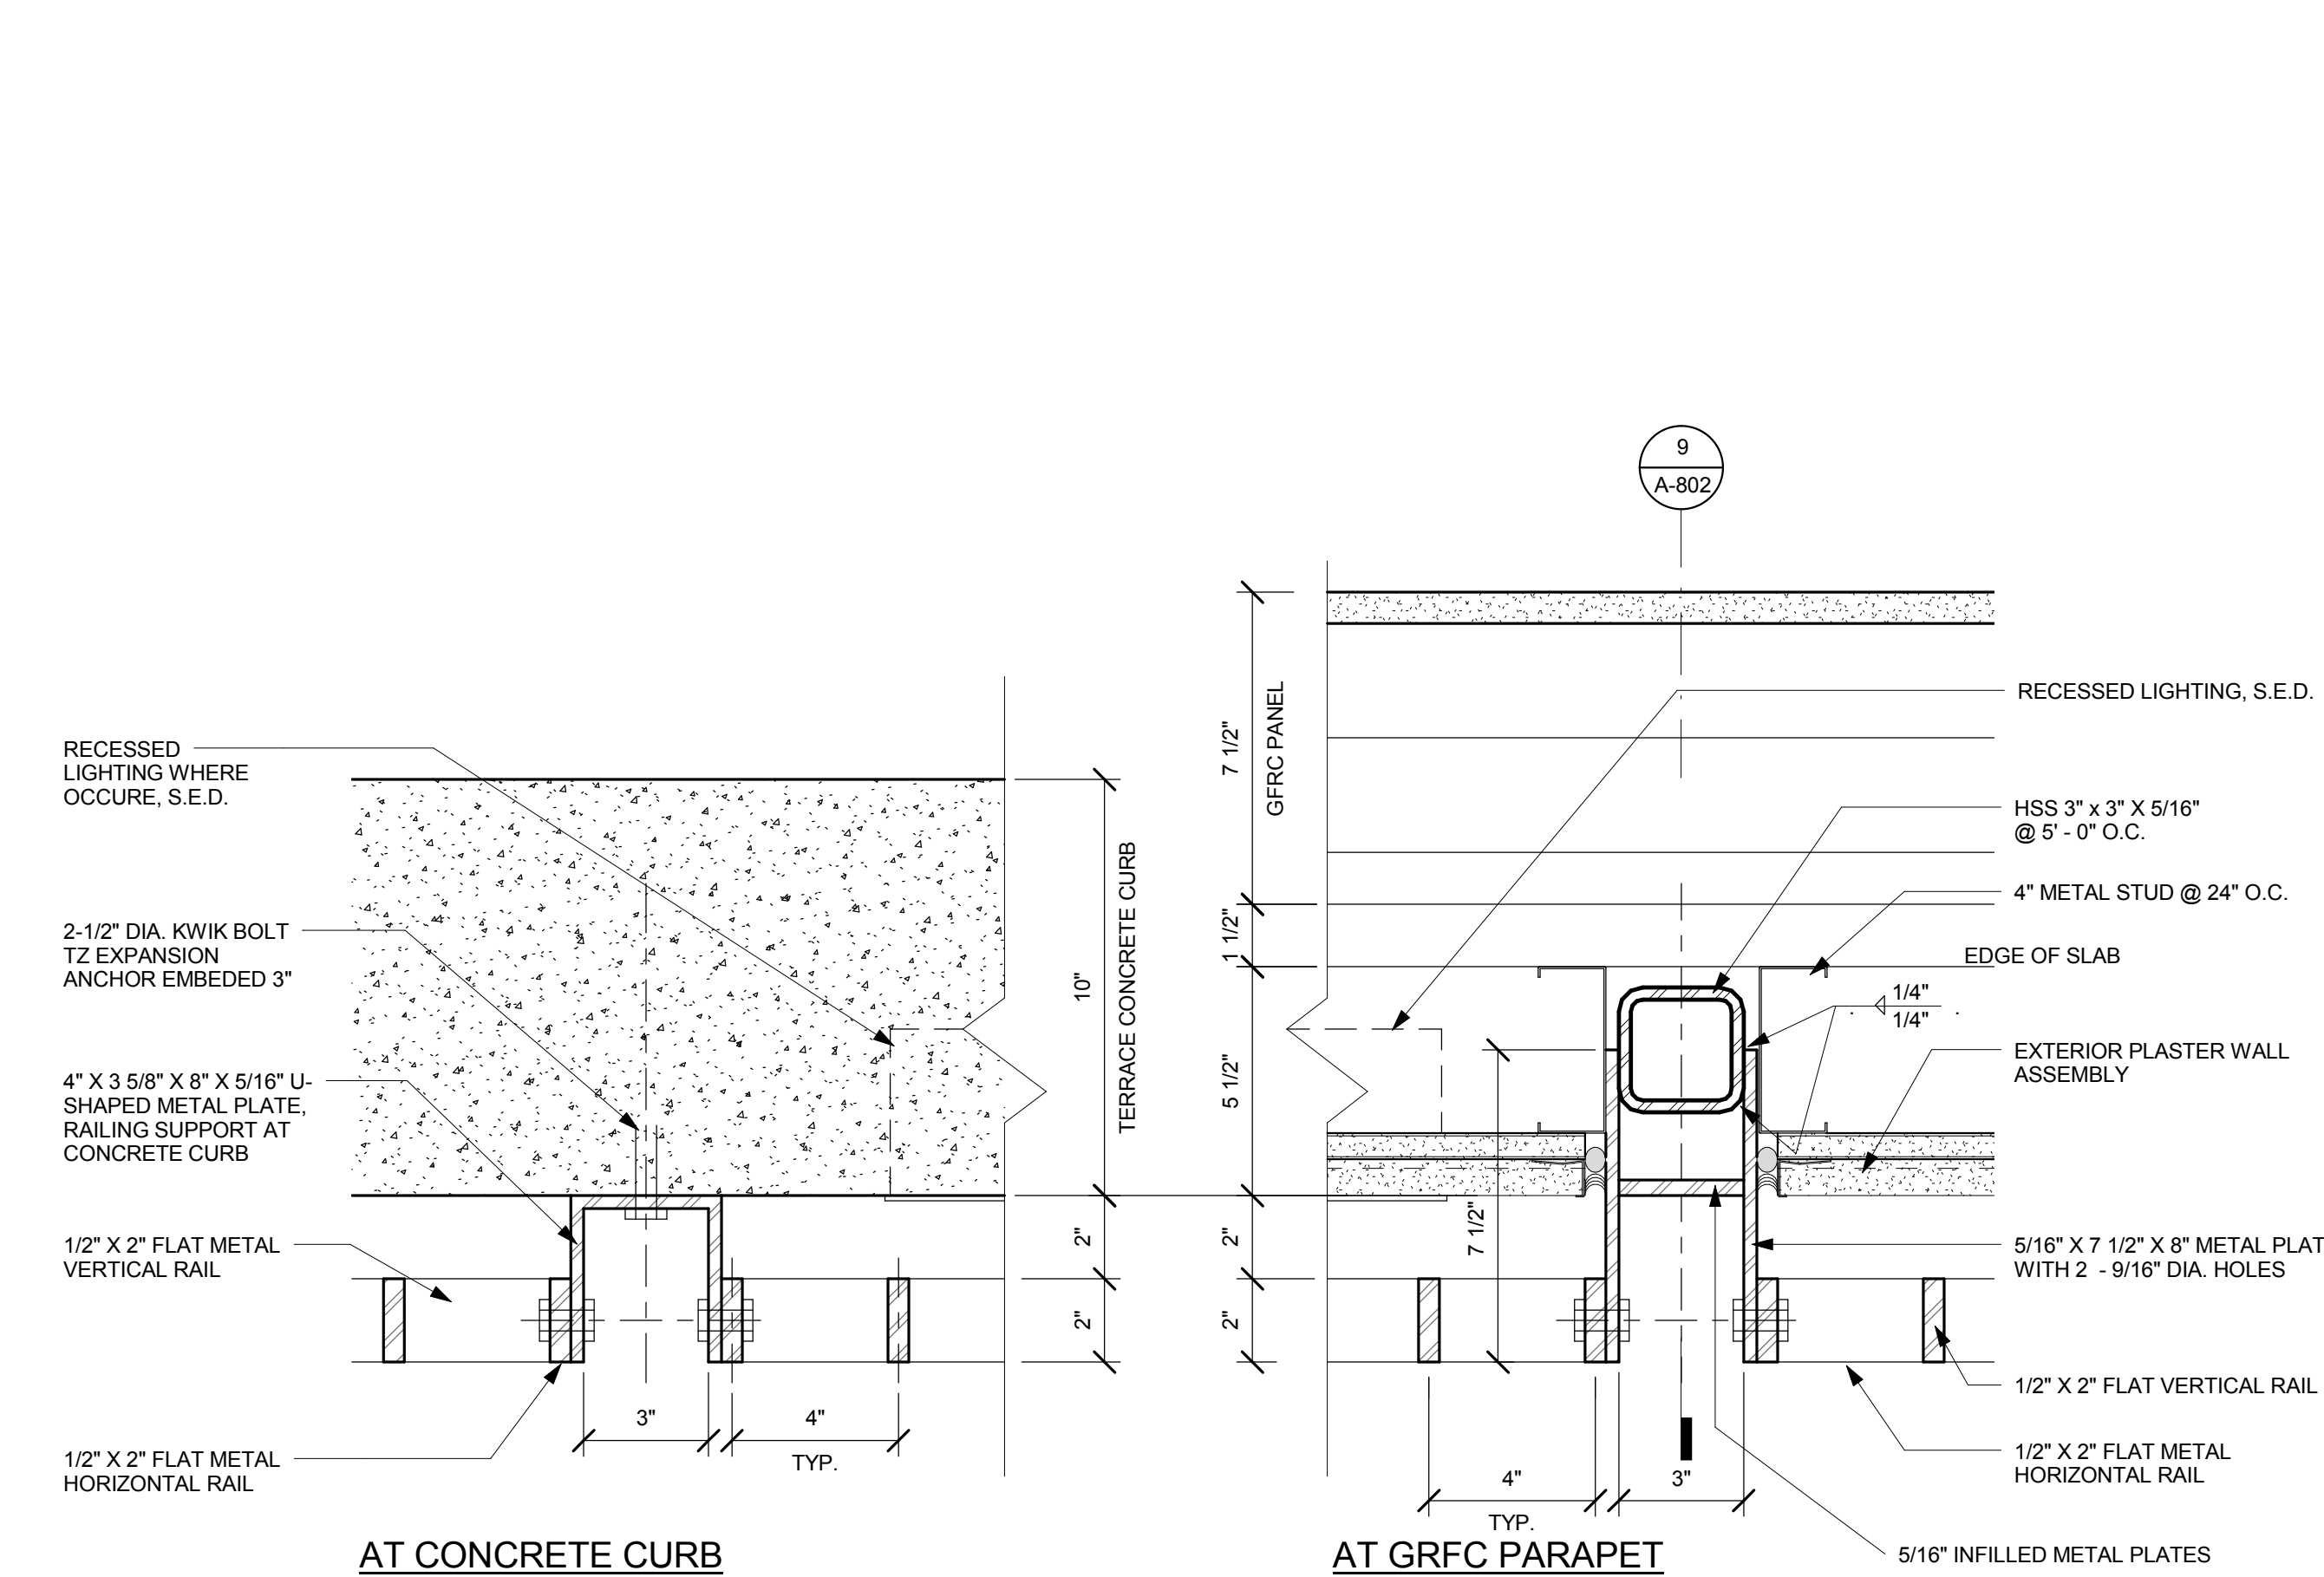


18 TERRACE RAILING - PLAN
3" = 1'-0"

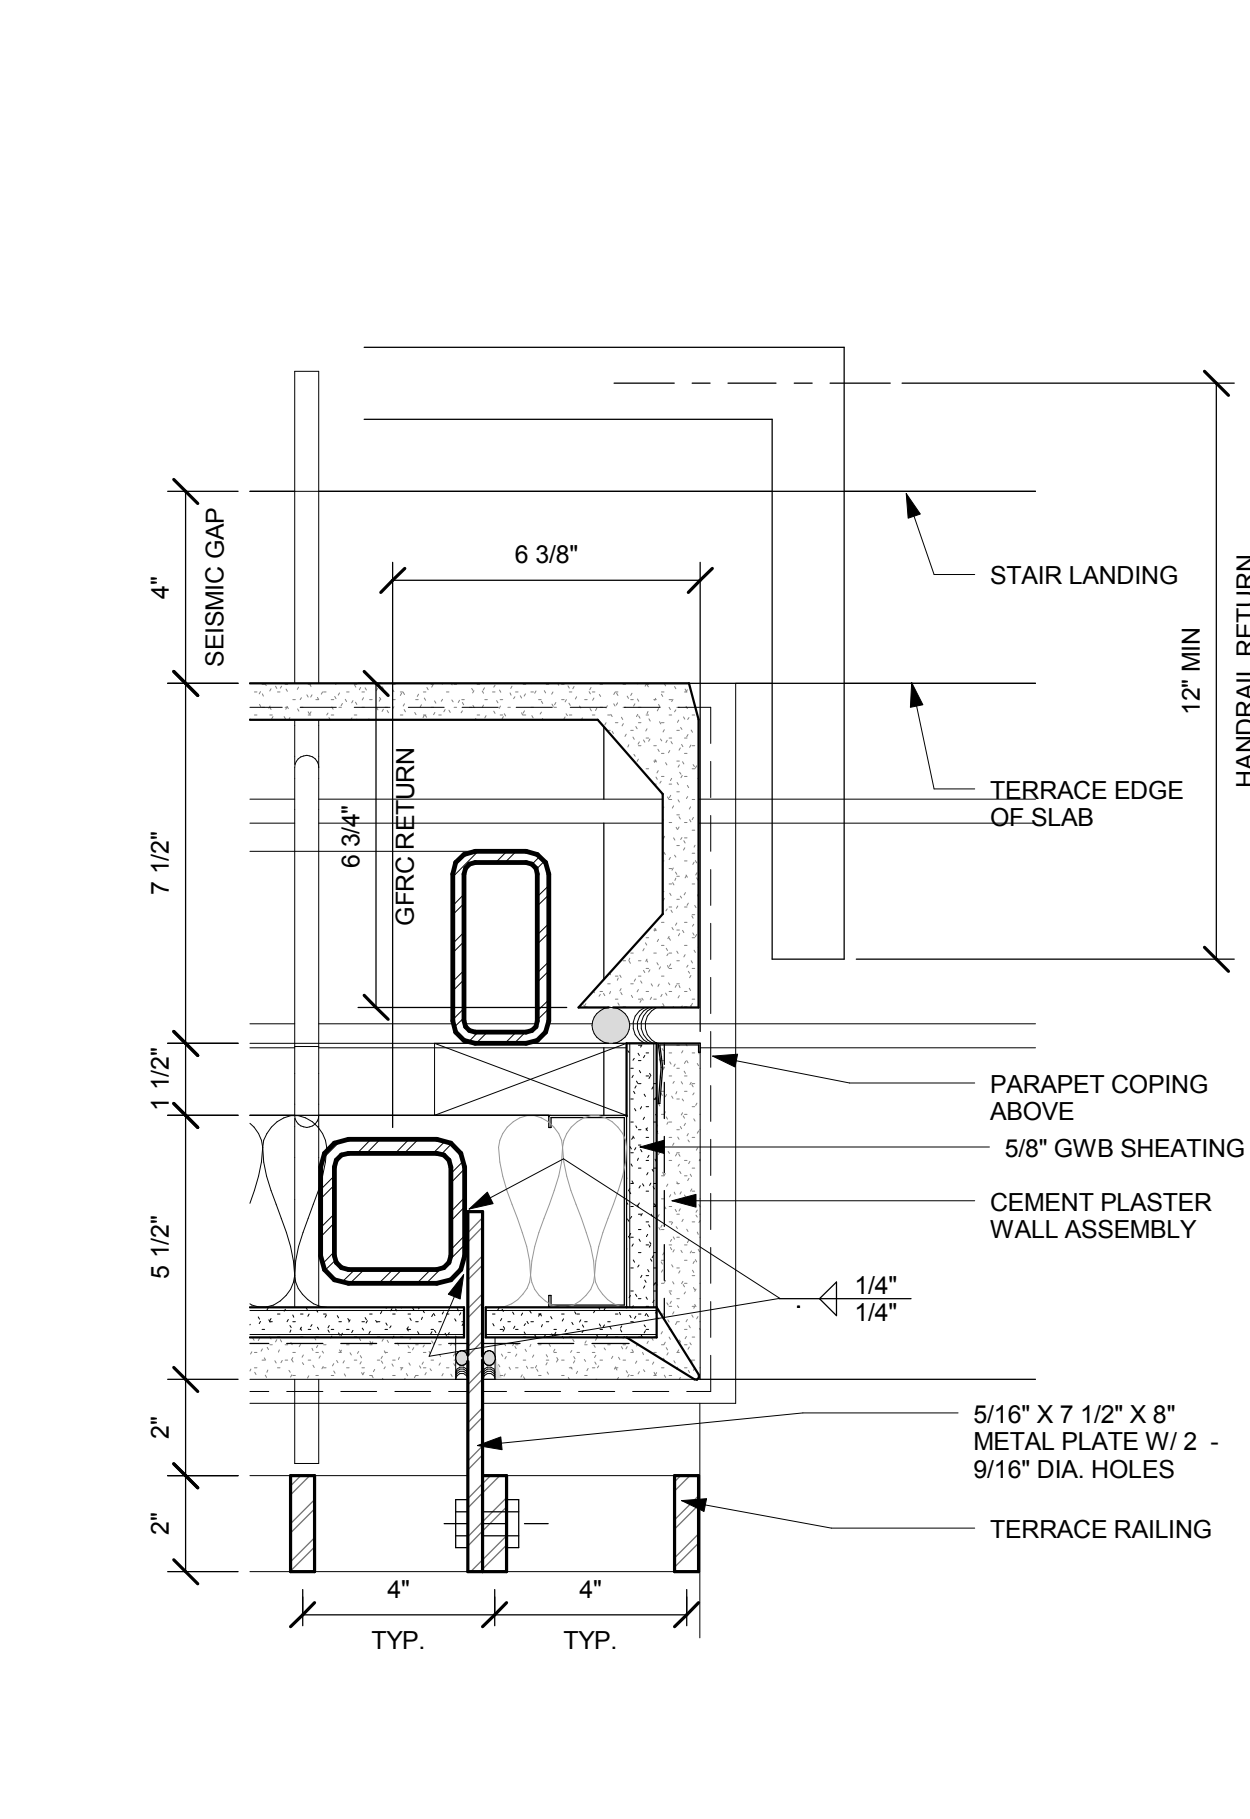


10 PARAPET RAIL END AT TERRACE
3" = 1'-0"

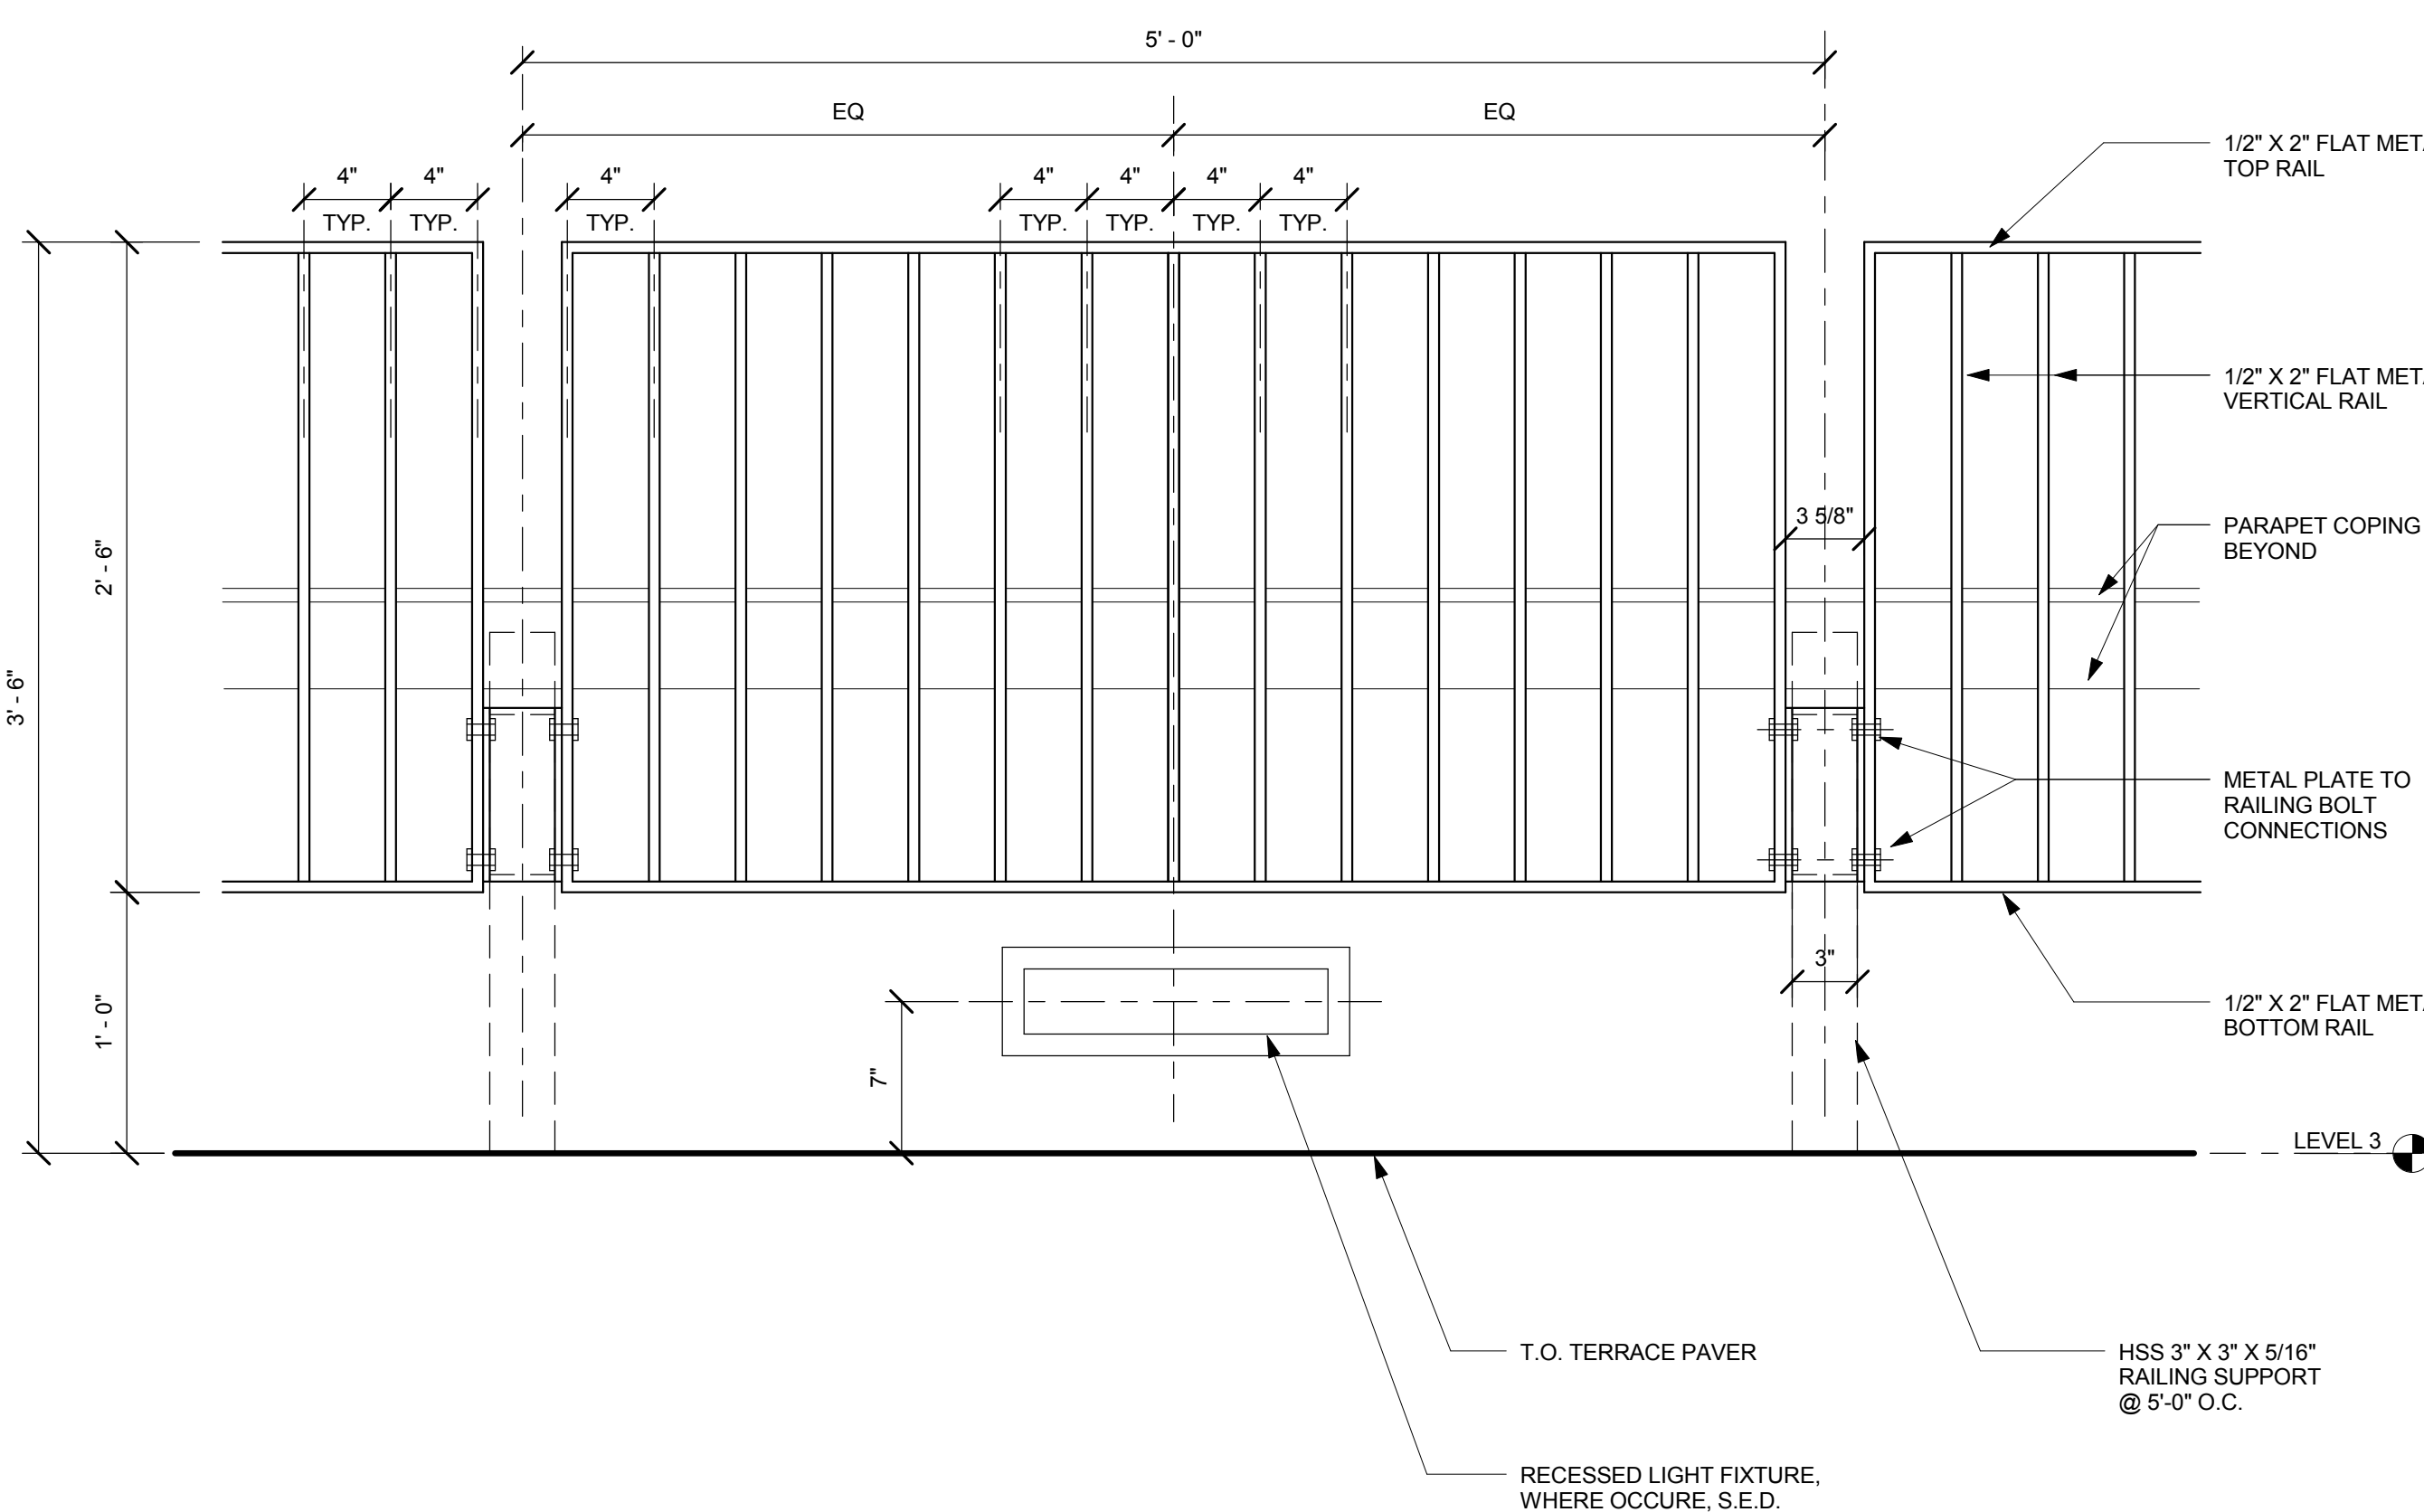


17 TERRACE RAILING - ELEVATION
1 1/2" = 1'-0"

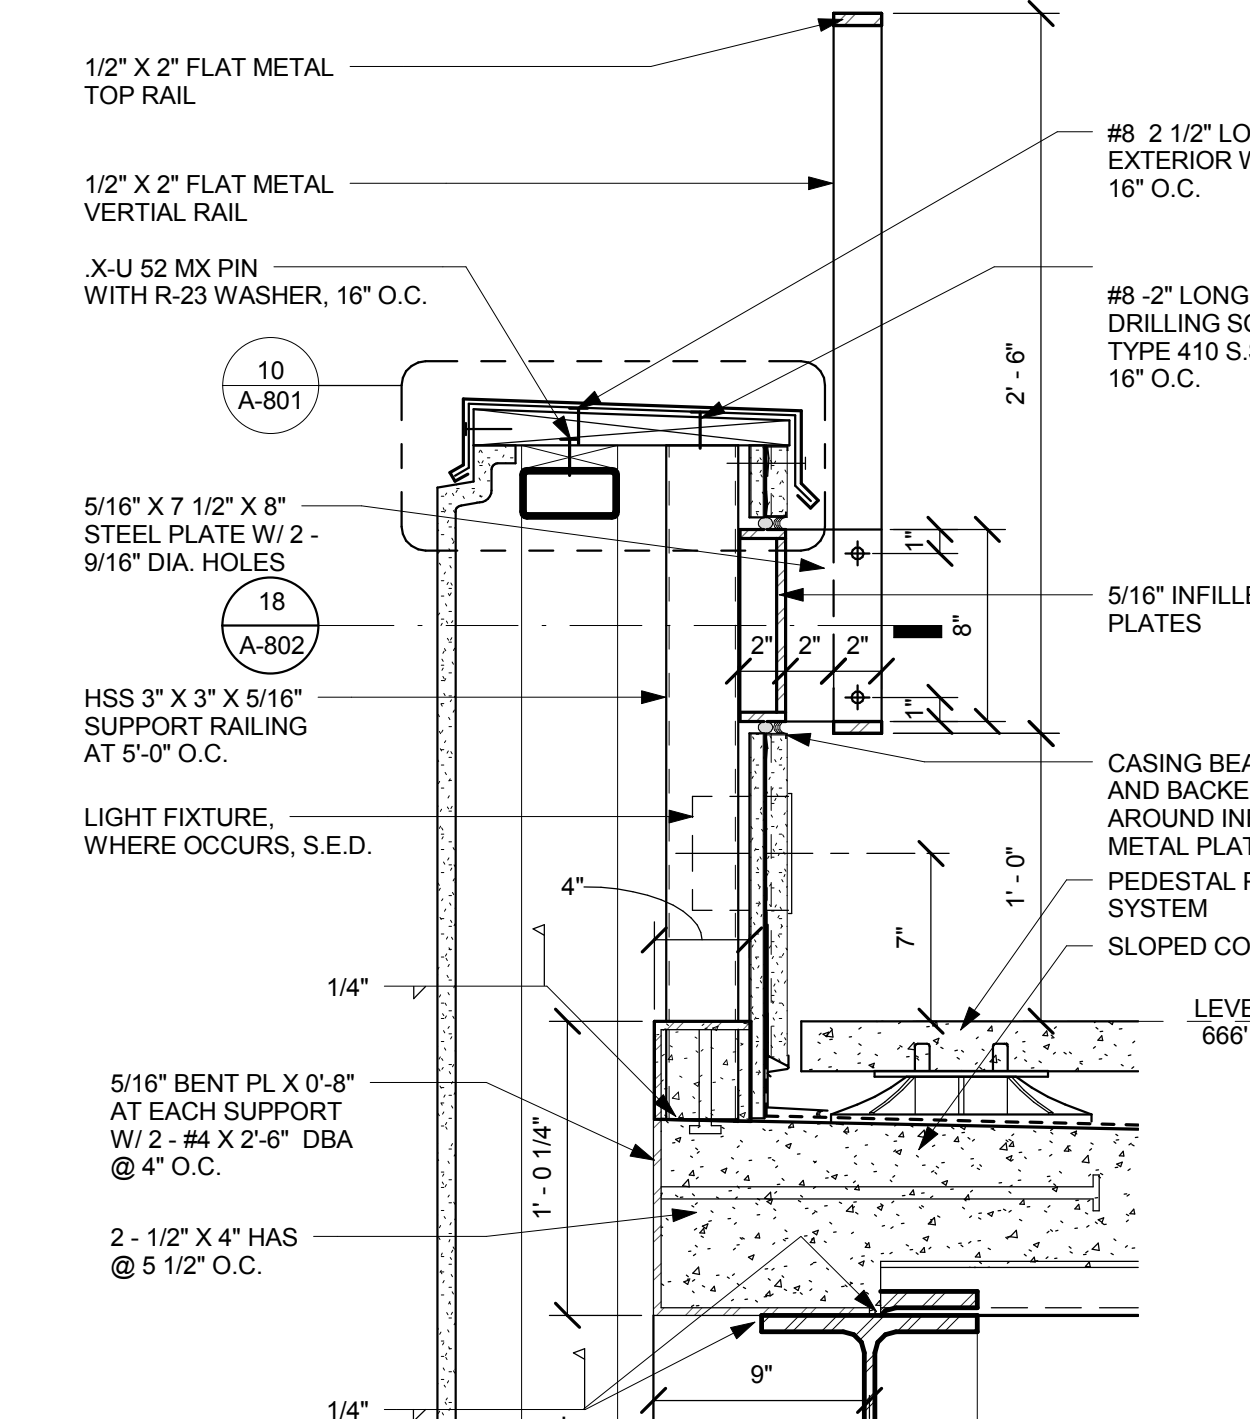


9 TERRACE RAILING SECTION - AT GRFC
1 1/2" = 1'-0"

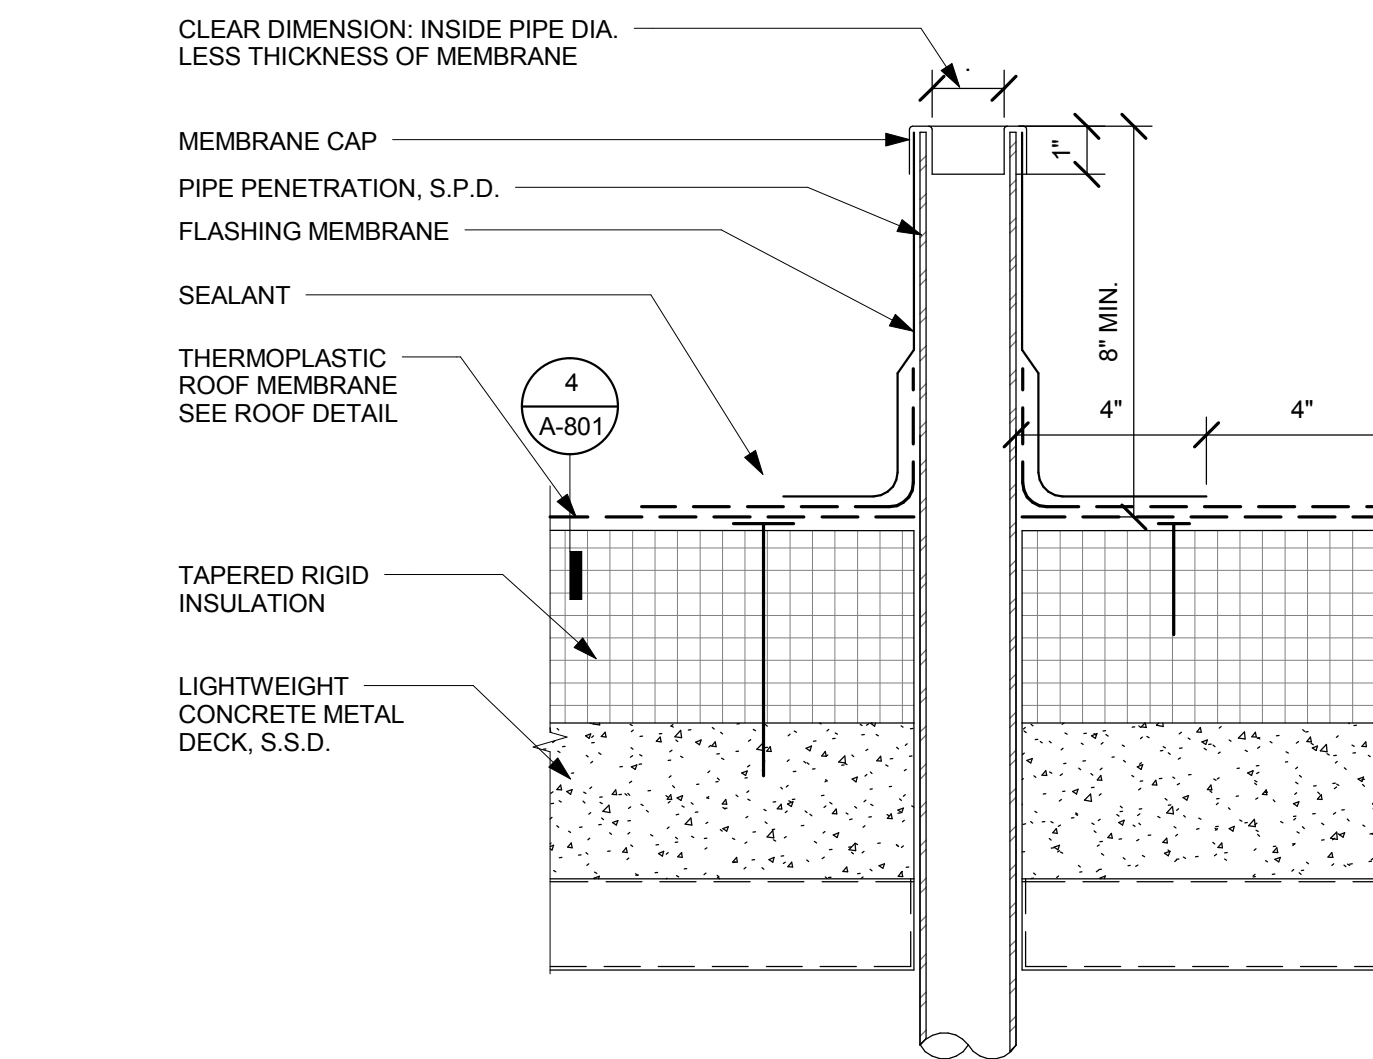


7 TYP. VENT PENETRATION
3" = 1'-0"

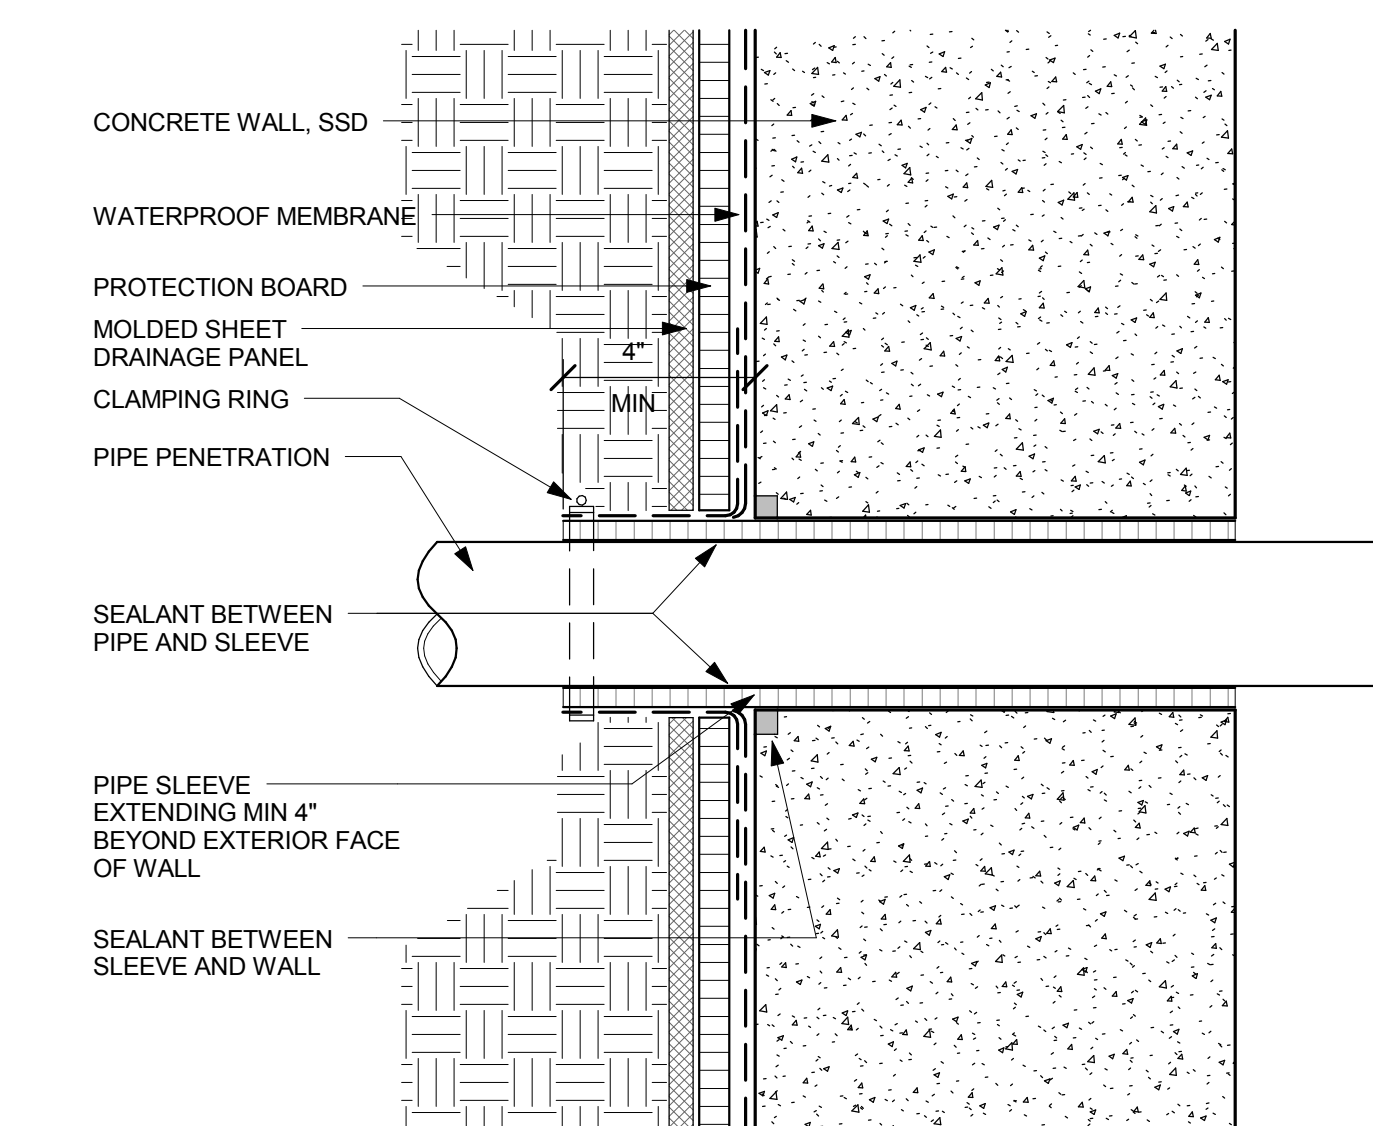


6 FOUNDATION WALL PENETRATION
3" = 1'-0"

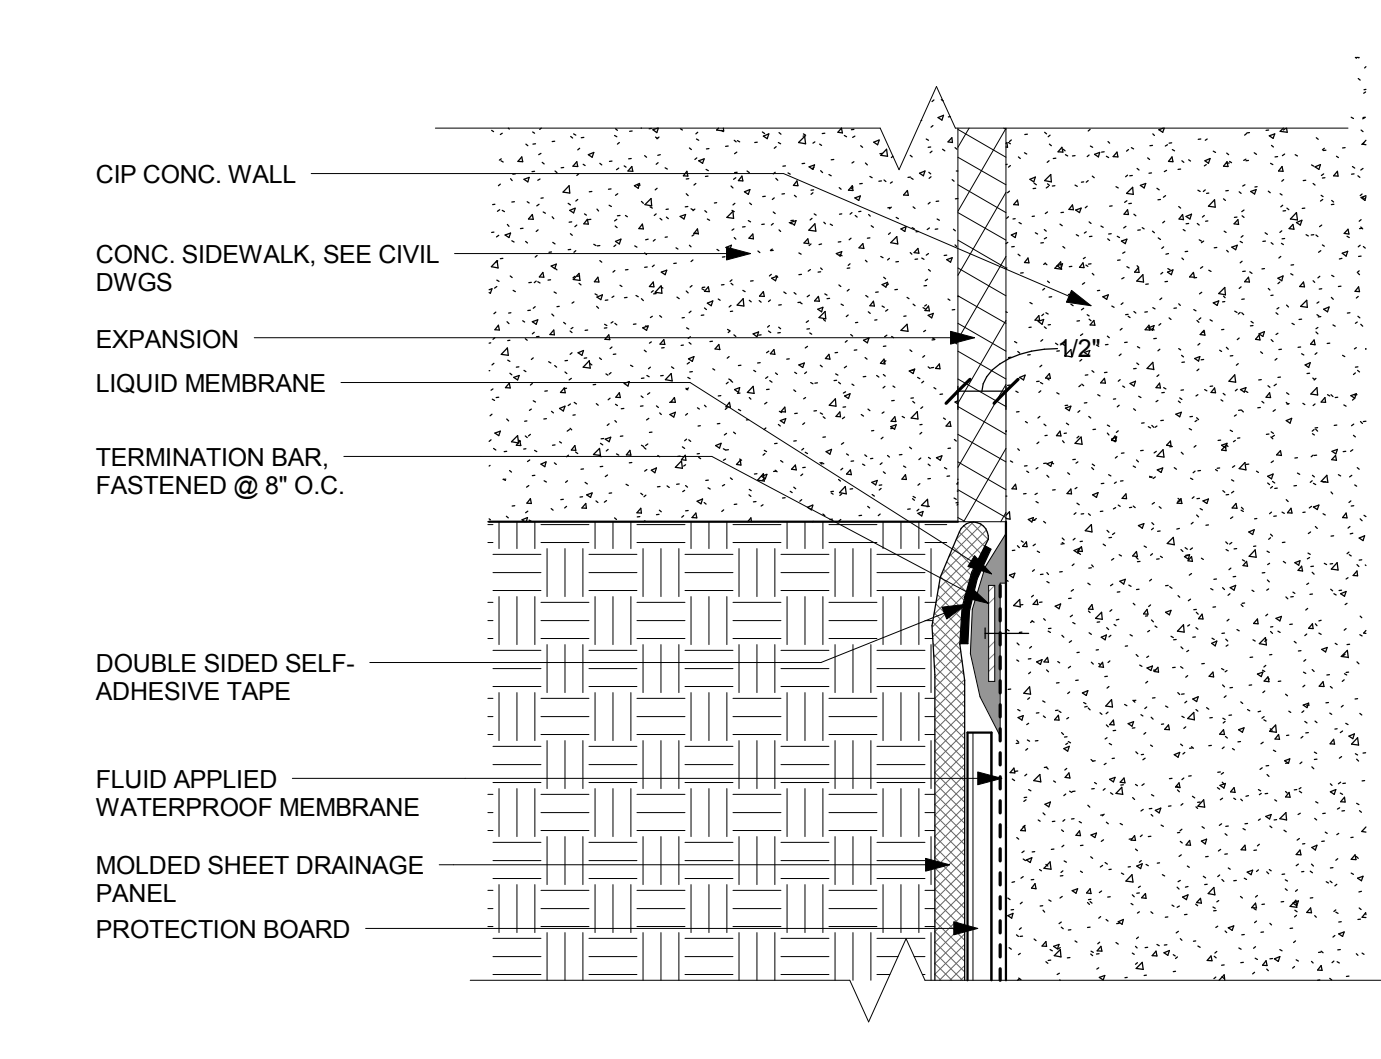

3 WATERPROOFING AT CIP WALL 2
6" = 1'-0"

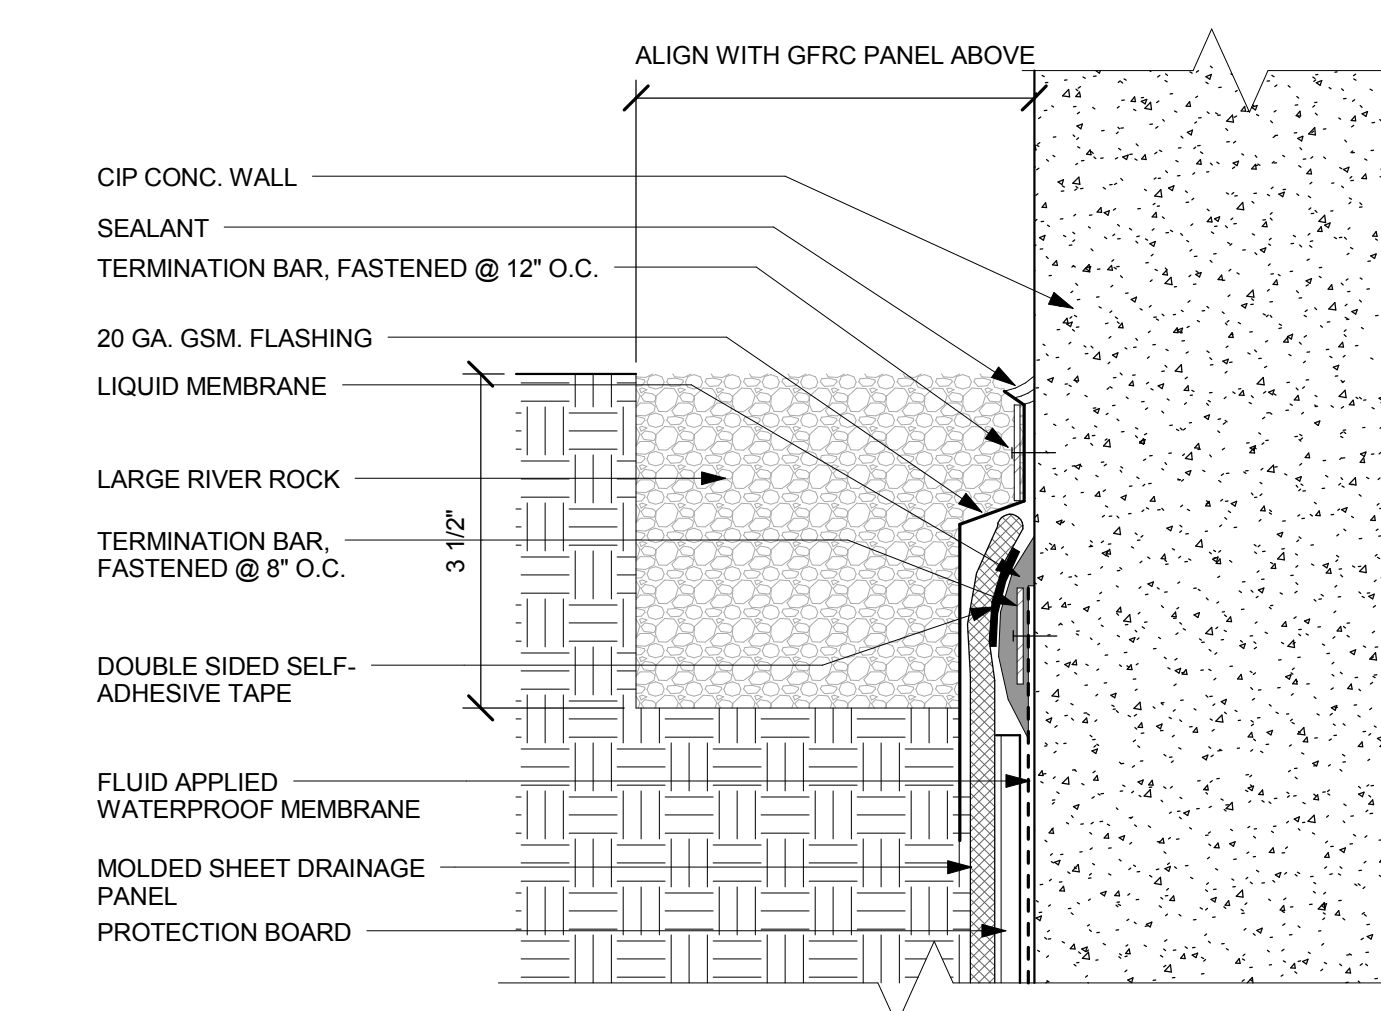

2 WATERPROOFING AT CIP WALL
6" = 1'-0"

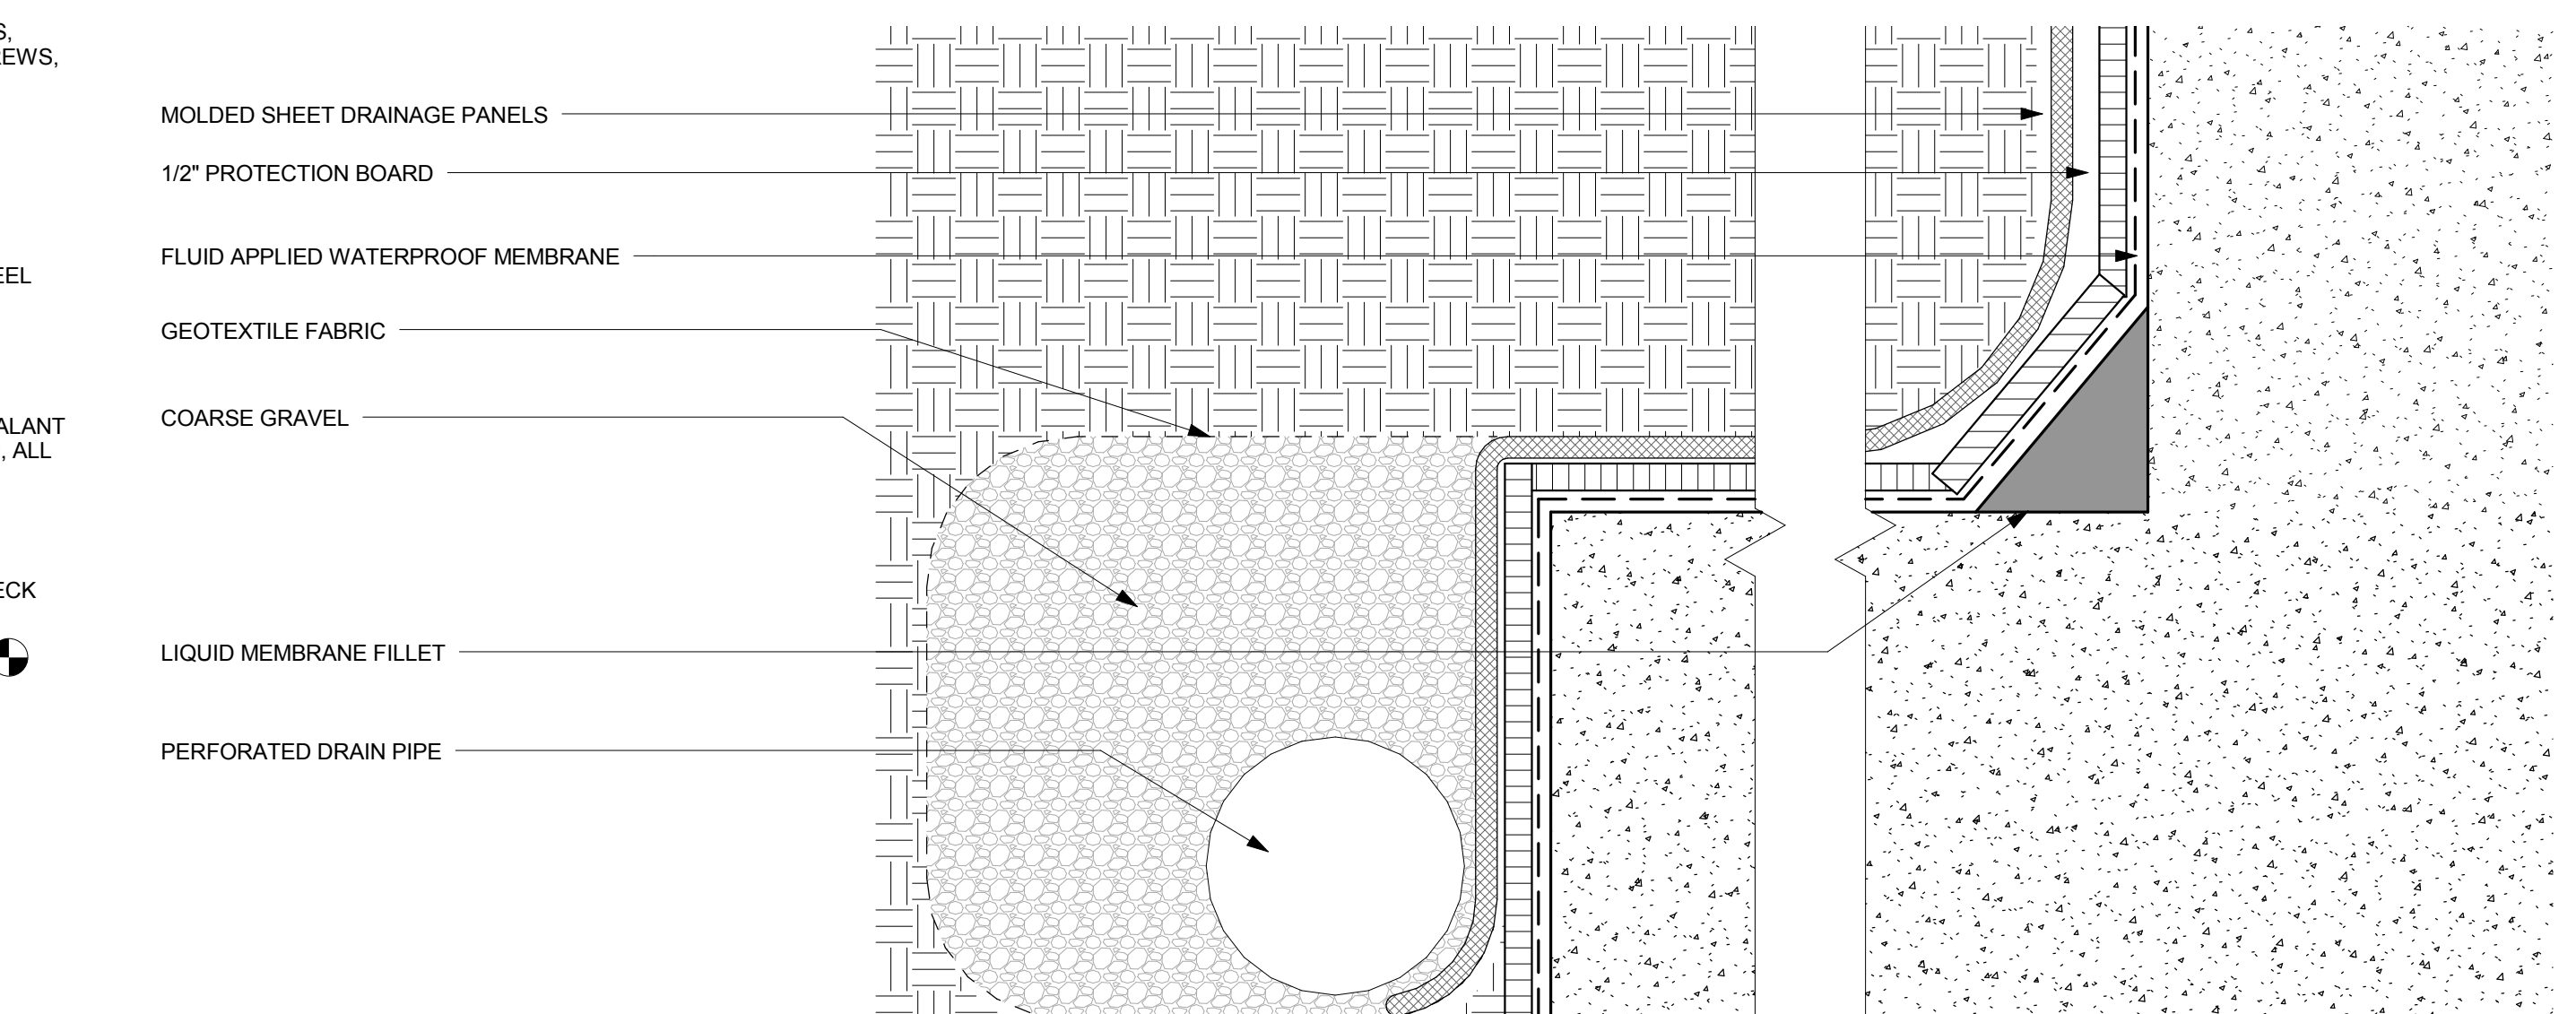

5 WATERPROOFING AT FOOTING
3" = 1'-0"