




4 EXTERIOR DOOR SILL
3" = 1'-0"

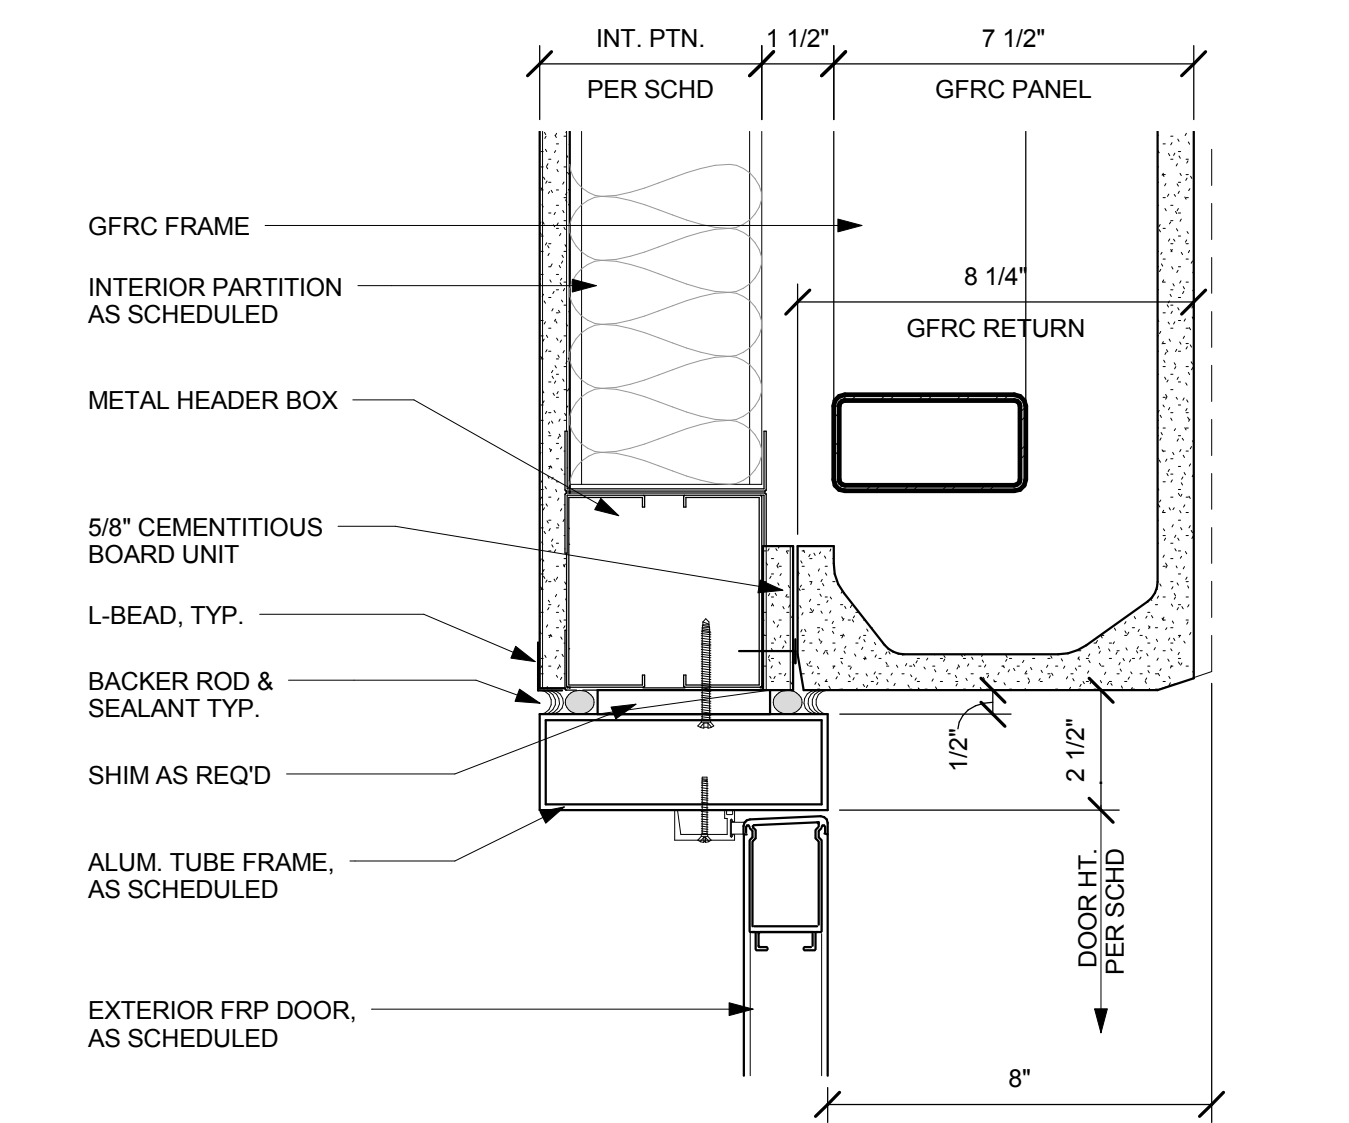


3 DOOR HEAD AT GFRc, TYP.
3" = 1'-0"

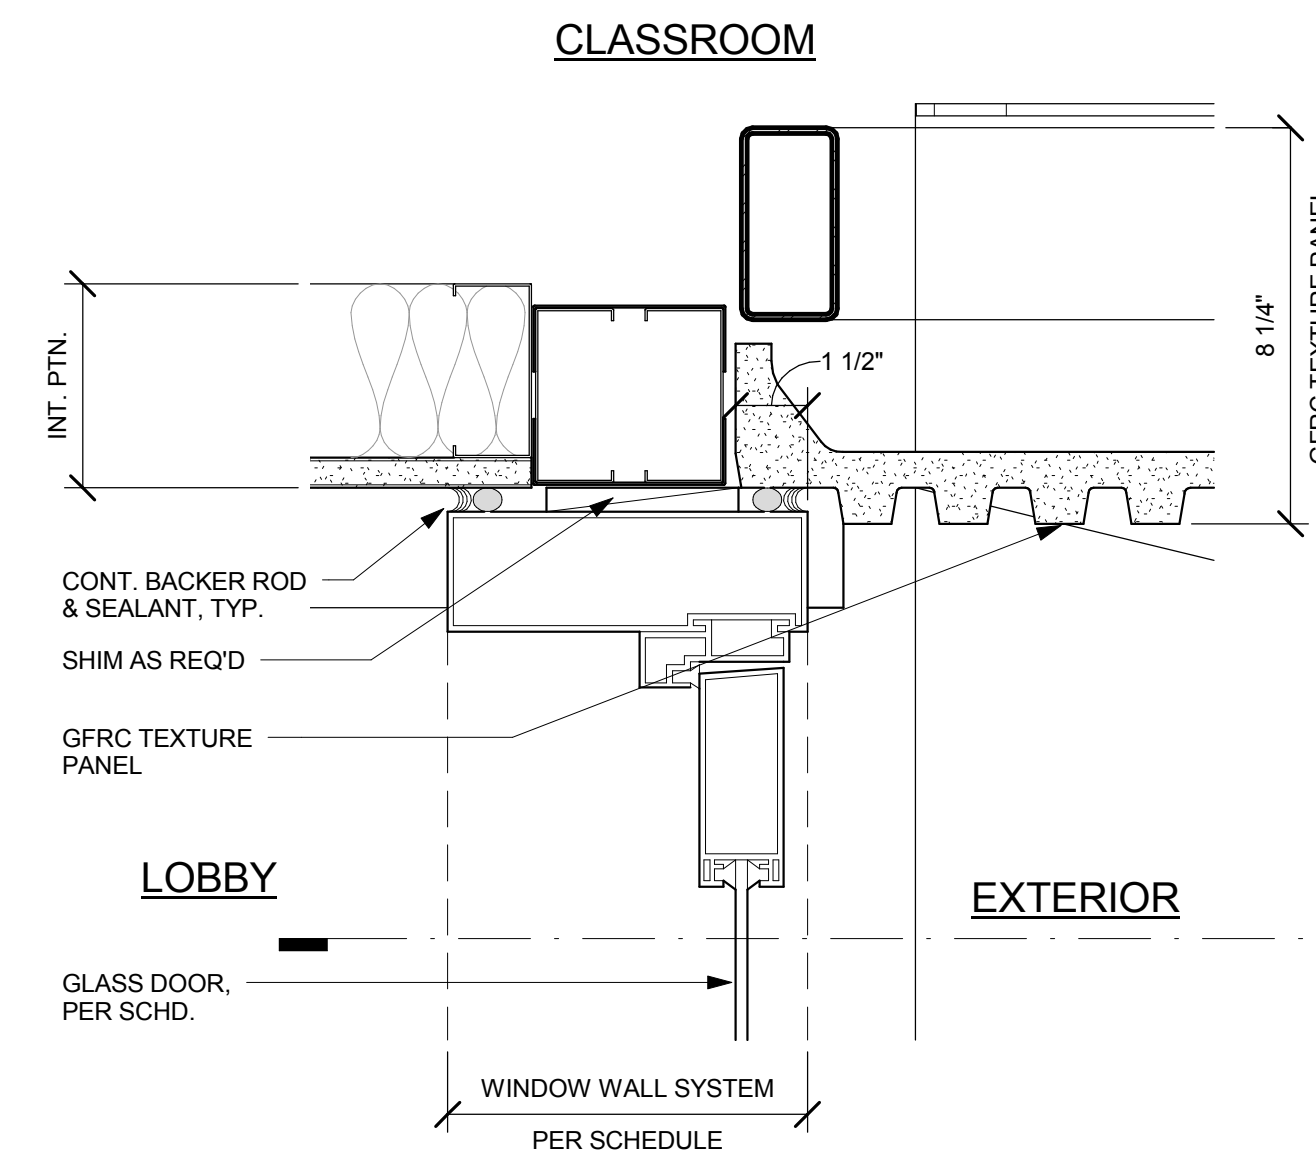


6 GFRc TEXTURE AT STRFNT JAMB
3" = 1'-0"

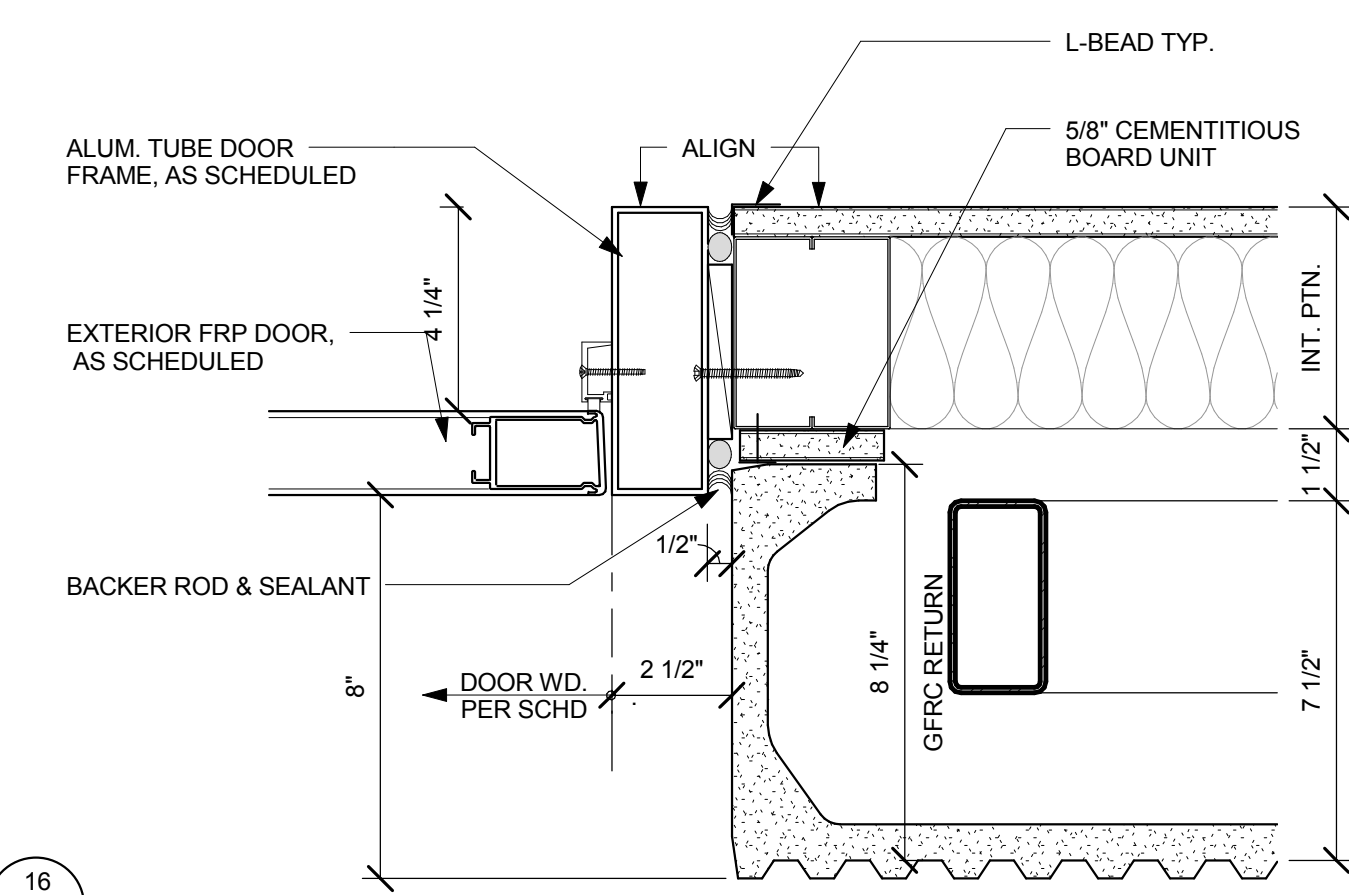


2 DOOR JAMB AT GFRc PANEL, TYP.
3" = 1'-0"

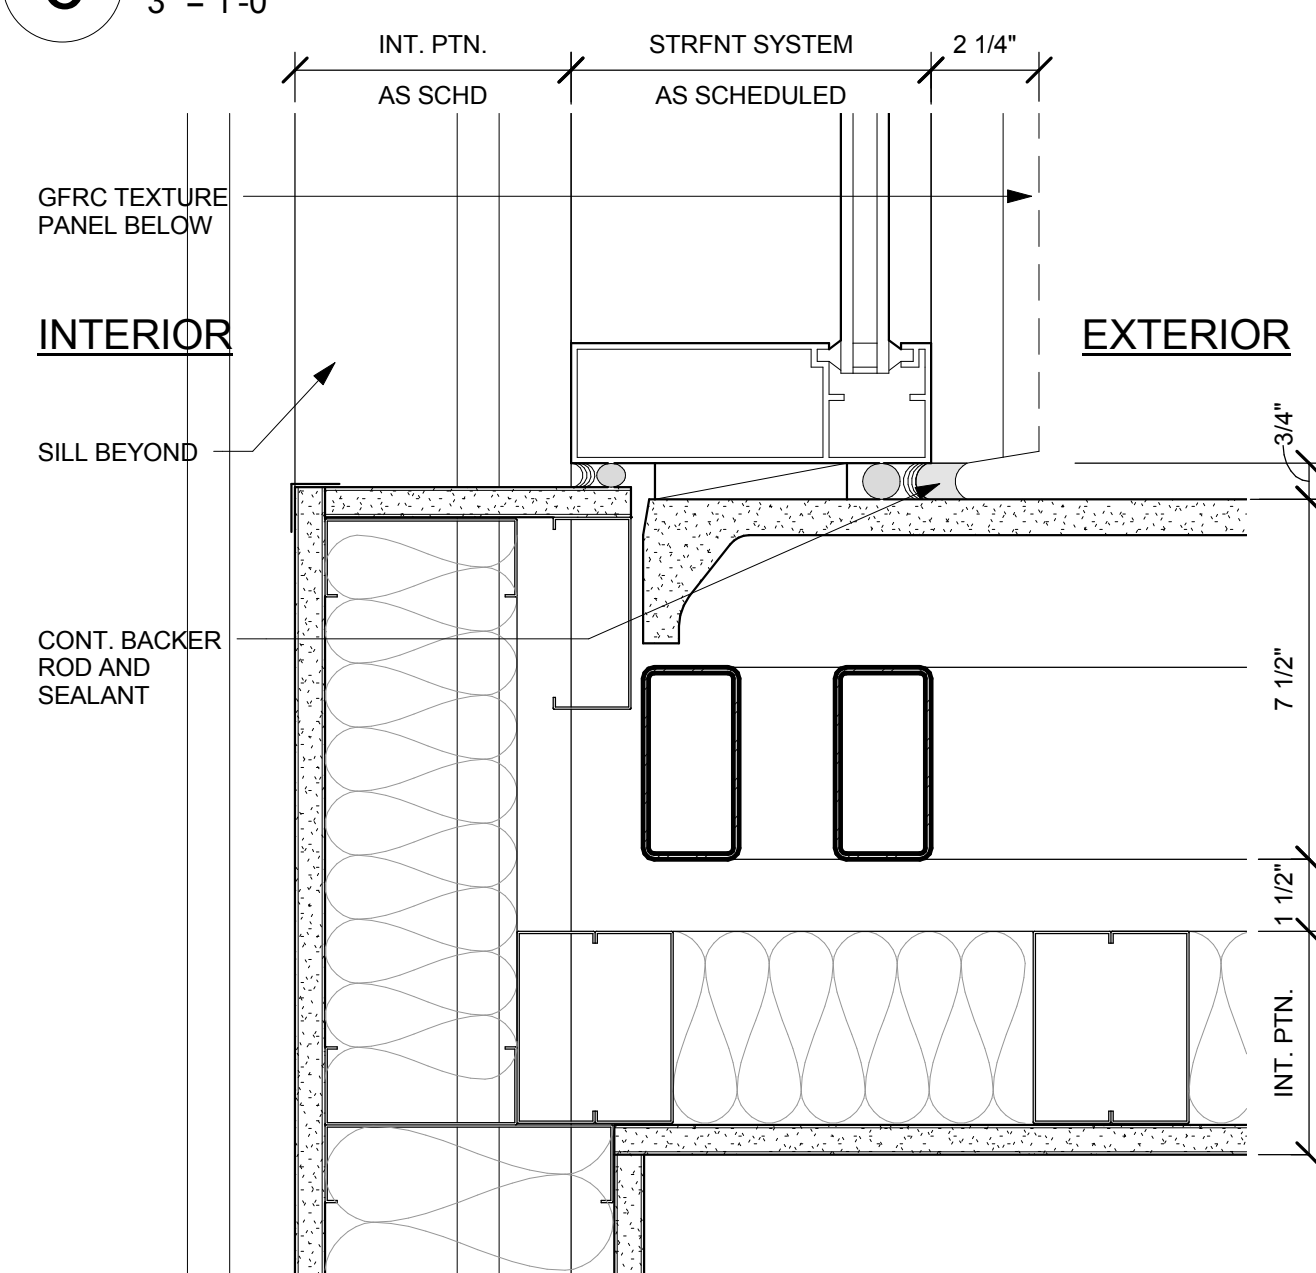

5 GFRc AT CLERESTORY JAMB - ST03
3" = 1'-0"

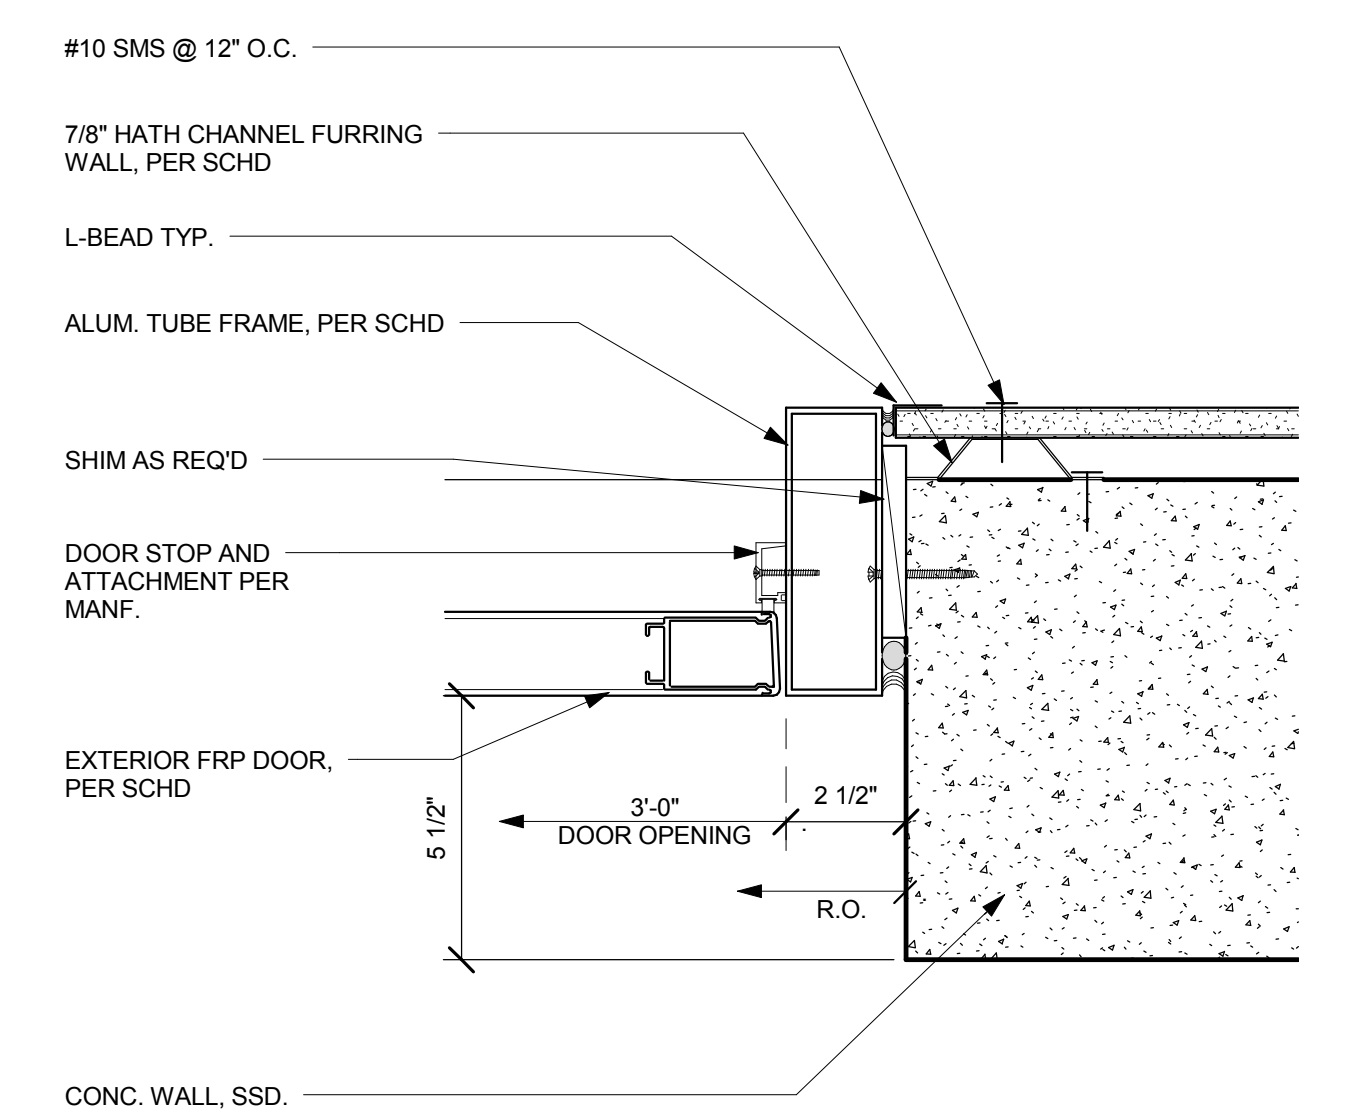

1 DOOR JAMB/HEAD AT CONC. WALL
3" = 1'-0"

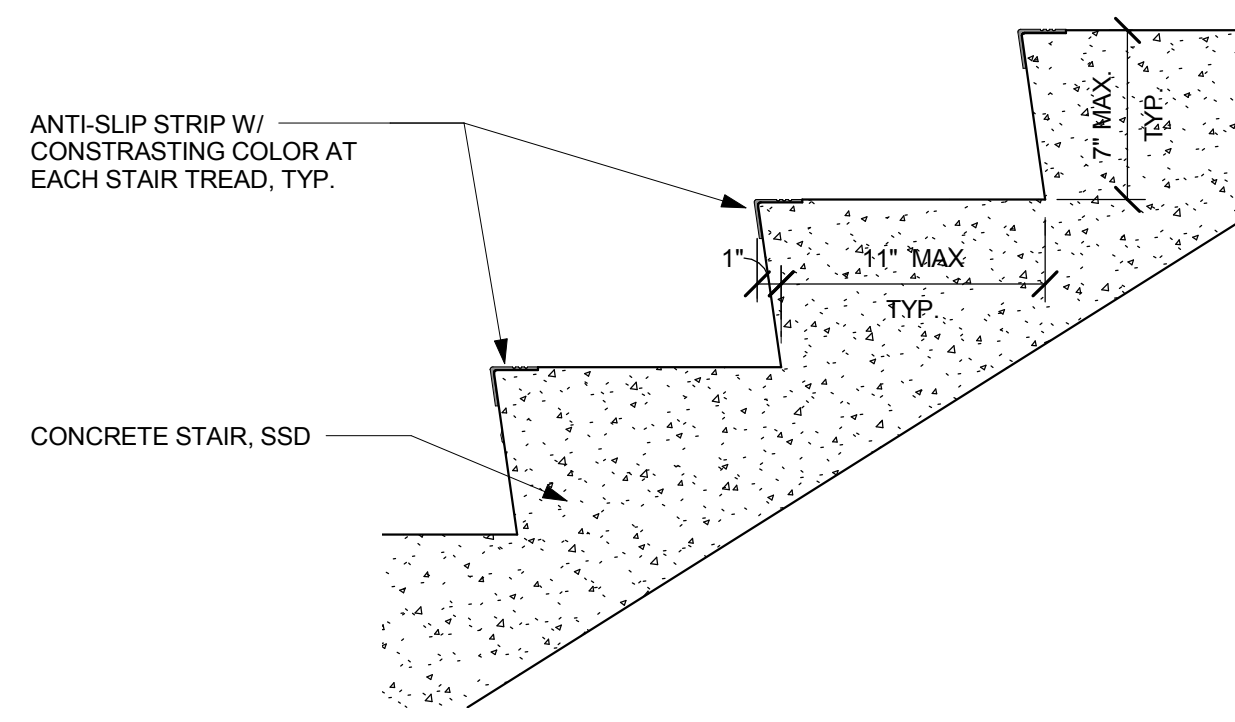

9 CONCRETE STAIR TREAD TYP.
1 1/2" = 1'-0"

NO.	ISSUES/REVISIONS	DATE

PROJECT
RECORD SET

BUILDING 4
SKYLINE COLLEGE

SAN MATEO COUNTY
COMMUNITY COLLEGE
DISTRICT

CIP2 DESIGN-BUILD
PROJECT
BUILDING 4

PROJECT NO.: 07012.00 DRAWN BY: Author
DATE: 10/29/08 CHECKED BY: Checker
SCALE: As indicated

SHEET TITLE:
EXTERIOR GFRc
PANEL DETAILS