




6 INSCRIPTION LIGHTING @ GFRc
3" = 1'-0"

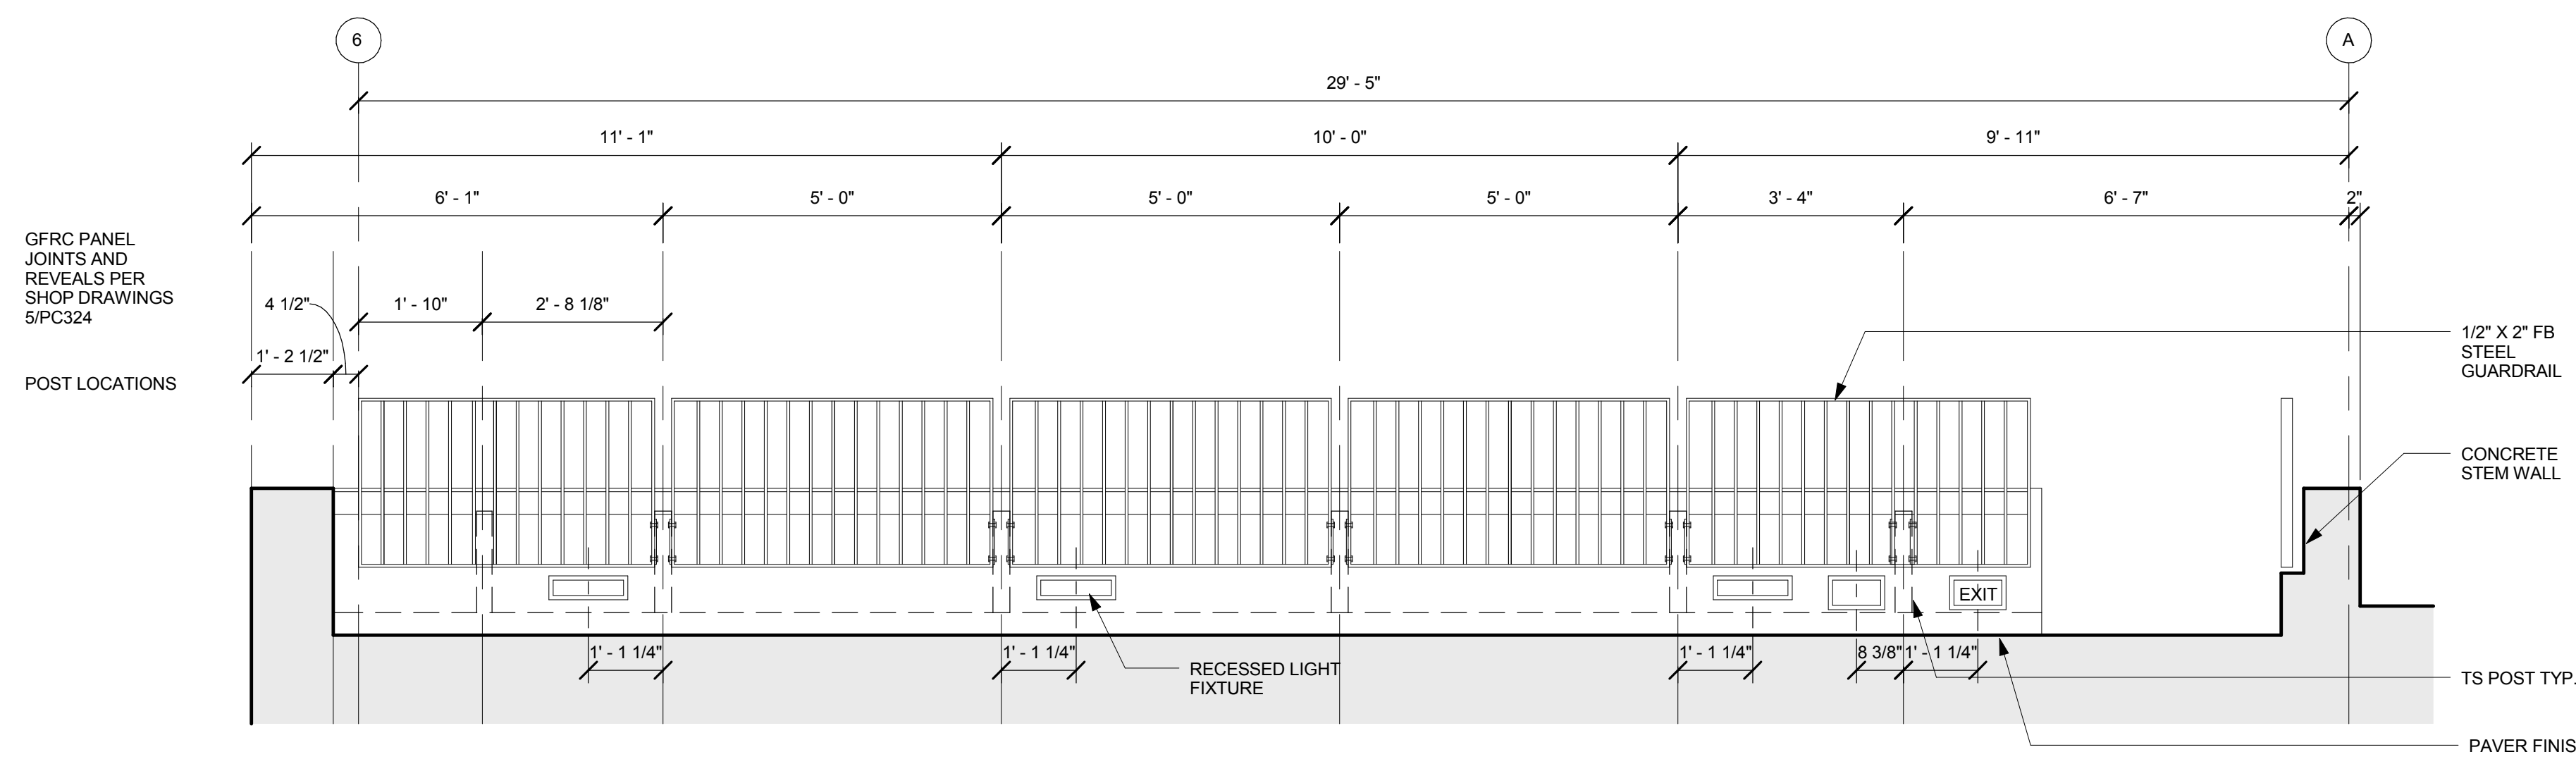


5 SK 12.2 WEST TERRACE MTL GUARDRAIL ELEVATION
1/2" = 1'-0"

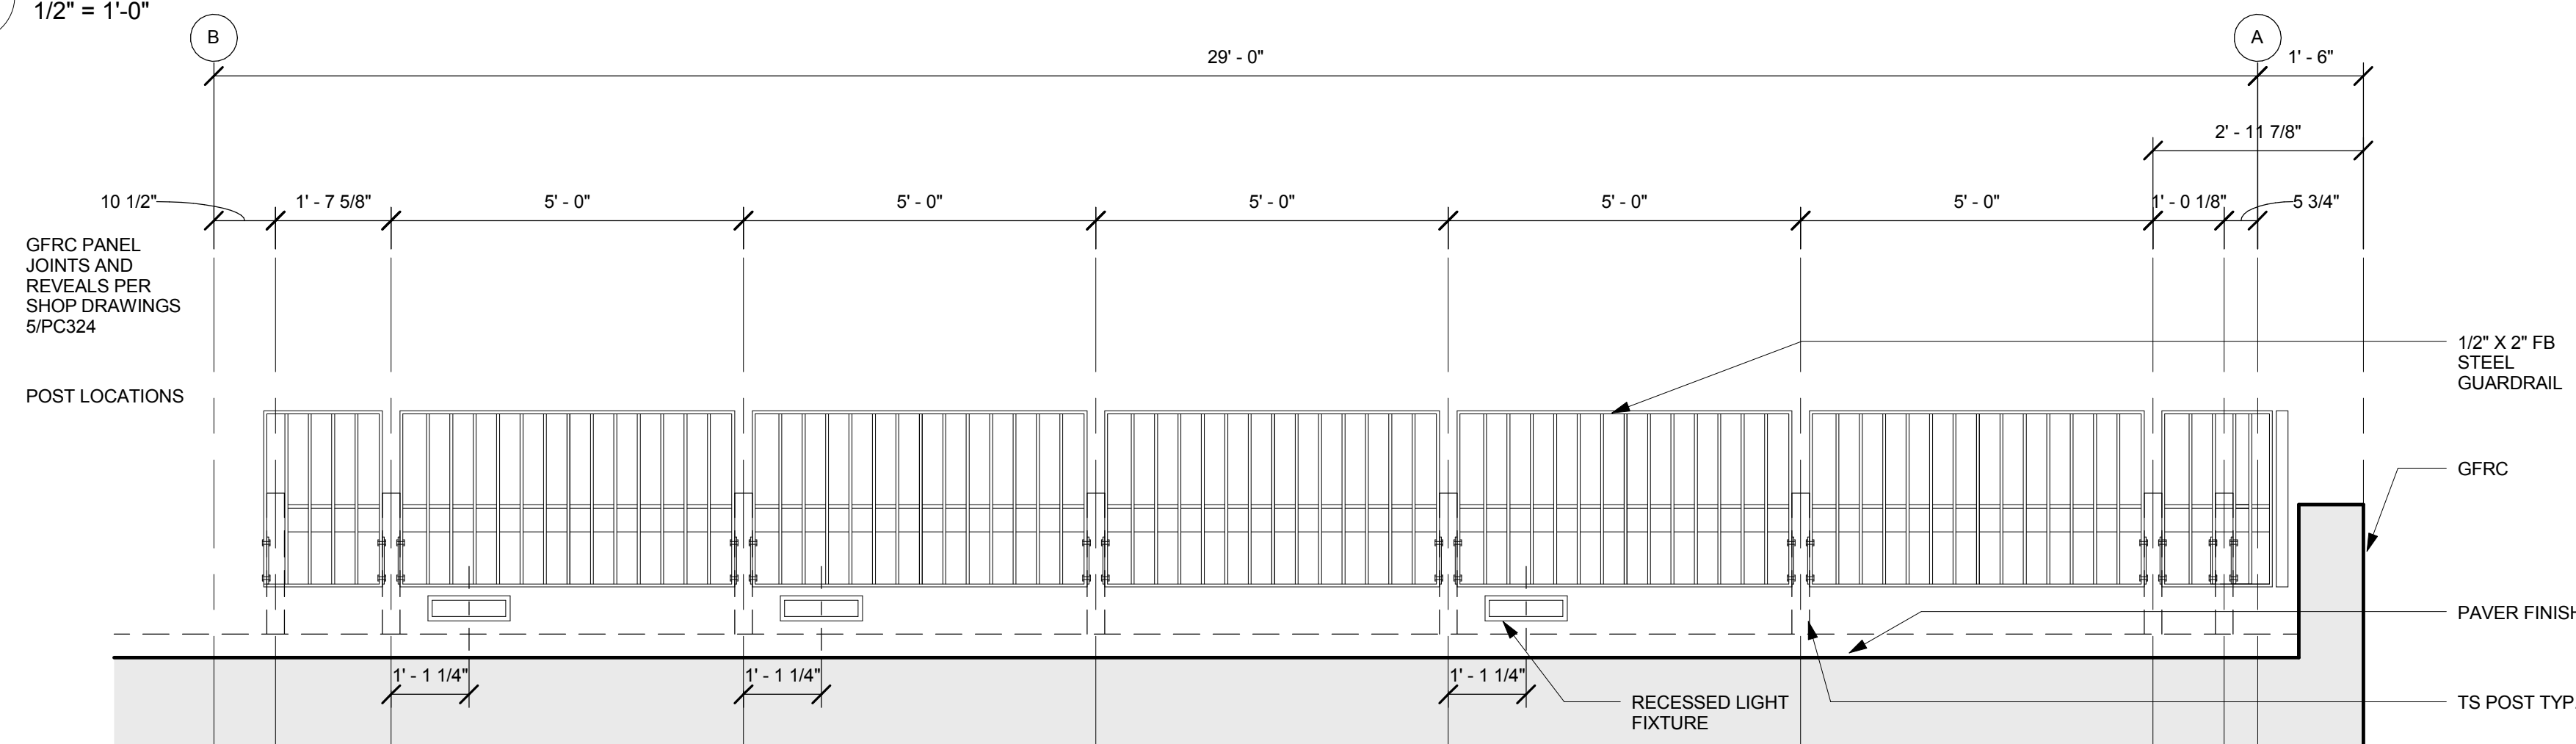


4 SK 12.2 SOUTH TERRACE MTL GUARDRAIL ELEVATION
1/2" = 1'-0"

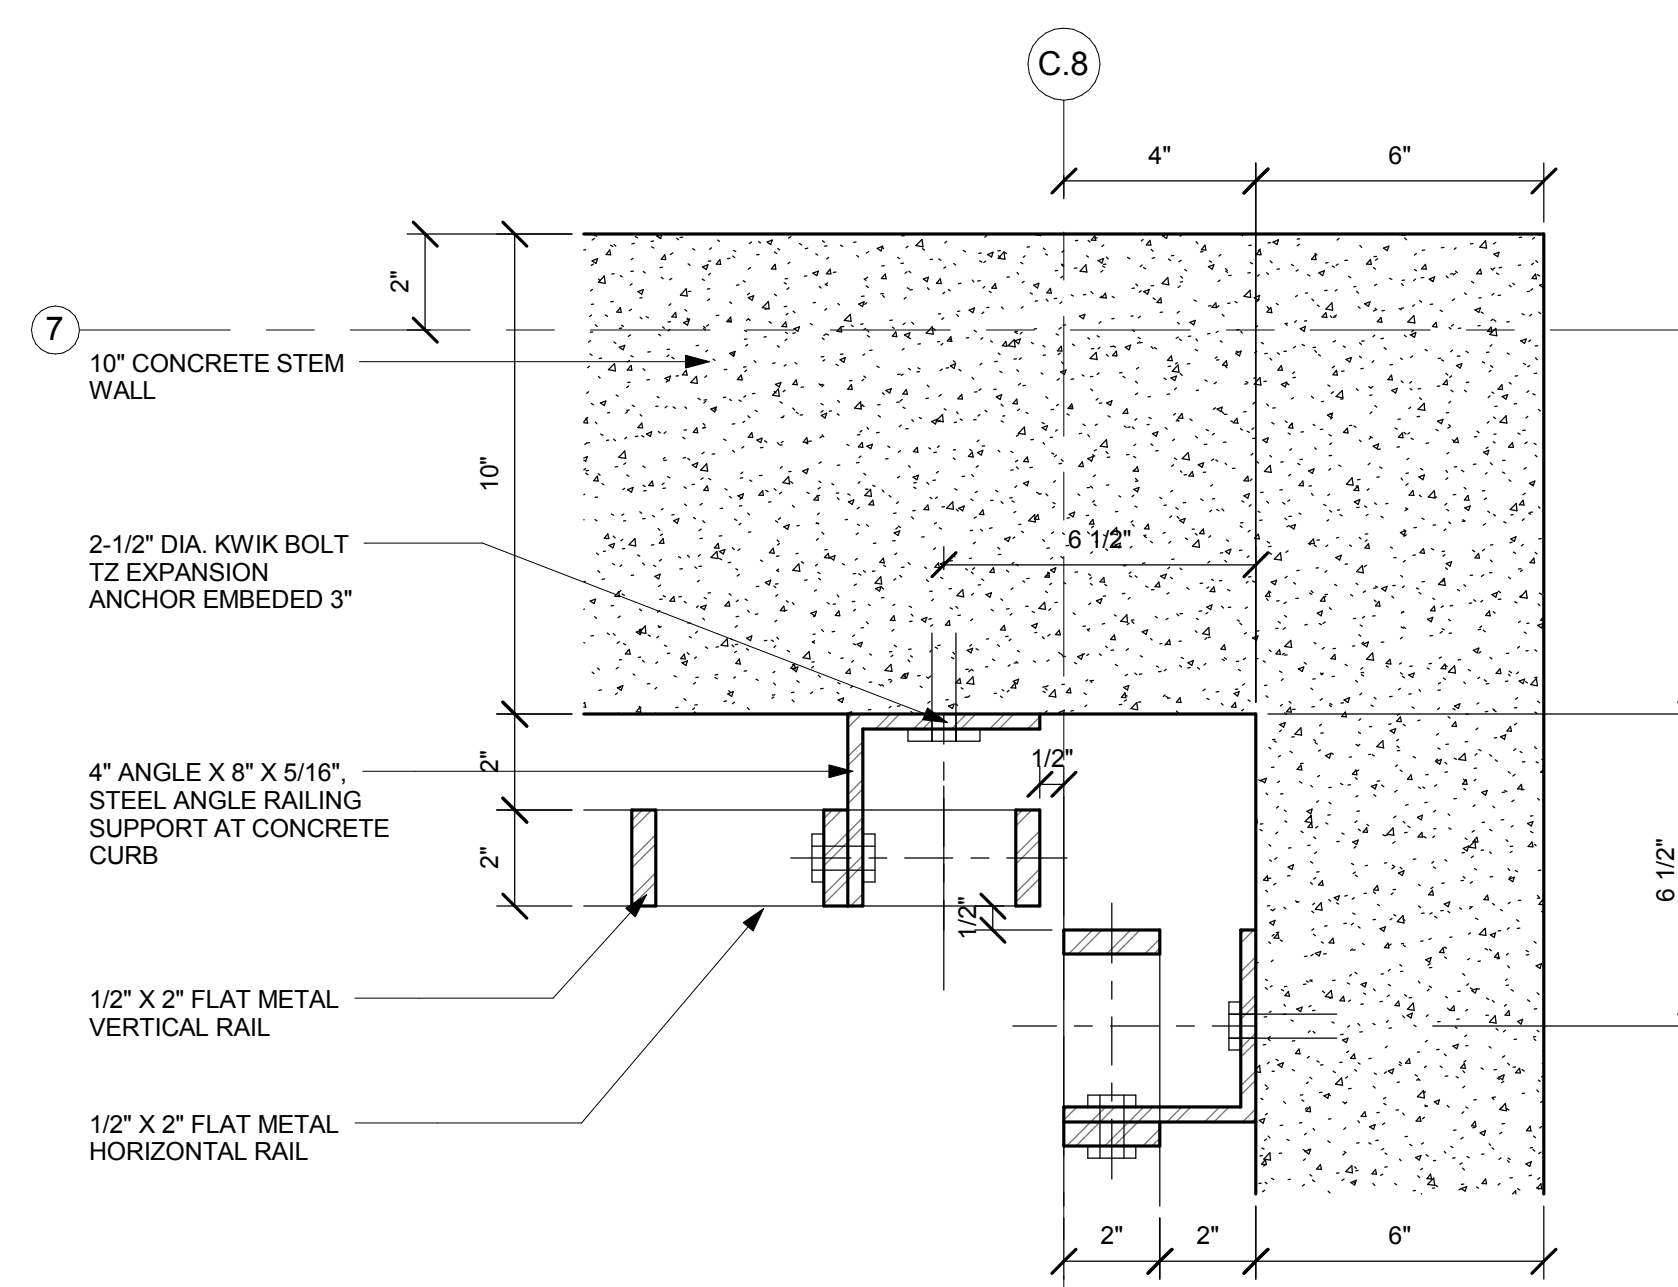

3 SK-11.1 CONCRETE PARAPET CORNER RAIL DETAIL
3" = 1'-0"

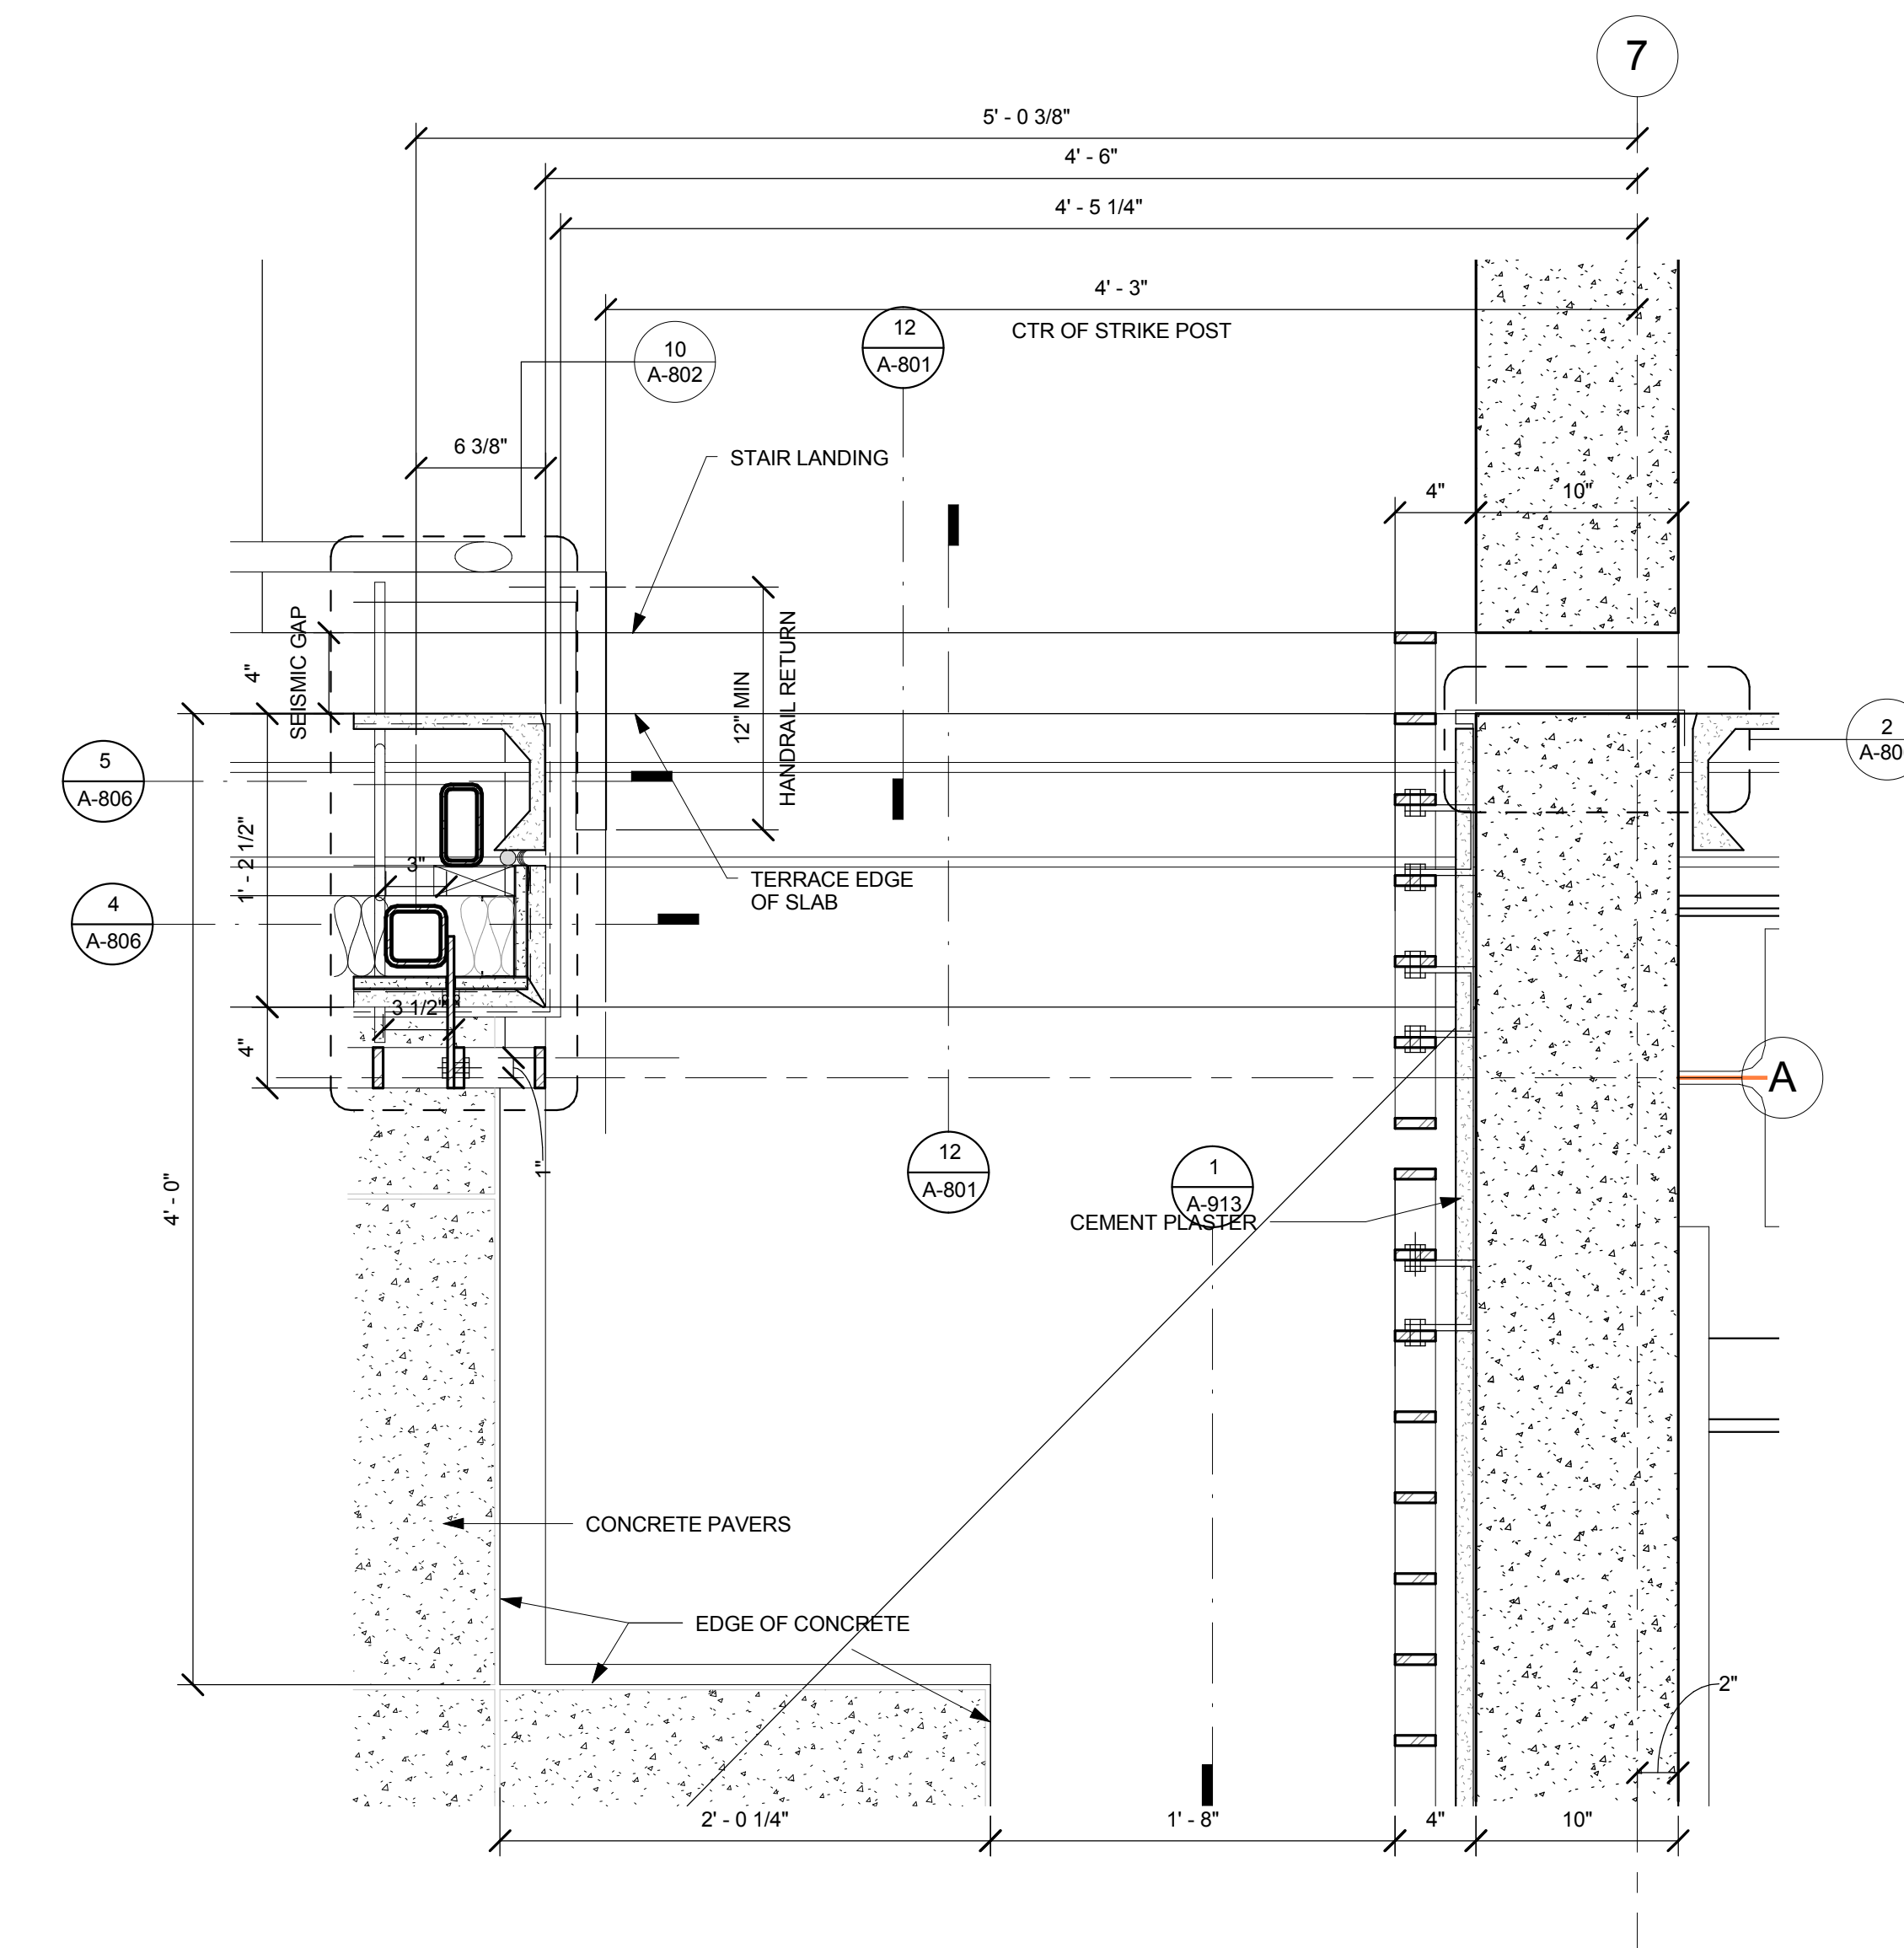

2 SK-12.1 TERRACE GATE PLAN DETAIL
1 1/2" = 1'-0"

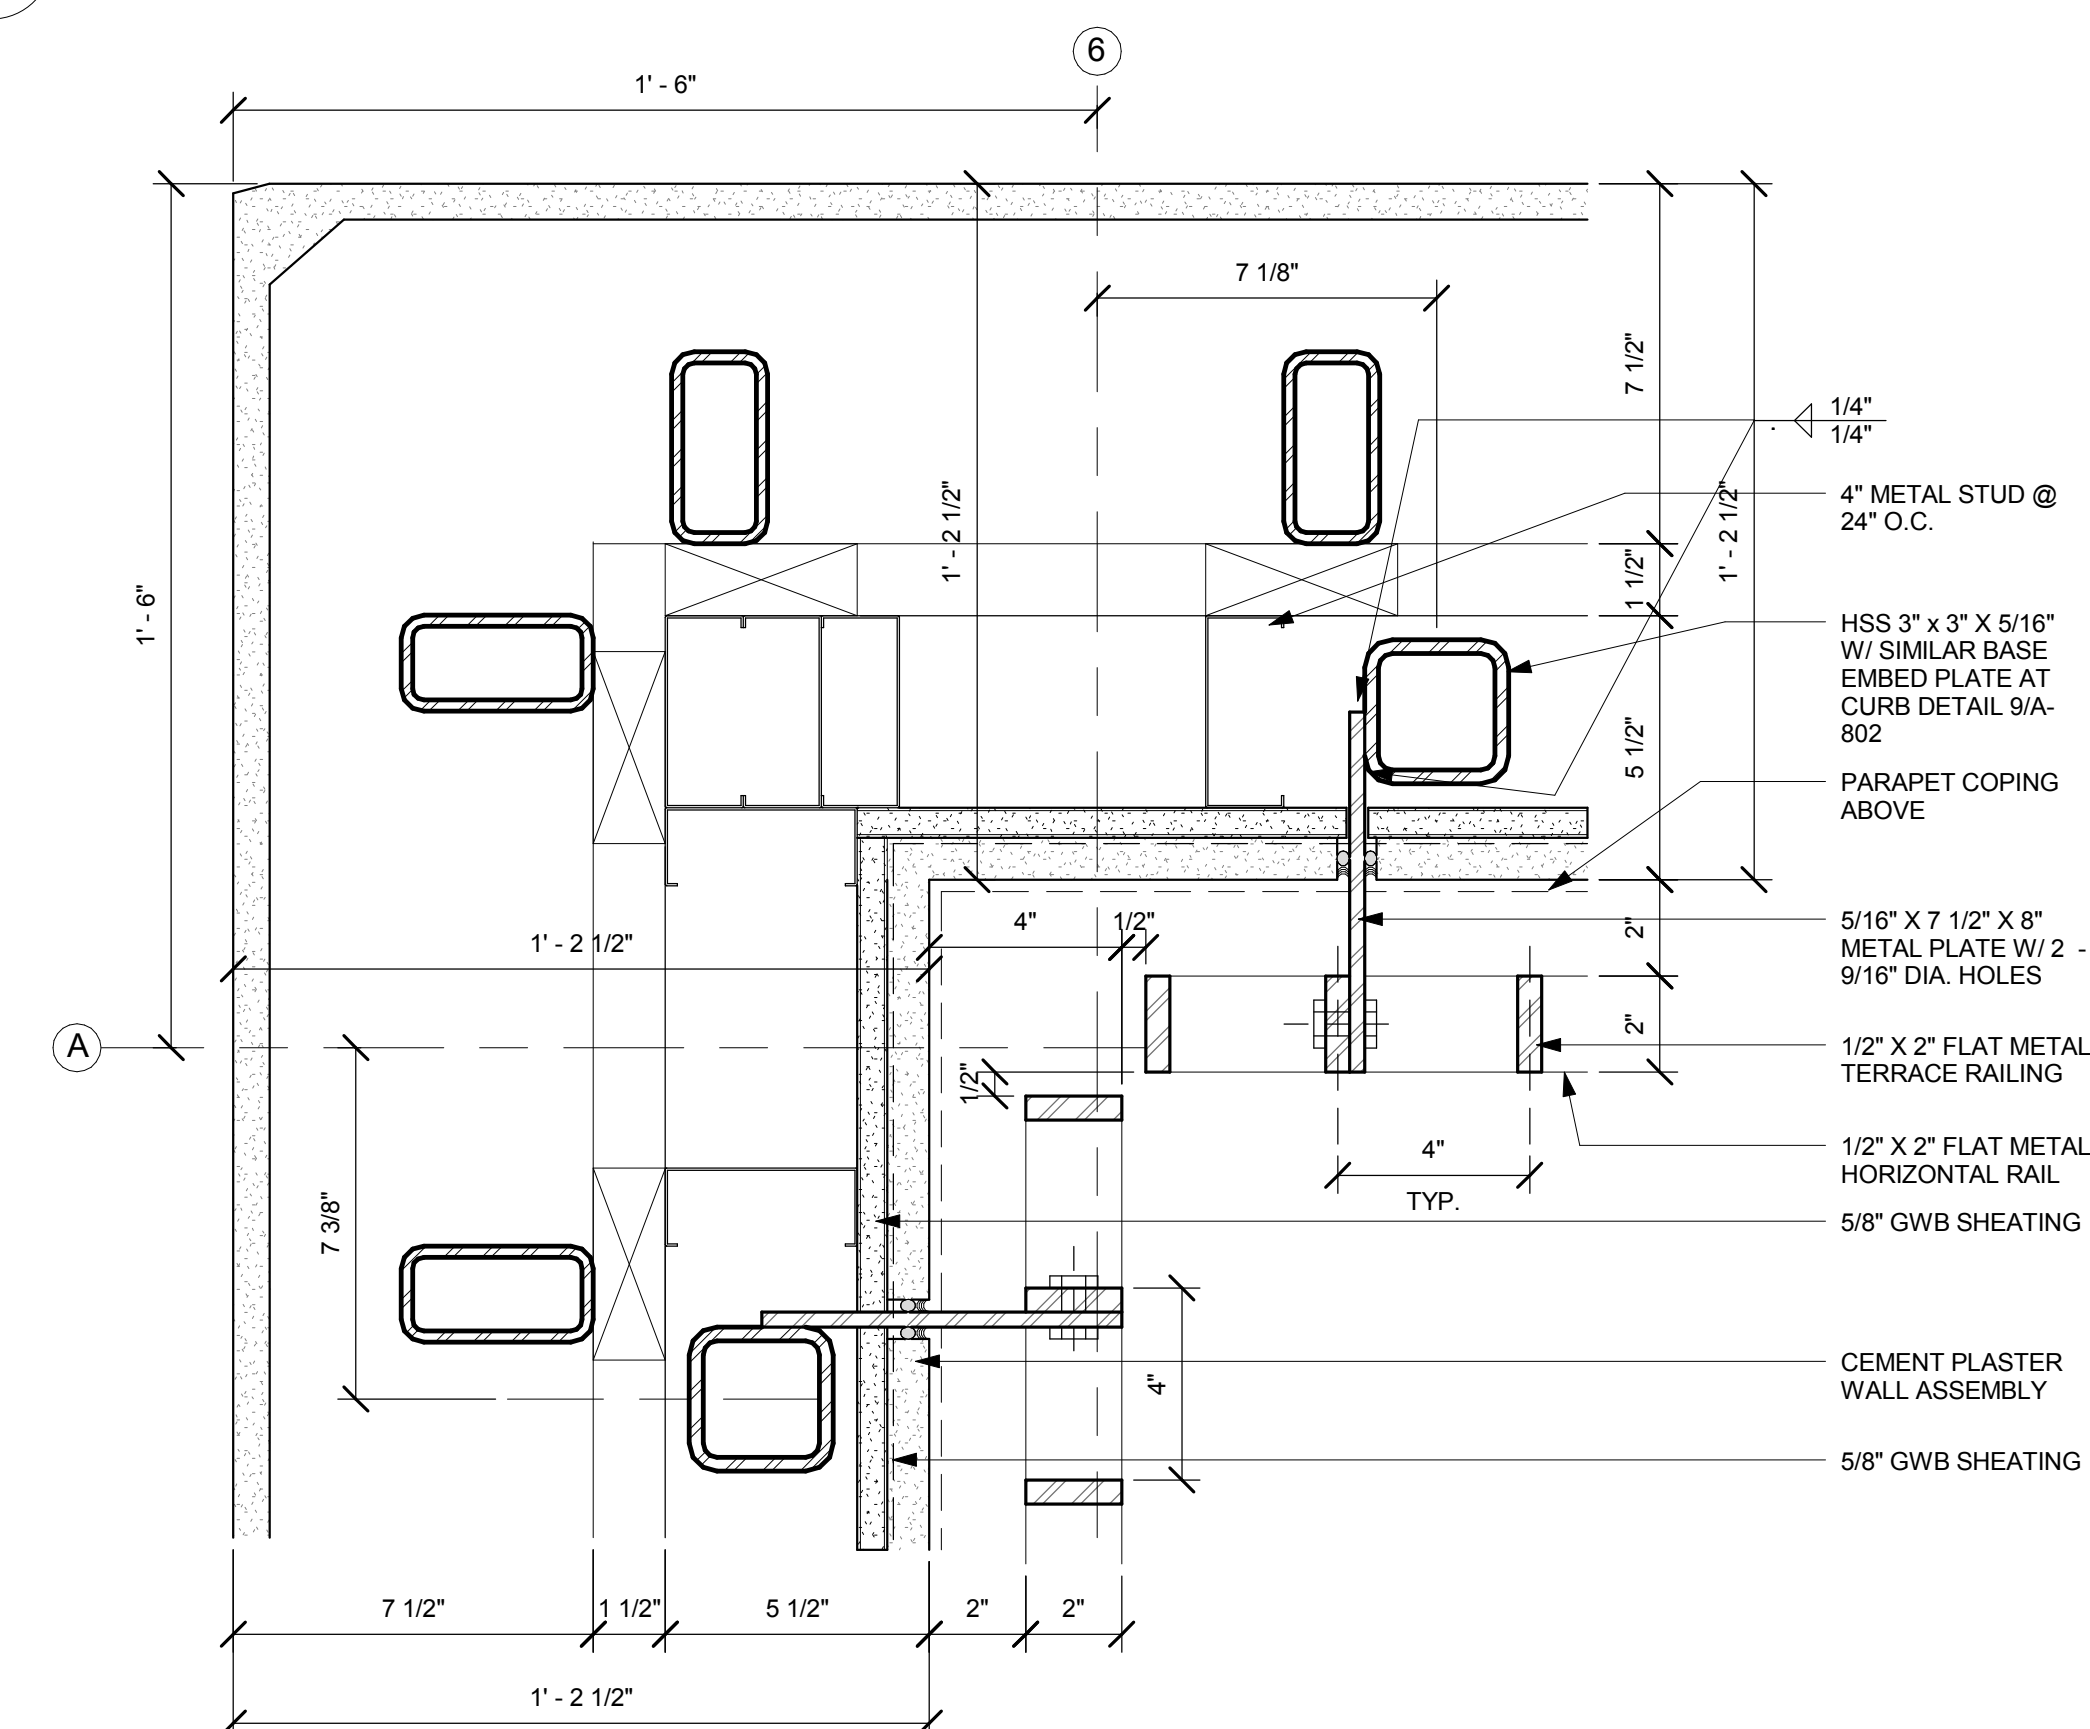

1 SK-11.2 STUCCO PARAPET CORNER RAIL DETAIL
3" = 1'-0"