




**6** B6 END CAP @ CEMENT PLASTER  
3" = 1'-0"

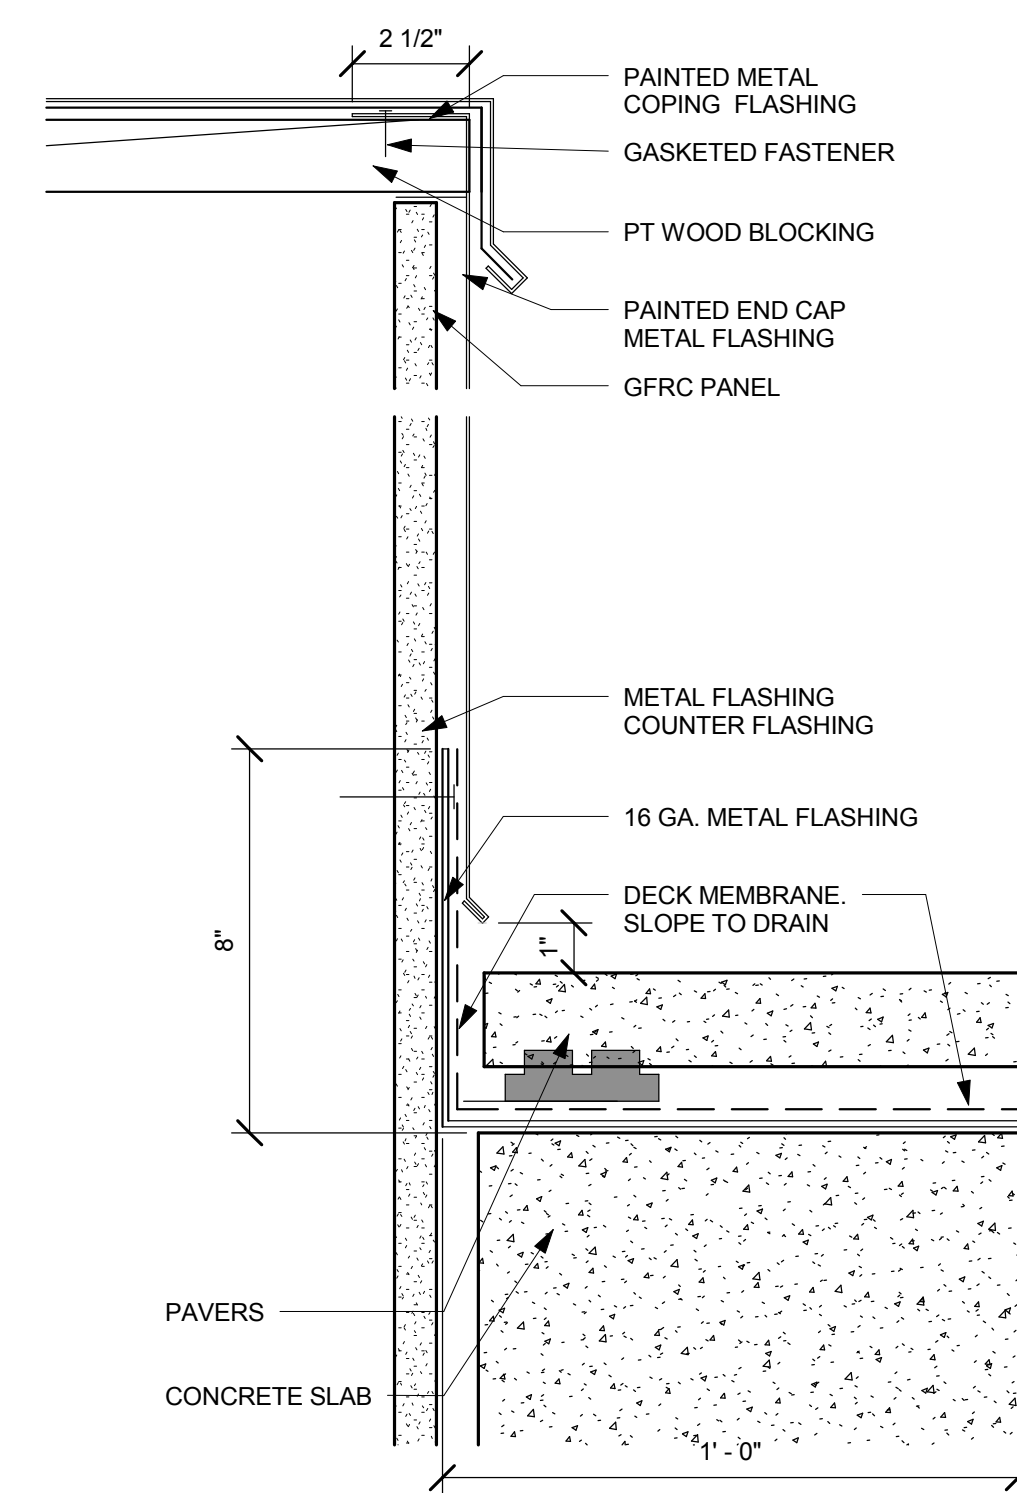


**7** B6 END CAP @ GFRc  
3" = 1'-0"

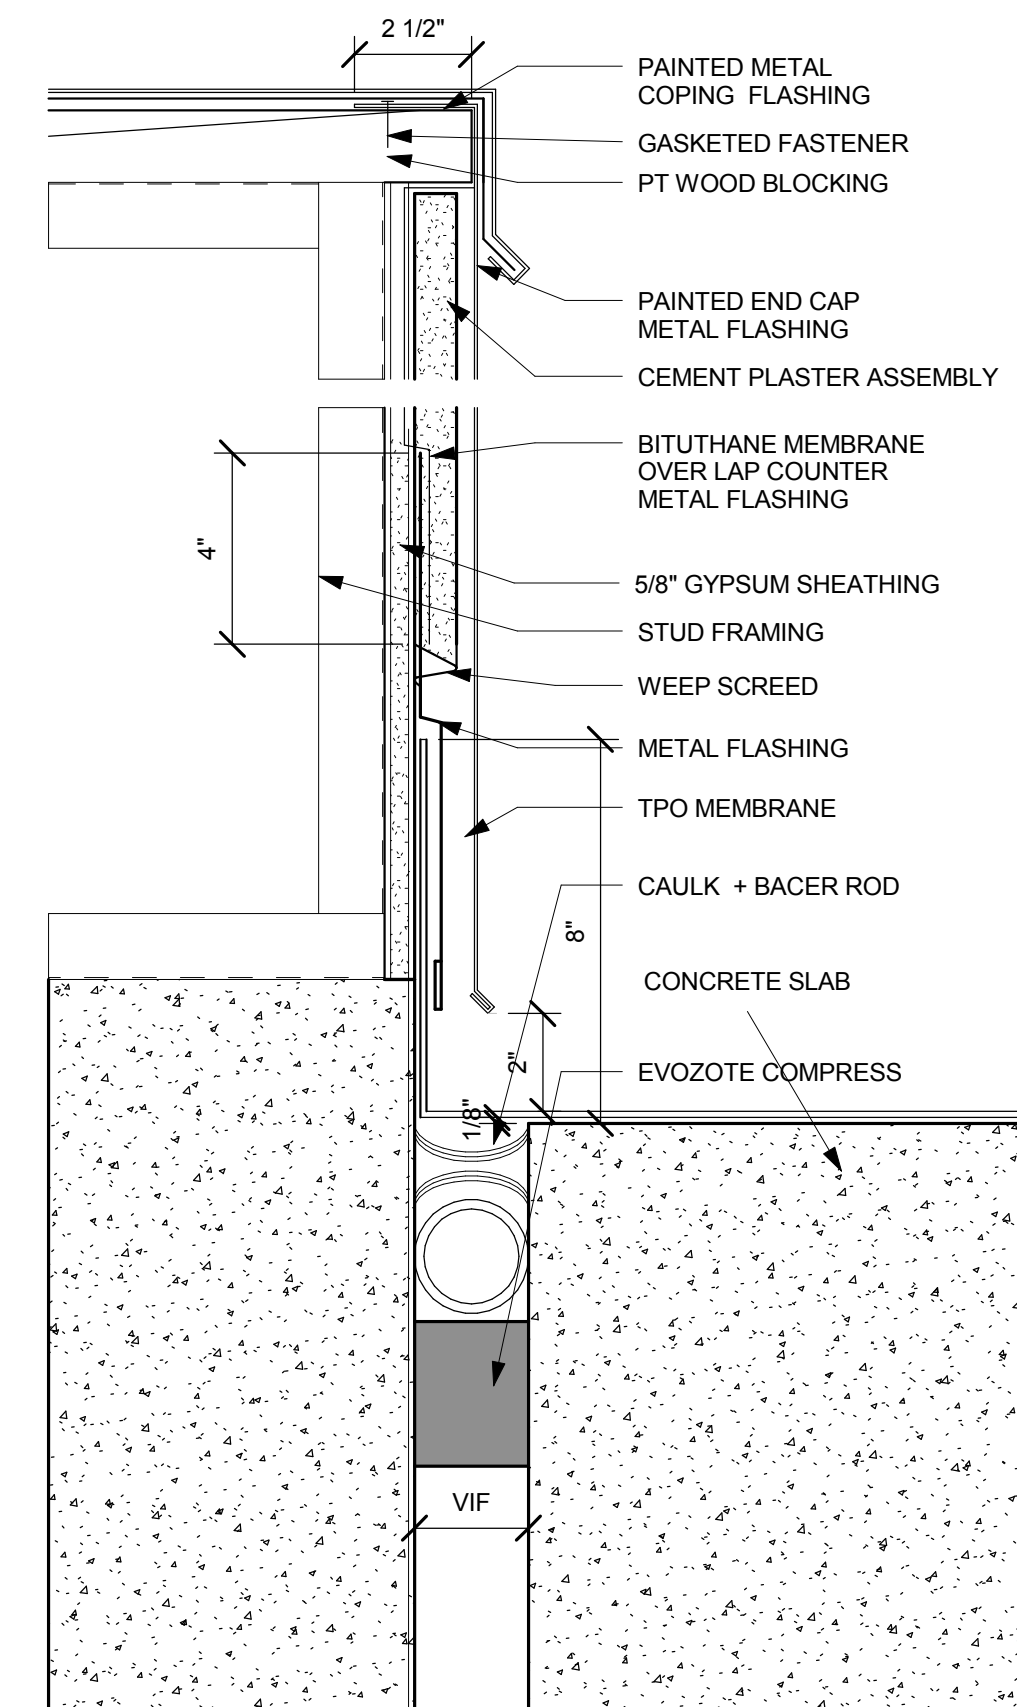


**4** STRIKE END CAP @ CEMENT PLASTER  
3" = 1'-0"

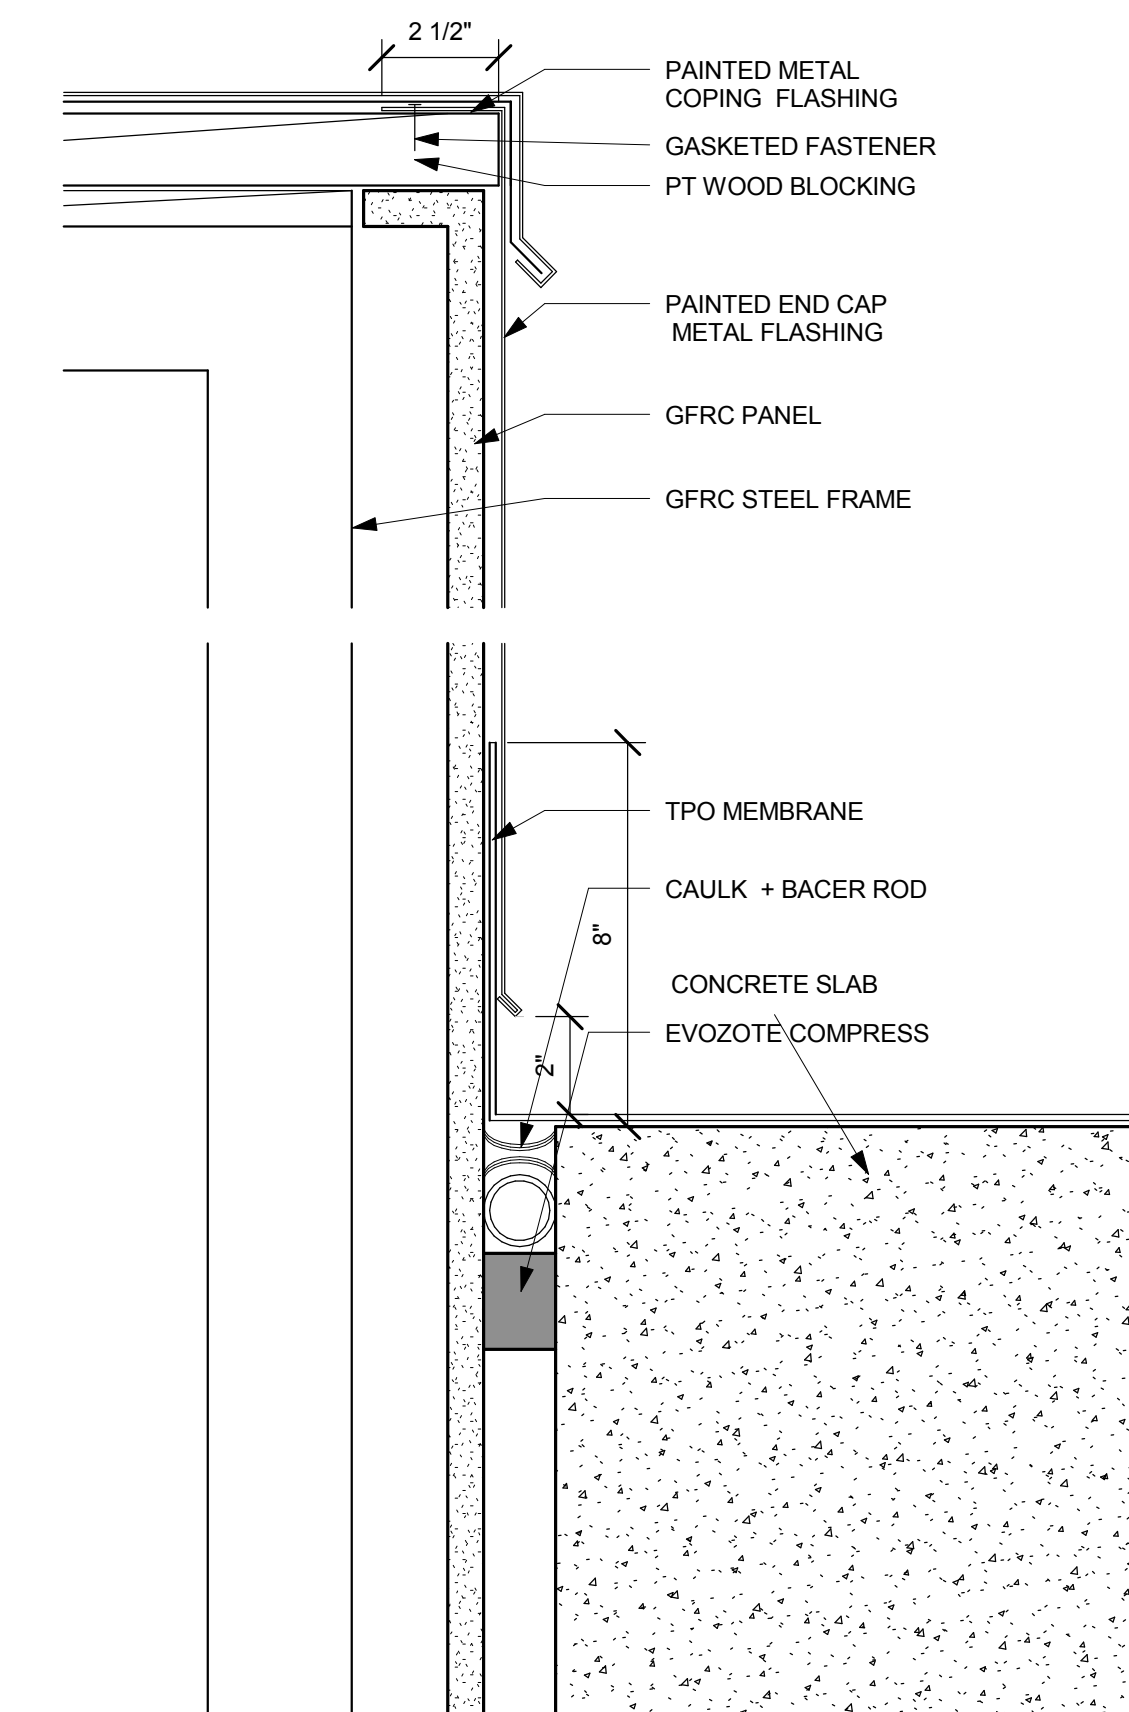

**5** STRIKE END CAP @ GFRc  
3" = 1'-0"

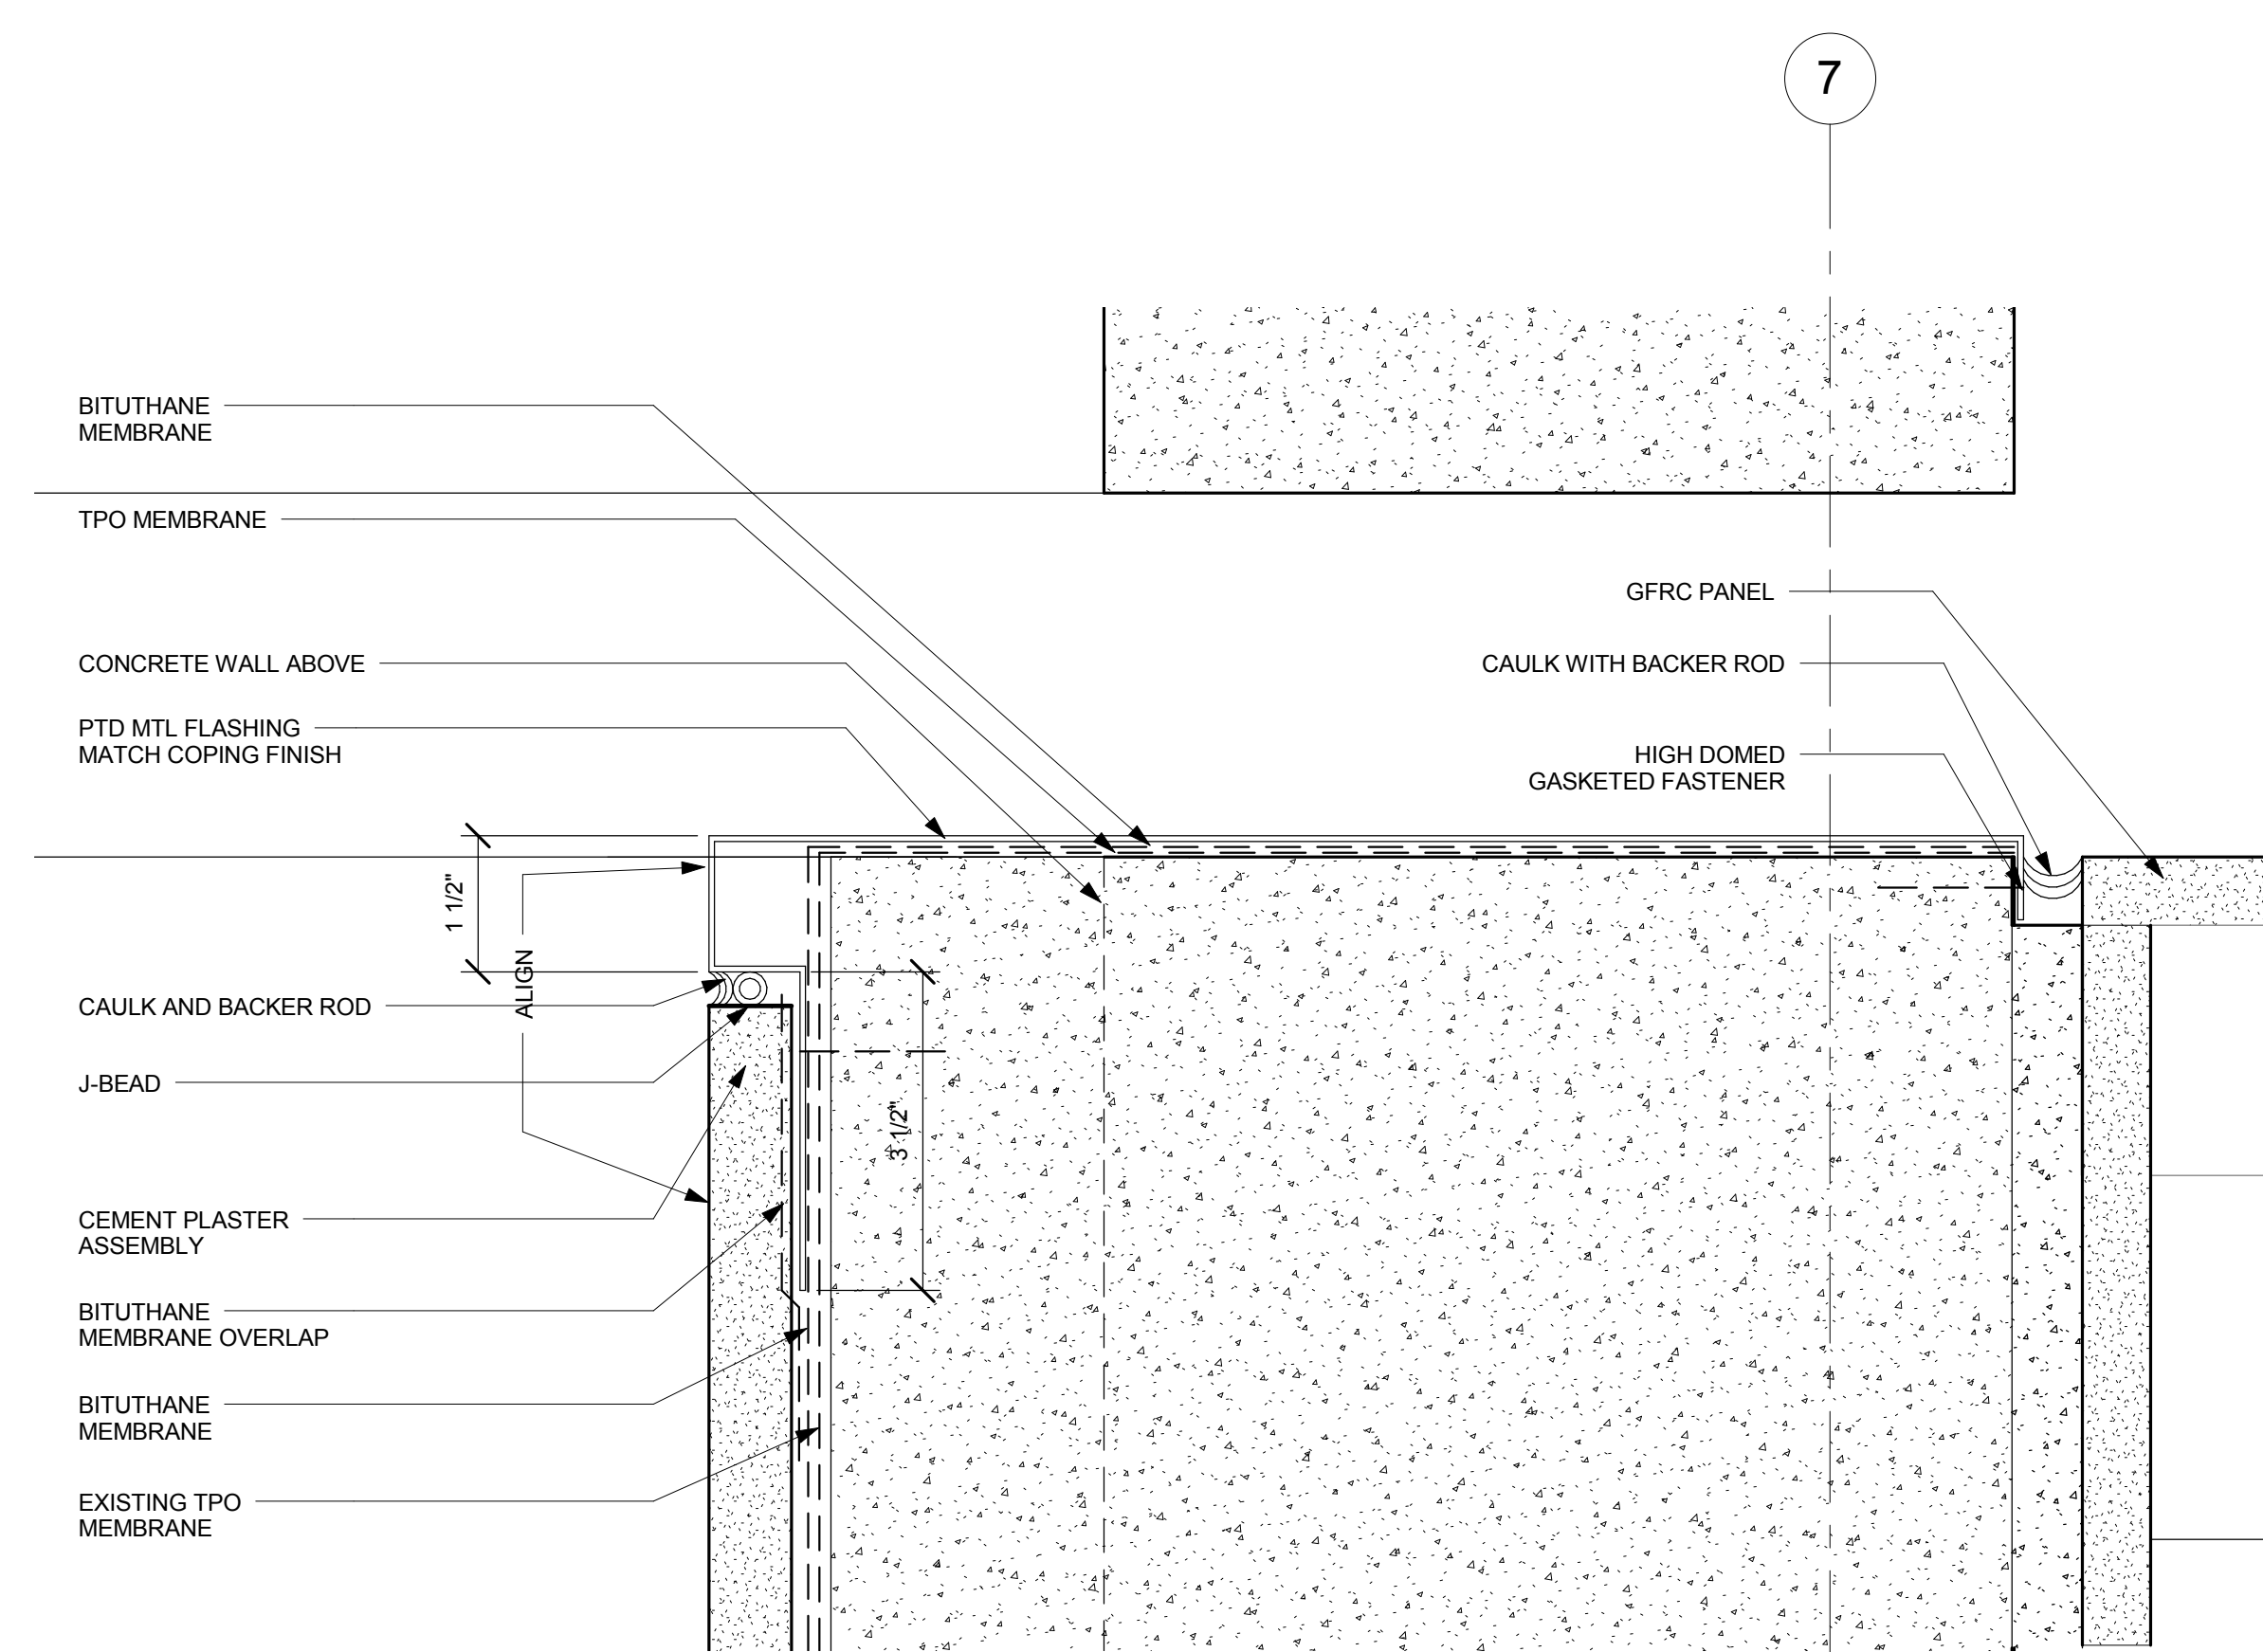

**2** B7 TERRACE END CAP DETAIL  
6" = 1'-0"

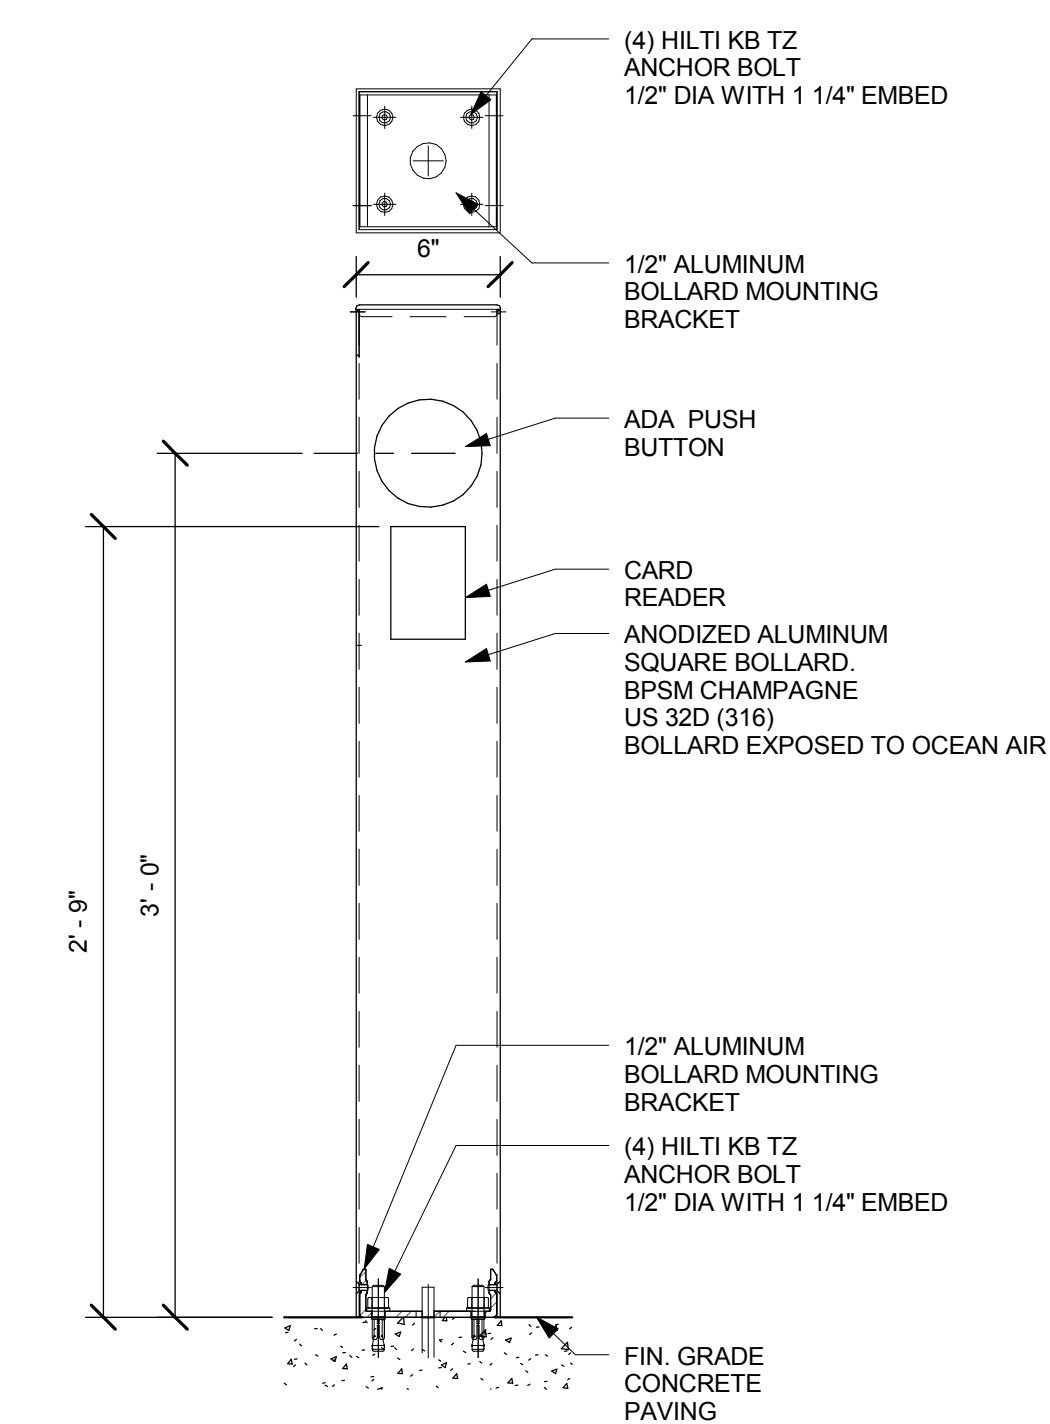

**1** ADA AND CARD READER BOLLARD  
1 1/2" = 1'-0"

PROJECT  
RECORD SET

BUILDING 4  
SKYLINE COLLEGE

SAN MATEO COUNTY  
COMMUNITY COLLEGE  
DISTRICT

CIP2 DESIGN-BUILD  
PROJECT  
BUILDING 4

PROJECT NO: 07012.00 DRAWN BY: Author  
DATE: 05/20/10 CHECKED BY: Checker  
SCALE: As indicated

SHEET TITLE:  
EXTERIOR  
DETAILS

SHEET NO: