




4 SAUNA DOOR THRESHOLD  
3" = 1'-0"

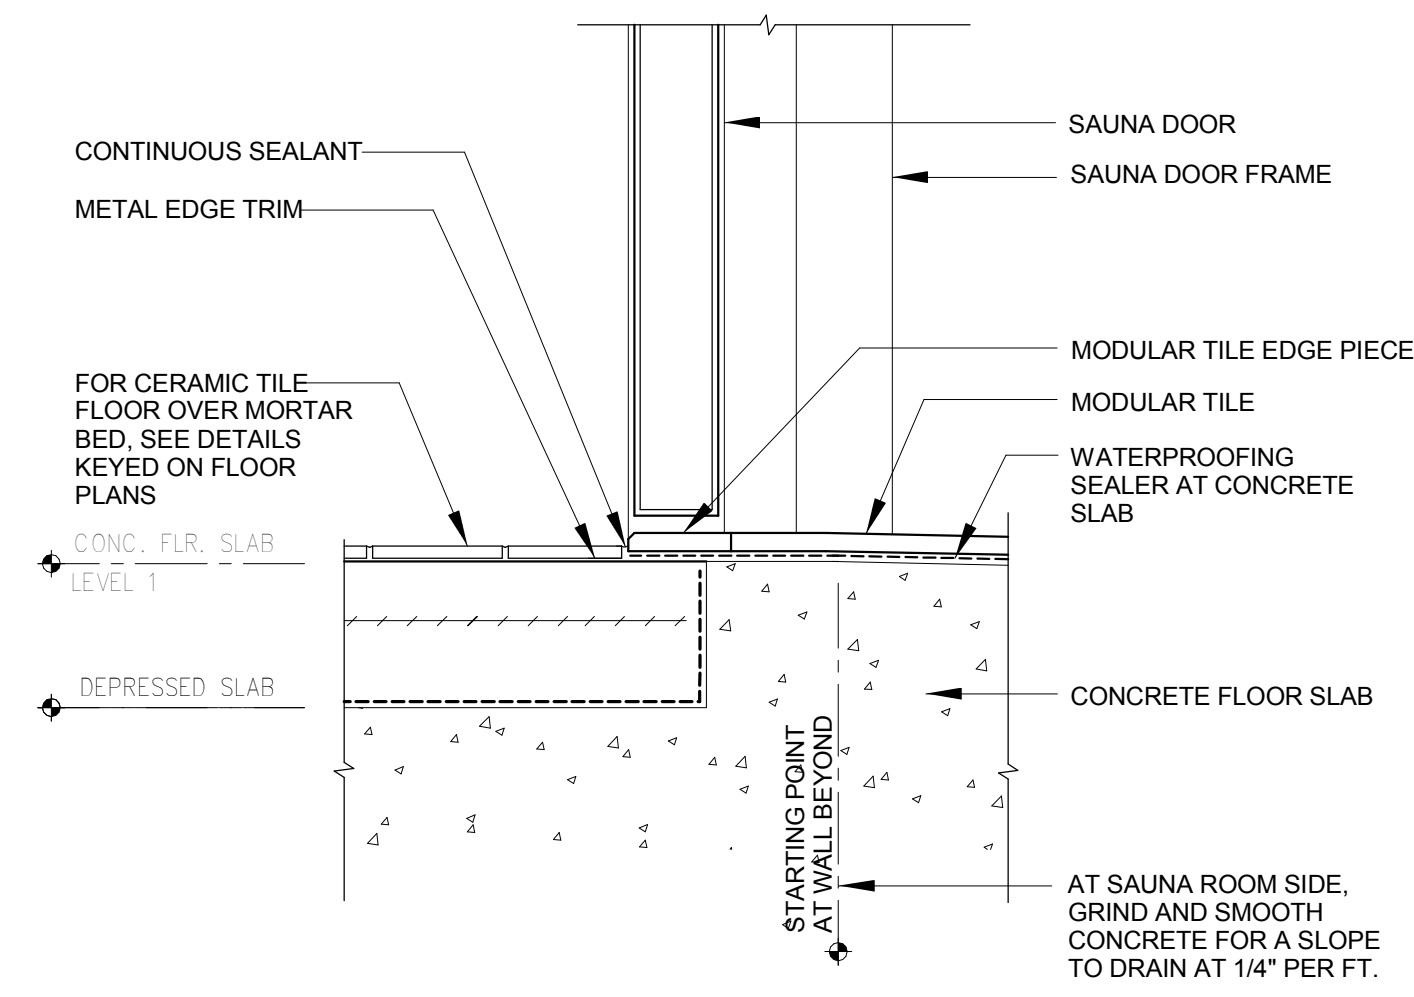


8 SAUNA DOOR JAMB (HEAD SIMILAR)  
3" = 1'-0"

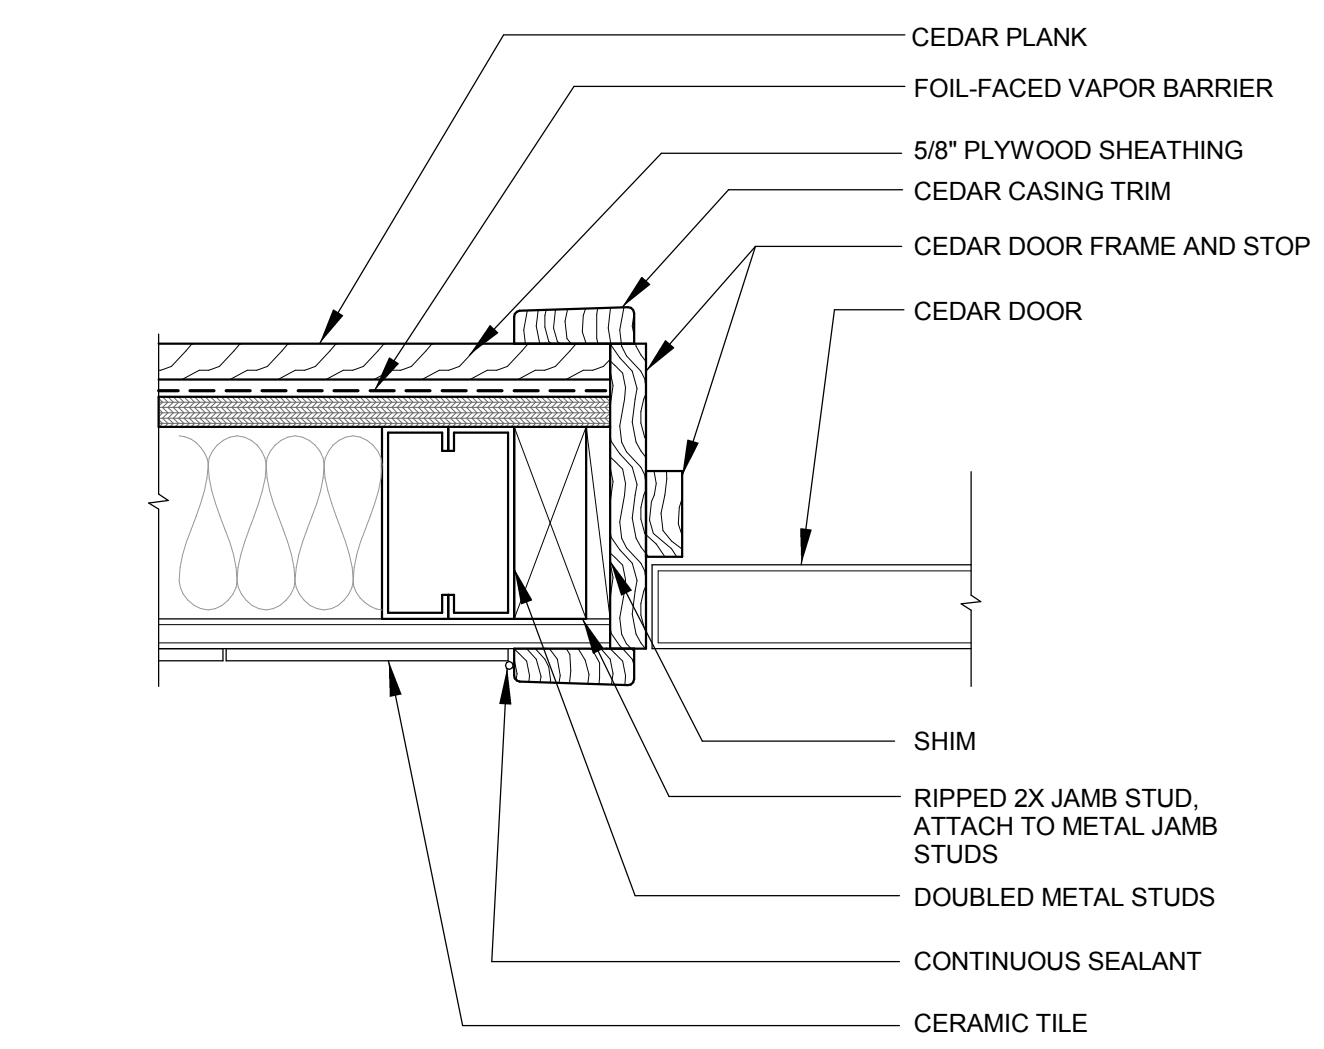


12 SAUNER EXHAUST VENT  
3" = 1'-0"

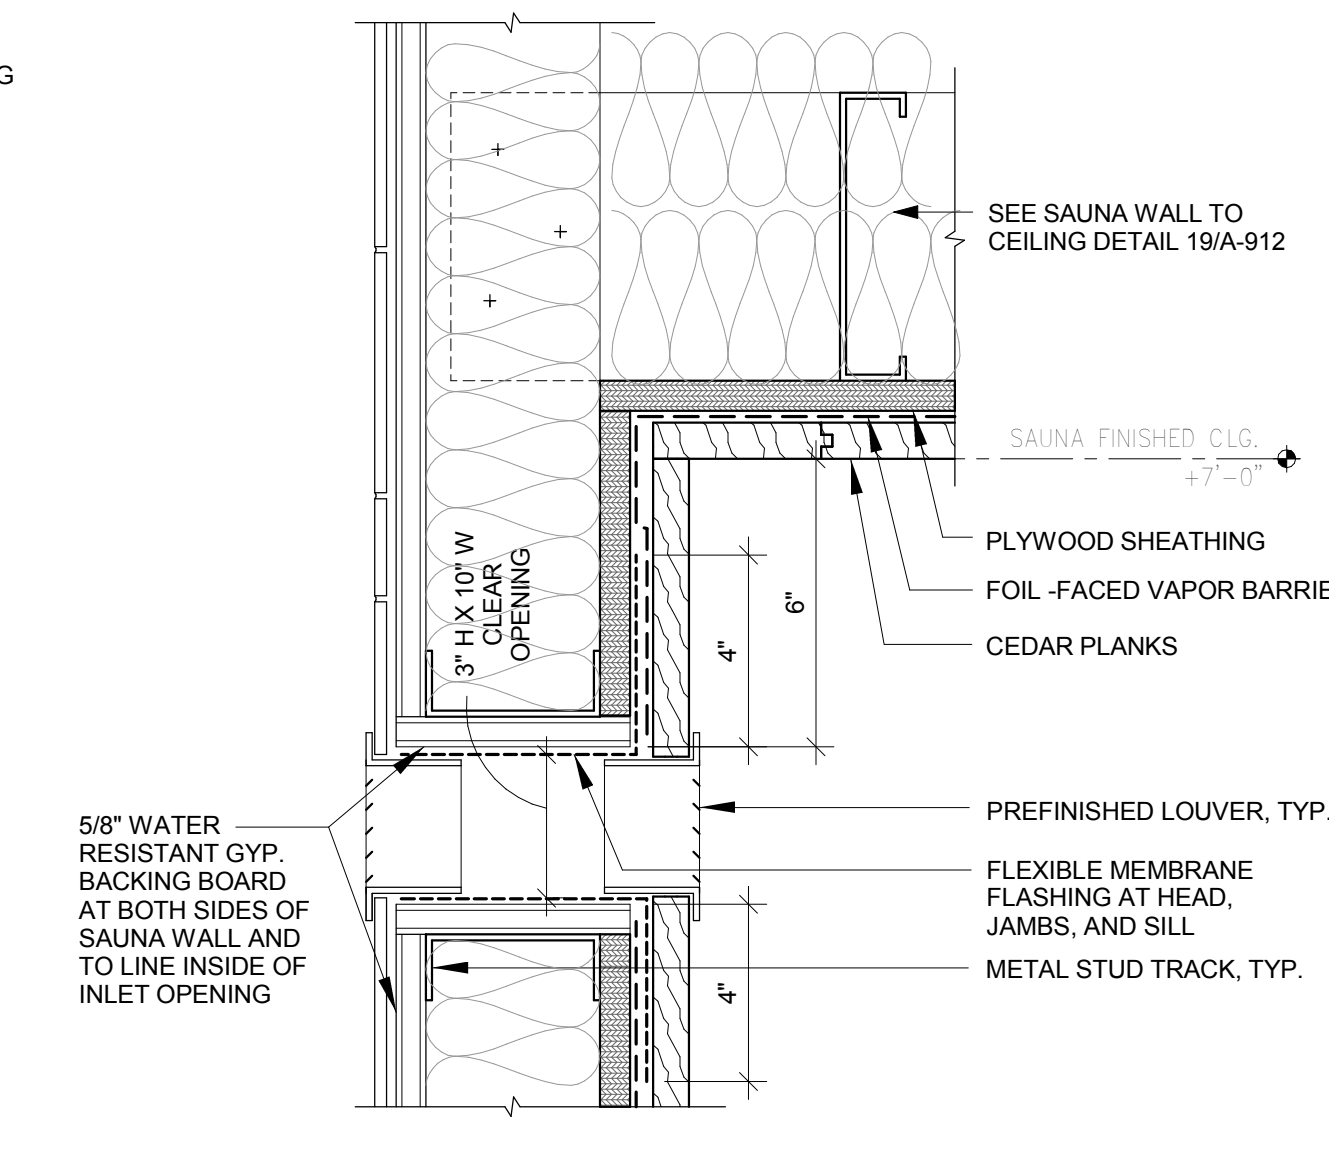


16 SAUNA INTAKE VENT  
3" = 1'-0"

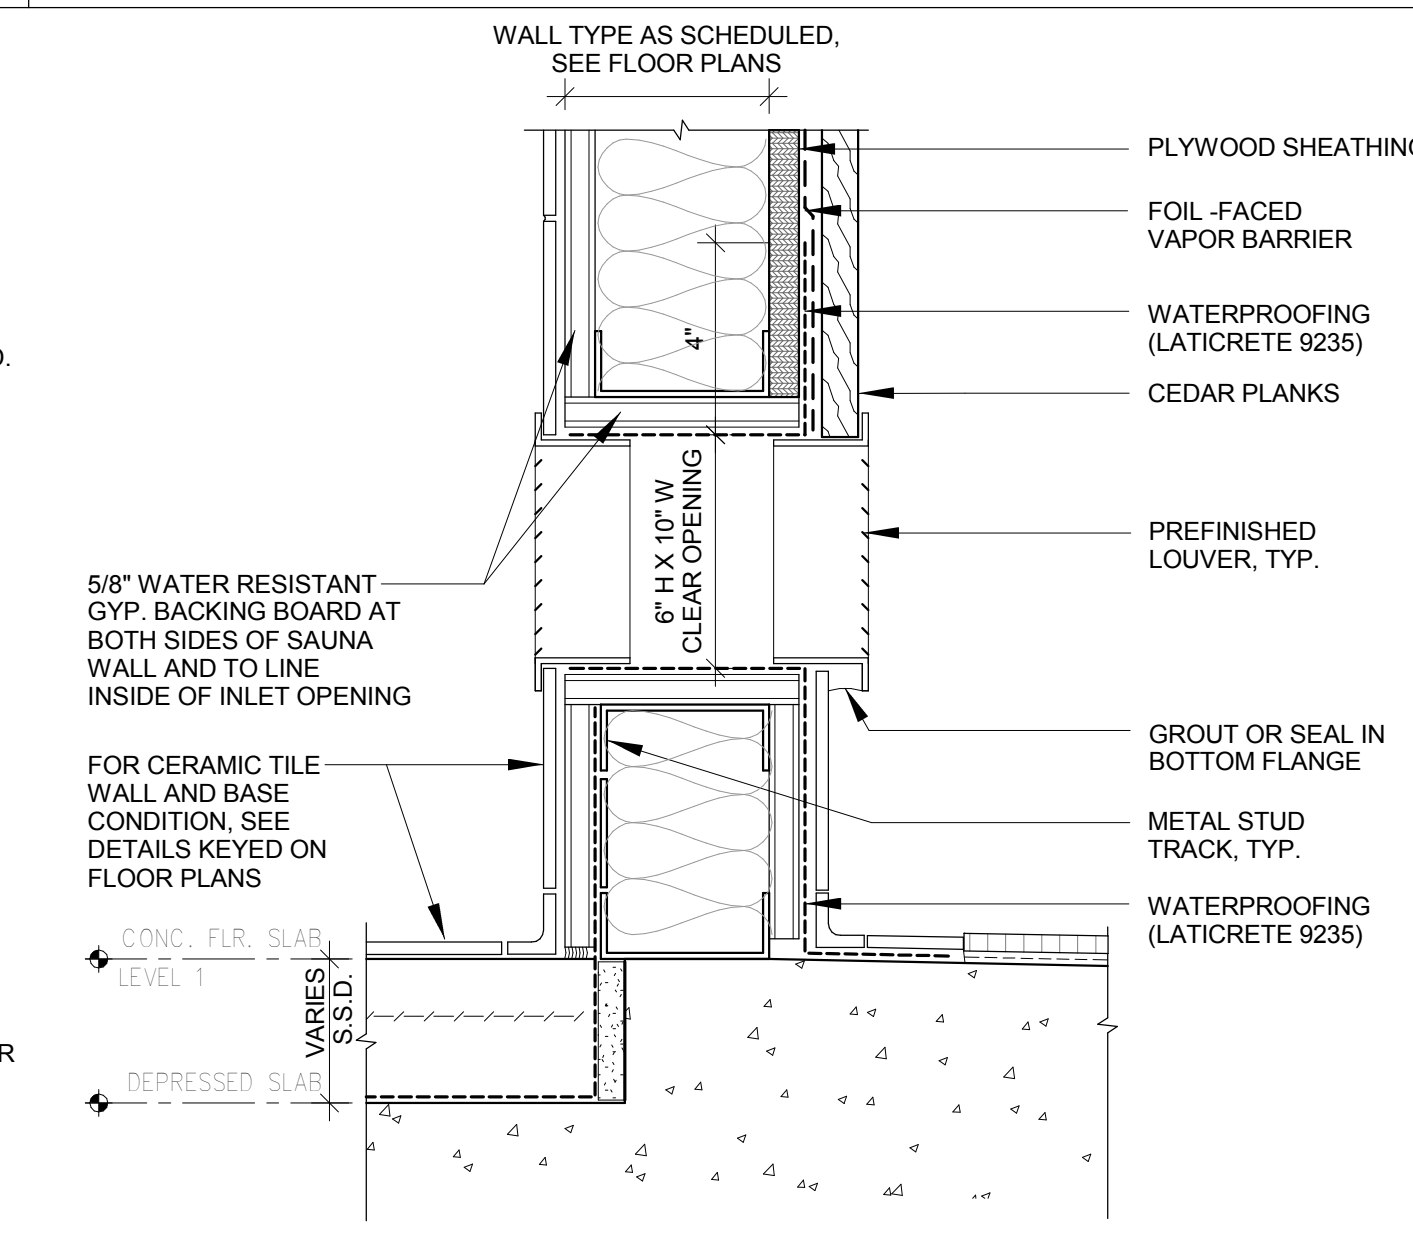


20 SAUNA WALL BASE - MORTAR BED  
3" = 1'-0"

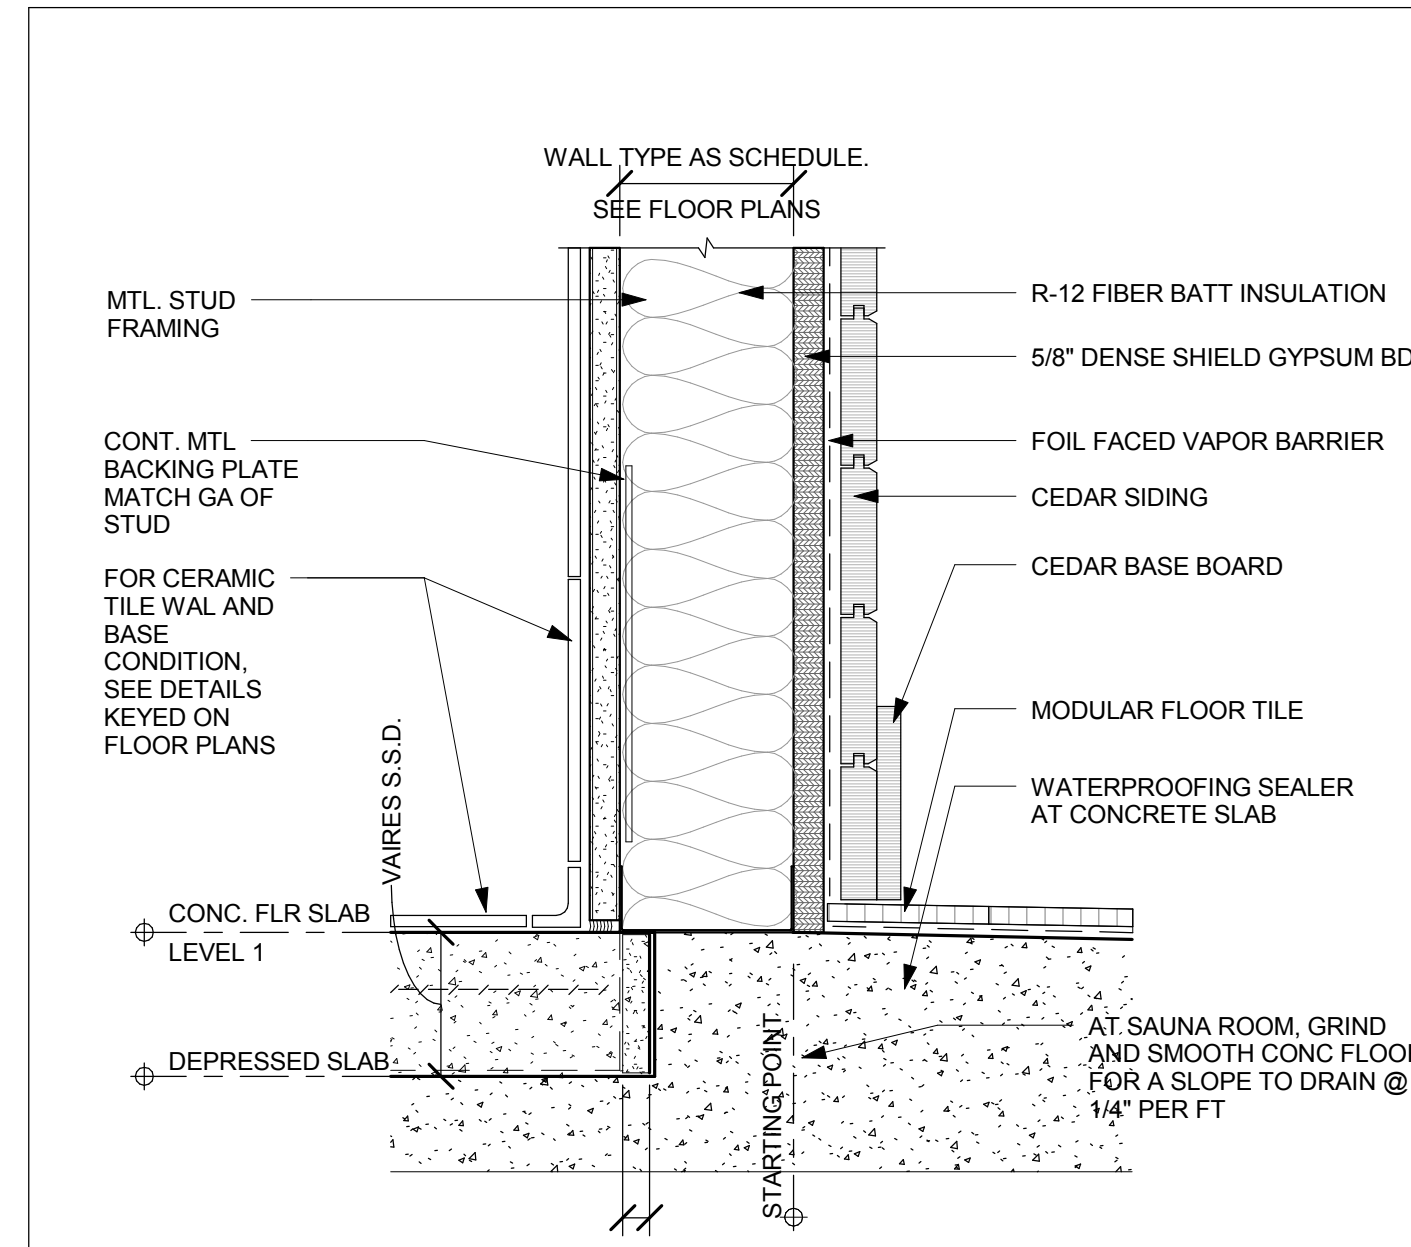


3 DOOR THRESHOLD - MORTAR BED  
3" = 1'-0"

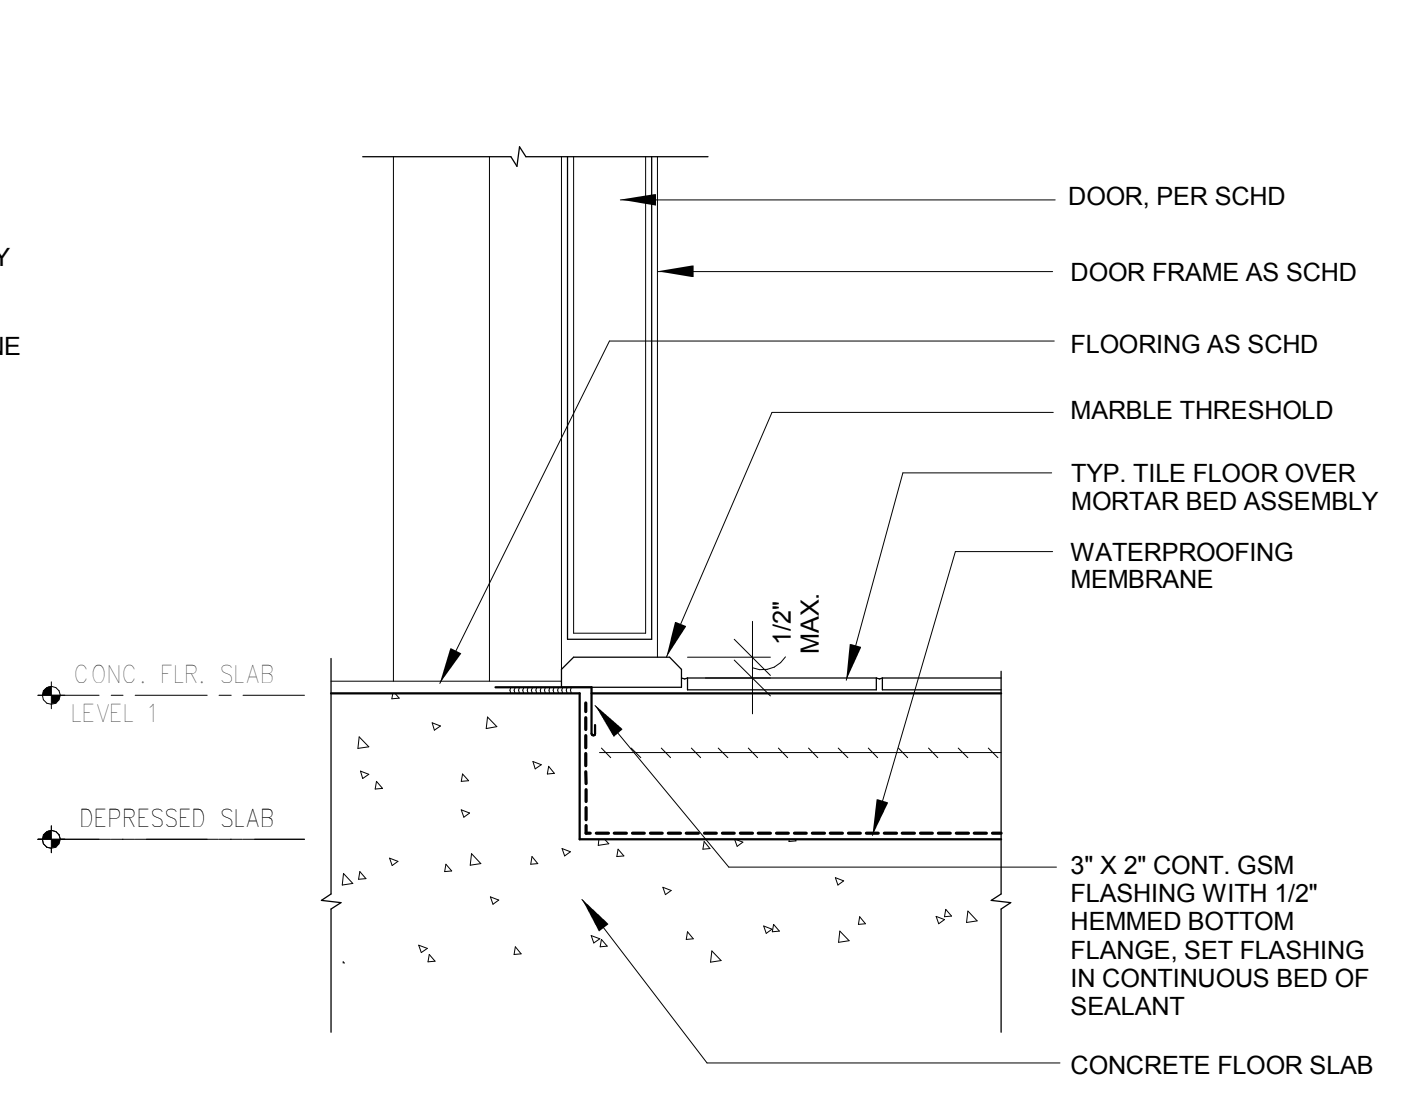


7 TYP. FLOOR DRAIN - THINSET  
3" = 1'-0"

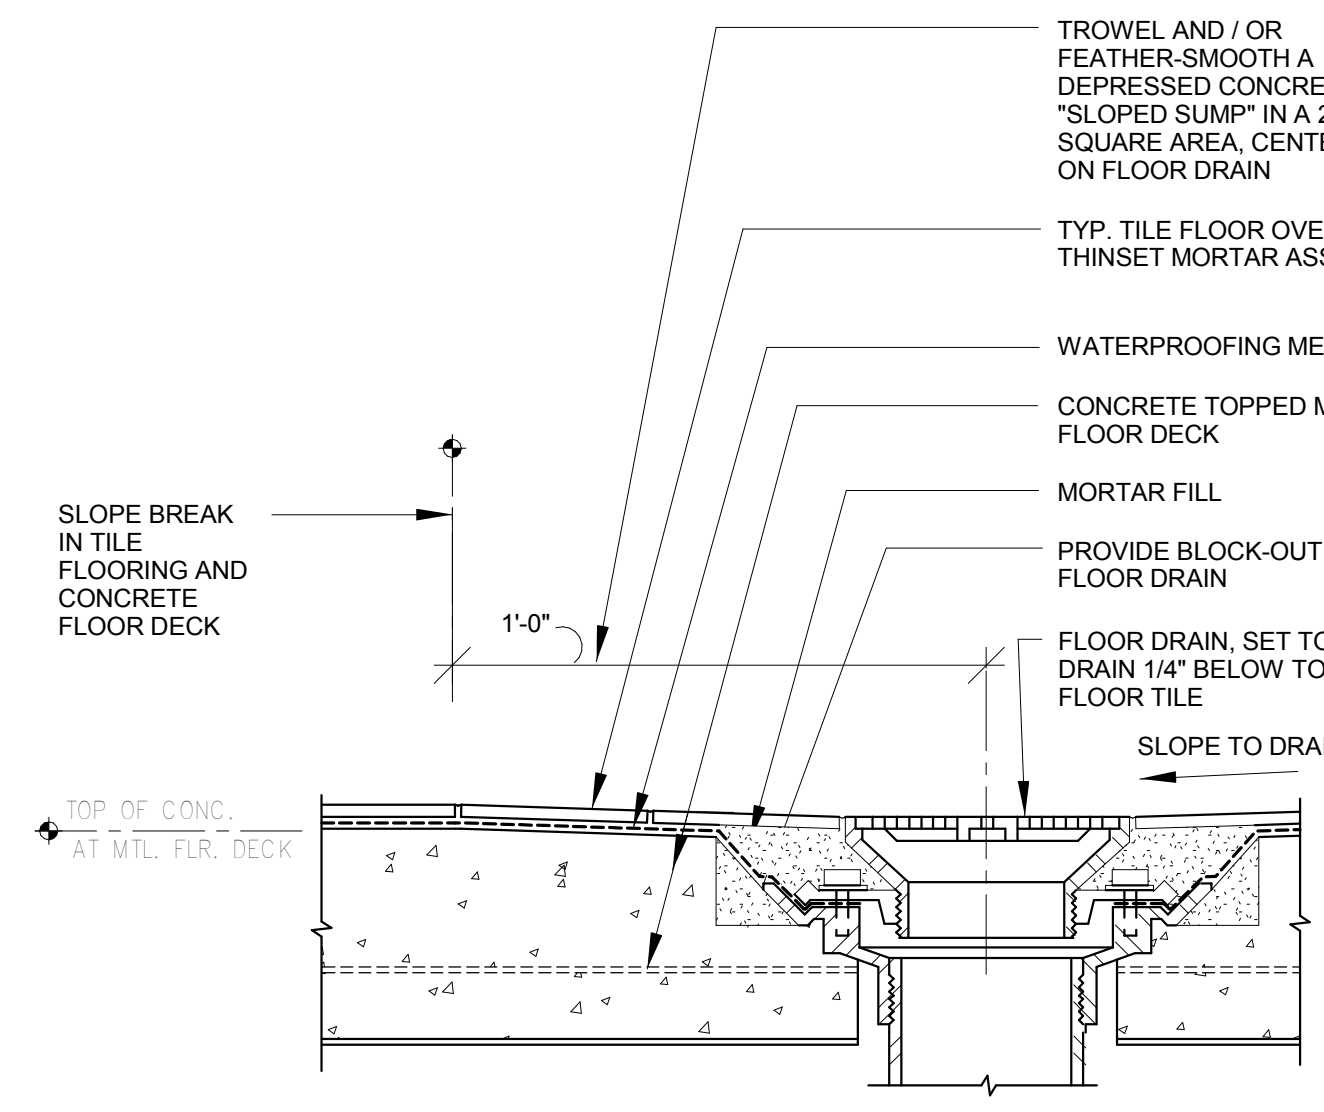


11 TYP. TILE FLOOR - THINSET  
3" = 1'-0"

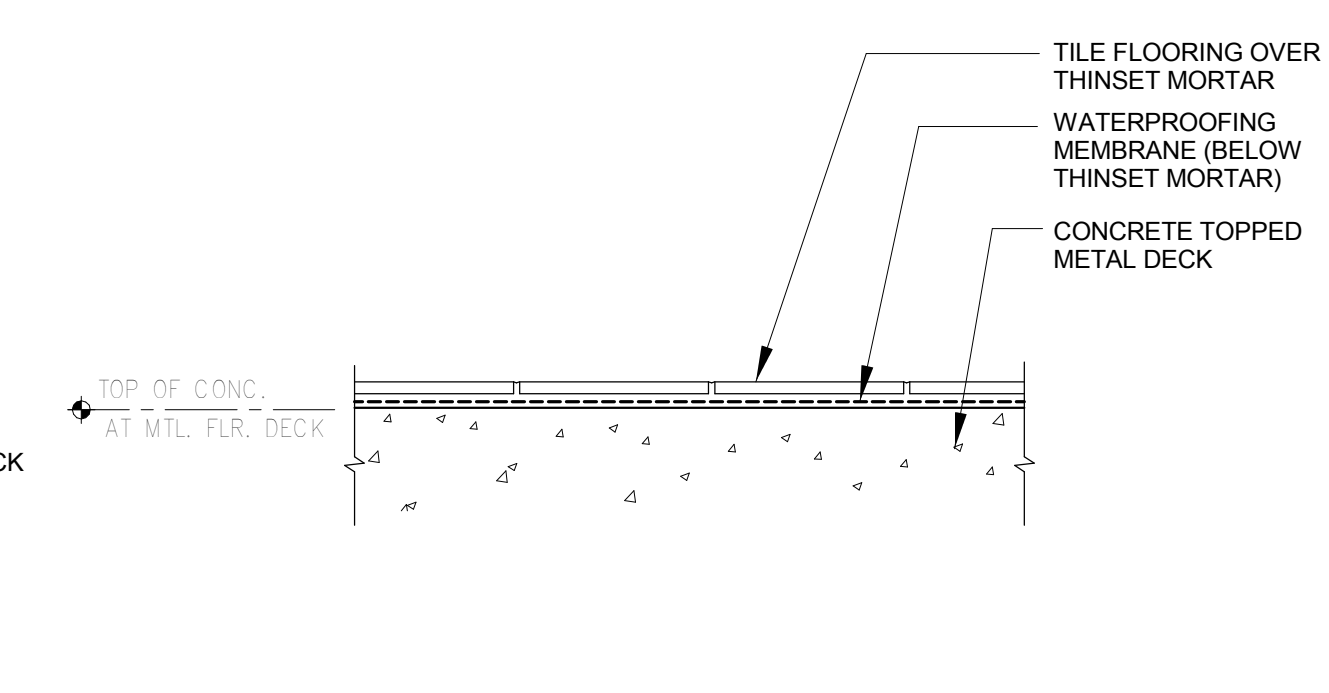


15 WALL BASE - THINSET - BOTH SIDE  
3" = 1'-0"

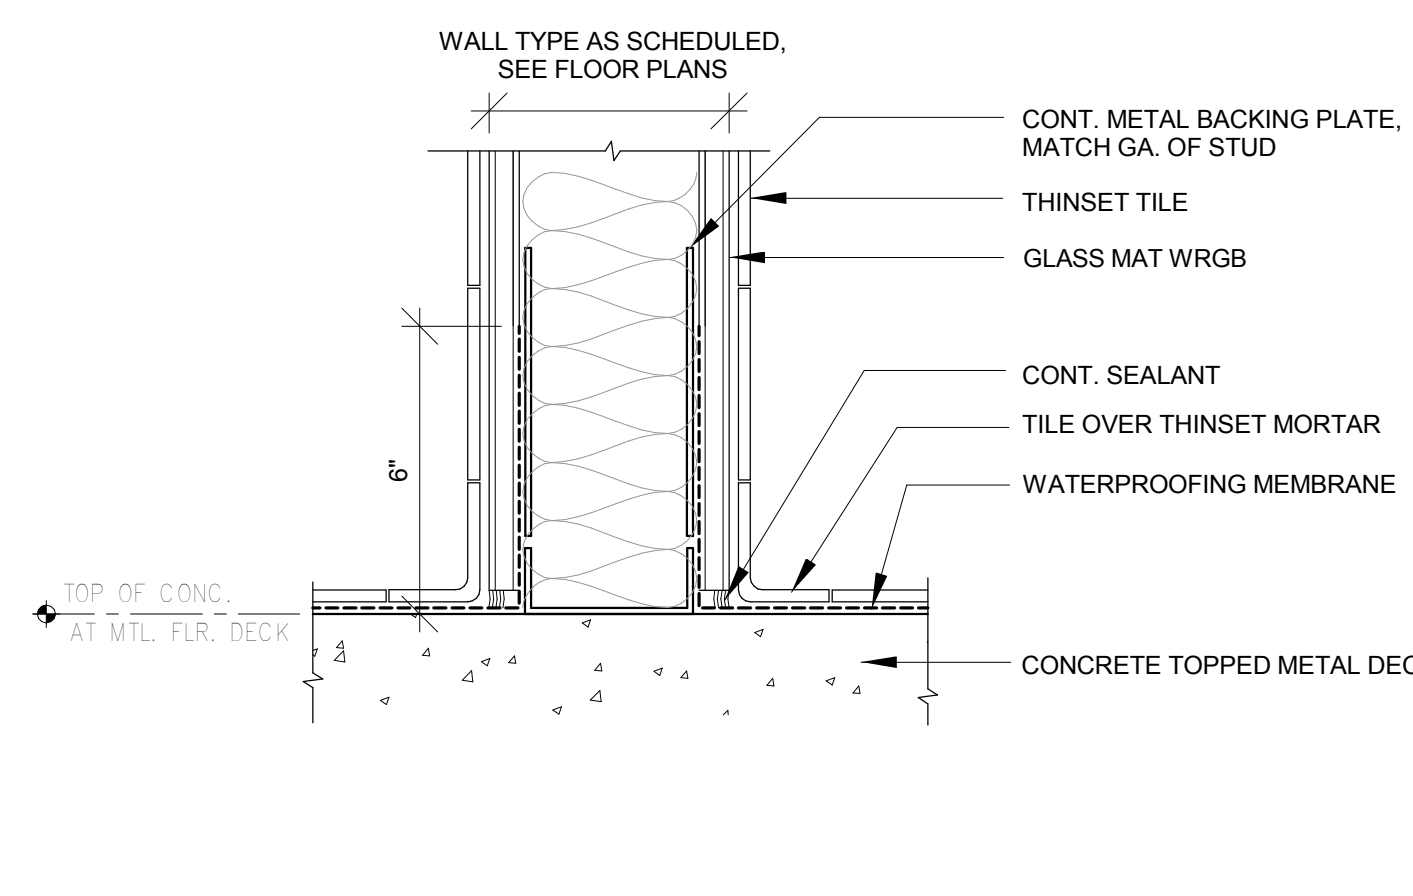


19 TYP. WALL BASE - THINSET  
3" = 1'-0"

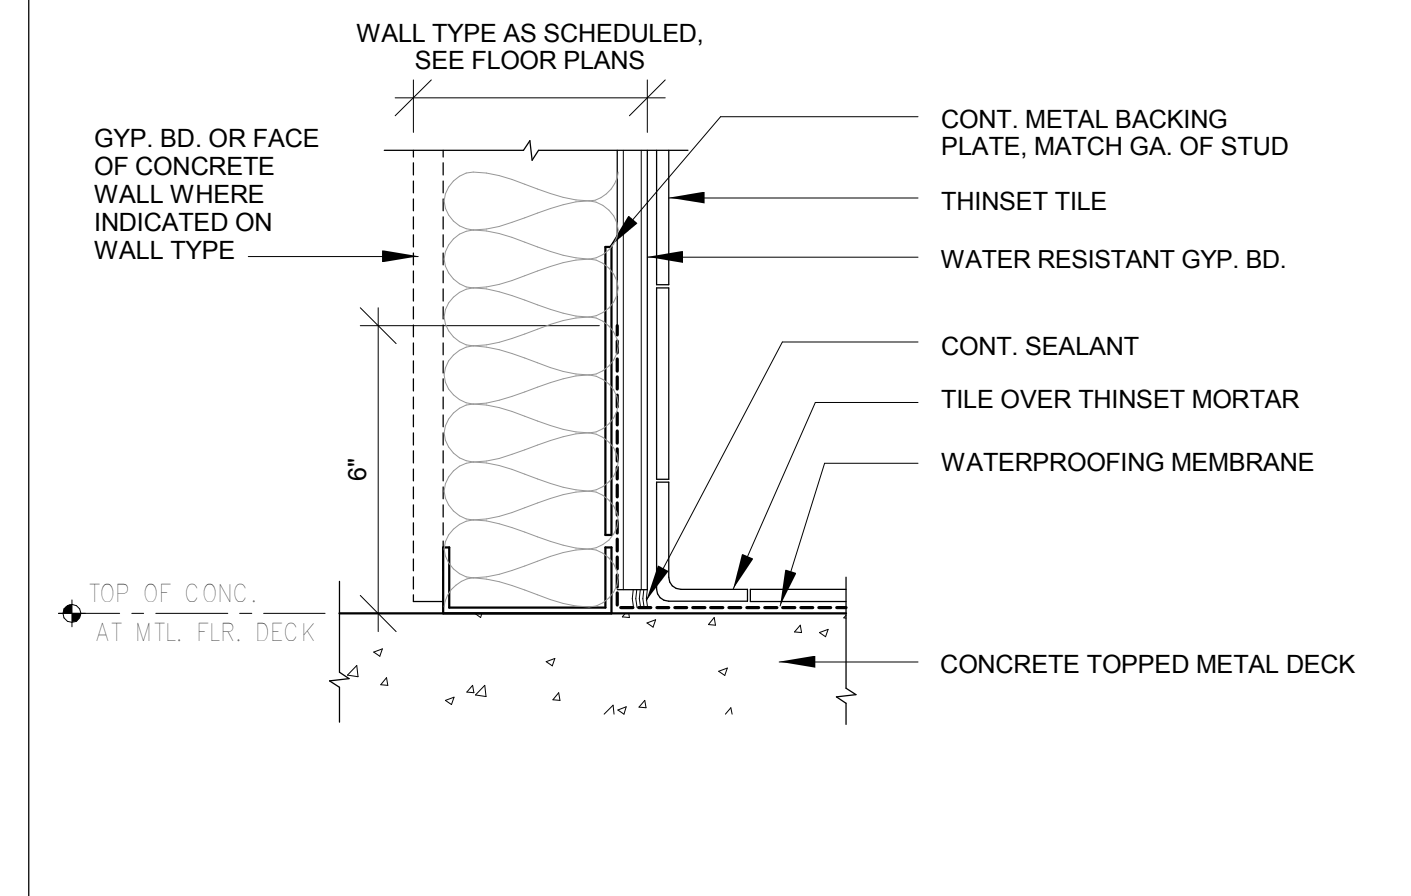


2 FLOOR TRANSITION - MORTAR BED  
3" = 1'-0"

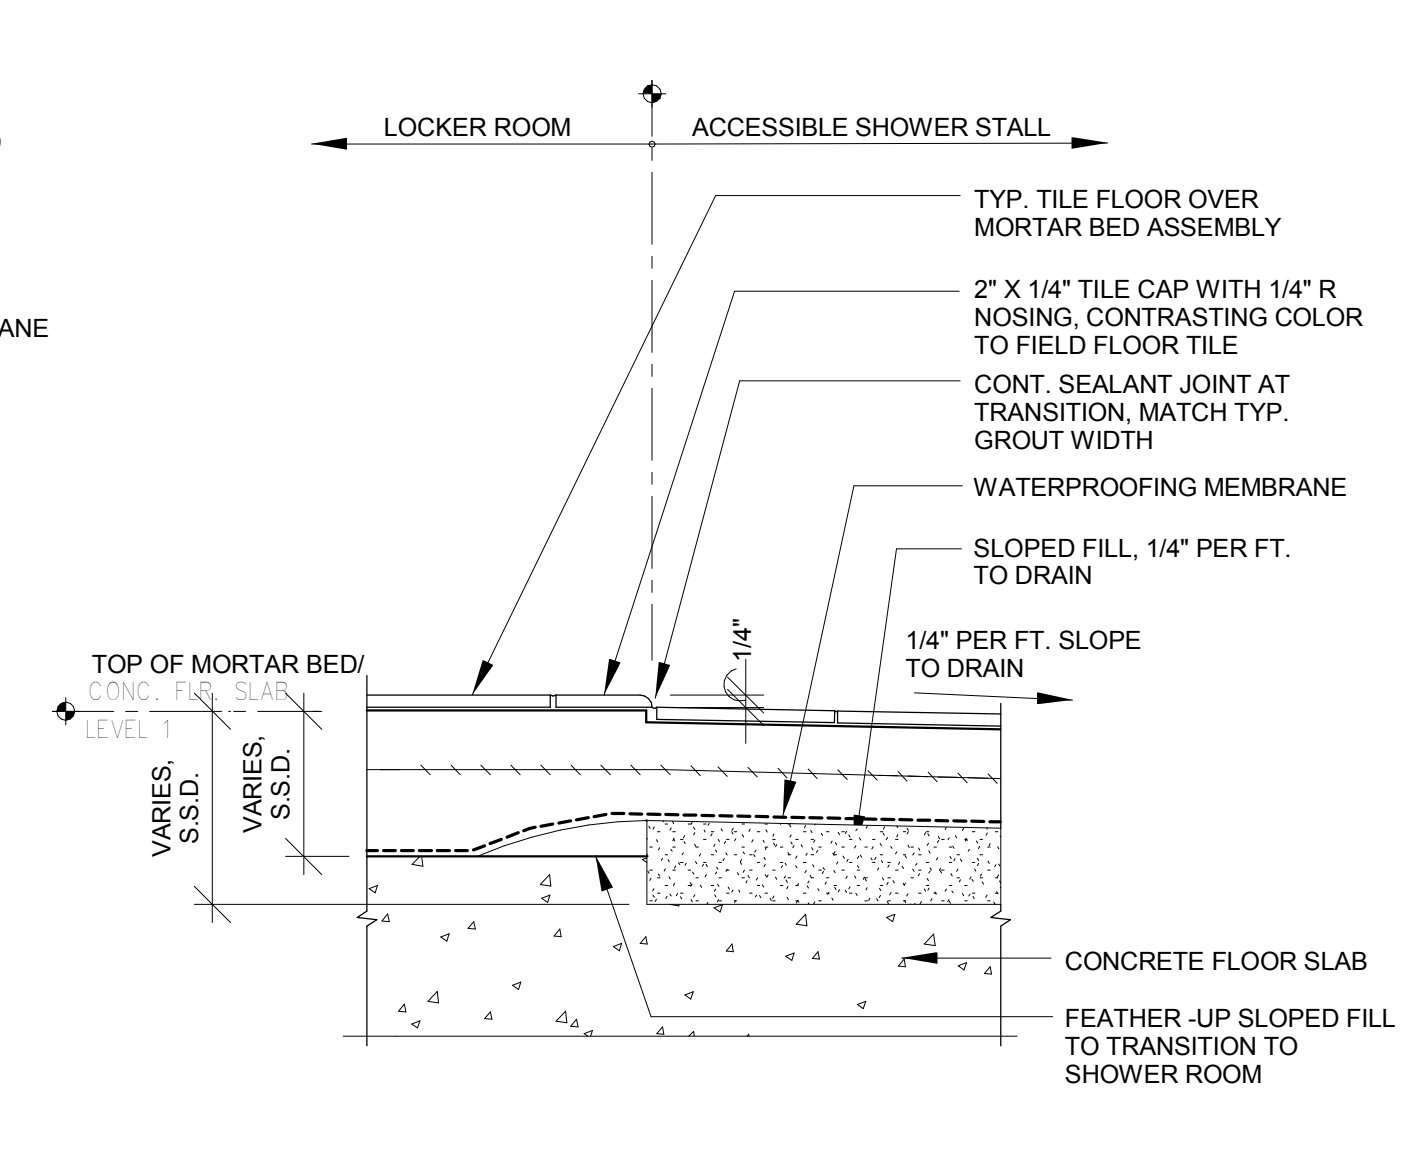


6 TYP. FLOOR DRAIN - MORTAR BED  
3" = 1'-0"

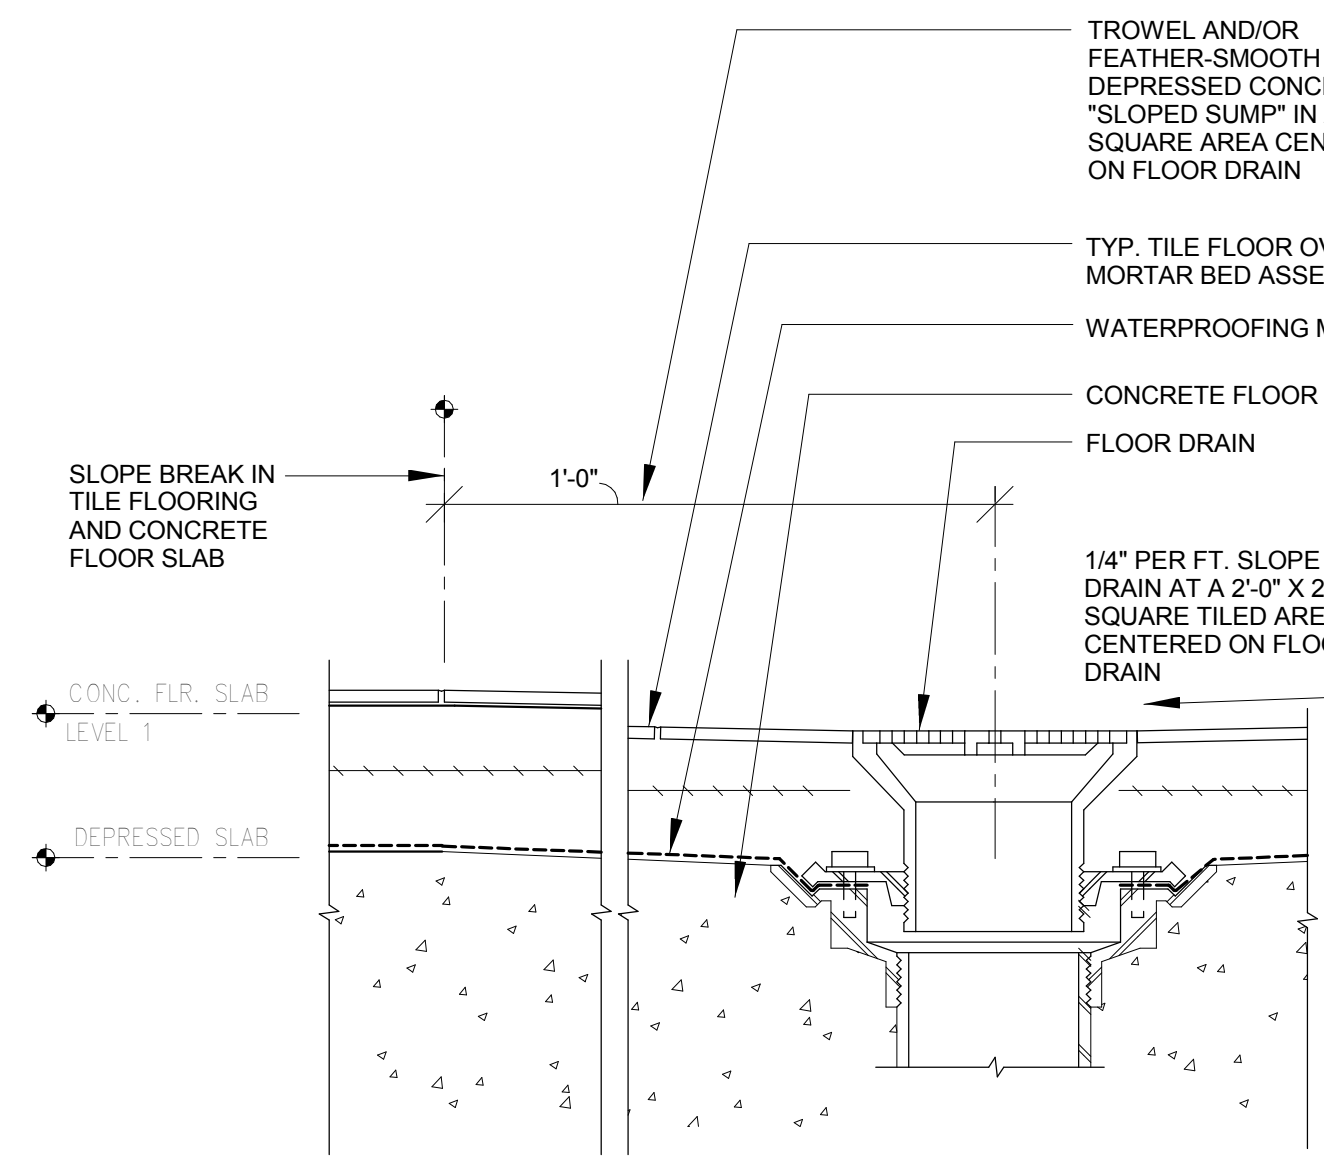


10 TYP. TILE FLOOR - MORTAR BED  
3" = 1'-0"

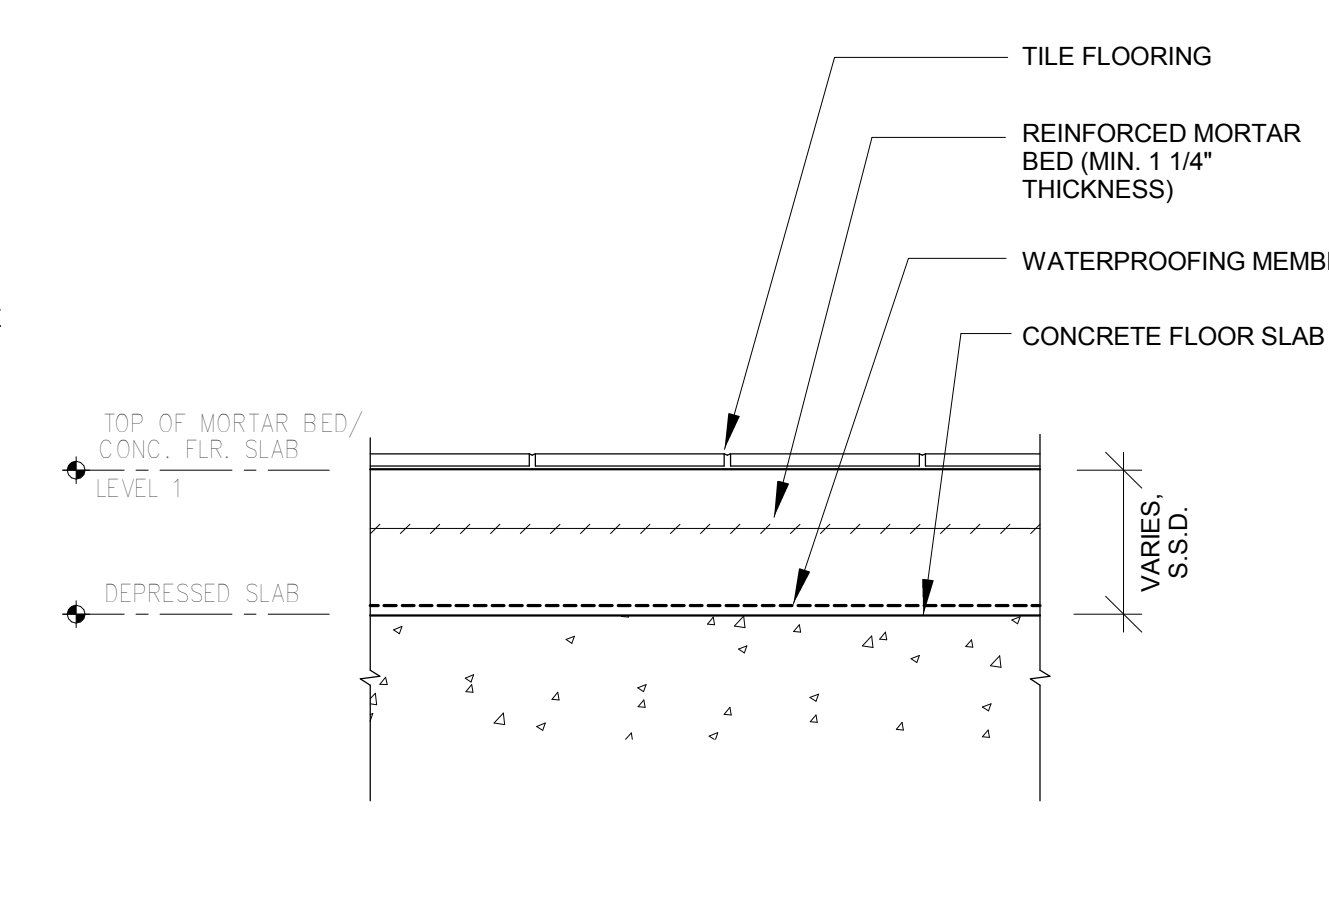


14 WALL BASE - MORTAR BED  
3" = 1'-0"

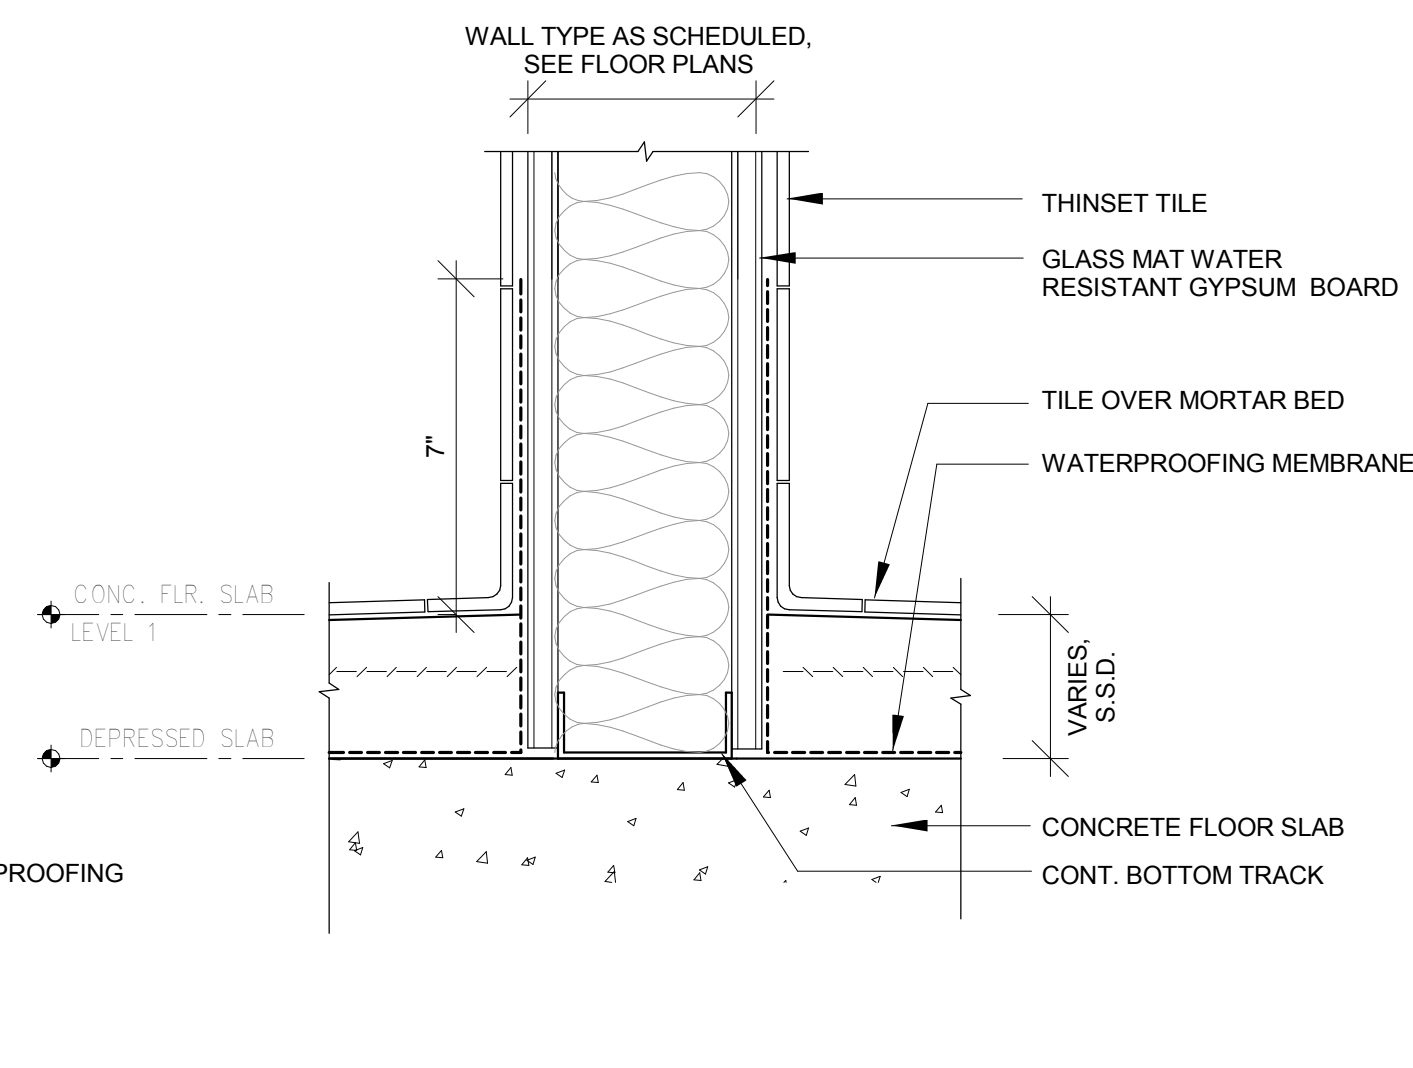


18 TYP. WALL BASE - MORTAR BED  
3" = 1'-0"

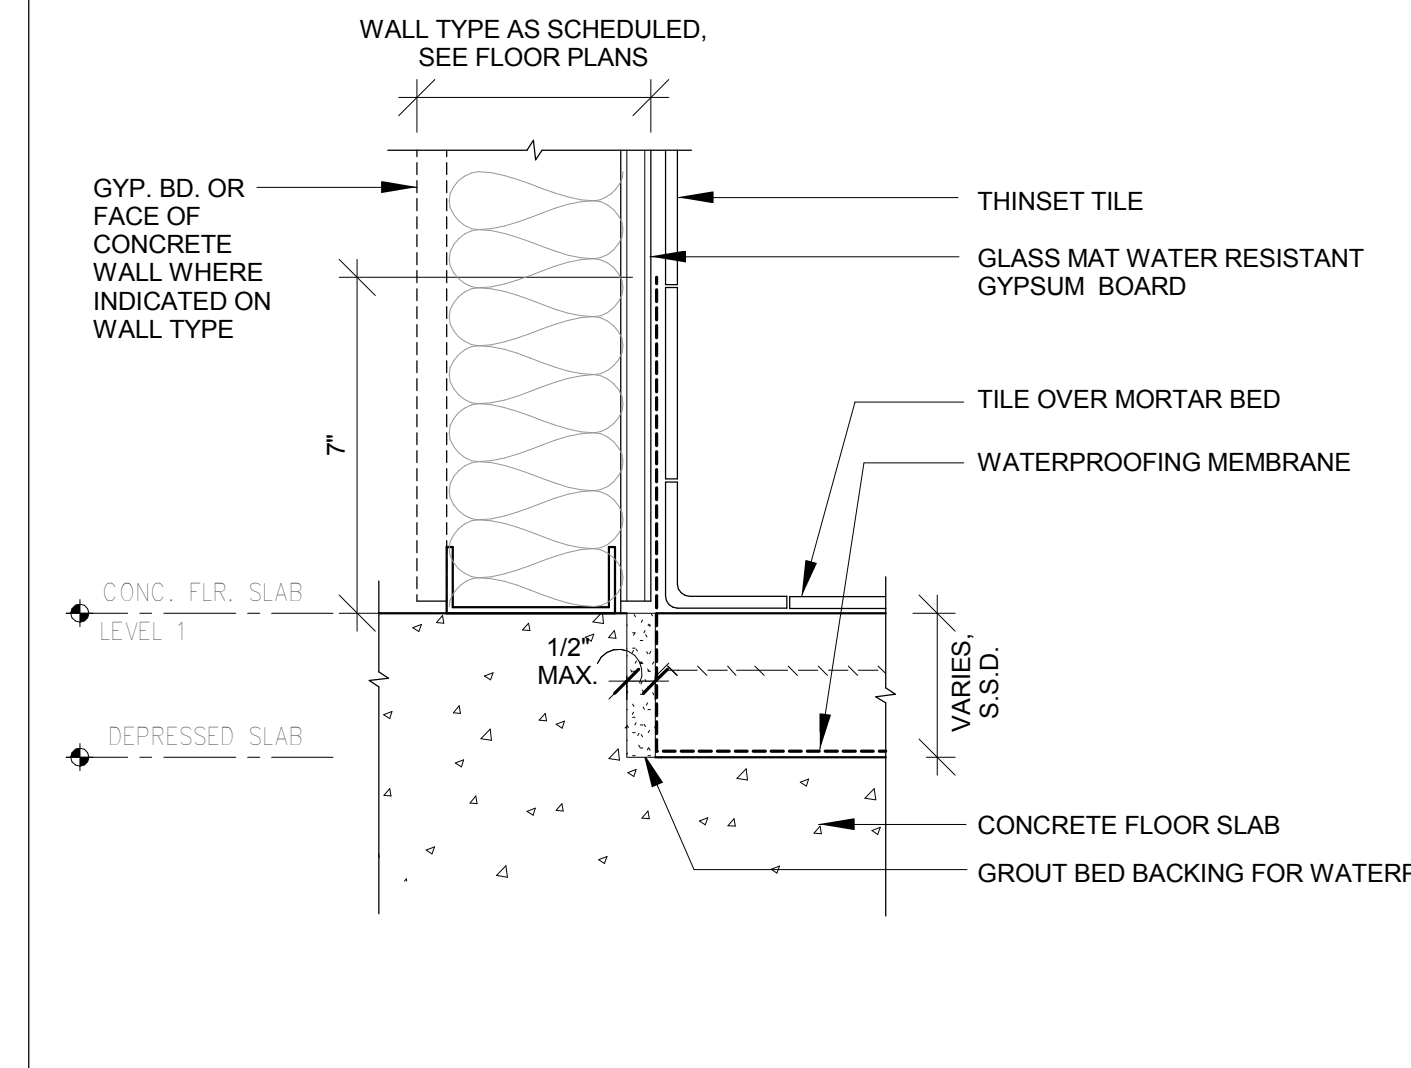


1 TYP. CURB AT SHOWER  
3" = 1'-0"

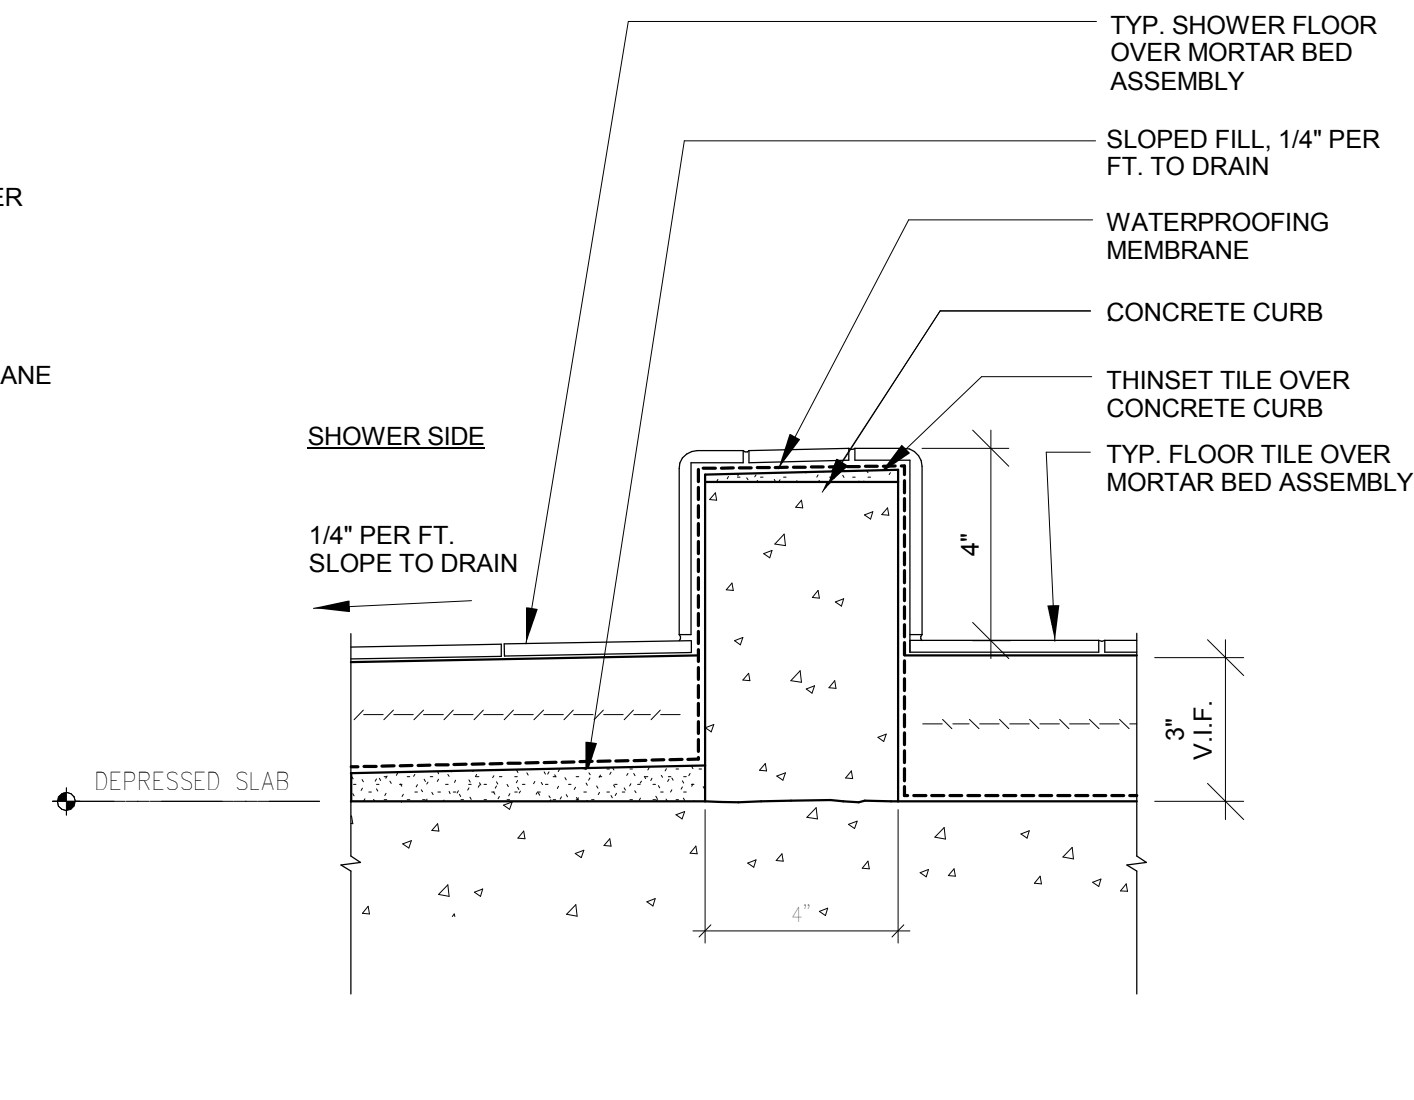


05 TYP. FLOOR DRAIN - SHOWER  
3" = 1'-0"

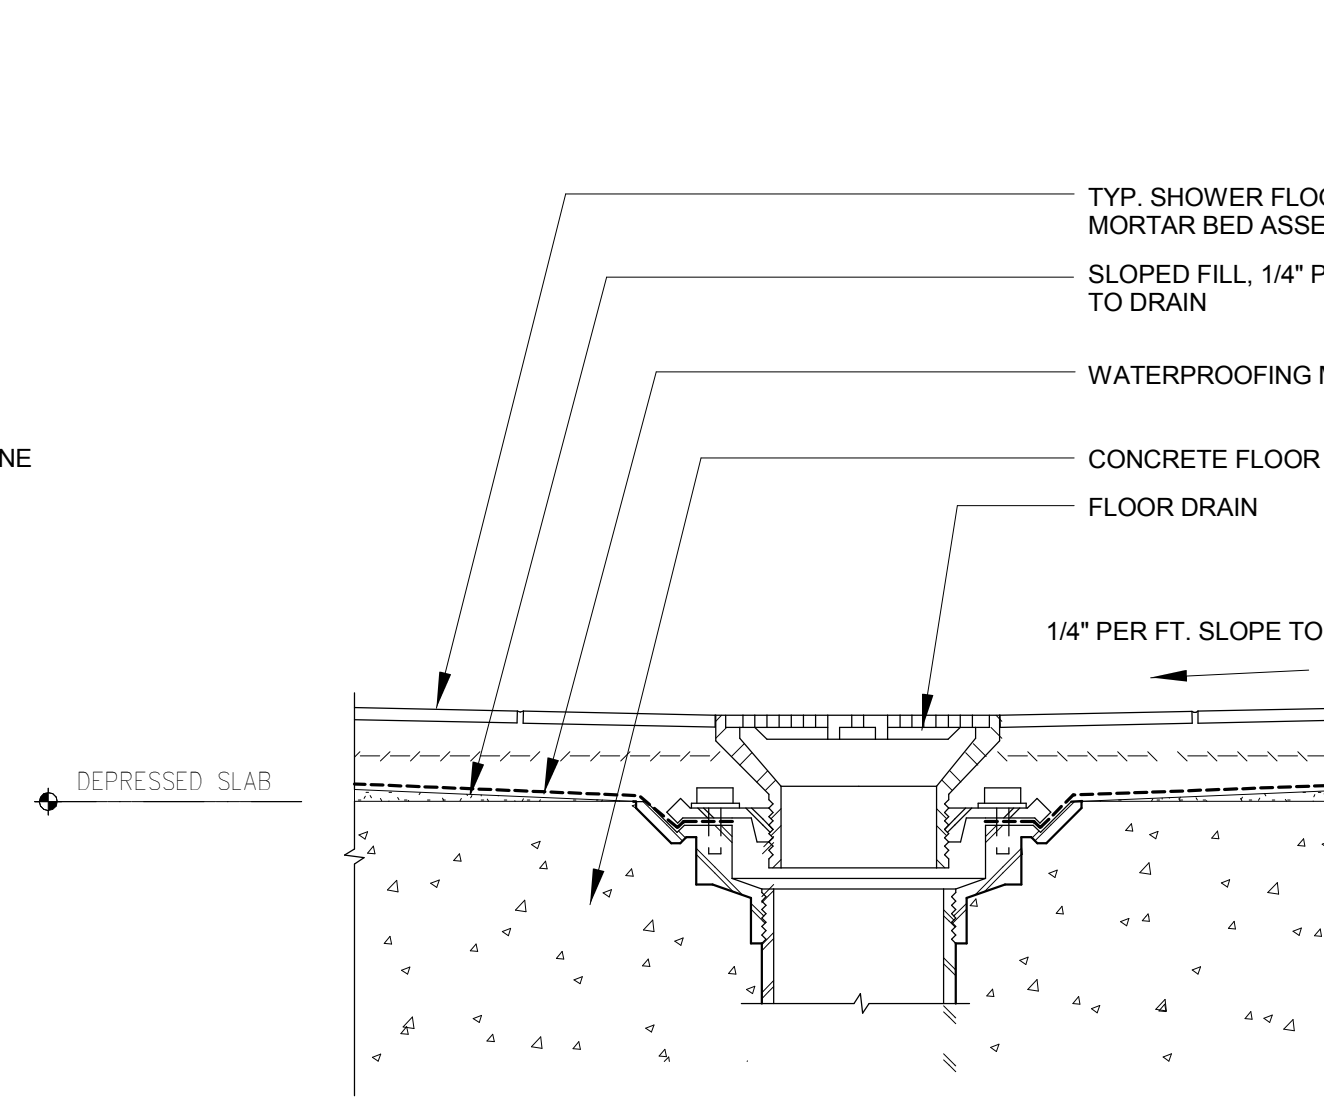

9 TYP. SHOWER FLOOR  
3" = 1'-0"

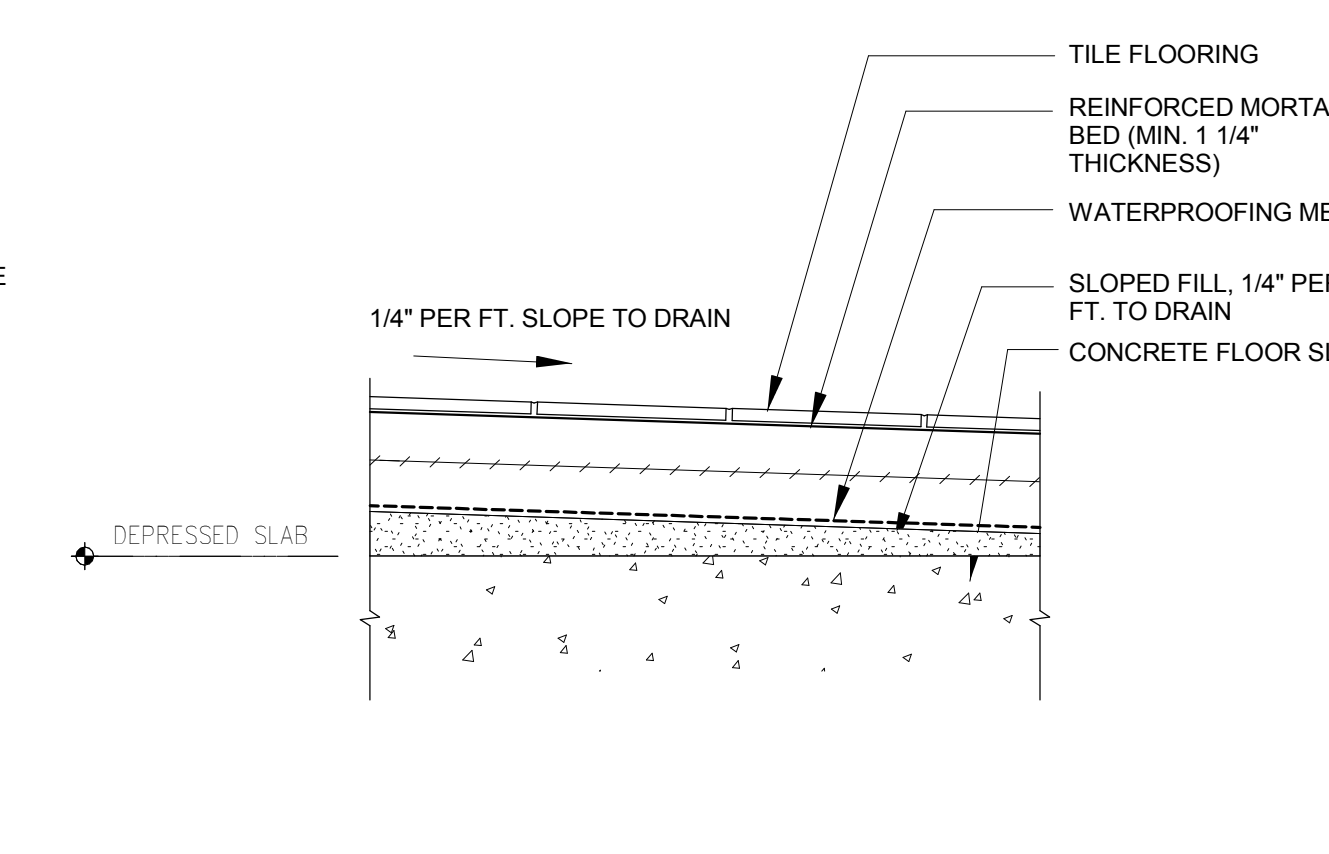

13 WALL BASE AT SHOWER  
3" = 1'-0"

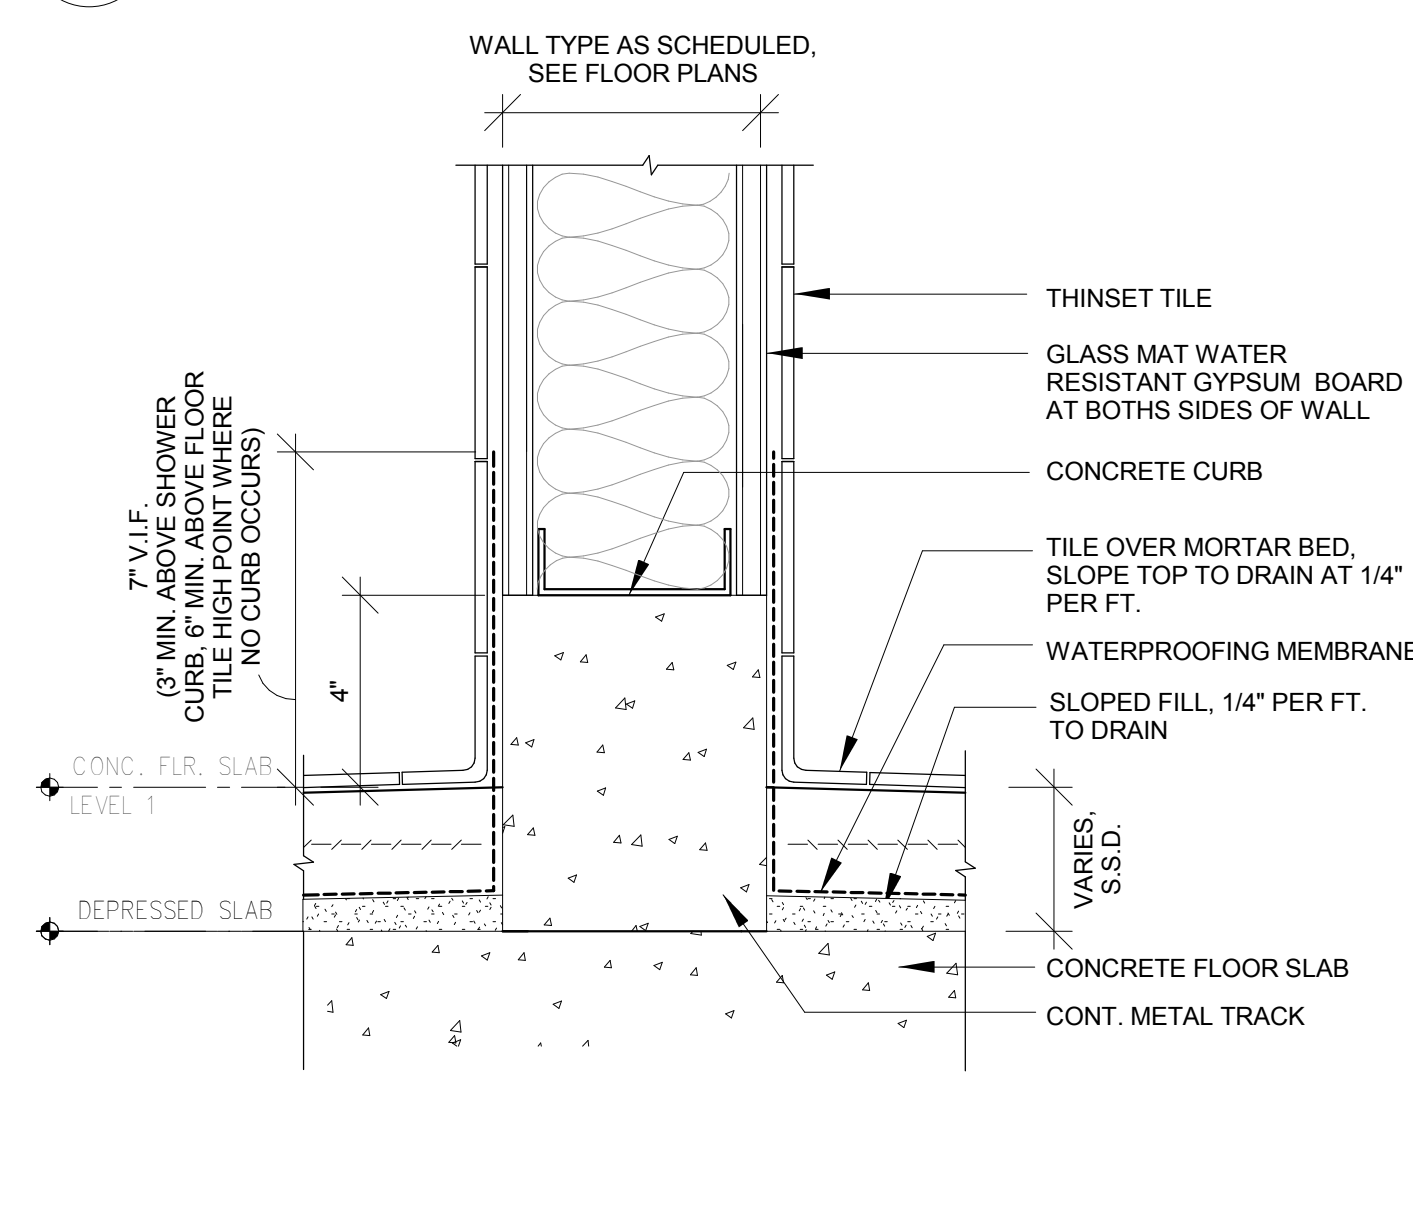

17 TYP. WALL BASE - AT SHOWER  
3" = 1'-0"

