




6 TILE WALL AT PASS THRU
6" = 1'-0"

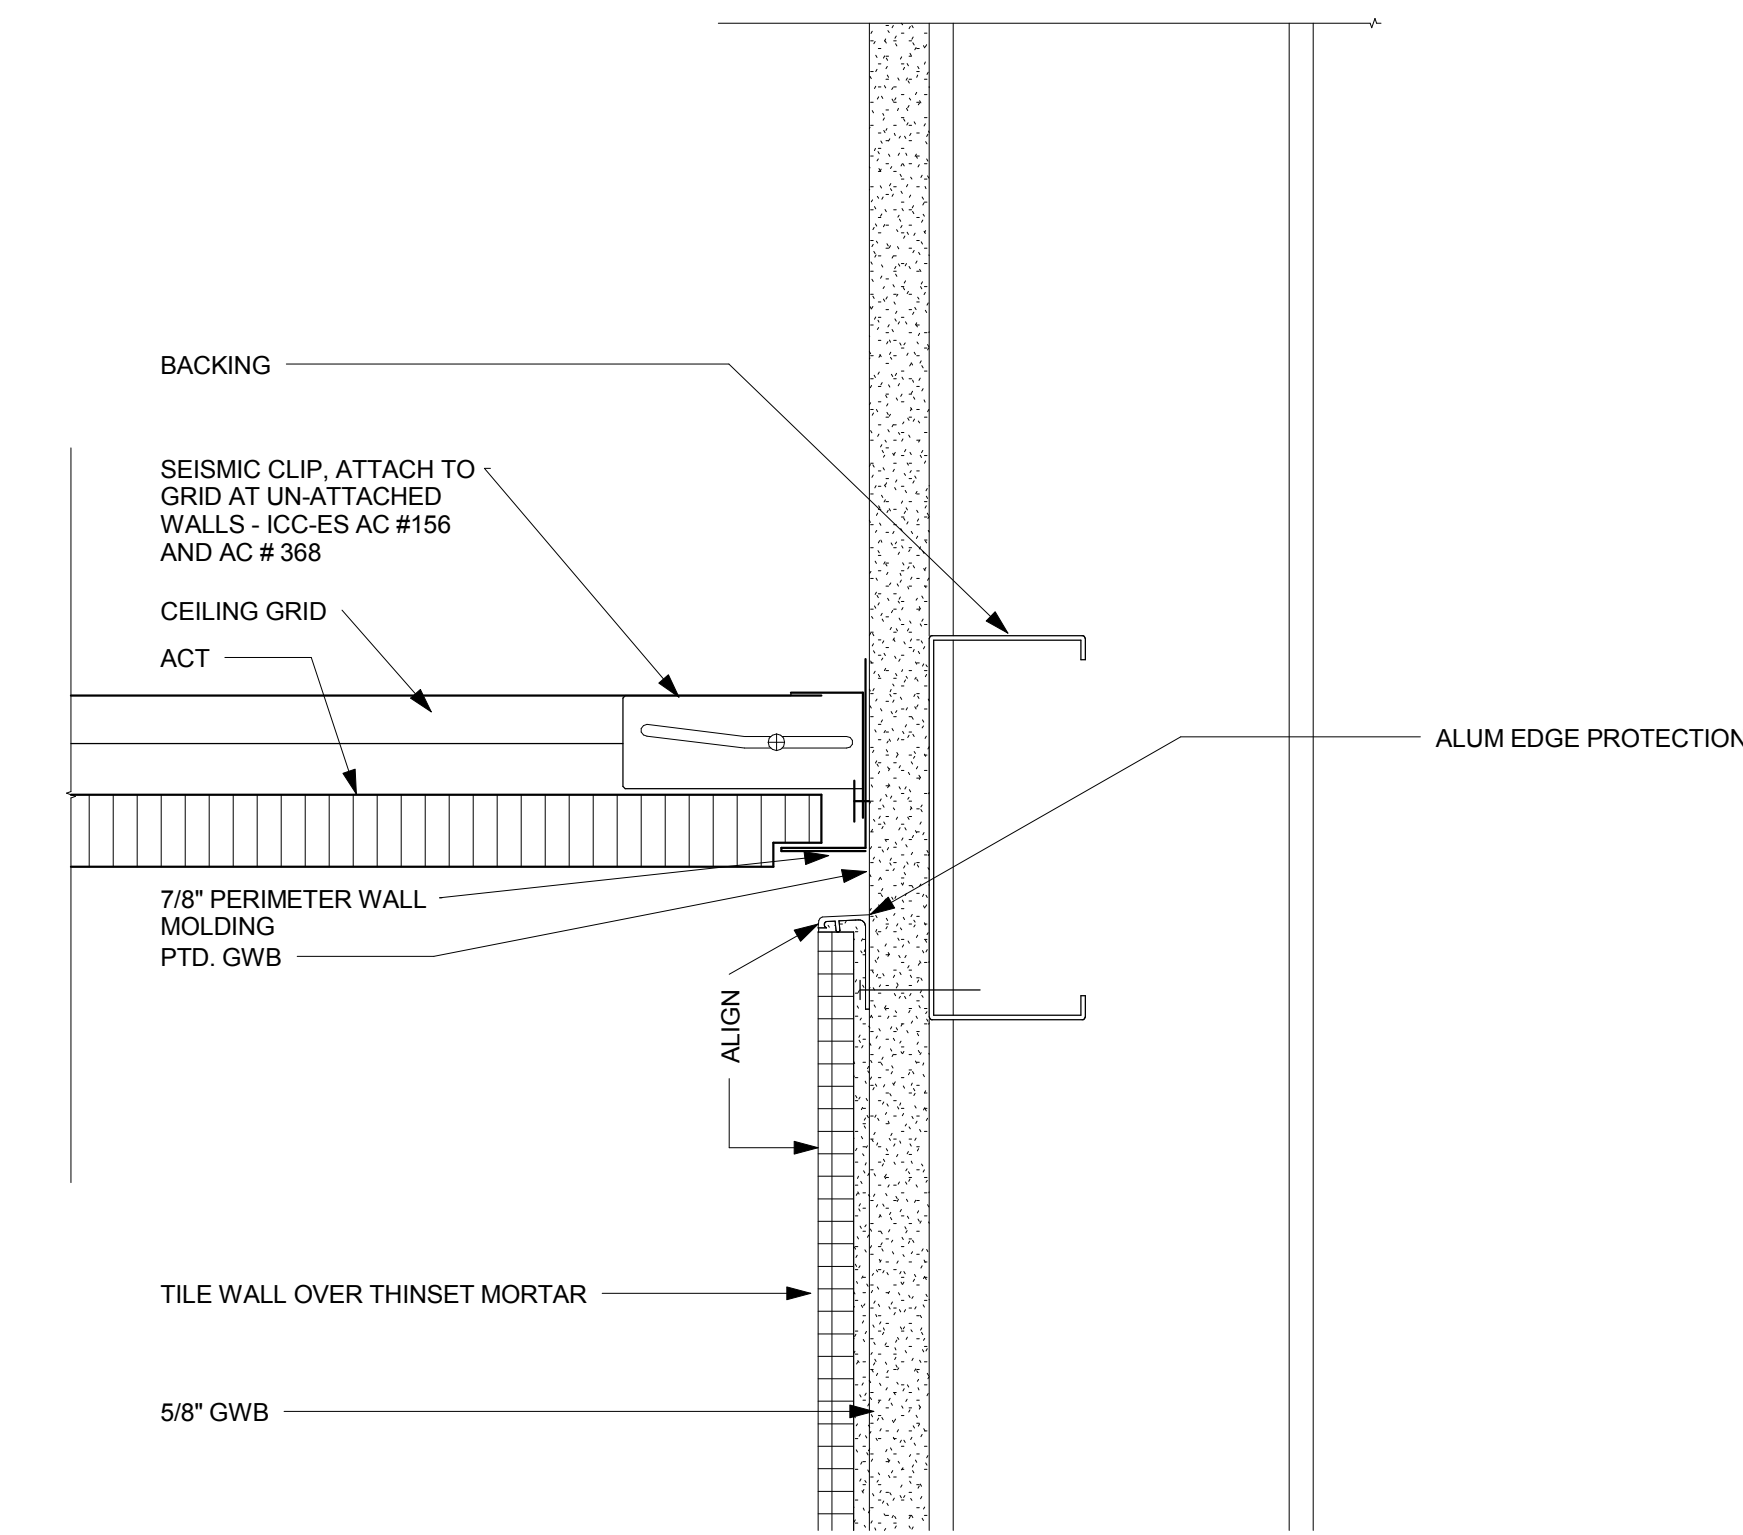


3 TILE WALL AT ACT
6" = 1'-0"

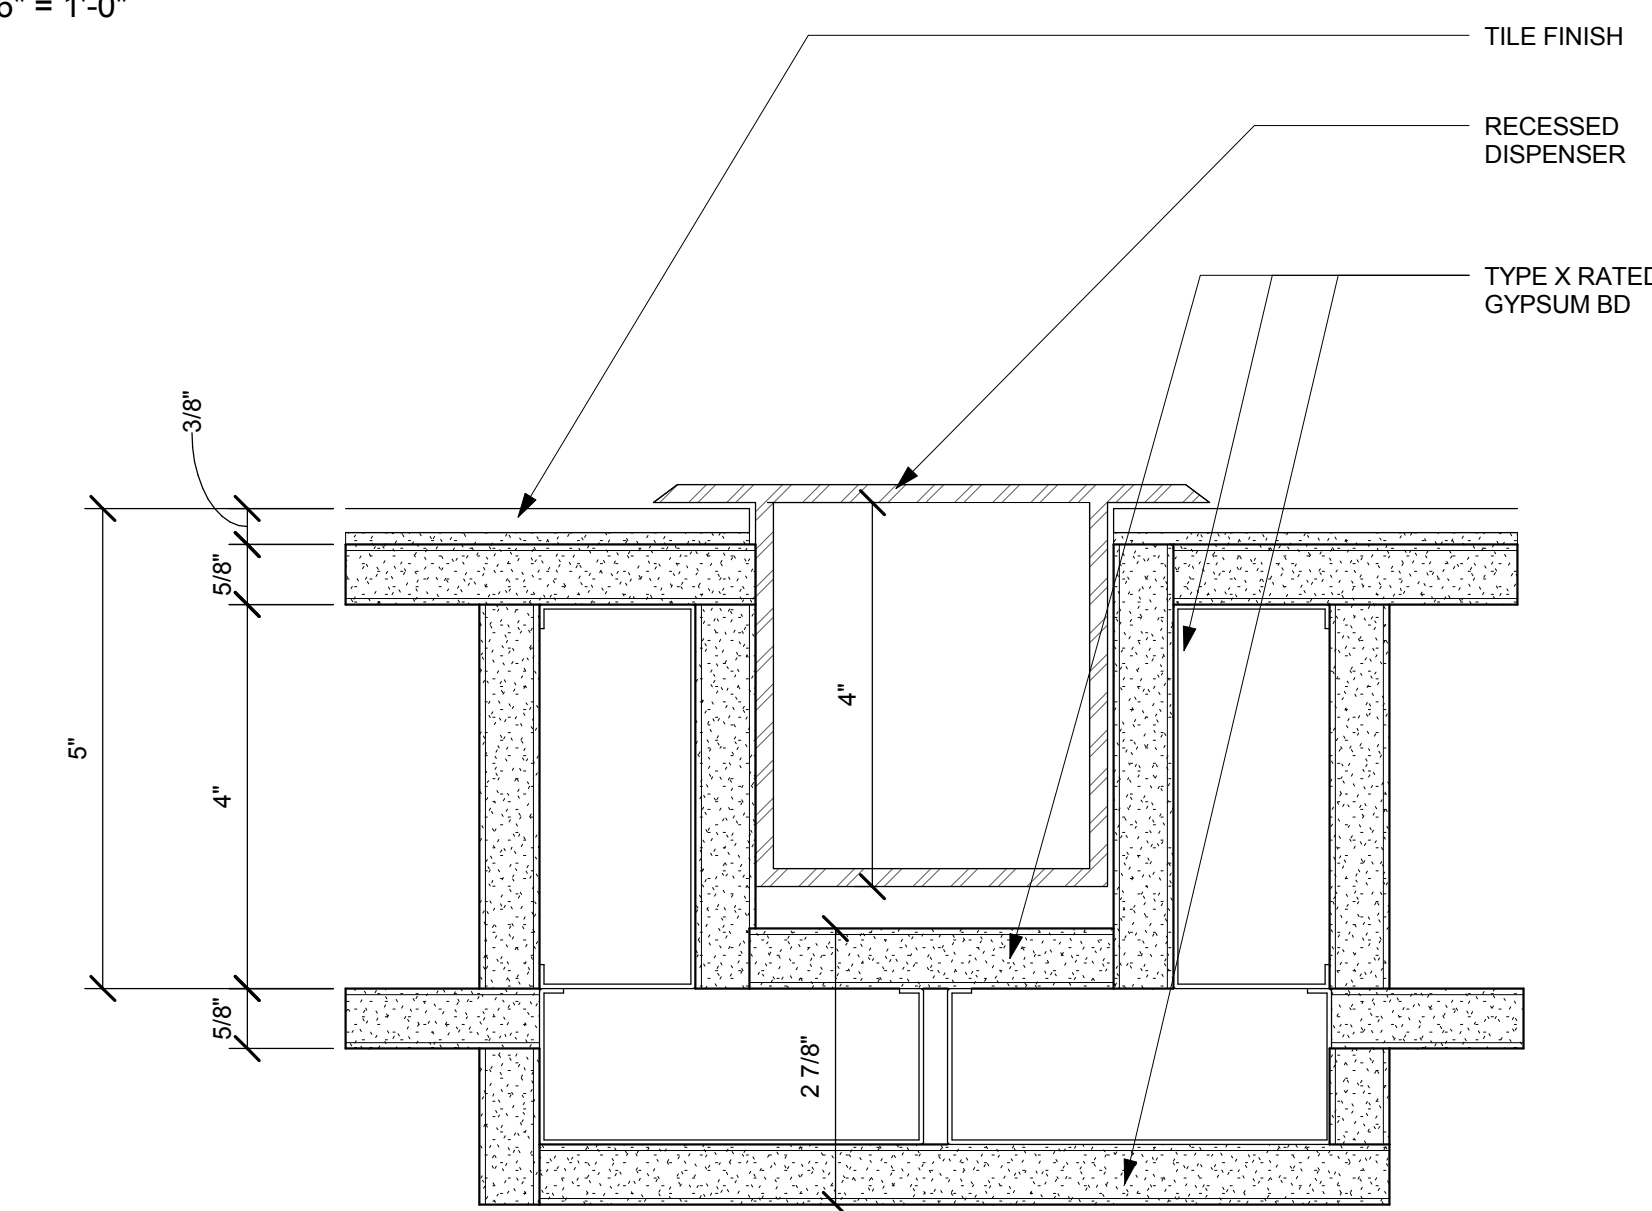


5 RECESSED DISPENSER AT RATED WALL
6" = 1'-0"

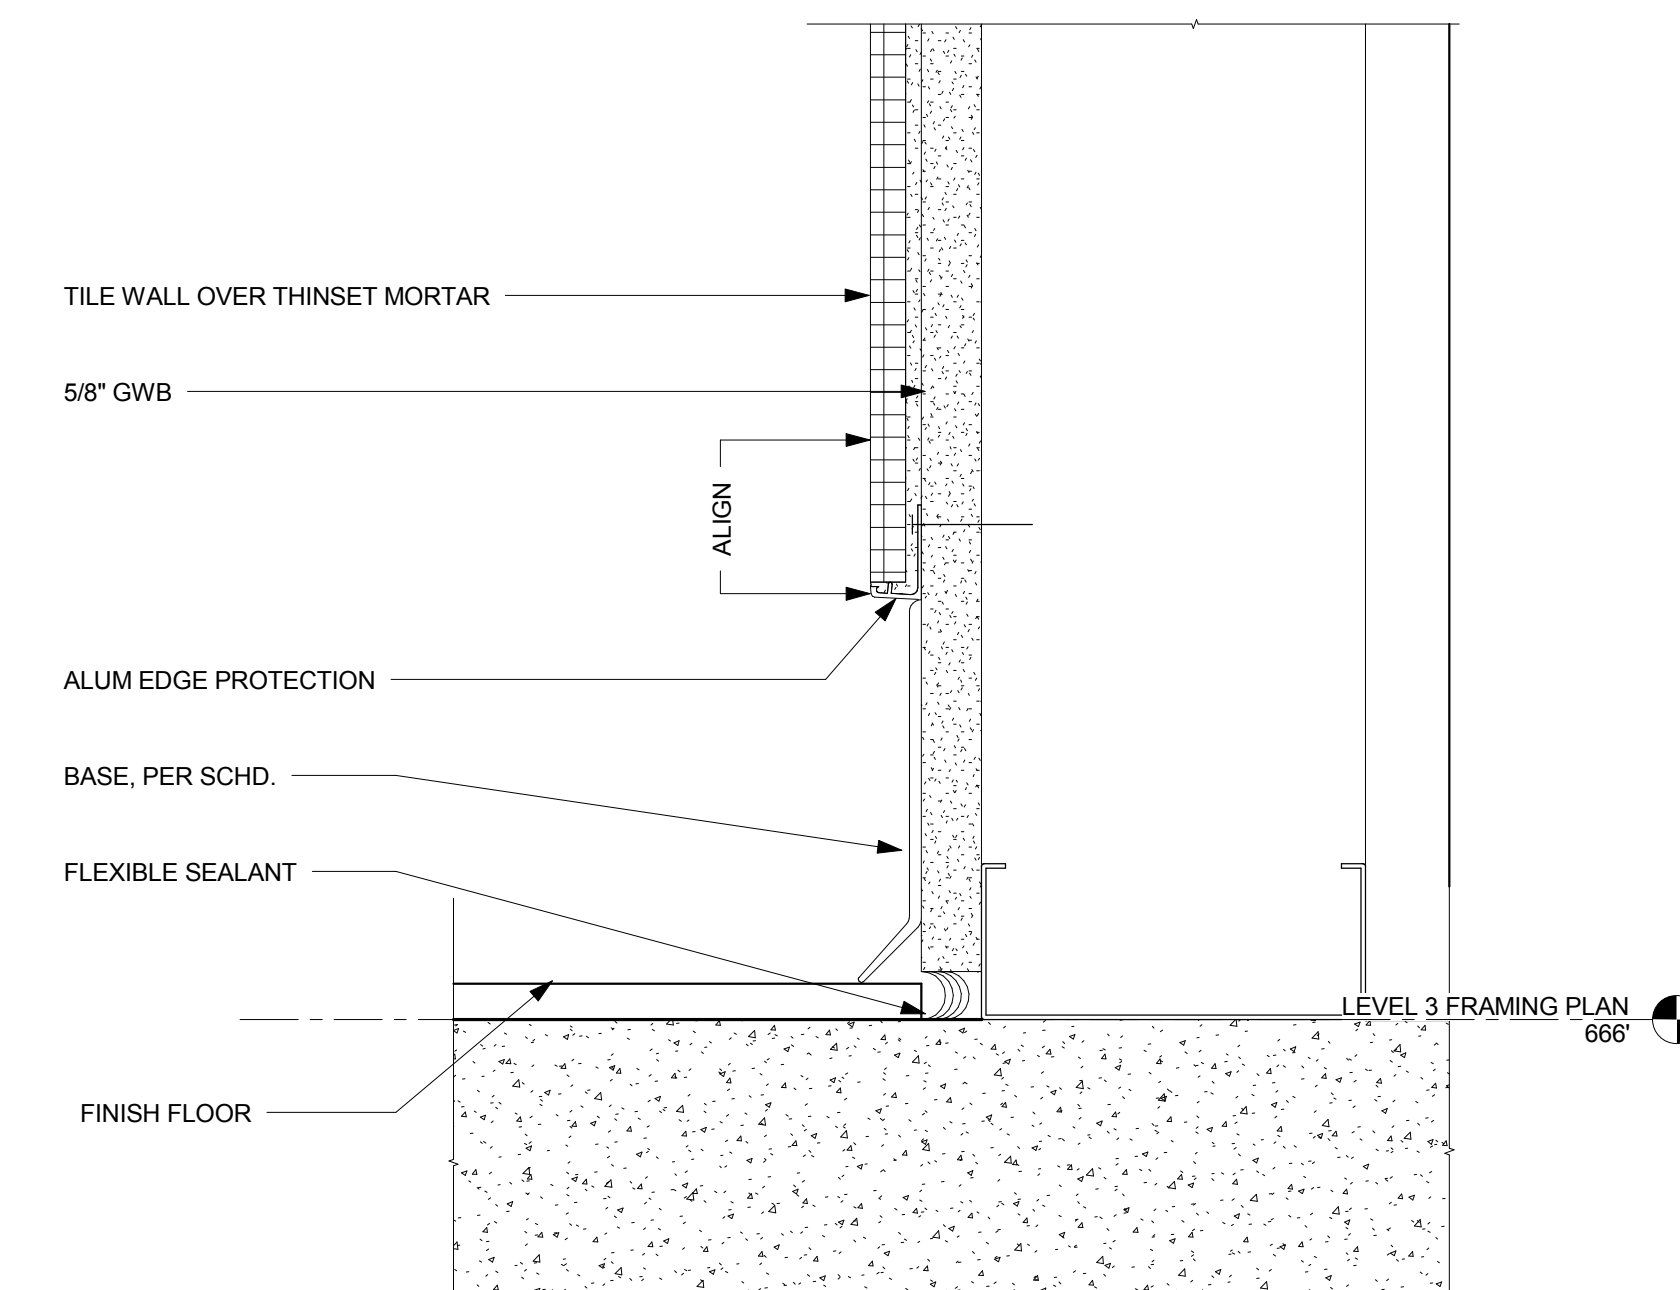


2 TILE WALL BASE
6" = 1'-0"

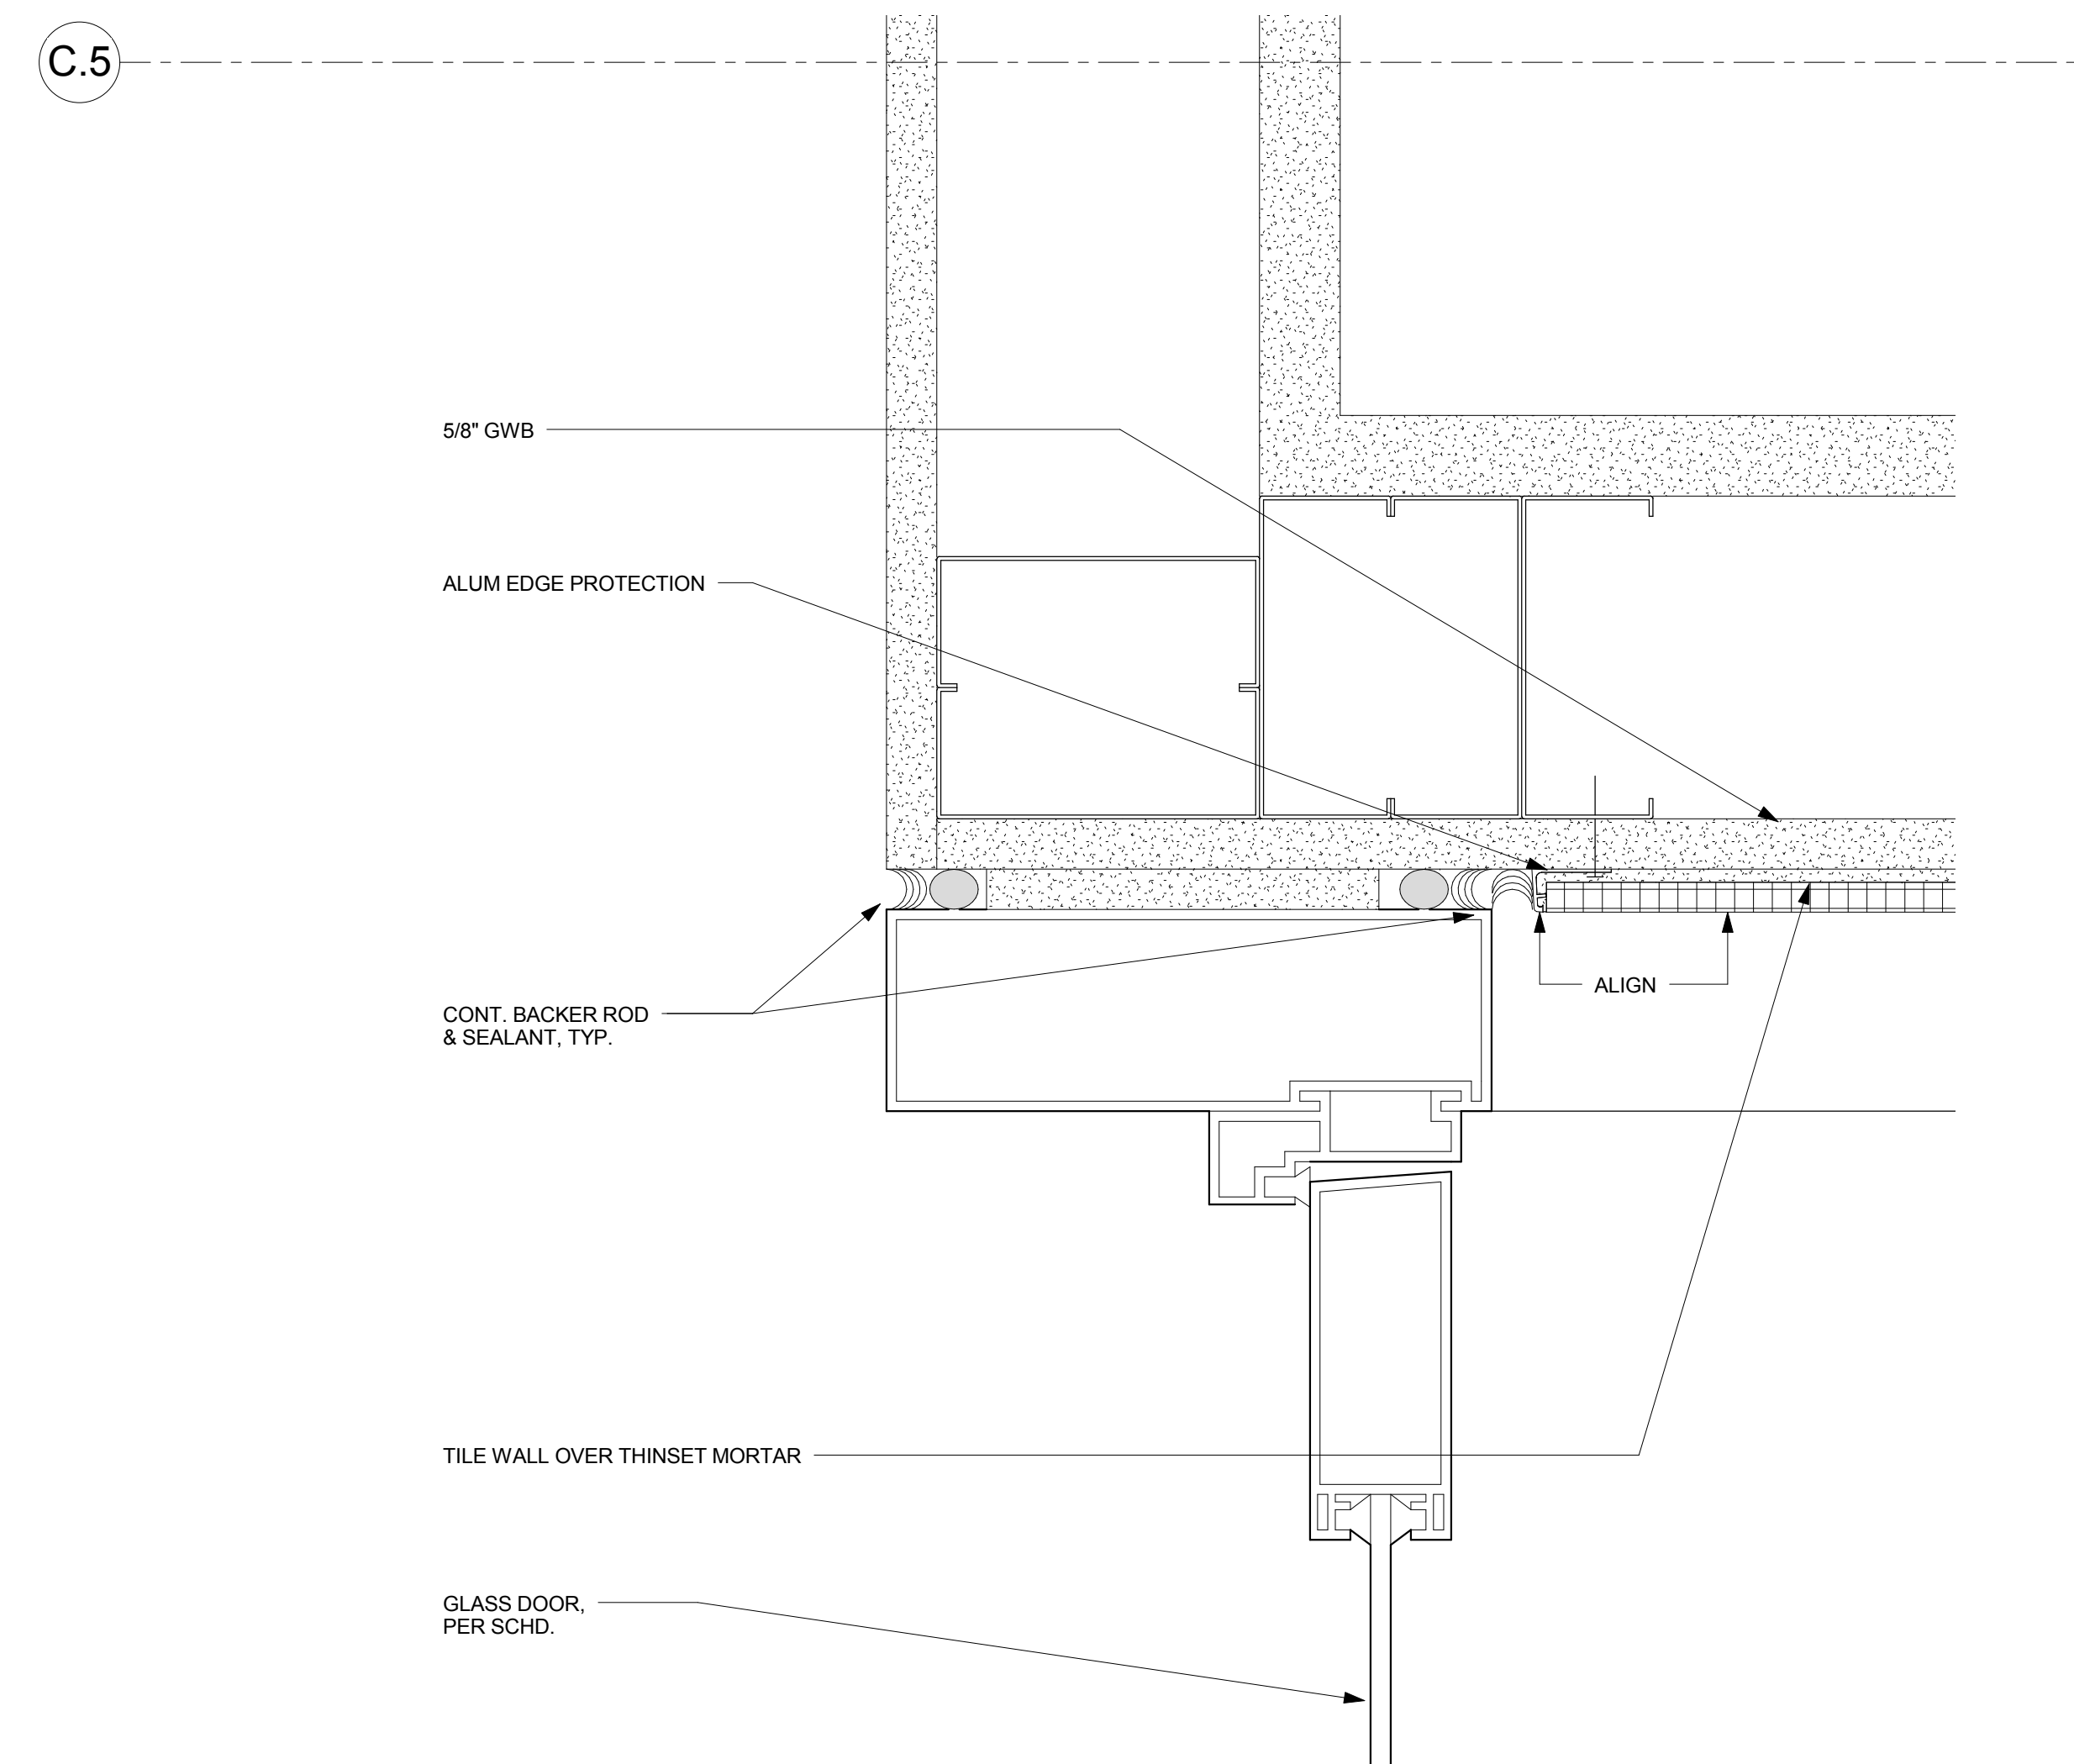

4 TILE WALL AT STOREFRONT JAMB
6" = 1'-0"

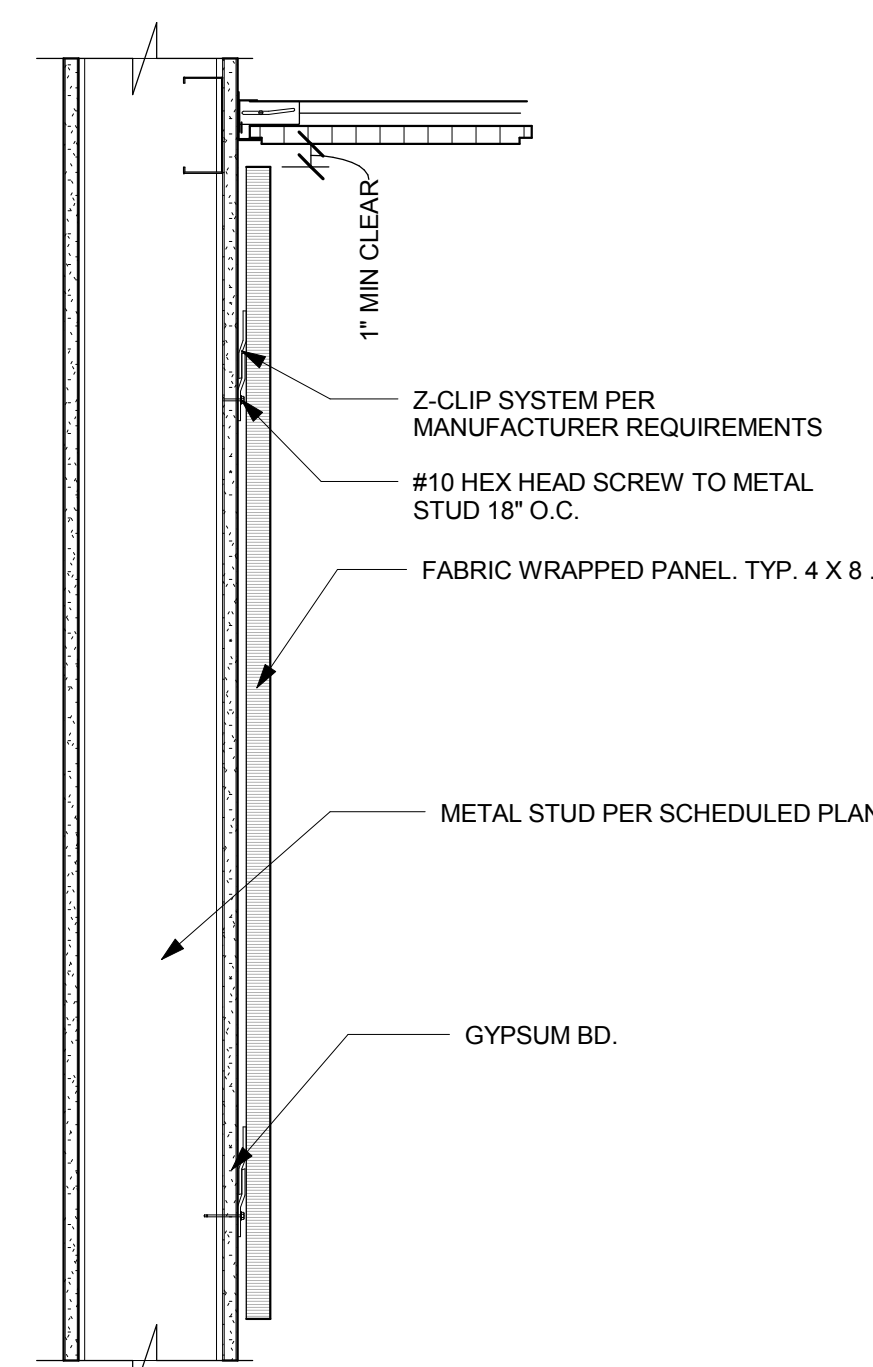

7 TYP. ACOUSTICAL WALL PANEL DETAIL
1 1/2" = 1'-0"

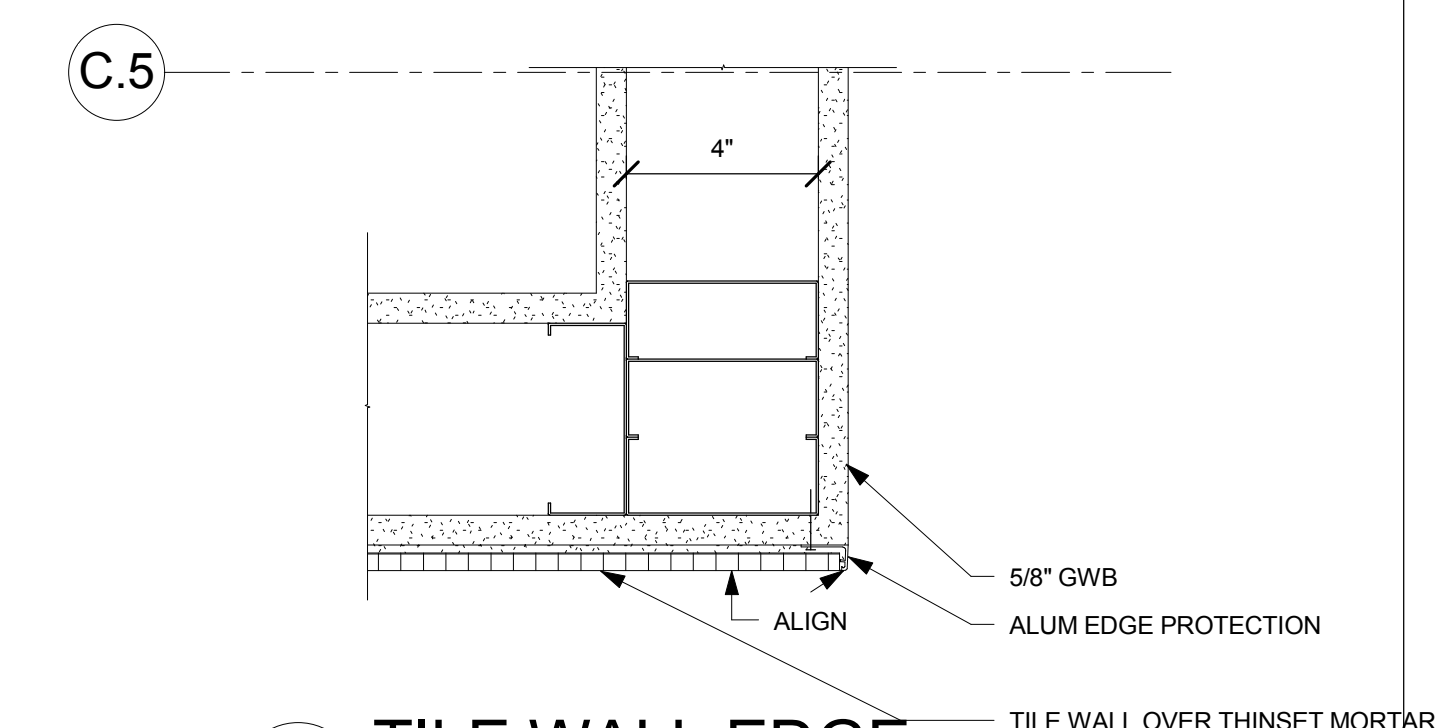

1 TILE WALL EDGE
3" = 1'-0"

PROJECT
RECORD SET

BUILDING 4
SKYLINE COLLEGE

SAN MATEO COUNTY
COMMUNITY COLLEGE
DISTRICT

CIP2 DESIGN-BUILD
PROJECT
BUILDING 4

PROJECT NO.: 07012.00 DRAWN BY: DG
DATE: 11/20/09 CHECKED BY: Checker
SCALE: As indicated

SHEET TITLE:
INTERIOR
DETAILS

SHEET NO.