


PROJECT
RECORD SET

BUILDING 4
SKYLINE COLLEGE

SAN MATEO COUNTY
COMMUNITY COLLEGE
DISTRICT

CIP2 DESIGN-BUILD
PROJECT
BUILDING 4

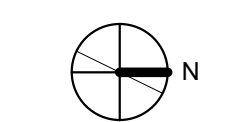


LEVEL 1

PROJECT NO.: 07012.00 DRAWN BY: DG
DATE: 04.16.2009 CHECKED BY: EK
SCALE: As indicated

SHEET TITLE:
LEVEL 1 OVERALL
FLOOR PLAN

SHEET NO.
AC-101

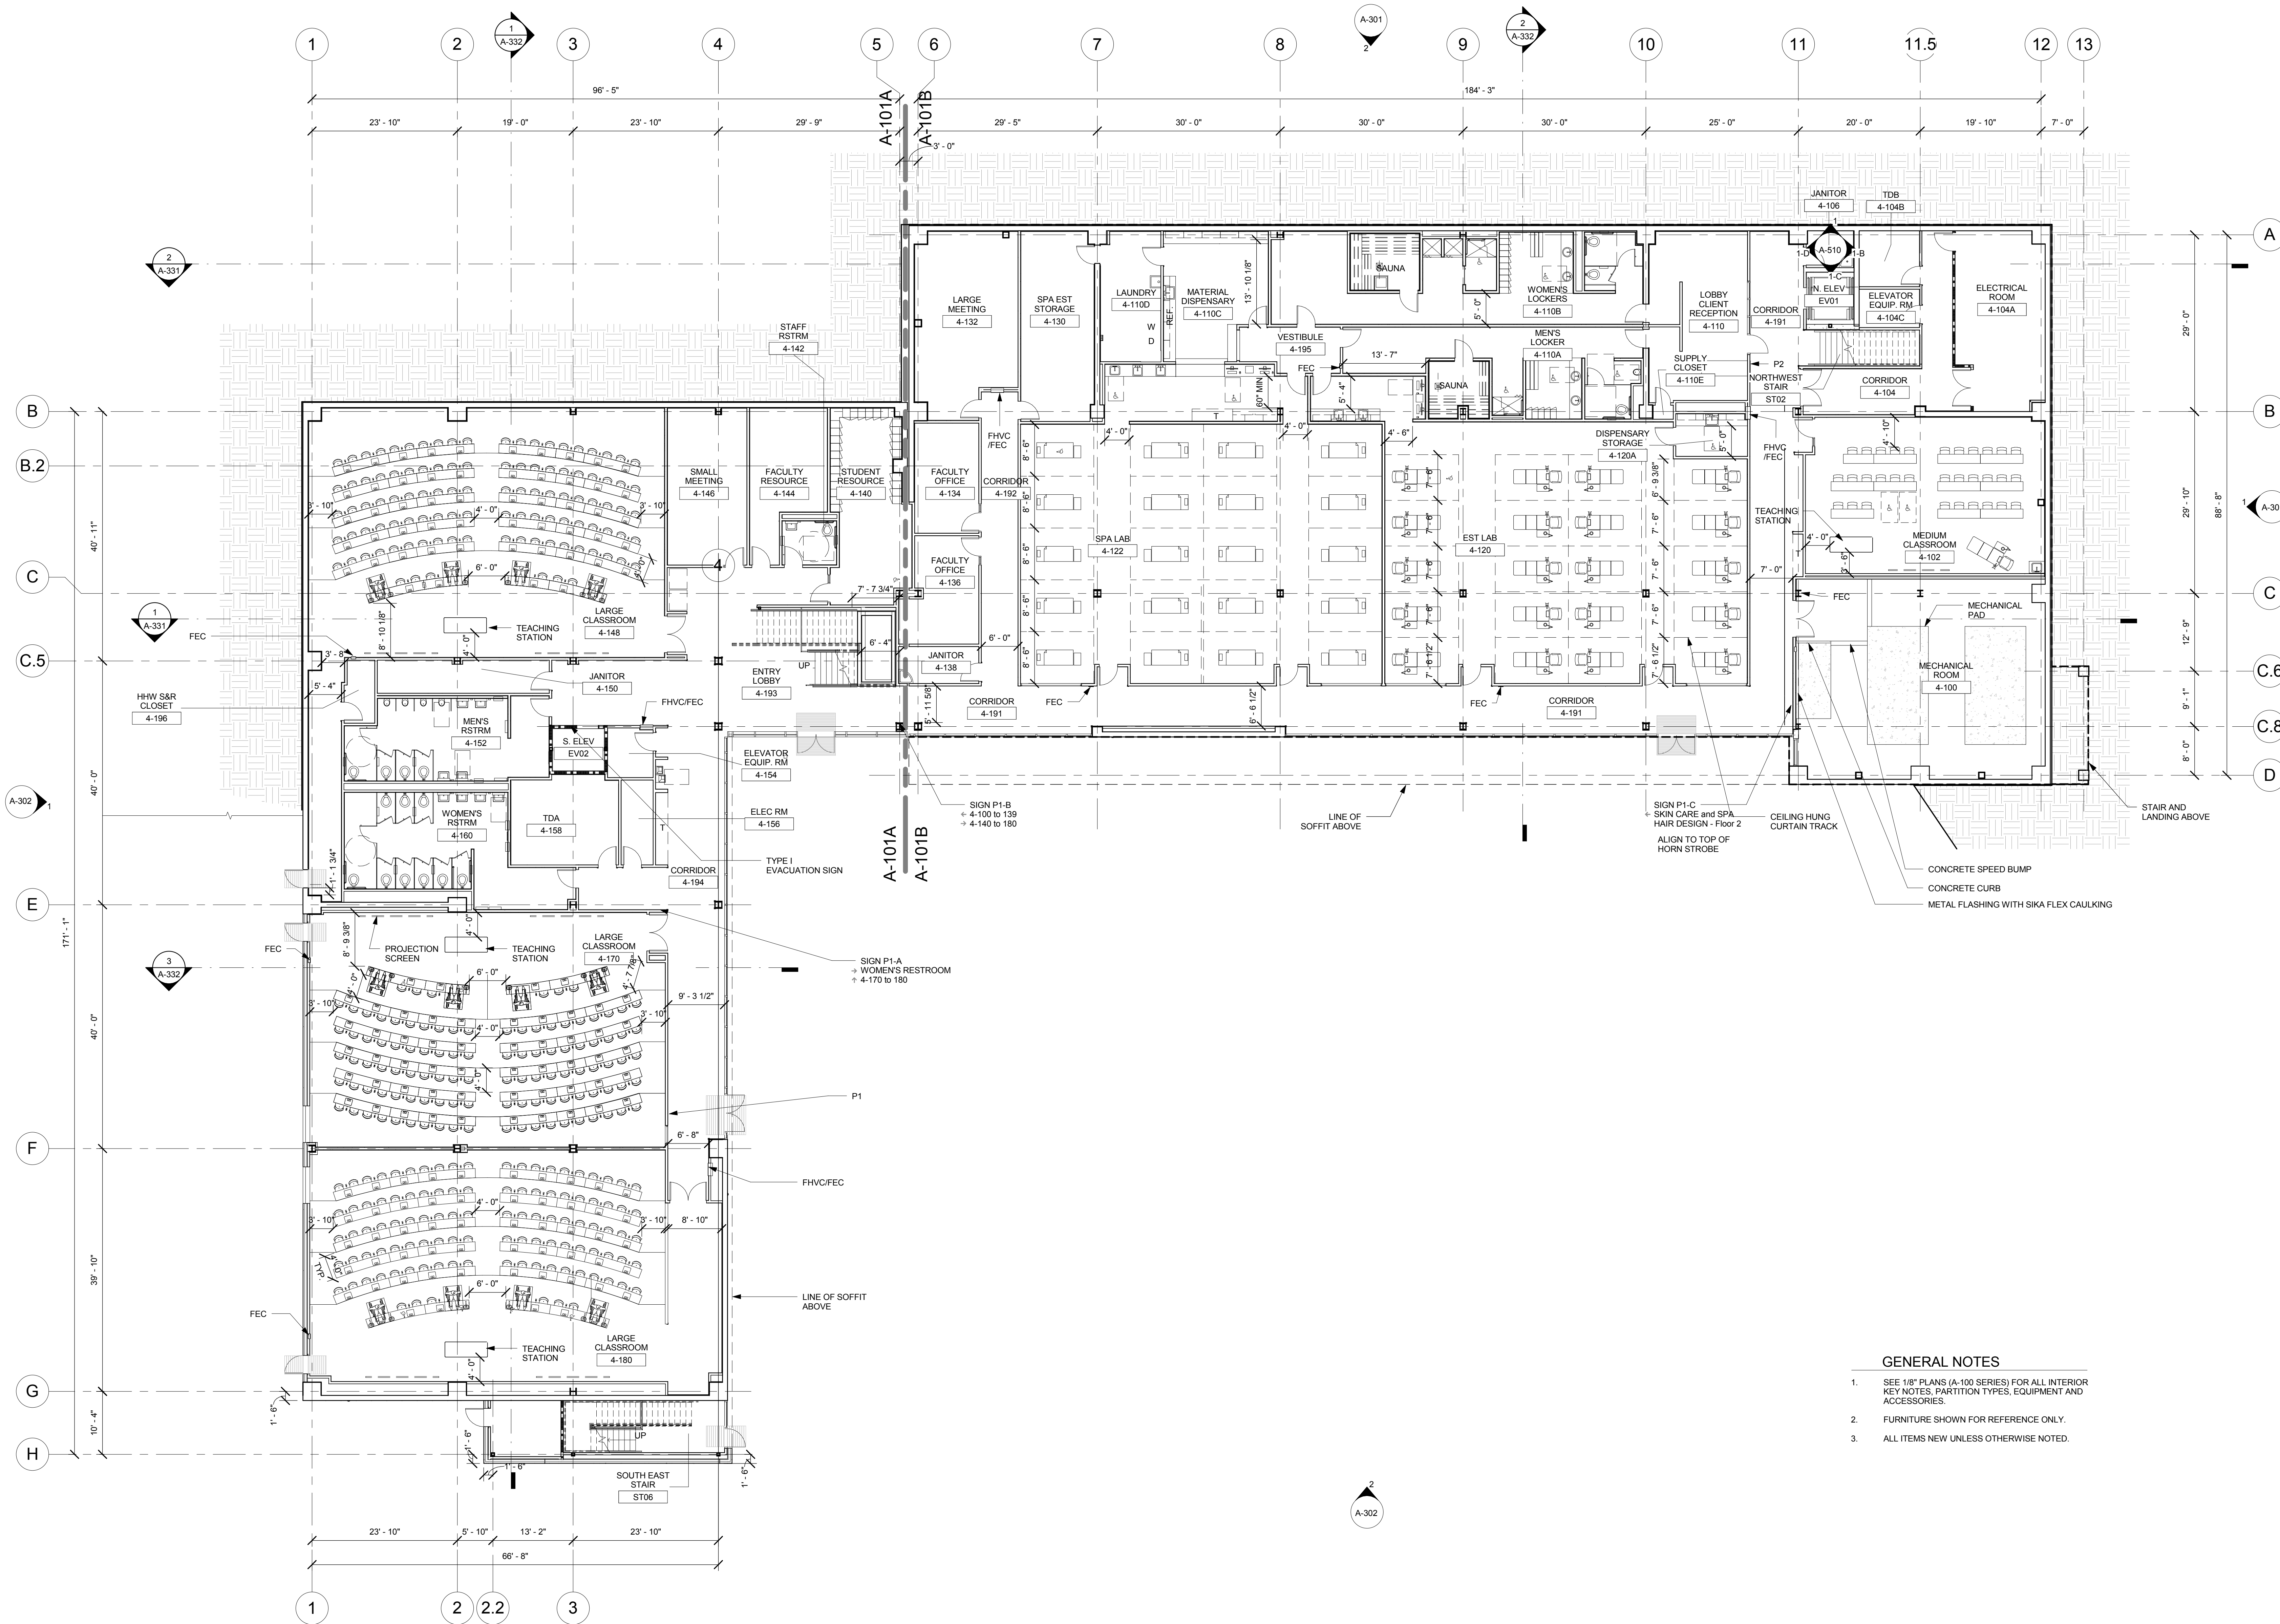

- GENERAL NOTES**
- SEE 1/8" PLANS (A-100 SERIES) FOR ALL INTERIOR KEY NOTES, PARTITION TYPES, EQUIPMENT AND ACCESSORIES.
 - FURNITURE SHOWN FOR REFERENCE ONLY.
 - ALL ITEMS NEW UNLESS OTHERWISE NOTED.

1 LEVEL 1 - FLOOR PLAN
3/32" = 1'-0"