


LEVEL 2

PROJECT NO.: 07012.00 DRAWN BY: DG  
DATE: 04.16.2009 CHECKED BY: EK  
SCALE: As indicated

SHEET TITLE:  
LEVEL 2 OVERALL  
FLOOR PLAN

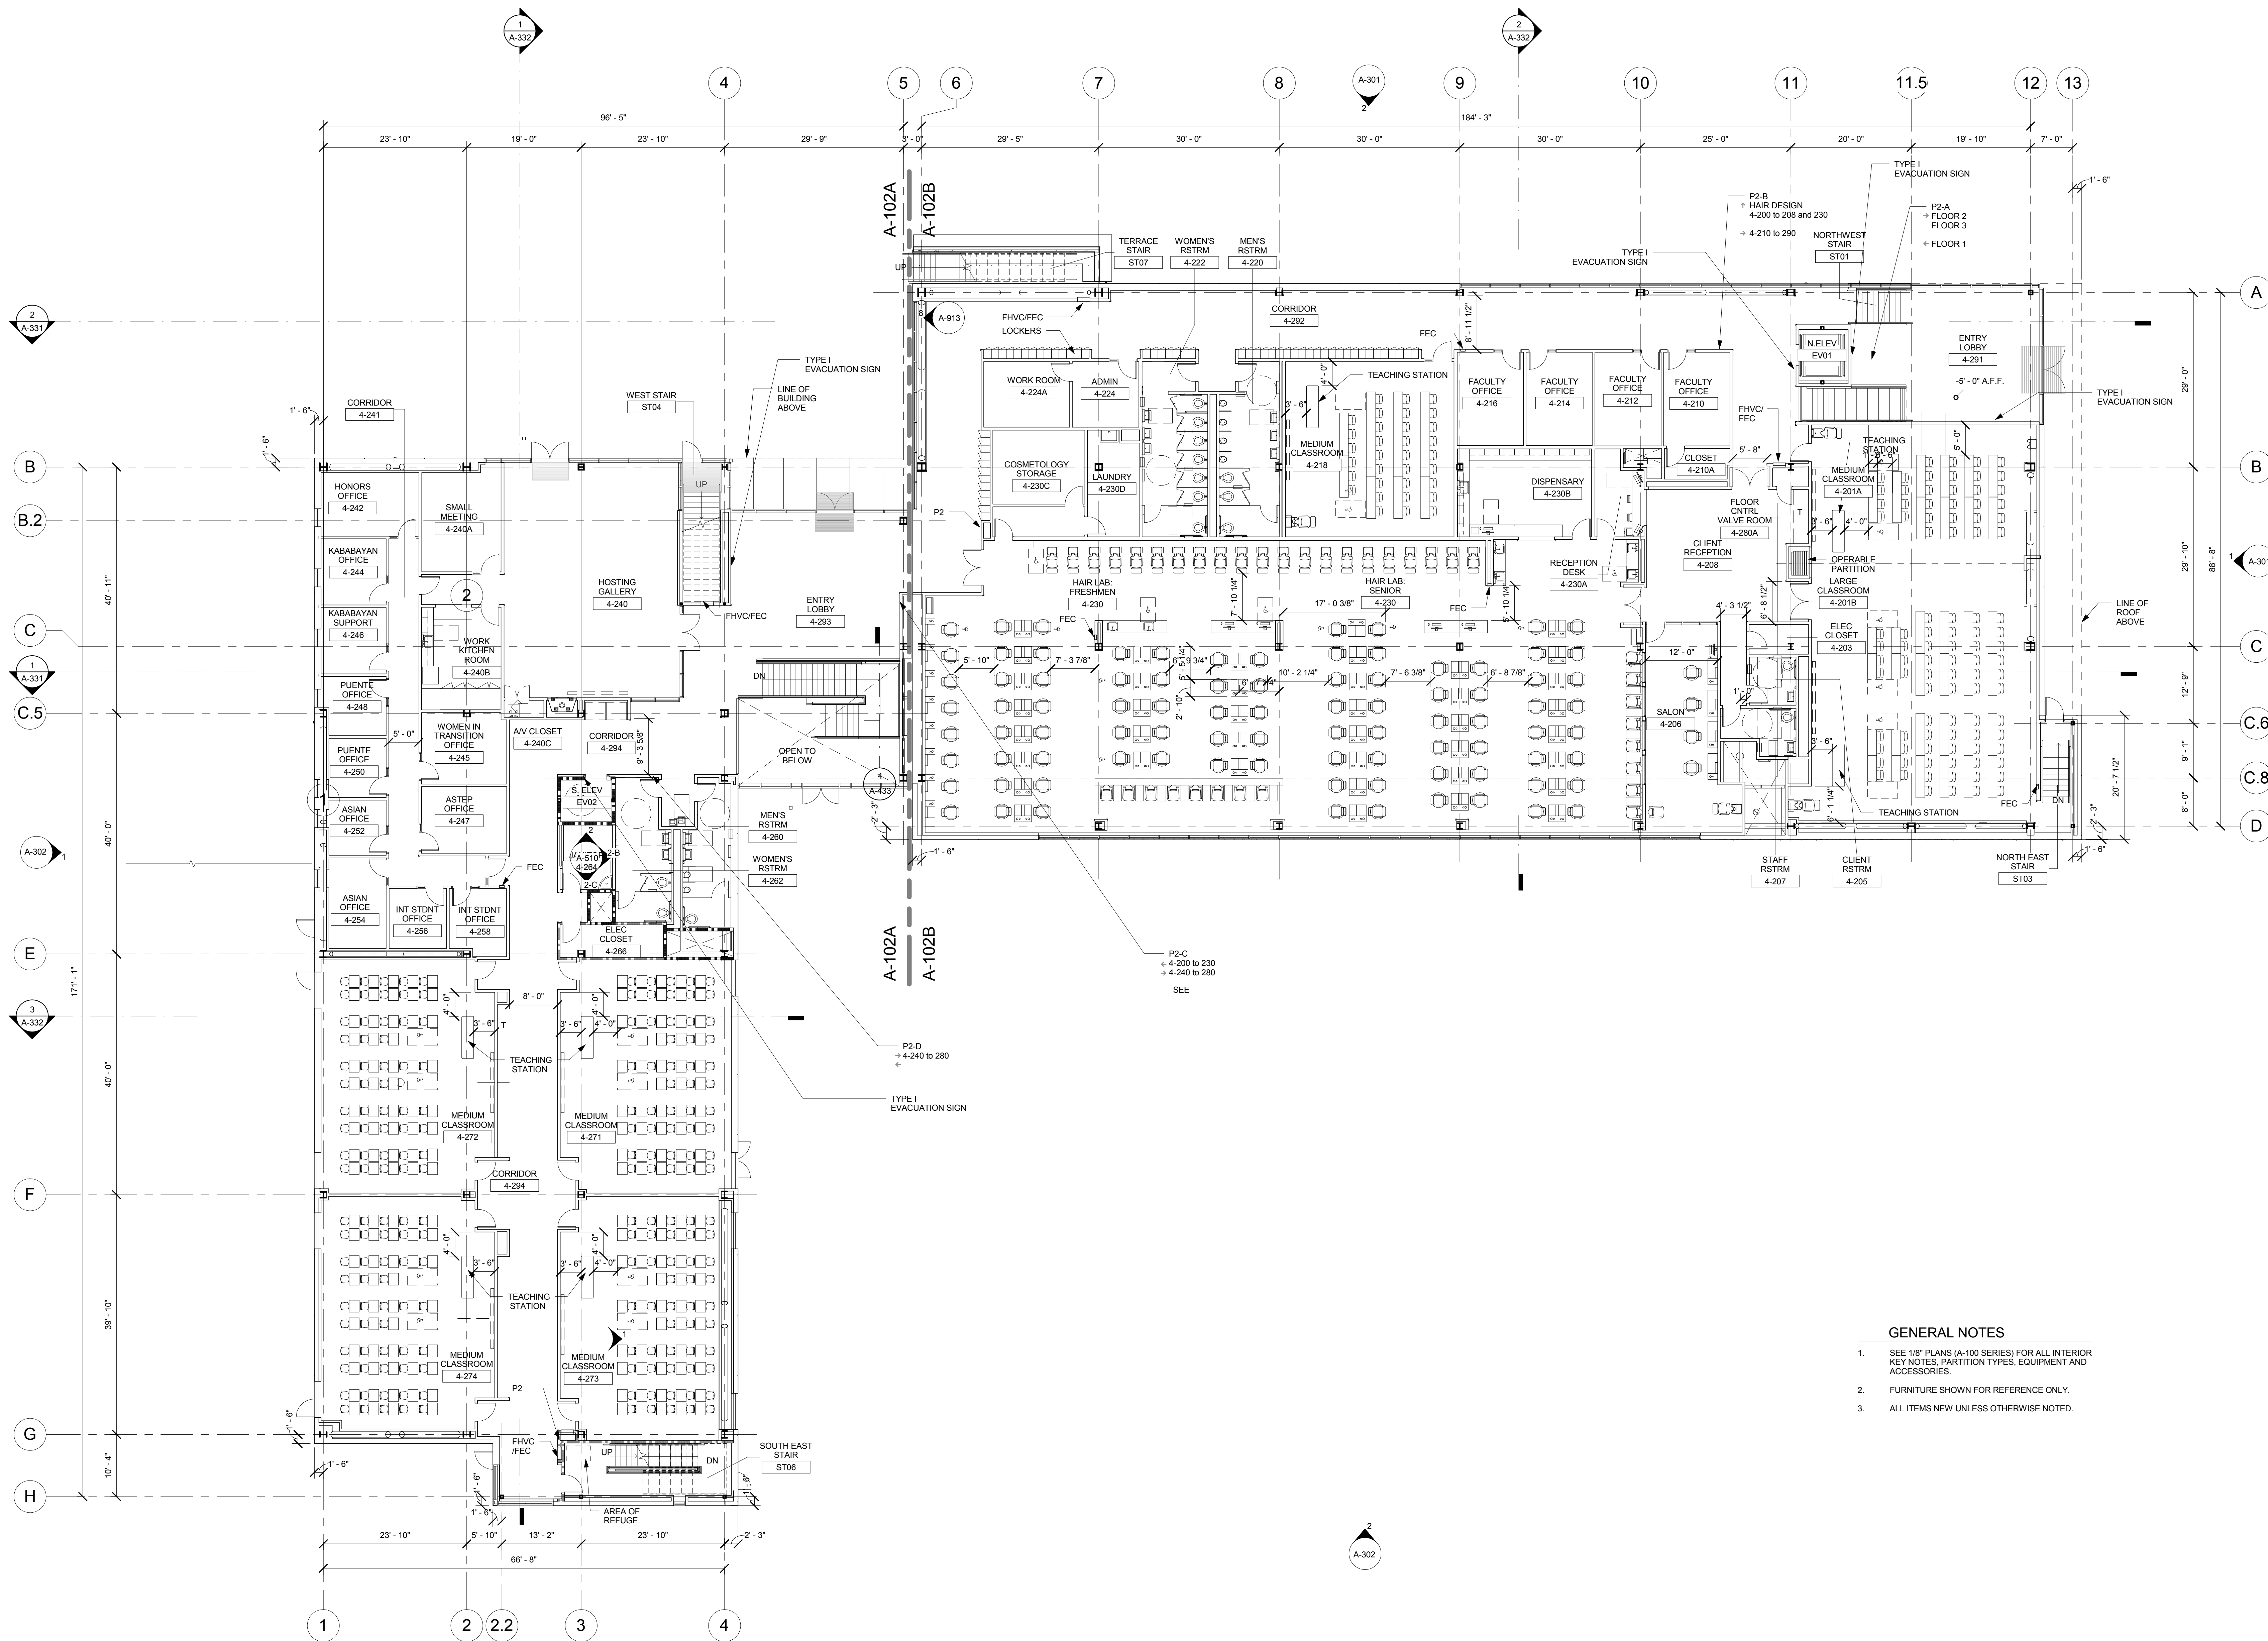

**GENERAL NOTES**

- SEE 1/8" PLANS (A-100 SERIES) FOR ALL INTERIOR KEY NOTES, PARTITION TYPES, EQUIPMENT AND ACCESSORIES.
- FURNITURE SHOWN FOR REFERENCE ONLY.
- ALL ITEMS NEW UNLESS OTHERWISE NOTED.

**1** LEVEL 2 FLOOR PLAN  
3/32" = 1'-0"