


LEVEL 3

PROJECT NO.: 07012.00 DRAWN BY: DG
DATE: 04.16.2009 CHECKED BY: EK
SCALE: As indicated

SHEET TITLE:
LEVEL 3 OVERALL
FLOOR PLAN

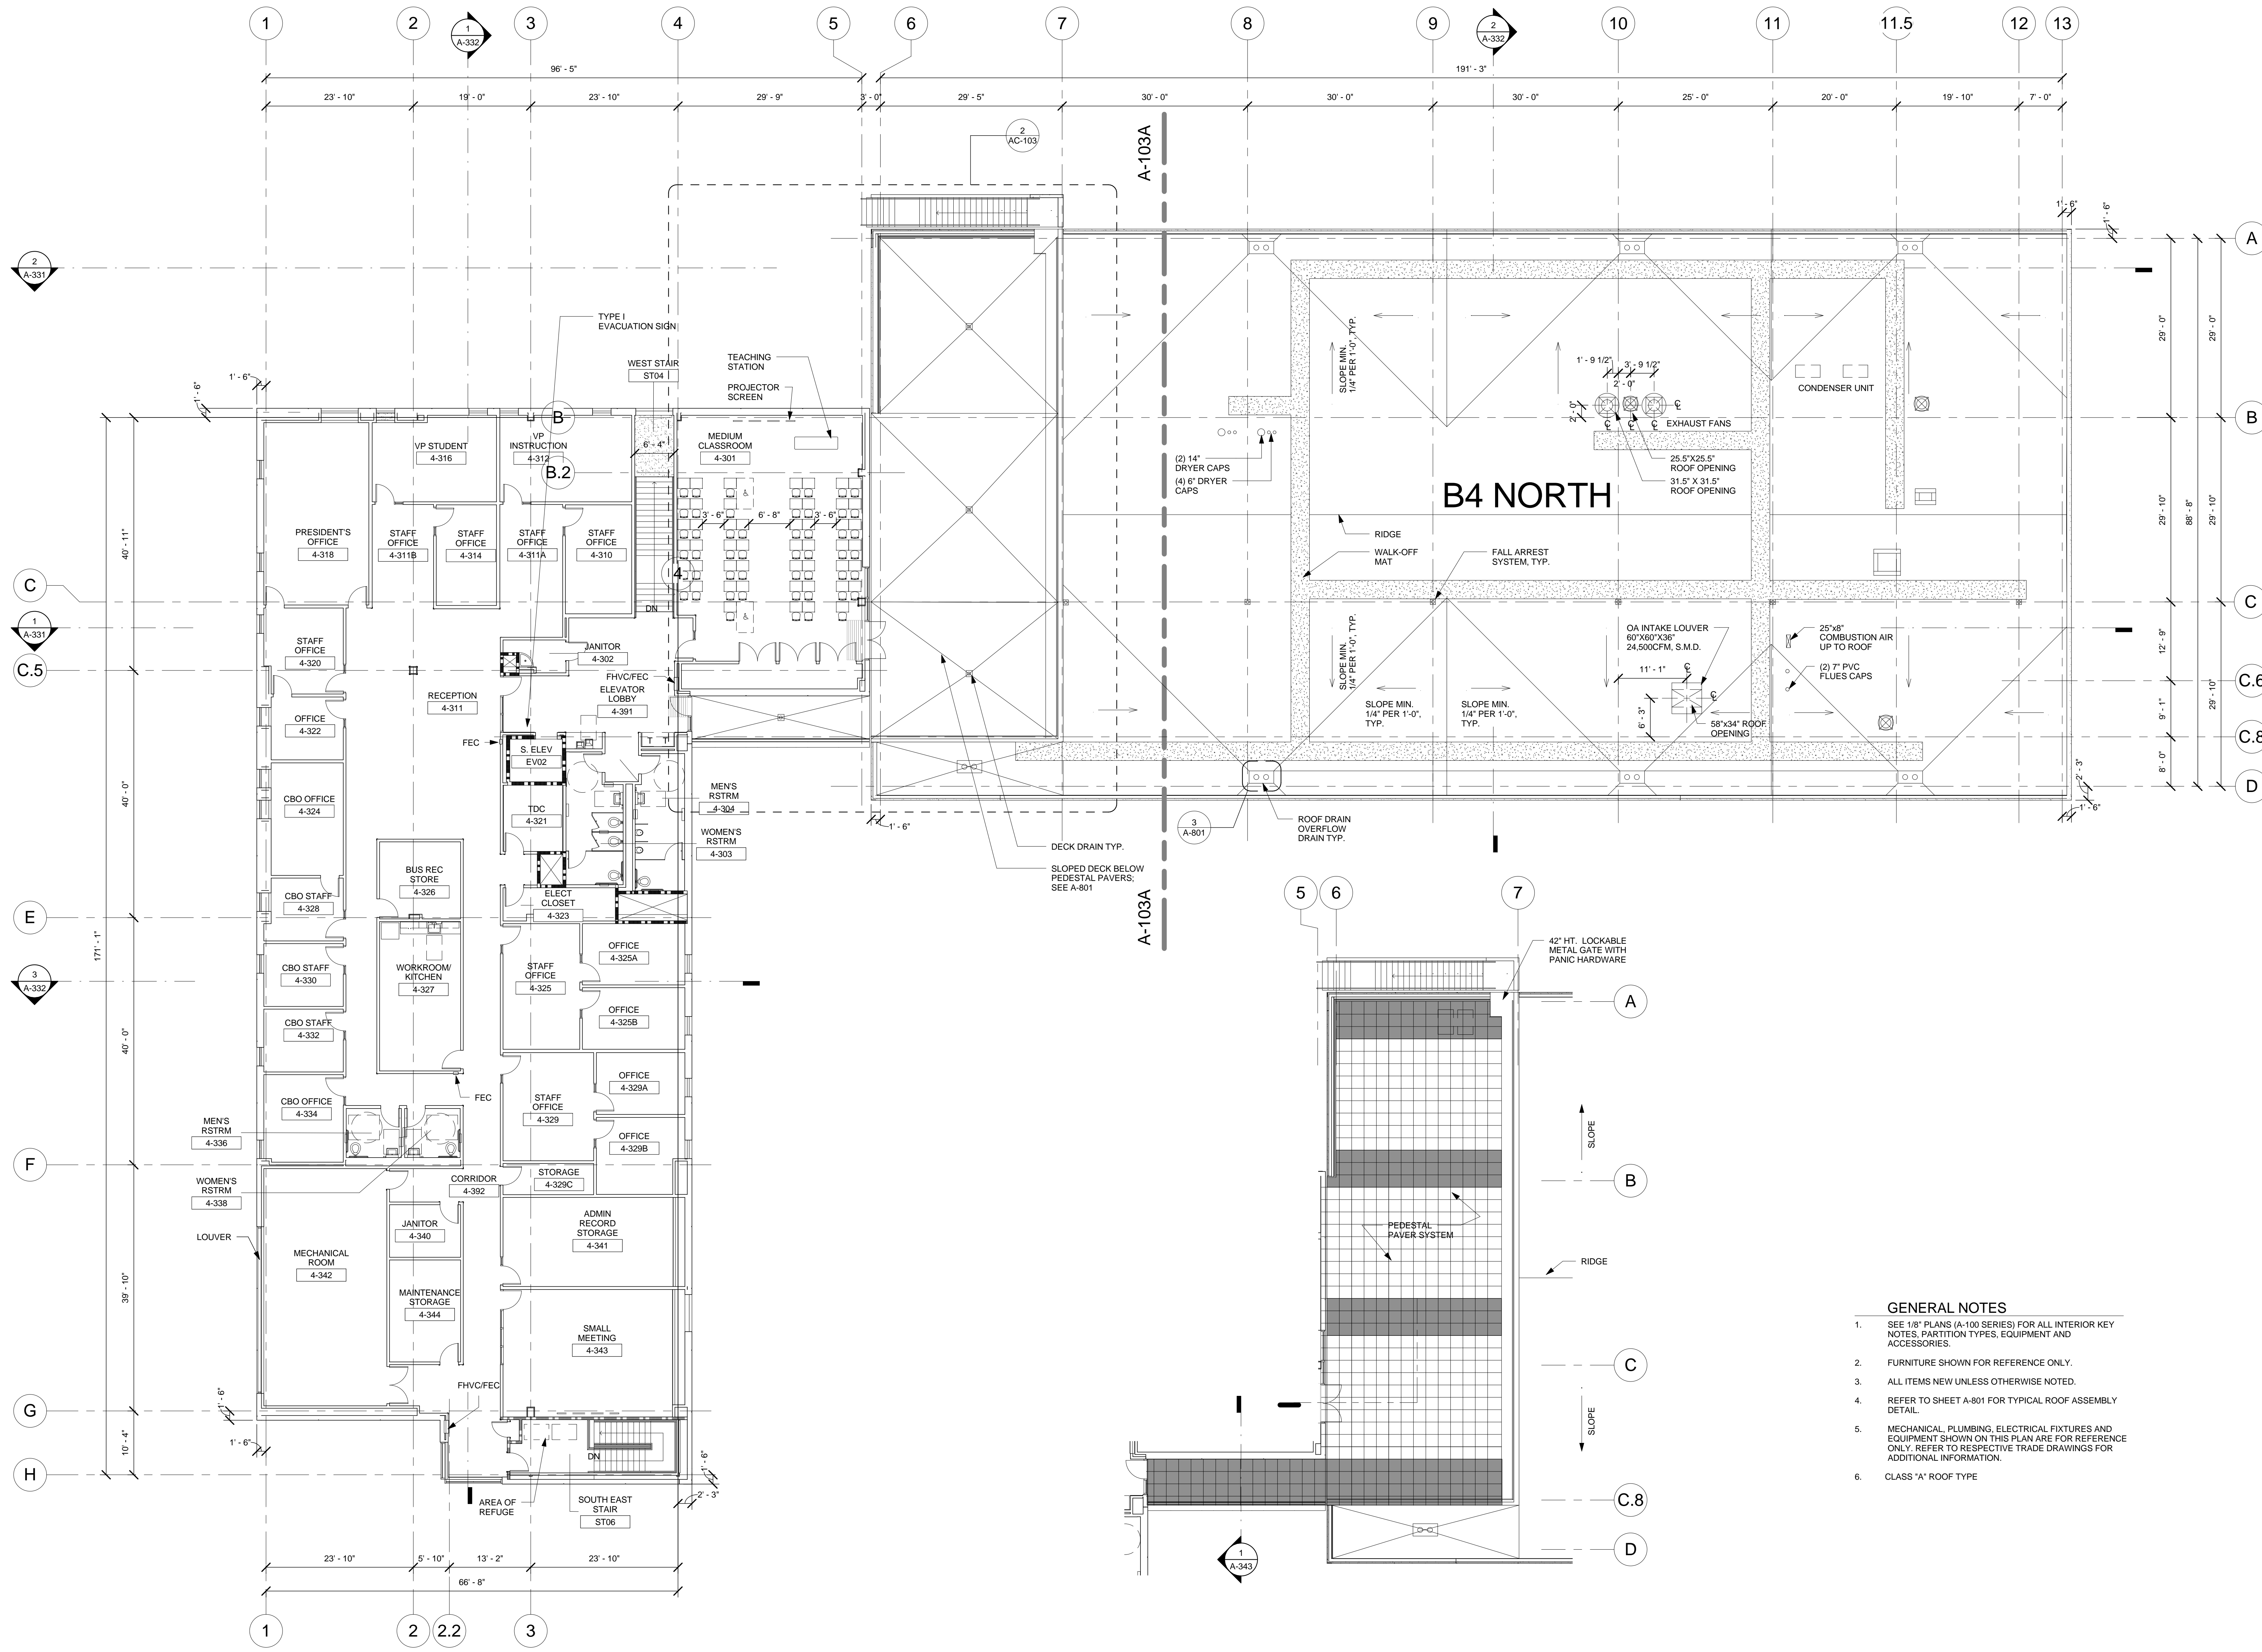

1 LEVEL 3 - FLOOR PLAN
3/32" = 1'-0"

2 TERRACE FLOOR PLAN
3/32" = 1'-0"