

ABBREVIATIONS


A	ABOVE AIR CONDITIONING ASPHALT CONCRETE ADA ACCESSIBLE ACOUSTICAL ACOUSTICAL CEILING PANEL ACOUSTICAL CEILING TILE AREA DRAIN ADDITIONAL ADJUSTABLE ABOVE FINISH FLOOR AGGREGATE ALUMINUM ALTERNATE ANCHOR APPROXIMATE ARCHITECTURAL ASPHALT AUTOMATIC TRANSFER SWITCH AUTOMATIC
B	BOARD BITUMINOUS BACKING BUILDING BLOCKING BEAM BOTTOM BACKER ROD BRACKET BASEMENT BETWEEN BUILT-UP ROOF
C	CABINET CATCH BASIN CEMENTITIOUS BOARD UNIT CEMENT CERAMIC CONTRACTOR FURNISHED CONTRACTOR INSTALLED CONTRACTOR FURNISHED OWNER INSTALLED CORNER GUARD CHANNEL CAST IRON CAST IN PLACE CONTROL JOINT CENTERLINE CEILING CLOSET CLEAR CONCRETE MASONRY UNIT COLUMN COMMUNICATION IS COMPENSATING/TION CONCRETE CONNECTION CONSTRUCTION CONTINUOUS CONTRACTOR COORDINATE CORRIDOR CARPET CARD READER COLD ROLLED CHANNEL CERAMIC TILE CENTER/COUNTER COUNTERSUNK
D	DUST BARRIER DOUBLE DECK DRAIN DEMOLITION DEPARTMENT DETAIL DRINKING FOUNTAIN DIAMETER DIAGONAL DIMENSION DISPENSER DOWN DOOR OPENING DOOR DIVISION OF STATE ARCHITECT DRAWINGS DRAWER
E	EXISTING EAST EACH EACH SIDE EACH WAY EXPANSION BOLT EACH FACE EMERGENCY GENERATOR EXPANSION JOINT ELEVATION ELECTRICAL ELEVATOR EMBEDMENT EMERGENCY ENCLOSURE ENGINEER ELECTRICAL PANEL EXPANDED POLYSTYRENE EQUAL EQUIPMENT ESCUTCHEON ETCETERA ELECTRIC WATER COOLER EXPANSION, EXPOSED EXPOSED EXTERIOR EXTRUDED

F	FIRE ALARM FIRE ALARM CONTROL PANEL FLAT BAR FLOOR CLOSER FLOOR DRAIN OR FIRE DAMPER FIRE DEPARTMENT CONNECTION FOUNDATION FIRE EXTINGUISHER FIRE EXTINGUISHER CABINET FLAT HEAD FIRE HOSE VALVE CABINET FLAT HEAD MACHINE SCREW FLAT HEAD WOOD SCREW FINISH FLOOR FLOOR SINK FLUORESCENT FACE OF FACE OF CONCRETE FACE OF EQUIPMENT FACE OF FINISH FACE OF STUD FIREPROOFING FROM FIRE RATED FULL SIZE FIRE SPRINKLER RISER FIRE SPRINKLER FOOT OR FEET FOOTING FURRING FUTURE
G	GAUGE GALVANIZED GRAB BAR GENERAL CONTRACTOR GENERATOR GLASS FIBER REINFORCED CONCRETE GLASS FIBER REINFORCED GYPSUM GALVANIZED IRON GLASS GLUE LAMINATED BEAM GLUE LAMINATED GROUND GRADE GUARDRAIL GALVANIZED SHEET METAL GYPSUM WALL BOARD GYPSUM
H	HAT CHANNEL HOSE BIB HOLLOW CORE HARDBOARD HEADER HARDWARE HARDWOOD HEIGHT HOLLOW METAL HOLD OPEN MAGNETIC HORIZONTAL HIGH POINT HOUR HOT ROLLED CHANNEL HANDRAIL HOOK STRIP HEATER HEATING, VENTILATING AND AIR CONDITIONING
I	INSIDE DIAMETER/DIMENSION INCH INCANDESCENT INCLUDE INSULATION/ING INTERIOR INTERMEDIATE INVERT
J	JANITOR JOIST JOINT
K	LABORATORY LAMINATE /D LAVATORY POUND LOCKER LEAD LINED LONG LEGS BACK TO BACK LONG LEG HORIZONTAL LONG LEG VERTICAL LOCATION LOW POINT LIGHT LIMITED LIGHT WEIGHT

M	MACHINE MATERIAL MAXIMUM MACHINE BOLT MEDICINE CABINET MEDIUM-DENSITY FIBERBOARD MECHANICAL MEDIUM MEMBRANE MOLDED EXPANDED POLYSTYRENE METAL MEZZANINE MANUFACTURER MANHOLE MINIMUM OR MINUTE MISCELLANEOUS MASONRY OPENING MOUNTED MOUNTING METAL SLOTTED MULLION
N	NEW NORTH NOT IN CONTRACT NUMBER NOMINAL NON-RATED NOT TO SCALE
O	OVERALL ON CENTER OUTSIDE DIAMETER/DIMENSION OWNER FURNISHED CONTRACTOR INSTALLED OVERFLOW DRAIN OFFICE OWNER FURNISHED OWNER INSTALLED OVERHEAD OPPOSITE HAND OPENING OPPOSITE
P	POWDER ACTUATED DEVICE POWDER ACTUATED FASTENER PENETRATION PERFORATED PERPENDICULAR POST INDICATOR VALVE PLATE PROPERTY LINE PLASTIC LAMINATE PLASTER PLUMBING PLYWOOD PANEL POLISHED PAIR PRECAST PREFABRICATED PROJECTION POUNDS PER SQUARE FOOT POUNDS PER SQUARE INCH POINT OR PAINT PAINTED PAPER TOWEL DISPENSER OR RECEPTACLE PARTITION PRESSURE TREATED PRESSURE TREATED WOOD POLYVINYL CHLORIDE
Q	QUARRY TILE QUANTITY
R	REVEAL OR RISER RADIUS RESILIENT BASE REINFORCED CONCRETE PIPE OR REFLECTED CEILING PLAN ROOF DRAIN REDWOOD REFERENCE REFLECTED REFRIGERATOR REINFORCED ANGLEMENT REQUIRED RESILIENT RESOURCE RETAINING OR RETARDANT REVISION REGISTER ROOM ROUGH OPENING RAIN WATER LEADER

S	SOUTH OR SINK SLOTTED ADJUSTABLE FRAMING SYSTEM SANITARY SOLID CORE SEE CIVIL DRAWINGS OR SEAT COVER DISPENSER SCHEDULED SOAP DISPENSER SECTION SEE ELECTRICAL DRAWINGS SQUARE FOOT OR FEET SHELF SHOWER SHEET SHEATHING SIMILAR SEISMIC JOINT SHORT LEGS BACK TO BACK SEALANT SEE LANDSCAPE DRAWINGS SLOTTED SHEET METAL SEE MECHANICAL DRAWINGS SANITARY NAPKIN DISPENSER SANITARY NAPKIN RECEPTACLE SOFFIT SLAB ON GRADE SPACING SEE PLUMBING DRAWINGS SPECIFICATION /S SQUARE SEE STRUCTURAL DRAWINGS SERVICE SINK SOLID SURFACING MATERIAL STAINLESS STEEL STATION SOUND TRANSMISSION COEFFICIENT STANDARD STIFF STIFFENER STEEL STAIN STORAGE STRUCTURAL SELF TAPPING SCREW SUSPENDED SHEET VINYL SQUARE YARD SYMMETRICAL SYNTHETIC SYSTEM
T	TOP AND BOTTOM TONGUE AND GROOVE TOP OF CURB TOILET DISPENSER TELEPHONE TEMPERATURE TERRAZZO THERMOSTAT OR THERMAL THICK TOP OF TOP OF CONCRETE TOILET TOP OF PAVING TOP OF STEEL TOP OF WALL TOILET PAPER DISPENSER THERMOPLASTIC MEMBRANE TREAD TELEVISION TYPICAL OR TYPICAL UON
U	UNDERWRITERS LABORATORIES UNLESS OTHERWISE NOTED URINAL
V	VITEROUS CLAY PIPE VINYL COMPOSITION TILE VERTICAL VESTIBULE VERTICAL GRAIN VERIFY IN FIELD VENT THROUGH ROOF VINYL WALL COVERING
W	WEST OR WIDTH WITH WATER CLOSET WOOD WINDOW WIRE GLASS WORK WHERE OCCURS WITHOUT WATERPROOF WORKING POINT WATER RESISTANT WOOD SCREW WAINSCOT WEIGHT WELED WIRE FABRIC WELED WIRE MESH
X	TRANSFORMER

SYMBOLS

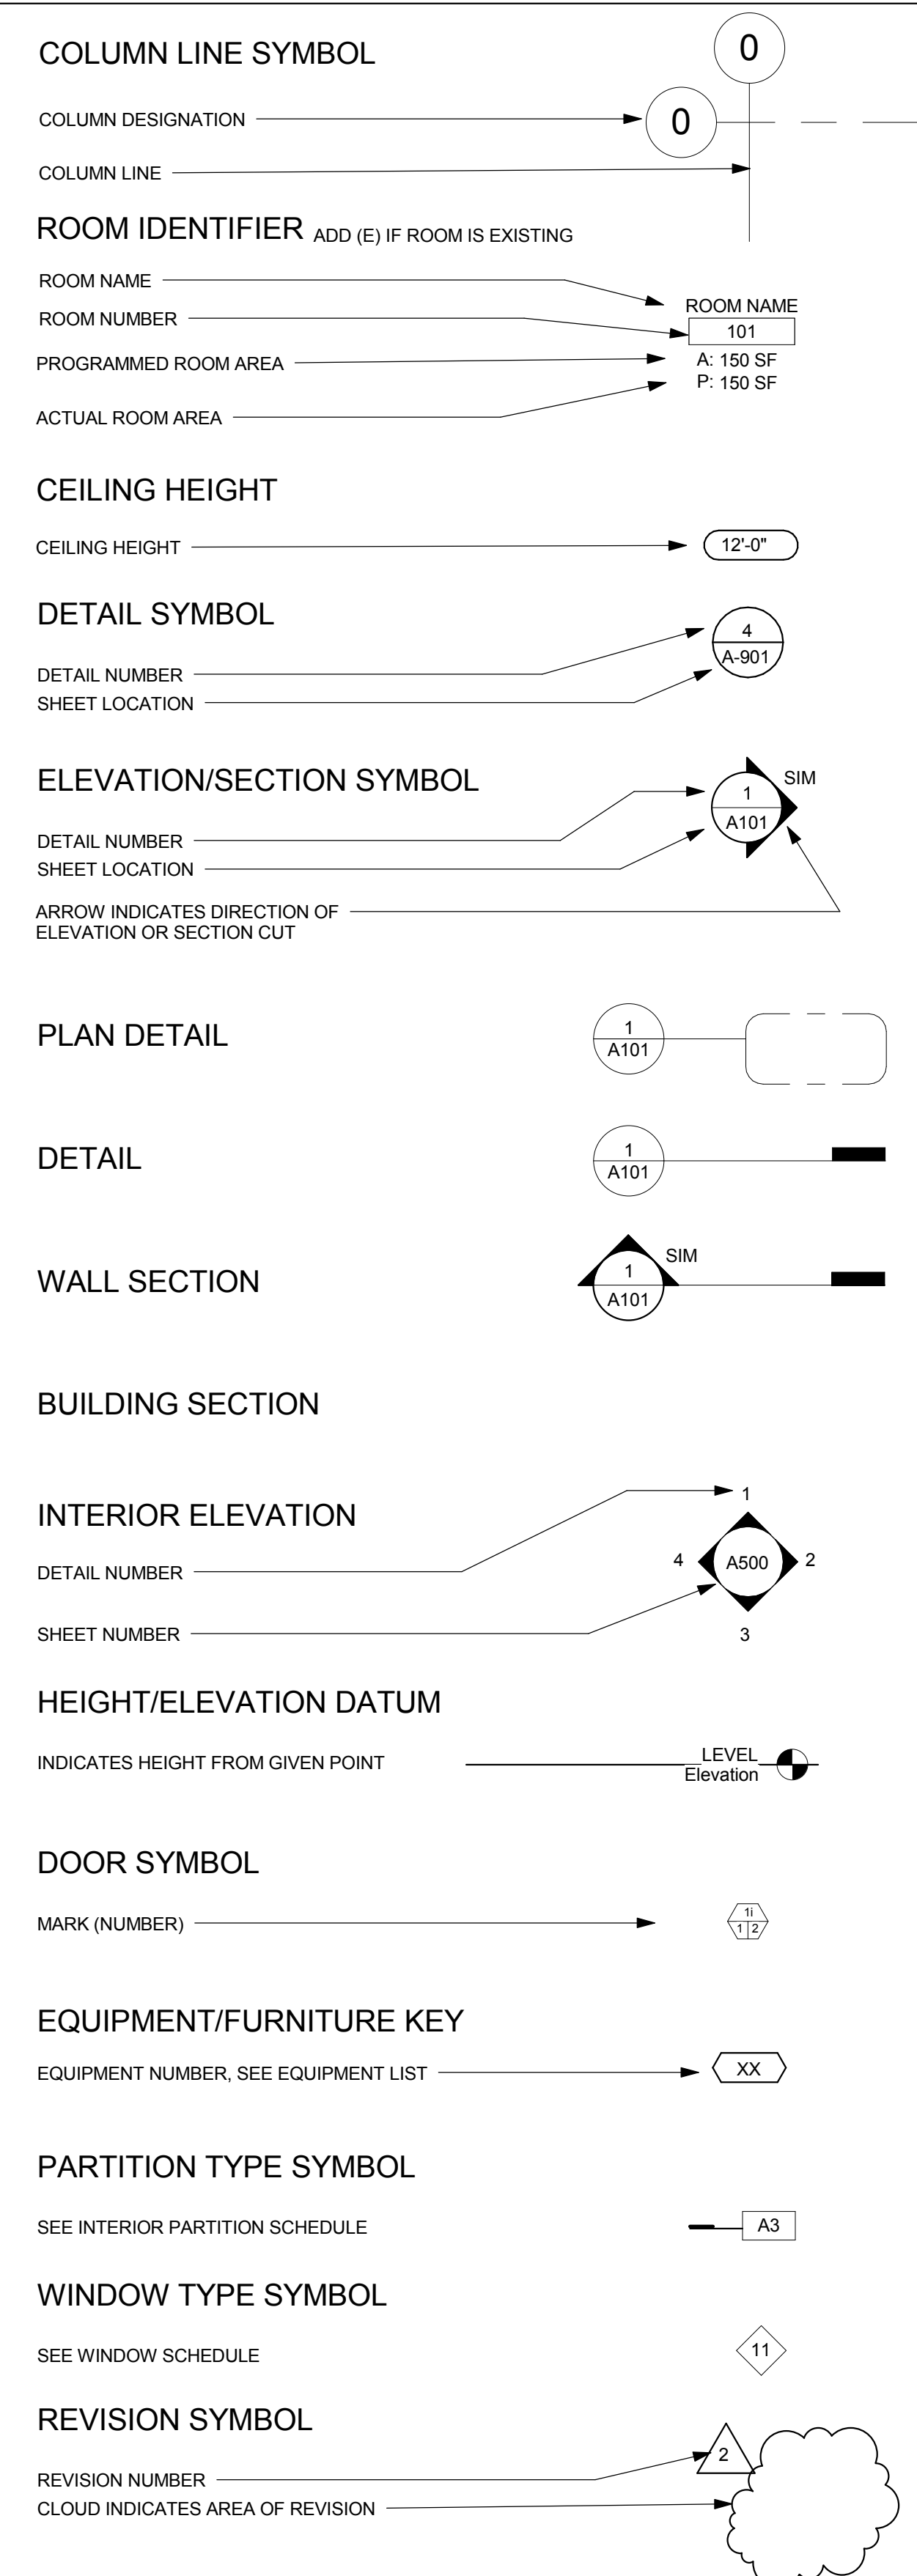

GENERAL NOTES

- THIS CONSTRUCTION CONTRACT IS FOR THE CONSTRUCTION OF A COMPLETE AND FULLY FUNCTIONING INSTALLATION. THESE DOCUMENTS DESCRIBE THE DESIGN INTENT AND SPECIFIC REQUIREMENTS OF THE INSTALLATION. THESE DOCUMENTS DO NOT INTEND TO SHOW EVERY ITEM REQUIRED TO CONSTRUCT THE WORK. ITEMS SUCH AS FASTENERS, CONNECTORS, FILLERS, MISCELLANEOUS CLOSURE ELEMENTS, ANCHILLARY CONTROL WIRING AND POWER WHERE REQUIRED FOR THE CONTROL OR OPERATION OF THE PROVIDED EQUIPMENT ARE NOT ALWAYS SHOWN BUT ARE CONSIDERED INCLUDED IN THE SCOPE OF THE WORK. IT IS THE RESPONSIBILITY OF THE CONTRACTOR TO PROVIDE A FULLY FUNCTIONING INSTALLATION WHICH MEETS THE DESIGN INTENT, INCLUDING THE SPECIFIC REQUIREMENTS INCLUDED IN THESE DOCUMENTS.
- ALL ITEMS SHOWN IN THESE DOCUMENTS ARE NEW UNLESS OTHERWISE NOTED.
- THESE DOCUMENTS DESCRIBE A SINGLE CONSTRUCTION CONTRACT. THE USE OF SUBCONTRACTORS IS THE ELECTION OF THE CONTRACTOR. THESE DOCUMENTS DO NOT INTEND TO DIVIDE THE WORK AMONG THE CONTRACTOR'S SUBCONTRACTORS WHERE THE DOCUMENTS IDENTIFY WORK WHICH IS NOT IN MECHANICAL WORK OR NOT IN ELECTRICAL WORK. IT MEANS THAT THE WORK IS NOT FURTHER DESCRIBED OR SPECIFIED IN THE MECHANICAL OR ELECTRICAL DRAWINGS OR SPECIFICATIONS. IT DOES NOT PRECLUDE THE CONTRACTOR FROM DELEGATING THE WORK TO THE ENTITIES OF THEIR ELECTION. IN ADDITION, THE DIVISION OF THE PROJECT MANUAL INTO ARCHITECTURAL, STRUCTURAL, MECHANICAL, ELECTRICAL AND OTHER DESIGN DISCIPLINES NEITHER DIVIDES THE WORK BETWEEN THE CONTRACTOR'S SUBCONTRACTOR NOR IMPLIES THAT ALL OF THE WORK FOR THOSE DISCIPLINES IS SHOWN ONLY IN THOSE DRAWINGS OR SPECIFICATIONS.
- IT IS THE RESPONSIBILITY OF THE GENERAL CONTRACTOR AND THE SUBCONTRACTORS TO REVIEW ALL DRAWINGS, PROJECT MANUAL, ETC. IN ORDER TO ASSURE THE COORDINATION OF ALL WORK AFFECTING EACH TRADE. FAILURE TO REVIEW AND COORDINATE ALL PROJECT MANUAL BY THE GENERAL CONTRACTOR WITH ALL THE SUBCONTRACTORS FOR APPLICABLE ITEMS OF THE WORK SHALL NOT RELIEVE THE RESPONSIBLE PARTY FROM PERFORMING ALL WORK SO REQUIRED AS PART OF THE CONTRACT.
- WHERE THERE ARE DISCREPANCIES BETWEEN THE PROJECT MANUAL AND THE DRAWINGS, THE CONTRACTOR SHALL ADVISE THE ARCHITECT AND REQUEST A CLARIFICATION. THE ORDER OF PRECEDENCE BETWEEN THE DRAWINGS AND THE PROJECT MANUAL IS AS DEFINED IN THE PROJECT MANUAL.
- THE CONTRACTOR SHALL LAYOUT AND SEQUENCE THE INSTALLATION OF THE WORK SO THAT THE DIFFERENT SYSTEMS DO NOT OBSTRUCT THE INSTALLATION OF SUCCESSIVE WORK. IN GENERAL, SYSTEMS INSTALLED FIRST SHOULD BE KEPT AS HIGH AND TIGHT TO STRUCTURE AS POSSIBLE SO AS TO LEAVE SPACE AVAILABLE FOR SYSTEMS WHICH FOLLOW.
- REFER TO THE PROJECT MANUAL FOR SPECIFICATIONS FOR GENERAL INFORMATION, PRODUCTS AND EXECUTION REQUIREMENTS. REQUIREMENTS OF THE SPECIFICATIONS APPLY TO ALL ASPECTS OF THE WORK AND ARE INCLUDED AS ADDITIONAL INFORMATION FOR EACH ITEM SPECIFIED. IF DISCREPANCIES EXISTING BETWEEN THE SPECIFICATIONS AND DRAWINGS, THE MORE STRINGENT REQUIREMENTS SHALL PREVAIL. THE GENERAL CONTRACTOR SHALL NOTIFY THE ARCHITECT OF ANY DISCREPANCIES.
- THE GENERAL CONTRACTOR AND ALL SUBCONTRACTORS WILL VISIT THE SITE IN ORDER TO FAMILIARIZE THEMSELVES WITH THE EXISTING CONDITIONS AND THE IMPACT OF THE PROPOSED NEW WORK, INDICATED ON THE DRAWINGS AND SPECIFICATIONS, ON THESE CONDITIONS. ANY QUESTIONS REGARDING THE COORDINATION OF NEW WORK OR EXISTING CONDITIONS MUST BE SUBMITTED TO THE DISTRICT IN WRITING WITH ADEQUATE TIME FOR RESPONSE. THE DISTRICT WILL RESPOND TO QUESTIONS, SUBMITTED IN A TIMELY MANNER, WITH WRITTEN CLARIFICATIONS.
- THE EXISTING DIMENSIONS AND CONDITIONS SHOWN ON THESE DRAWINGS ARE ASSUMED TO BE ACCURATE BASED ON AVAILABLE INFORMATION. THE CONTRACTOR SHALL, PRIOR TO THE START OF CONSTRUCTION, VERIFY ALL EXISTING CONDITIONS, PROVIDE A COMPLETE FIELD LAYOUT ON THE JOB SITE, AND NOTIFY THE DISTRICT AND ARCHITECT OF ANY DEVIATIONS OR CONFLICTS WITH THESE DRAWINGS.
- THE DRAWINGS SHALL NOT BE SCALED. THE GENERAL CONTRACTOR SHALL REFER TO THE DIMENSIONS INDICATED OR THE ACTUAL SIZES OF CONSTRUCTION ITEMS WHERE NO DIMENSION OR METHOD OF DETERMINING A LOCATION IS GIVEN, VERIFY CORRECT DIMENSION OR LOCATION WITH THE UNIVERSITY'S REPRESENTATIVE PRIOR TO INSTALLATION.
- THE DRAWINGS AND REFERENCED DETAILS HAVE BEEN DIMENSIONED IN ORDER TO ESTABLISH THE CONTROL AND GUIDELINES FOR FIELD LAYOUT. WHERE DISCREPANCY EXISTS BETWEEN THE DRAWING AND THE DETAIL, THE CONTRACTOR SHALL NOTIFY THE ARCHITECT FOR CLARIFICATION PRIOR TO INSTALLATION.
- UNLESS OTHERWISE NOTED, DIMENSIONS ARE TO FACE OF FINISH OR FACE OF SUBSTRATE AT SURFACES WITH CERAMIC TILE, WOOD PANELING OR OTHER SPECIAL FINISHES.
- WHERE DIMENSIONS ARE NOTED TO BE VERIFIED IN THE FIELD (V.I.F.), THE DIMENSION SHOWN IS THE DESIGN BASIS, BUT MAY DIFFER FROM ACTUAL CONDITIONS. CONTRACTOR SHALL VERIFY THESE DIMENSIONS WHILE LAYING OUT THE WORK AND REPORT ANY DISCREPANCIES BETWEEN THE DESIGN BASIS AND ACTUAL DIMENSIONS TO THE ARCHITECT PRIOR TO PROCEEDING WITH THE WORK. WHERE DIMENSIONS ARE NOTED "±", FIELD DIMENSIONS MAY VARY FROM THE NOTED DIMENSIONS BY MINOR AMOUNTS.
- INTERIOR DETAILS ARE KEVED TO THE PLANS AT TYPICAL LOCATIONS. TYPICAL DETAILS APPLY TO ALL LOCATIONS WHICH ARE SIMILAR BUT ARE NOT OTHERWISE DETAILED. THE CONTRACTOR AND SUBCONTRACTORS ARE RESPONSIBLE TO COORDINATE THE LOCATION OF ALL TYPICAL DETAILS AND INSTALL THE WORK INDICATED. IF DISCREPANCIES EXIST OR QUALIFICATION IS REQUIRED, THE CONTRACTOR SHALL NOTIFY THE ARCHITECT FOR CLARIFICATION PRIOR TO PROCEEDING.
- ABBREVIATIONS ON THIS SHEET APPLY TO THE ENTIRE SET UNLESS OTHERWISE NOTED.

WRNS STUDIO, LLP

501 SECOND STREET
4TH FLOOR, STE. 402
SAN FRANCISCO
CALIFORNIA 94107
415.489.2224 TEL
415.358.9100 FAX
WWW.WRNSSTUDIO.COM

Steinberg Architects



NO ISSUES/REVISIONS DATE

PROJECT RECORD SET

BUILDING 4 SKYLINE COLLEGE

SAN MATEO COUNTY
COMMUNITY COLLEGE
DISTRICT

CIP2 DESIGN-BUILD PROJECT BUILDING 4

PROJECT NO.: 07012.00 DRAWN BY: BC
DATE: 04/28/08 CHECKED BY: LG
SCALE: 1:1

GENERAL NOTES AND ABBREVIATIONS

SHEET NO. AN-001

All drawings and written material appearing herein constitute original and unpublished work of the Architect/Engineer and may not be duplicated, used or disclosed without consent of Architect/Engineer.

If this drawing is not 30"x42", then the drawing has been revised from its original size. Noted scales must be adjusted. This line should be equal to one inch.