
		# 1 2 2	SHEET		# 2 F		SHEET			SHEET		#	QUEET		#3
ET D.	SHEET NAME		NO.	SHEET NAME	IN C IN C	REMARKS	NO.	SHEET NAME	REMARKS	NO.	SHEET NAME	REMARKS	SHEET NO.	SHEET NAME	
RAL			A-103A	LEVEL 3 - ENLARGED FLOOR PLAN- SECTOR A	X		PC-100	KEY PLAN	1	M-503	LEVEL 2 MECHANICAL SEISMIC FLOOR PLAN	x	T-102	TELCOM PLAN LEVEL 2	X
	AWING INDEX, PROJ. DIRECTORY, PROJECT DATA	X	A-301	EXTERIOR BUILDING ELEVATIONS	X		PC-101	LEVEL 1 OVERALL FLOOR PLAN	() ()	M-504	LEVEL 3 MECHANICAL SEISMIC FLOOR PLAN	x	T-103	TELCOM PLAN LEVEL 3	
	MPUS PLAN ACCESSIBLE PATH OF TRAVEL		A-302	EXTERIOR BUILDING ELEVATIONS			PC-102	LEVEL 2 OVERALL FLOOR PLAN	1 1	M-505	ROOF MECHANICAL SESMIC FLOOR PLAN	×	T-201	TELECOM SINGLE LINE RISER	
	DE/LIFE SAFETY EXITING PLANS		A-302 A-321	ENLARGED ELEVATIONS			PC 102	LEVEL 2 OVERALL FLOOR PLAN	·]	M 506	LEVEL 1 MECHANICAL SEISMICT LOOK FLAN		T-500	TELECOM DETAILS	
	DE/LIFE SAFETT EXITING FLANS		A-321	ENLARGED ELEVATIONS			PC-103			IVI-500					<u>^</u>
			A-322		X		PC-104	OVERALL ROOF PLAN		M-507	LEVEL 2 MECHANICAL PIPING SEISMIC FLOOR PLAN X	X	SECURITY		
	DEMOLITION AND SEQUENCING		A-323	ENLARGED ELEVATIONS	X		PC-201	LEVEL 1 EMBED PLAN		M-508	LEVEL 3 MECHANICAL PIPING SEISMIC FLOOR PLAN X	X	SEC-0.00	PROJECT INFORMATION COVER SHEET	X
	EARTHWORK CROSS-SECTION KEY PLAN	[X]	A-324	ENLARGED ELEVATIONS	X		PC-202	LEVEL 2 EMBED PLAN		M-509	ANCHORAGE DETAILS AND CALCULATION X	X	SEC-001	SECURITY SYMBOLS LIST AND DRAWING INDEX	X
B4 E	EARTHWORK CROSS-SECTION (1 OF 2)	[X]	A-331	BUILDING SECTIONS	X		PC-203	LEVEL 3 EMBED PLAN	(]	M-510	ANCHORAGE DETAILS AND CALCULATIONS X	X	SEC-1.00	ACAMS RISER DIAGRAM	X
B4 E	EARTHWORK CROSS-SECTION (2 OF2)	[X]	A-332	BUILDING SECTIONS	X		PC-204	ROOF EMBED PLAN	(]	M-511	ANCHORAGE DETAILS AND CALCULATIONS X	X	SEC-1.01	ACAMS POINT-TO-POINT WIRING DIAGRAM	X
B4 S	STORM DRAINAGE SYSTEM PLAN	[X]	A-341	WALL SECTIONS	X		PC-321	ENLARGED ELEVATIONS		M-512	ANCHORAGE DETAILS AND CALCULATIONS X	X	SEC-1.02	ACAMS POINT-TO-POINT WIRING DIAGRAM	X
FOL	JNDATION DRAINAGE SYSTEM	X	A-342	WALL SECTIONS	X		PC-322	ENLARGED ELEVATIONS	a –	M-601	LEVEL 1 TEMP CONTROL ZONES X	X	SEC-1.03	ACAMS POWER SUPPLIES POINT-TO-POINT WIRING	X
	SANITARY SEWER SYSTEM		A-343	WALL SECTIONS	X		PC-323	ENLARGED ELEVATIONS		M-602	LEVEL 2 TEMP CONTROL ZONES X	x		DIAGRAM	
	WATER DISTRIBUTION SYSTEM		A-344	WALL SECTIONS	X		PC-324	ENLARGED ELEVATIONS	1	M-603	LEVEL 3 TEMP CONTROL ZONES X	x	SEC-1.04	CCTV RISER DIAGRAM	X
	JOINT TRENCH		A-345	WALL SECTIONS			PC-621	PREWELD ELEVATIONS	(1)	MP 201	LEVEL 1 MECHANICAL PIPING OVERALL FLOOR PLAN	×	SEC-1.05	NVR & STORAGE CCTV POINT-TO-POINT WIRING DIAGRAM	X
	IGATION PLAN & PROFILE		A-343	WALL SECTIONS				PREWELD ELEVATIONS		MD 202	LEVEL 2 MECHANICAL PIPING OVERALL FLOOR PLAN		SEC-1.06	AREA OF REFUGE RISER DIAGRAM & POINT-TO-POINT	X
		[X] [X]	A-346		X		PC-622			MP-202			020-1.00	WIRING DIAGRAM	
	TAIL SHEET UTILITIES (1 of 2)		A-420	STAIR PLANS AND SECTIONS	X		PC-623	PREWELD ELEVATIONS [2		MP-301	LEVEL 3 MECHANICAL PIPING OVERALL FLOOR PLAN X	X	SEC-2.01	FIRST FLOOR WEST SIDE SECURITY PLAN	X
	TAIL SHEET UTILITIES (2 of 2)	[X]	A-421	STAIR PLANS AND SECTIONS	X		PC-624	PREWELD ELEVATIONS [2		CONTROLS			SEC-2.01A	FIRST FLOOR EAST SIDE SECURITY PLAN	
	EROSION & SEDIMENTATION CONTROL	[X]	A-422	STAIR PLANS AND SECTIONS	X		PC-801	WALL SECTIONS [2		IC-100	CONTROL DIAGRAM COVER SHEET X	x	SEC-2.01A	SECOND FLOOR WEST SIDE SECURITY PLAN	
RAL			A-423	STAIR ELEVATIONS			PC-802	WALL SECTIONS		IC-101	CONTROL DIAGRAM SHEET 1 OF 4 X	X			X
GEN	NERAL STRUCTURAL NOTES	[X]	A-431	STAIR DETAILS	X		PC-803	WALL SECTIONS [2		IC-102	CONTORL DIAGRAM SHEET 2 OF 4 X	X	SEC-2.02A	SECOND FLOOR EAST SIDE SECURITY PLAN	X
	NERAL STRUCTURAL NOTES	[X]	A-432	STAIR DETAILS	X		PC-804	WALL SECTIONS		IC-103	CONTROL DIAGRAM SHEET 3 OF 4 X	x	SEC-2.03	THIRD FLOOR WEST SIDE SECURITY PLAN	X
	NERAL STRUCTURAL NOTES		A-433	STAIR DETAILS			PC-805	WALL SECTIONS	a	IC-104	CONTROL DIAGRAM SHEET 4 OF 4	x	SEC-2.03A	THIRD FLOOR EAST SIDE SECURITY PLAN	X
	PICAL FOUNDATION DETAILS		A-441	ENLARGED ELEVATOR PLANS			PC-806	WALL SECTIONS		PLUMBING			SEC-3.01	MDF EQUIPMENT LAYOUT	X
	PICAL FOUNDATION DETAILS		, , , , , , , , , , , , , , , , , , ,	SECTIONS/DETAILS			DC 921	CONNECTION DETAILS	<u>''</u>		DRAWING INDEX, EQUIPMENT, SCHEDULES & NOTES X	×	SEC-3.02	ACAMS DETAILS	X
	PICAL FOUNDATION DETAILS		A-501	INTERIOR ELEVATION (RESTROOM)	x		PC-031	CONNECTION DETAILS		P 401	1ST FLR DOMESTIC WATER AND NATURAL GAS PLUMBING		SEC-3.03	ACAMS DETAILS	X
			A_502	INTERIOR ELEVATION (RESTROOM)			PC-832					<u> </u>	SEC-3.04	CCTV DETAILS	X
	NERAL STEEL DETAILS		A-502 A-503	INTERIOR ELEVATIONS (ENTRY LOBBY & RECEPTIONS)			PC-833	CONNECTION DETAILS		D 402	2ND FLR DOMESTIC WATER AND NATURAL GAS PLUMBING X	~	SEC-3.05	AREA OF REFUGE DETAILS	X
	NERAL STEEL DETAILS	[X]		INTERIOR ELEVATIONS (ENTRY LOBBY & RECEPTIONS)	X		PC-834	CONNECTION DETAILS		P-102	ZND FLR DOWESTIG WATER AND NATURAL GAS PLOWBING	^	SEC-3.06	ACAMS DOOR DETAILS	
	NERAL STEEL DETAILS	[X]	A-504		X		PC-835	CONNECTION DETAILS	(]	D 402	3RD FLR DOMESTIC WATER AND NATURAL GAS PLUMBING X	~	SEC-3.07	ACAMS DOOR DETAILS	
GEN	NERAL STEEL DETAILS	[X]	A-505	INTERIOR ELEVATIONS	X		PC-836	CONNECTION DETAILS	(]	P-103	3RD FLR DOMESTIC WATER AND NATURAL GAS PLUMBING	^			^
TYP	PICAL DETAILS	[X]	A-506	INTERIOR ELEVATIONS			PC-837	CONNECTION DETAILS	[]	D 000	BELOW GRADE WASTE & VENT PLUMBING PLAN		AUDIO VISL		
	ERIOR METAL STUDS DETAILS	X	A-507	INTERIOR ELEVATIONS	X		PC-838	CONNECTION DETAILS	3	P-200		X	TA-001	AUDIOVISUAL SYMBOLS AND DRAWING INDEX	X
INTE	ERIOR METAL STUDS DETAILS	X	A-508	INTERIOR ELEVATIONS	X		PC-839	CONNECTION DETAILS		P-201	FIRST FLOOR WASTE & VENT PLUMBING PLAN X	X	TA-002	BACKBOX SCHEDULE AND NOTES	X
	ERIOR METAL STUDS DETAILS		A-509	INTERIOR ELEVATIONS	X		PC-840	CONNECTION DETAILS	1	P-202	SECOND FLOOR WASTE & VENT PLUMBING PLAN X	X	TA-011	AUDIOVISUAL RISER DIAGRAMS	X
	ERIOR METAL STUD DETAILS		A-510	INTERIOR ELEVATIONS			PC-841	CONNECTION DETAILS	'i	P-203	THIRD FLOOR WASTE & VENT PLUMBING PLAN	X	TA-101	LEVEL 1 AUDIOVISUAL OVERALL FLOOR PLAN	X
			A-701	DOOR SCHEDULE. DOOR & FRAME TYPES	x		PC-041			P-204	ROOF WASTE & VENT PLUMBING PLAN X	X	TA-102	LEVEL 2 AUDIOVISUAL OVERALL FLOOR PLAN	X
	NCRETE FLOOR AT TIERED SEATING		A-741	WINDOW SCHEDULE-EXTERIOR			PC-842	CONNECTION DETAILS		P-300	PLUMBING DETAILS X	X	TA-103	LEVEL 3 AUDIOVISUAL OVERALL FLOOR PLAN	X
			A-741 A-742	WINDOW SCHEDULE - EXTERIOR			PC-843	CONNECTION DETAILS [2		P-301	SANITARY WASTE PIPING SCHEMATICS	x	TA-201	LEVEL 1 AUDIO VISUAL OVERALL RCP	X
	/EL 2 FRAMING PLAN	[X]	7.1.12		X		PC-844	CONNECTION DETAILS		P-302	DOMESTIC WATER PIPING SCHEMATICS	x	TA-201	LEVEL 2 AUDIO VISUAL OVERALL RCP	
LEV	/EL 3 FRAMING PLAN	[X]	A-743	WINDOW SCHEDULE - INTERIOR and LOUVERS	X		PC-845	CONNECTION DETAILS	(]	P-400	PLUMBING SEISMIC DETAILS X	×			<u> </u>
ROC	OF FRAMING PLAN	[X]	A-744	WINDOW DETAILS - EXTERIOR	X		PC-846	CONNECTION DETAILS		P-400	PLUMBING SEISMIC DETAILS X		TA-203	LEVEL 3 AUDIO VISUAL OVERALL RCP	X
ENL	_ARGED PLANS	[X]	A-745	WINDOW DETAILS - EXTERIOR	X		PC-847	CONNECTION DETAILS	[]		SEISMIC FIRST FLOOR WASTE & VENT PLUMBING PLAN		TA-401	SECTIONS AND ELEVATIONS	X
TYP	PICAL STAIR DETAILS	[X]	A-746	WINDOW DETAILS	X		PC-851	GFRC DETAILS	3	P-402		X	TA-501	AUDIO VISUAL DETAILS	X
TYP	PICAL STAIR DETAILS		A-801	ROOF/EXTERIOR DETAILS	X		PC-852	GFRC DETAILS		P-403	SEISMIC, SECOND FLOOR WASTE & VENT PLUMBING PLAN X	X	FIRE PROTI		
	ARGED STAIR PLANS		A-802	ROOF/EXTERIOR DETAILS	X		PC-931	PREWELD DETAILS	1	P-404	SEISMIC, THIRD FLOOR WATER & VENT PLUMBING PLAN X	X	FP-100	FIRE PROTECTION GENERAL NOTES, SECTION & DETAILS	X
	ARGED STAIR PLANS		A-803	EXTERIOR GFRC PANEL DETAILS	X		PC-932	PREWELD DETAILS	'1	P-501	SEISMIC, 1ST FLR DOMESTIC WATER & NATURAL GAS X	X	FP-101	LEVEL 1 OVERALL FIRE PROTECTION FLOOR PLAN	X
	LARGED STAIR PLANS		A-804	EXTERIOR GFRC PANEL DETAILS	X		PC 022	PREWELD DETAILS	(<u>)</u>		PLUMB. PLAN		FP-101A	LEVEL 1 ENLARGED FIRE PROTECTION PLAN-SECTOR A	X
			A-805	EXTERIOR DETAILS	X		PC-933	•		P-502	SEISMIC, 2ND FLR DOMESTIC WATER & NATURAL GAS	X	FP-101B	LEVEL 1 ENLARGED FIRE PROTECTION PLAN-SECTOR B	X
			A_806	EXTERIOR DETAILS			FC-934	PREWELD DETAILS			PLUMB. PLAN		FP-102	LEVEL 2 OVERALL FIRE PROTECTION FLOOR PLAN	x
	NCRETE WALL ELEVATIONS		A 054	SEISMIC JOINT PLANS AND SECTIONS			PC-935	PREWELD DETAILS		ELECTRICA			FP-102A	LEVEL 2 ENLARGED FIRE PROTECTION PLAN-SECTOR A	x
	ACE FRAME ELEVATIONS						PC-936	PREWELD DETAILS []		E-001	SYMBOLS LIST, GENERAL NOTES, LIGHTING FIXTURE	×	FP-102A	LEVEL 2 ENLARGED FIRE PROTECTION PLAN-SECTOR A	X X
	ACE FRAME ELEVATIONS		A-852	SEISMIC JOINT SECTIONS			PC-937	PREWELD DETAILS [2			SCHEDULE		FP-102B	LEVEL 2 ENLARGED FIRE PROTECTION FLAN-SECTOR B	
	ACE FRAME DETAILS	[X]	A-853	SEISMIC JOINT DETAILS			PC-938	PREWELD DETAILS [2		E-002	TITLE 24 LIGHTING COMPLIANCE DOCUMENTATION X	×	11 100	LEVEL 3 OVERALL FIRE PROTECTION FLOOR PLAN	
	ACE FRAME DETAILS	[X]	A-900	ACCESSIBILITY			PC-939	PREWELD DETAILS [E-100	SINGLE LINE DIAGRAM X	X	FP-103A		A
BRA	ACE FRAME DETAILS	[X]	A-901	SIGNAGE SCHEDULE			PC-940	PREWELD DETAILS [2	[]	E-101	RISER DIAGRAMS X	x	FP-201	LEVEL 1 FIRE PROTECTION REFLECTED CEILING PLAN	X
FOL	JNDATION SECTIONS	[X]	A-902	INTERIOR PARTITION SCHEDULE	X		PC-941	PREWELD DETAILS	3	E-102	PANEL SCHEDULES X	x	FP-202	LEVEL 2 FIRE PROTECTION REFLECTED CEILING PLAN	X
	JNDATION DETAILS		A-910	INTERIOR DETAILS	X		PC-942	PREWELD DETAILS	a 🔰	E-103	PANEL SCHEDULES X	x	FP-203	LEVEL 3 FIRE PROTECTION REFLECTED CEILING PLAN	X
	/EL 2 DETAILS		A-911	INTERIOR DETAILS	X		PC-943	PREWELD DETAILS		F-200	ELECTRICAL SITE PLAN	x	FIRE ALARM		
	/EL 2 DETAILS		A-912	INTERIOR DETAILS			PC-944	PREWELD DETAILS		E_200	LEVEL 1 LIGHTING PLAN	×	FA-01	FIRE ALARM COVER SHEET	X
	/EL 3 DETAILS		A-913	INTERIOR DETAILS			PC-944	PREWELD DETAILS	<u>''</u> '	E 201	LEVEL 2 LIGHTING PLAN X	×	FA-02	MISCELLANEOUS NOTES & DETAILS	X
			A-914	INTERIOR DETAILS			DC 040						FA-03	FIRE ALARM CONTROL PANEL DETAILS - MXL	X
	H ROOF DETAILS		Δ_015	INTERIOR DETAILS				PREWELD DETAILS	<u>א</u>	E-203	LEVEL 3 LIGHTING PLAN X	<u>^</u>	FA-04	REMOTE ANNUNCIATOR PANEL DETAIL	x
JRAL			A 046	INTERIOR DETAILS			MECHANIC			E-301	LEVEL 1 POWER AND SIGNAL OVERALL FLOOR PLAN		FA-05	WHEELOCK POWER BOOSTER NAC EXTENDER PANEL	X
	NERAL NOTES AND ABBREVIATIONS		A-910				M-001	DRAWING INDEX, TITLE 24, LEGEND, & GENERAL NOTES	X	E-301A	LEVEL 1 POWER AND SIGNAL PLAN SECTOR A X	X	FA-06	BATTERY CALCULATIONS & VOLTAGE DROP	
-	E PLAN	X	A-920				M-002	IIILE 24	X	E-301B	LEVEL 1 POWER AND SIGNAL PLAN SECTOR B X	X		CALCULATIONS & VOLTAGE DROP	
	/EL 1 OVERALL FLOOR PLAN	X	A-930	CASEWORK DETAILS			M-003	MECHANICAL EQUIPMENT SCHEDULES	X	E-302	LEVEL 2 POWER AND SIGNAL OVERALL FLOOR PLAN		FA-07	TYPICAL WIRING DETAILS OF FIELD DEVICES	Y
	/EL 2 OVERALL FLOOR PLAN		A-931	CASEWORK DETAILS			M-101	LEVEL 1 MECHANICAL OVERALL FLOOR PLAN	X	E-302A	LEVEL 2 POWER AND SIGNAL PLAN SECTOR A X	X		FIRE ALARM RISER DIAGRAM	
LEV	/EL 3 OVERALL FLOOR PLAN	X	A-932	CASEWORK DETAILS			M-102	LEVEL 2 MECHANICAL OVERALL FLOOR PLAN	X	E-302B	LEVEL 2 POWER AND SIGNAL PLAN SECTOR B X	x	FA-08		
	ERALL ROOF PLAN		A-933	CASEWORK DETAILS	X		M-103	LEVEL 3 MECHANICAL OVERALL FLOOR PLAN	X	E-303	LEVEL 3 POWER AND SIGNAL OVERALL FLOOR PLAN		FA-09	FIRE ALARM - FIRST FLOOR	X
	/EL 1 REFLECTED CEILING PLAN		AI-101	LEVEL 1 OVERALL FINISH FLOOR PLAN	X		M-104	ROOF MECHANICAL OVERALL FLOOR PLAN	X	E-303A	LEVEL 3 POWER AND SIGNAL EVELOVER A X	x	FA-10	FIRE ALARM - SECOND FLOOR	X
	/EL 2 REFLECTED CEILING PLAN		AI-102	LEVEL 2 OVERALL FINISH FLOOR PLAN			M-104	MECHANICAL AND PIPING DETAILS	X	2 000/1	LEVEL 3 POWER AND SIGNAL PLAN SECTOR B		FA-11	FIRE ALARM - THIRD FLOOR	X
	/EL 3 REFLECTED CEILING PLAN		AI-103	LEVEL 3 OVERALL FINISH FLOOR PLAN	X		M_202	LEVEL 3 MECHANICAL COORDINATION PLAN		E-303B	ROOF ELECTRICAL OVERALL PLAN SECTOR B	×	FA-12	FIRE-ALARM - ROOF	
		X	AI-201	LEVEL 1 CORRIDOR FLOOR PATTERN					<u>^</u>						
ILEV	/EL 1- ENLARGED FLOOR PLAN- SECTOR A		-	LEVEL 2 & 3 CORRIDOR FLOOR PATTERN			M-204	ROOF MECHANICAL COORDINATION PLAN	X	E-400	ENLARGED ELECTRICAL ROOM PLANS X	X	L		
			AI-202				M-500	SEISMIC DETAILS	X	E-500	DETAILS, WIRING DIAGRAMS X	X			
	/EL 1- ENLARGED FLOOR PLAN- SECTOR B /EL 2 - ENLARGED FLOOR PLAN- SECTOR A							SEISMIC DETAILS		TELECOM					

DRAWING INDEX





G-003

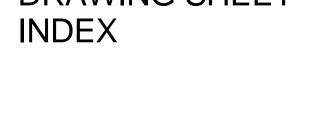

CIP2 DESIGN-BUILD PROJECT BUILDING 4

BUILDING 4 SKYLINE COLLEGE SAN MATEO COUNTY COMMUNITY COLLEGE DISTRICT



ISSUES/REVISIONS PROJECT RECORD SET

NO.

01

DATE 02/25/2011

Hensel Phelps Construction Co. Ð

501 SECOND STREET 4TH FLOOR, STE. 402 SAN FRANCISCO CALIFORNIA 94107 415.489.2224 TEL 415.358.9100 FAX WWW.WRNSSTUDIO.COM

Steinberg Architects

WRNSSTUDIO