



1 SECURITY SYSTEM ENLARGED MDF FLOOR PLAN
 SCALE: 1/2"=1'-0"

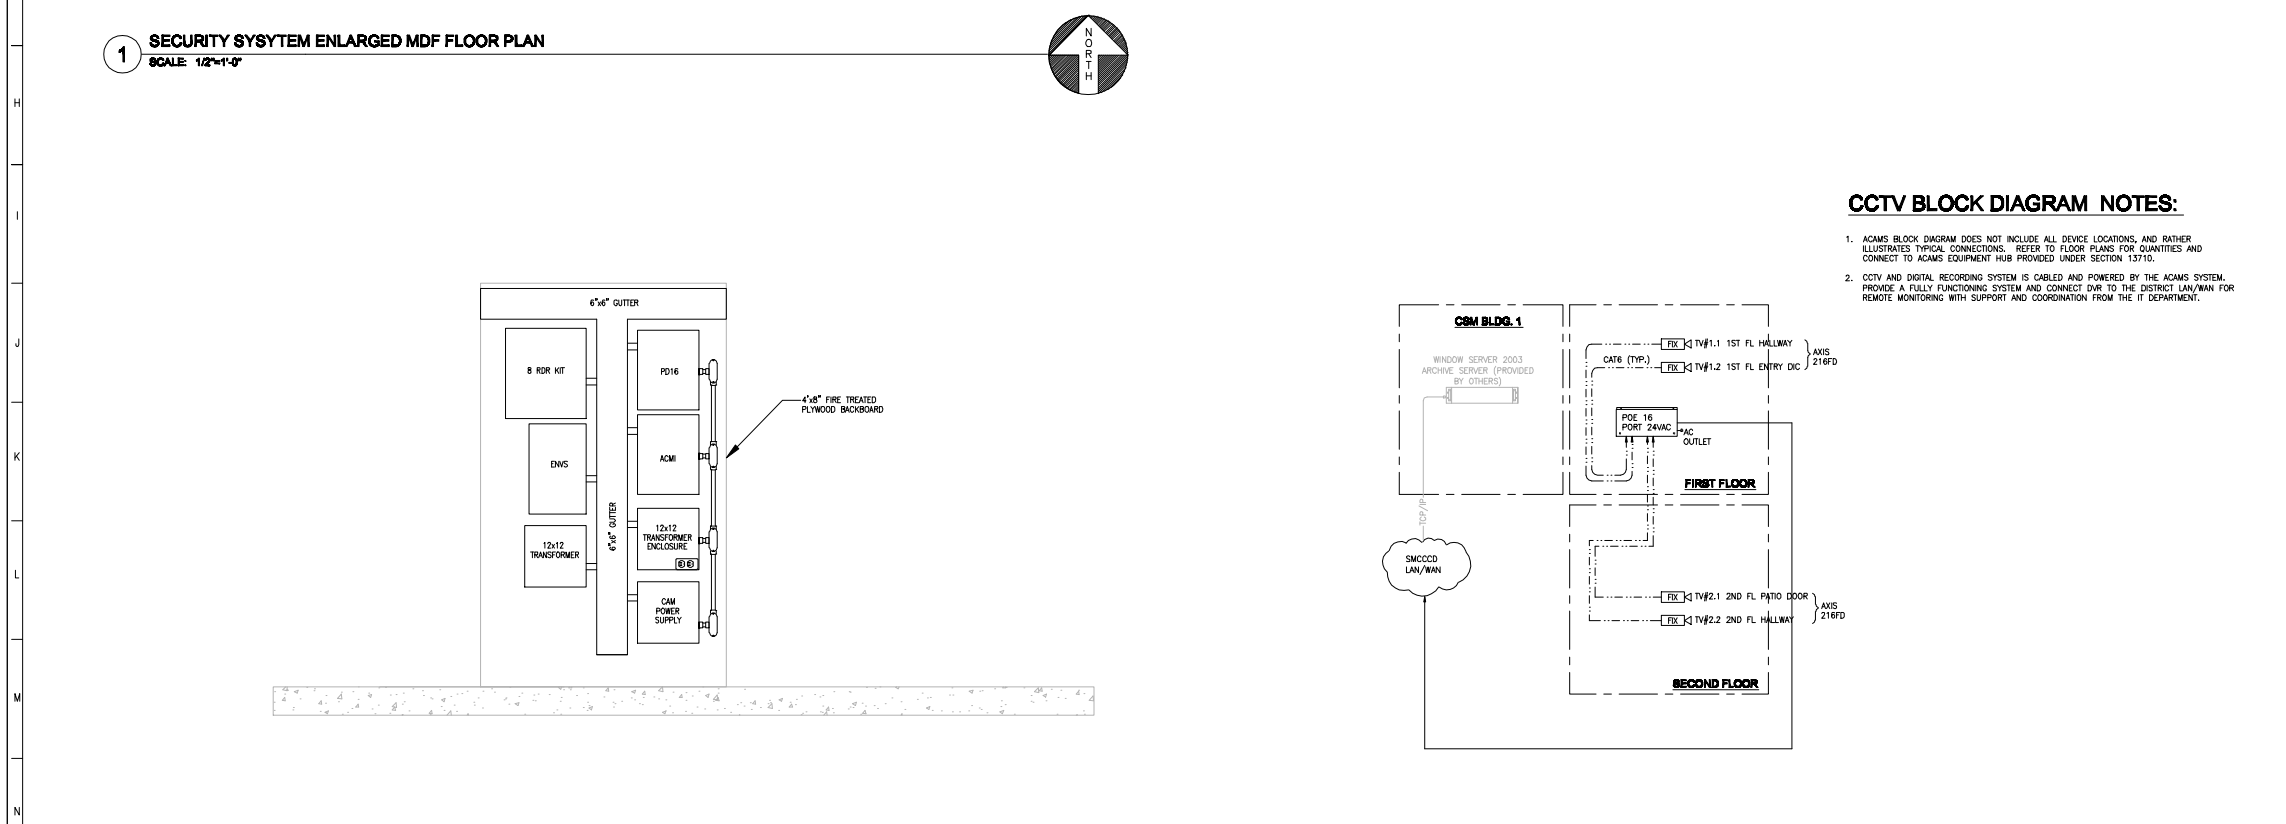


2 SECURITY SYSTEM PANEL ELEVATION
 SCALE: 1"=1'-0"

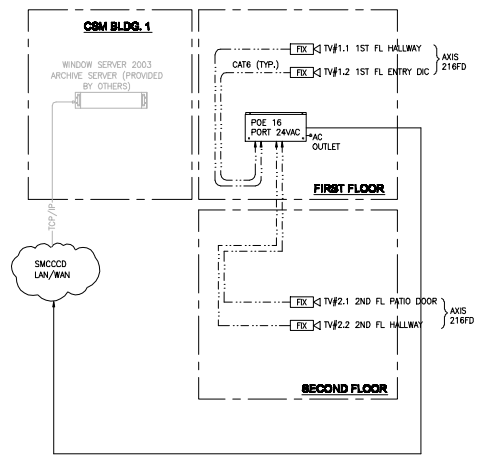

3 SECURITY SYSTEM PANEL ELEVATION
 SCALE: 1"=1'-0"

SHEET KEYNOTES:
 (1) PROVIDE NEW RACK MOUNTED MODULAR PATCH PANELS IN SPACES WHERE OLD PANELS WERE REMOVED. COORDINATE EXACT LOCATION WITH OWNER.

NetVersant
 47811 WARM SPRINGS BLVD.
 FREMONT, CA 94539
 OFFICE: 510.771.1200
 FAX: 510.252.0109

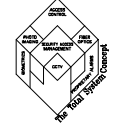

CCTV BLOCK DIAGRAM NOTES:

1. ACAMS BLOCK DIAGRAM DOES NOT INCLUDE ALL DEVICE LOCATIONS, AND RATHER ILLUSTRATES TYPICAL CONNECTIONS. REFER TO FLOOR PLANS FOR QUANTITIES AND CONNECT TO ACAMS EQUIPMENT HUB PROVIDED UNDER SECTION 13710.
2. CCTV AND DIGITAL RECORDING SYSTEM IS CABLED AND POWERED BY THE ACAMS SYSTEM. PROVIDE A FULLY FUNCTIONING SYSTEM AND CONNECT DVR TO THE DISTRICT LAN/WAN FOR REMOTE MONITORING WITH SUPPORT AND COORDINATION FROM THE IT DEPARTMENT.

ISSUANCE:
AS-BUILT DRAWINGS

PROPRIETARY INFORMATION
 NO PART OF THIS DOCUMENT MAY BE COPIED, REPRODUCED OR TRANSMITTED IN ANY FORM OR BY ANY MEANS WITHOUT PRIOR WRITTEN CONSENT OF NETVERSANT.

REVISIONS		
NO.	DATE	DESCRIPTION
1	3/19/09	REVISE FOR AS-BUILTS-ML

PROJECT:
 CANADA COLLEGE
 BUILDING # 8 PHASE 2
 REVOLUTION PROJECT
 4200 FARM HILL BLVD.
 REDWOOD CITY, CA 94061

SHEET TITLE:
 SECURITY SYSTEM
 PANEL ELEVATION,
 ENLARGED MDF FLOOR PLAN
 & CCTV BLOCK DIAGRAM

DATE: 8/25/08
 DRAWN BY: BCHA
 CHECKED BY: JLAMANTIA
 SCALE: AS NOTED
 JOB NO.: 109802306F25

SHEET NUMBER
SEC.4.01