

ABBREVIATIONS

TYP. TYPICAL
RW RETAINING WALL
N NORTHING
E EASTING



NOTES

1. ALL BUILDING GRIDLINE COORDINATES ARE BASED ON THE EXISTING TOPOGRAPHIC SURVEY BACKGROUND THAT WAS RECEIVED FROM THE SAN MATEO COUNTY COMMUNITY COLLEGE DISTRICT.
2. FOR ALL SITE FEATURE DIMENSIONING BEYOND FACE OF BUILDING, SEE LANDSCAPE DRAWINGS.
3. FOR ADA STALLS DIMENSIONING, SEE $\begin{matrix} 80, b \\ C-902 \end{matrix}$

BUILDING 4 CONTROL


ID	ARCH GRIDLINES	NORTHING	EASTING
(A)	(B) (12)	2,058,194.4721	5,992,033.7634
(B)	(D) (12)	2,058,225.7869	5,992,084.5522
(C)	(B) (L)	2,057,953.0128	5,992,182.6398
(D)	(G) (L)	2,058,037.3790	5,992,319.4714

REFERENCE

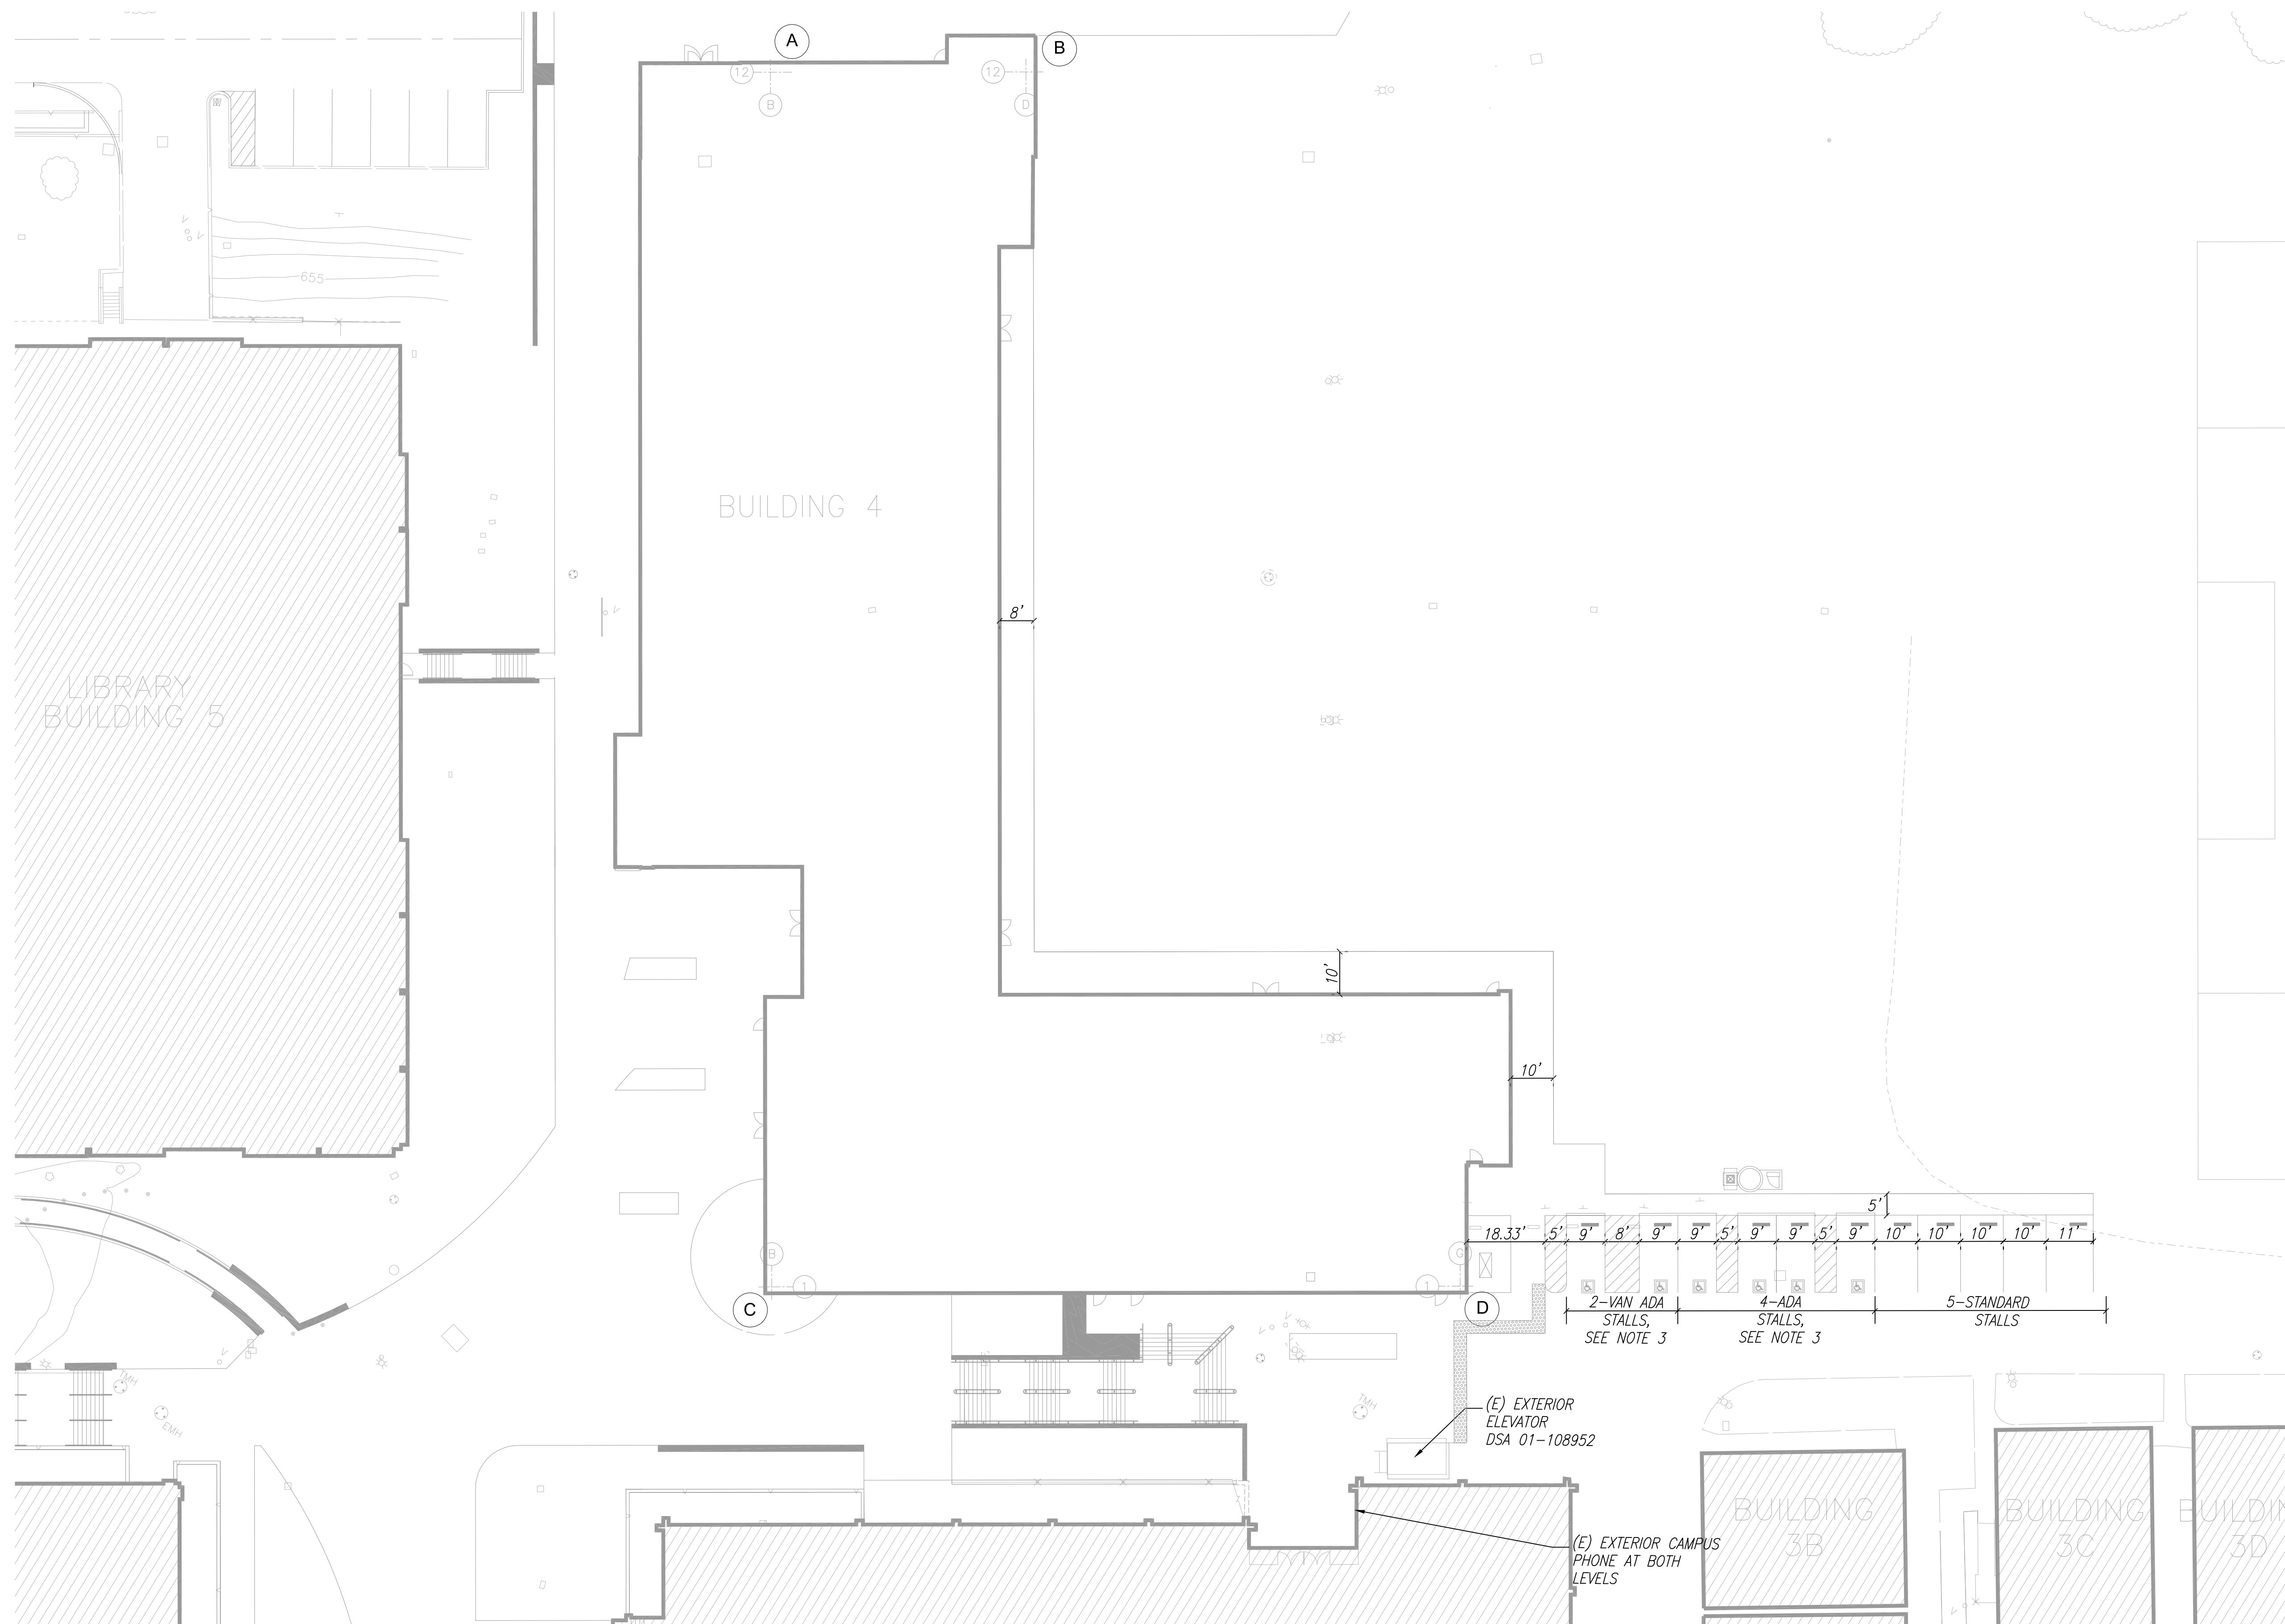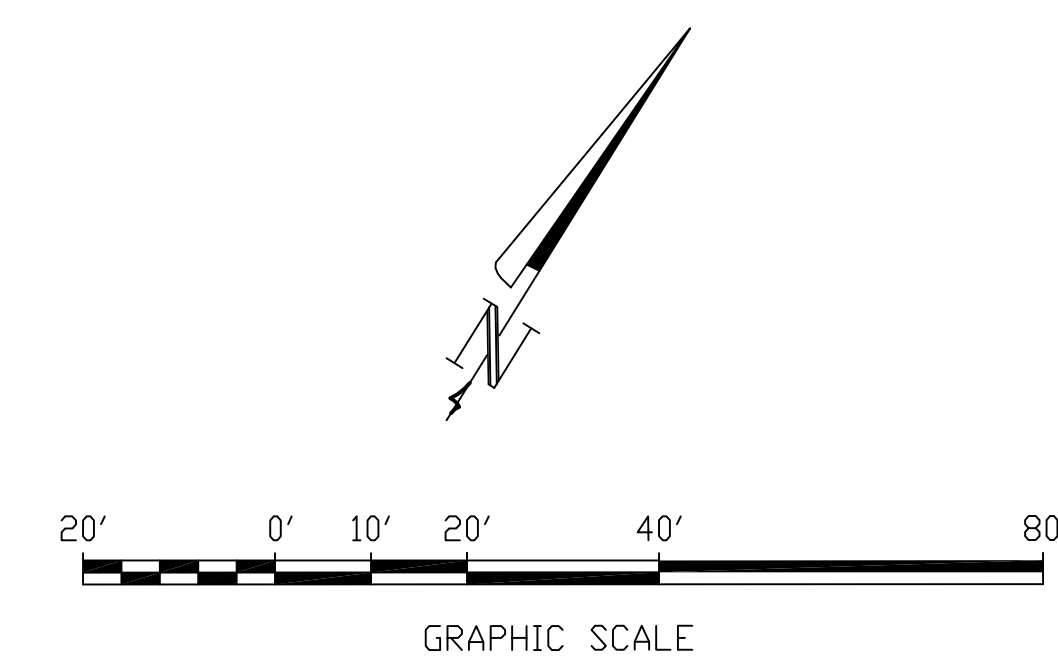

PROJECT RECORD SET

**SKYLINE COLLEGE
CIP2 DESIGN-BUILD
BUILDING 4**

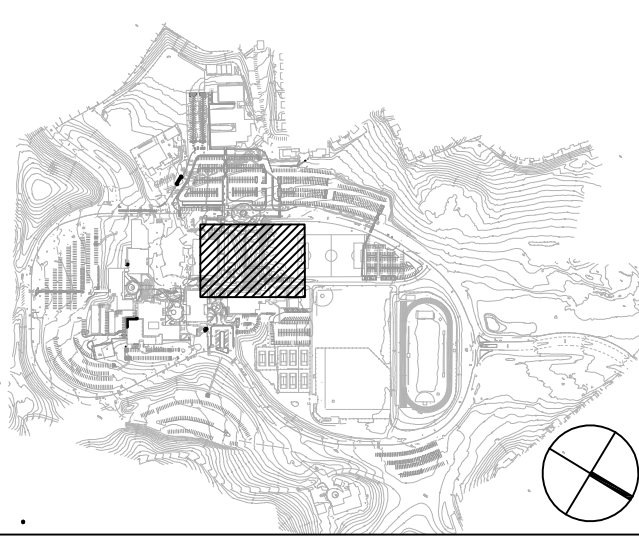

PROJECT NO. 07012.00 DRAWN BY: DZ
DATE: 01/31/11 CHECKED BY: MC
SCALE: AS SHOWN

**HORIZONTAL
CONTROL &
DIMENSIONING
PARKING LOT D
CURB**

SHEET NO.

C-201

FOR REFERENCE ONLY