



PROFILE A-A

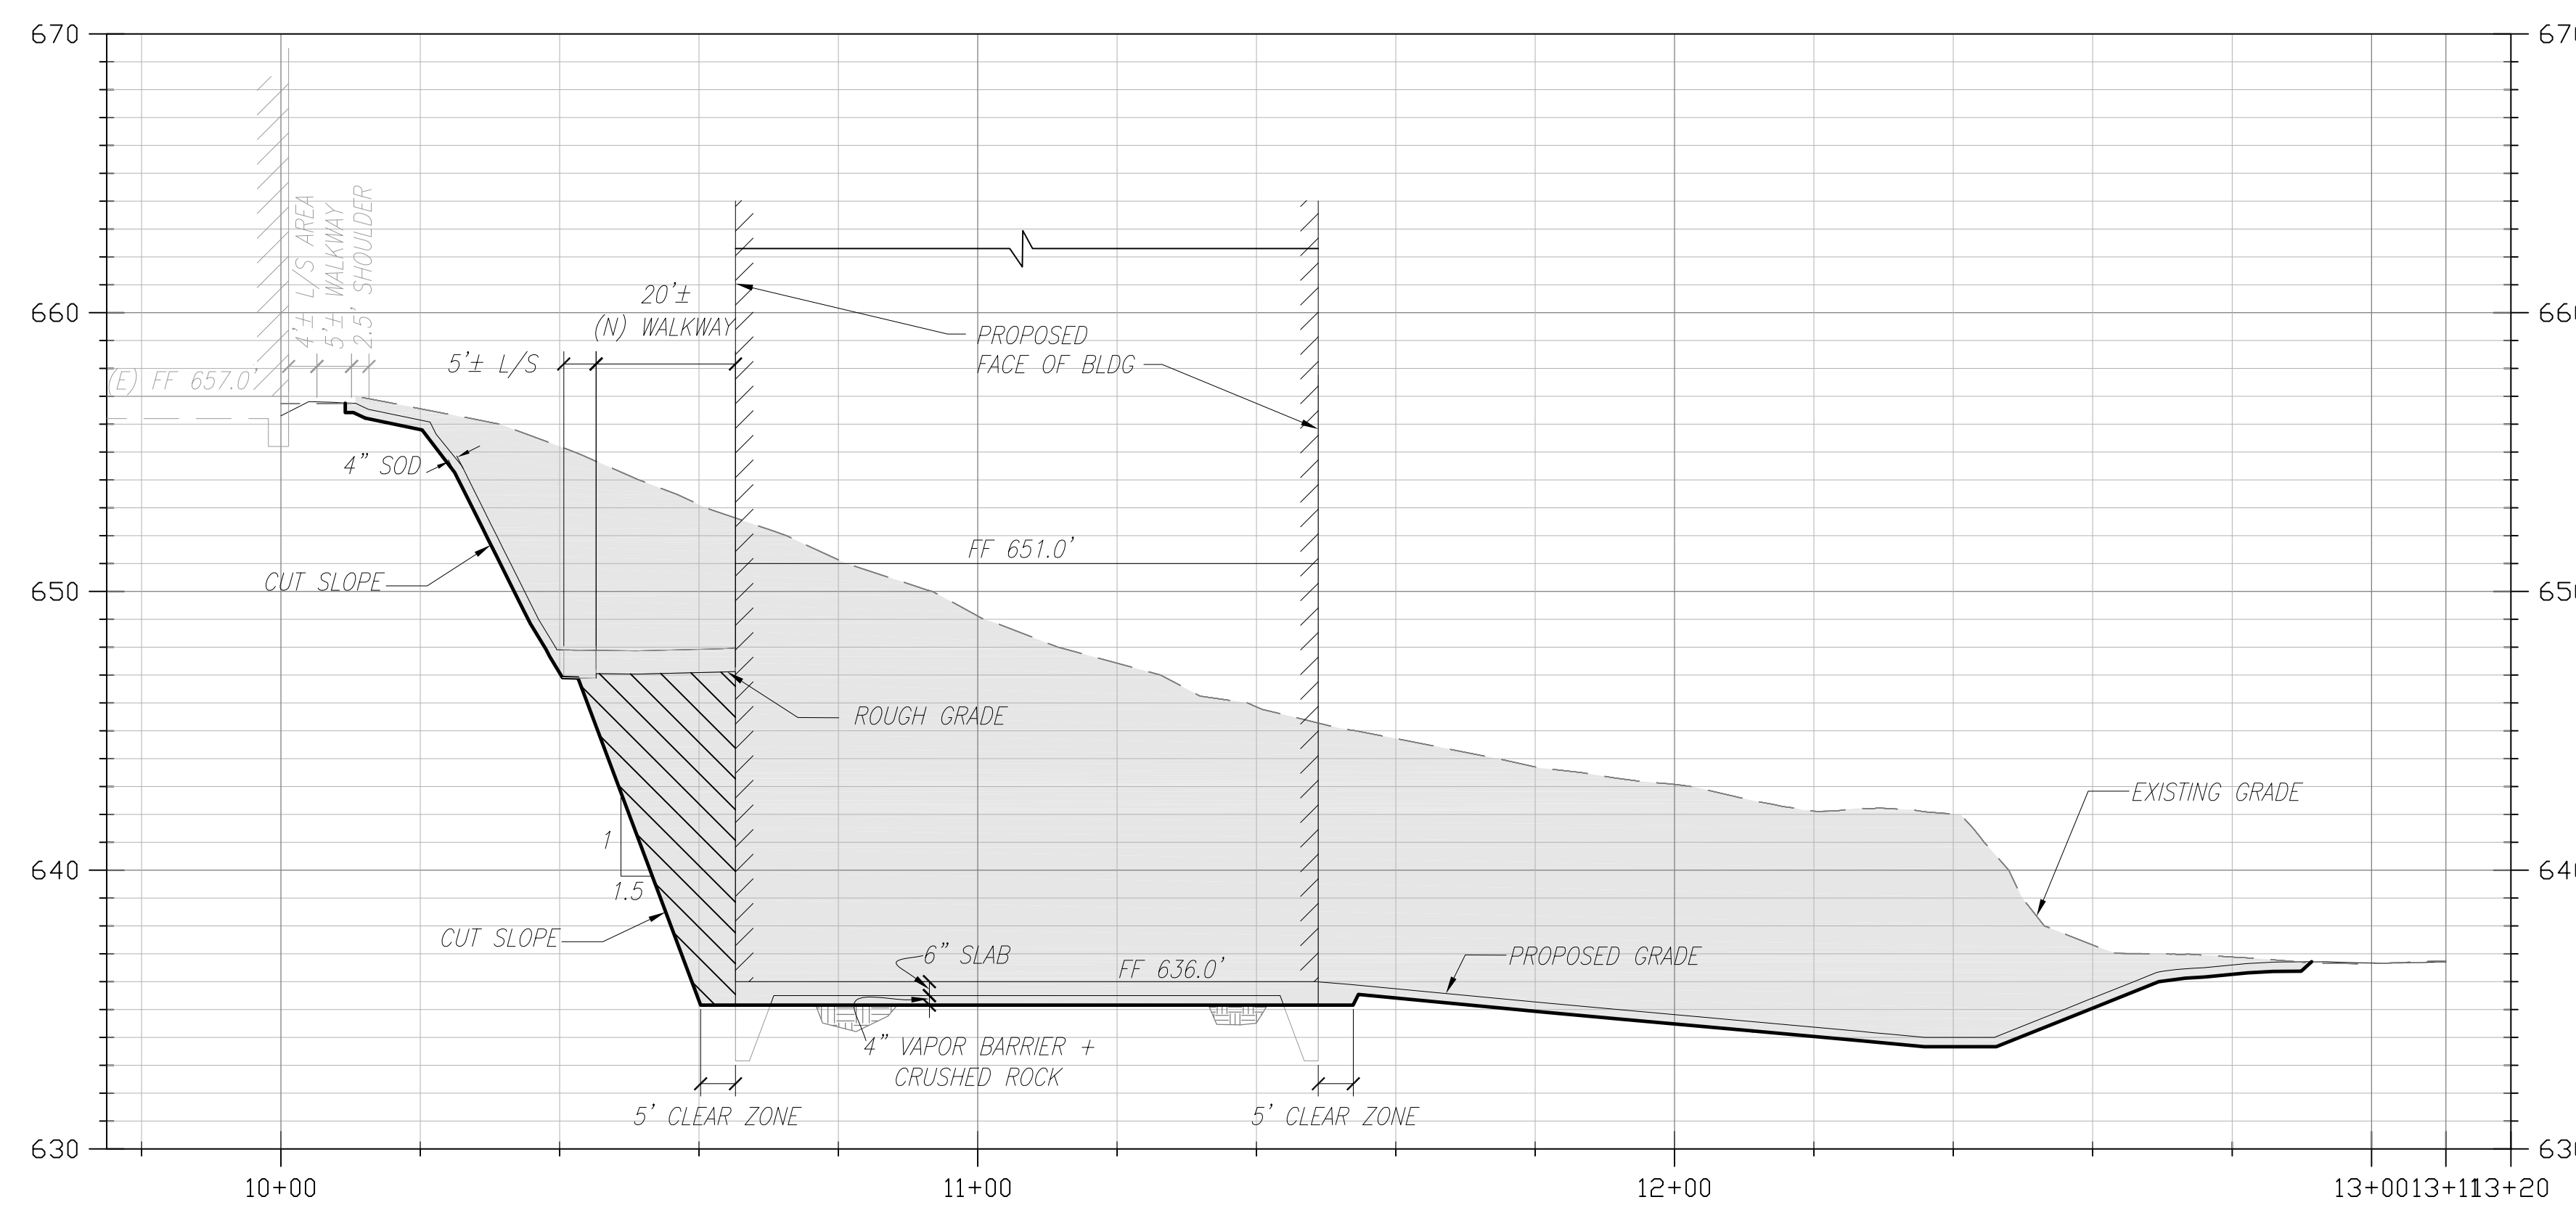

PROFILE B-B



NOTES

1. ALL NEW IMPROVEMENTS AND DIMENSIONS SHOWN ARE BASED ON THE SITE IMPROVEMENT PACKAGE.
2. ROUGH GRADING IS BASED ON THE FINISHED FLOOR OF BUILDING 4 (INCREMENTS 2 & 3) AND FINE GRADING AND DRAINAGE IN SITE IMPROVEMENT PACKAGE.

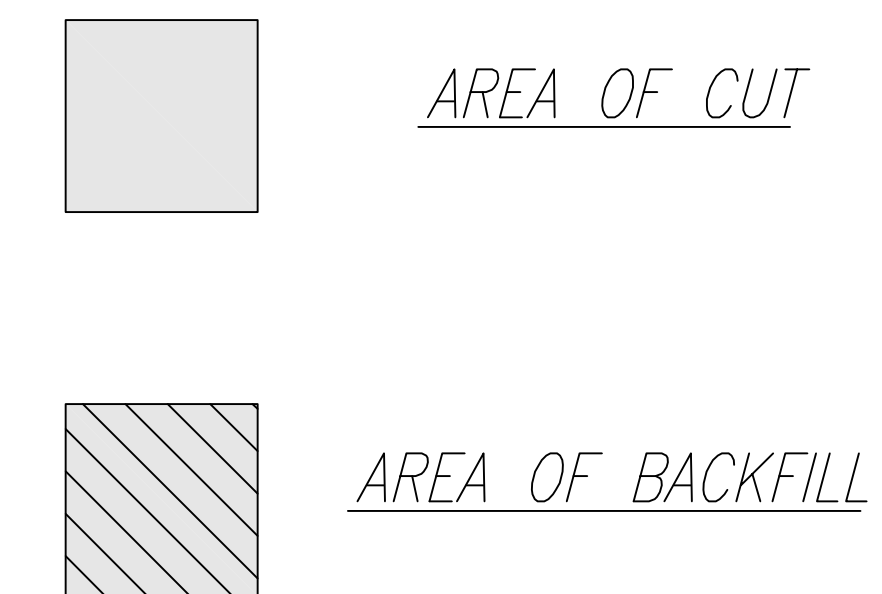

PROJECT RECORD SET

SKYLINE COLLEGE
CIP2 DESIGN-BUILD
BUILDING 4

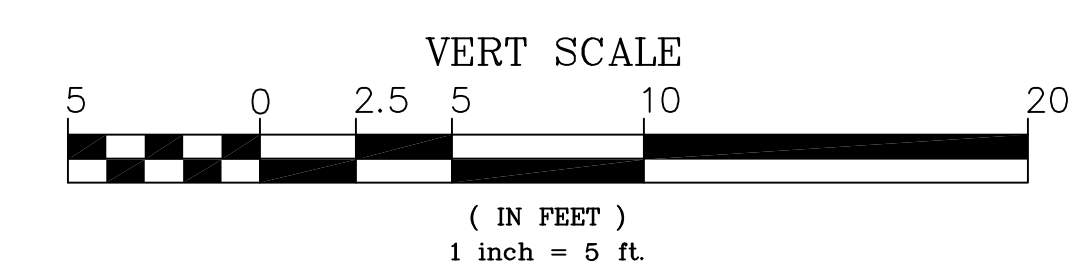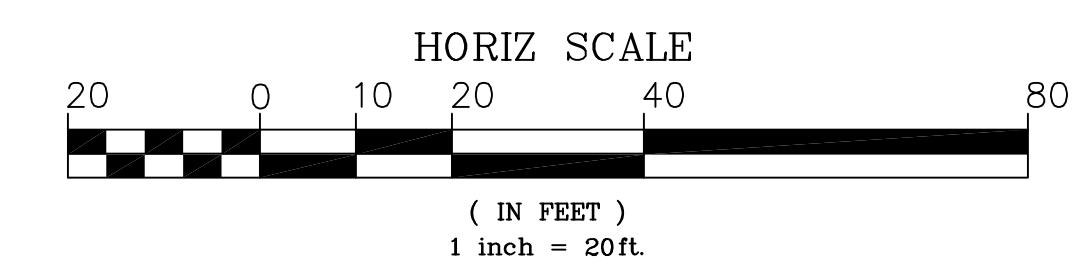

PROJECT NO: 07012.00 DRAWN BY: DZ
DATE: 01/31/11 CHECKED BY: MC
SCALE: AS SHOWN

SHEET TITLE:
**BUILDING 4
EARTHWORK
CROSS-SECTIONS
(1 OF 2)**