

SANITARY SEWER NOTES

- 1 FOR ALL SANITARY SEWER LATERALS, SEE P-200 FOR CONTINUATION WITHIN BUILDING.
- 2 6" SS @ S=0.0200 MIN, U.N.O.
- 3 RECONNECT TO (E) LATERAL. EXACT LOCATION AND INVERT V.I.F.
- 6e WORK TO BE COMPLETED PRIOR TO EXCAVATION PER SITE SEQUENCING NOTE 6e AS SHOWN ON SHEET C-301.
- 70 WORK TO BE COMPLETED AFTER BACKFILL PER SITE SEQUENCING NOTE 10 AS SHOWN ON SHEET C-301.

SS STRUCTURE CALLOUT

STRUCTURE ID	NORTHING	EASTING	TYPE	SPECIAL			DETAIL
				SMCCO SPECIFIED (OR APPROVED EQUAL)	TRAFFIC	ADA	
SSCO #201	2,057,902.5124	5,992,133.7469	CHRISTY BOX MODEL 05				4 C-902
SSCO #202	2,058,061.9938	5,992,035.4079	CHRISTY BOX MODEL 05	X	X		4 C-902
SSCO #203	2,058,169.0845	5,991,863.7320	CHRISTY BOX MODEL 05				4 C-902
SSCO #301	2,058,130.8538	5,992,151.5539	CHRISTY BOX MODEL 05				4 C-902
SSCO #302	2,058,059.8666	5,992,191.8857	CHRISTY BOX MODEL 05				4 C-902
SSCO #303	2,058,001.7072	5,992,267.8914	CHRISTY BOX MODEL 05				4 C-902
SSCO #401	2,057,986.5080	5,992,249.3396	CHRISTY BOX MODEL 05				4 C-902

STRUCTURE ID	NORTHING	EASTING	TYPE	SPECIAL			DETAIL
				SMCCO SPECIFIED (OR APPROVED EQUAL)	TRAFFIC	ADA	
SSMH #204	2,058,202.2684	5,991,975.7608	48" DIAMETER PRECAST ECCENTRIC MANHOLE ASSEMBLY		X		6 C-902
SSMH #303	2,058,001.7072	5,992,267.8914	48" DIAMETER PRECAST ECCENTRIC MANHOLE ASSEMBLY				6 C-902
SSMH #304	2,058,123.6640	5,992,295.3940	48" DIAMETER PRECAST ECCENTRIC MANHOLE ASSEMBLY				6 C-902
SSMH #305	2,058,036.2311	5,992,349.2560	48" DIAMETER PRECAST ECCENTRIC MANHOLE ASSEMBLY	X	X		6 C-902


UTILITY LEGEND & ABBREVIATIONS

ABBR.	SYMBOL	DESCRIPTION	DETAIL
SDMH	●	(N) SANITARY SEWER MANHOLE	6 C-902
(E) SSMH	○	(E) SANITARY SEWER MANHOLE	-
CO	●	SANITARY SEWER CLEAN OUT	4 C-902
SS	—SS—	(E) SANITARY SEWER PIPE	-
SS	—SS—	(N) SANITARY SEWER PIPE	-
	////	REMOVE OR ABANDON (E) PIPE	-
	[CUT & CAP EXISTING SS PIPE	3 C-902
	()*	INFO TO BE VERIFIED IN FIELD	-

REFERENCE



PROJECT RECORD SET

SKYLINE COLLEGE CIP2 DESIGN-BUILD BUILDING 4

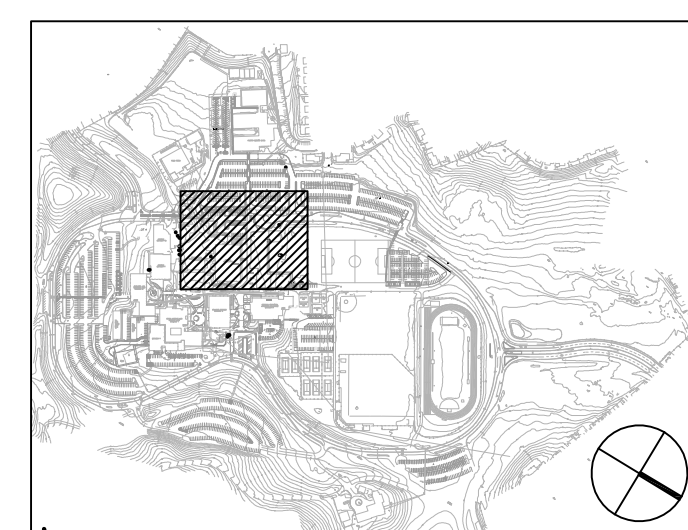

PROJECT NO. 07012.00 DRAWN BY: DZ
DATE: 01/31/11 CHECKED BY: MC
SCALE: AS SHOWN

BUILDING 4 SANITARY SEWER SYSTEM

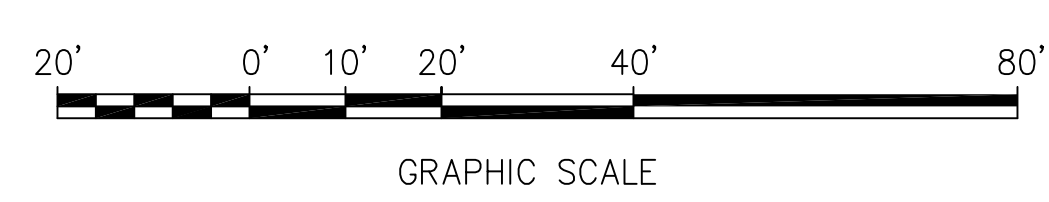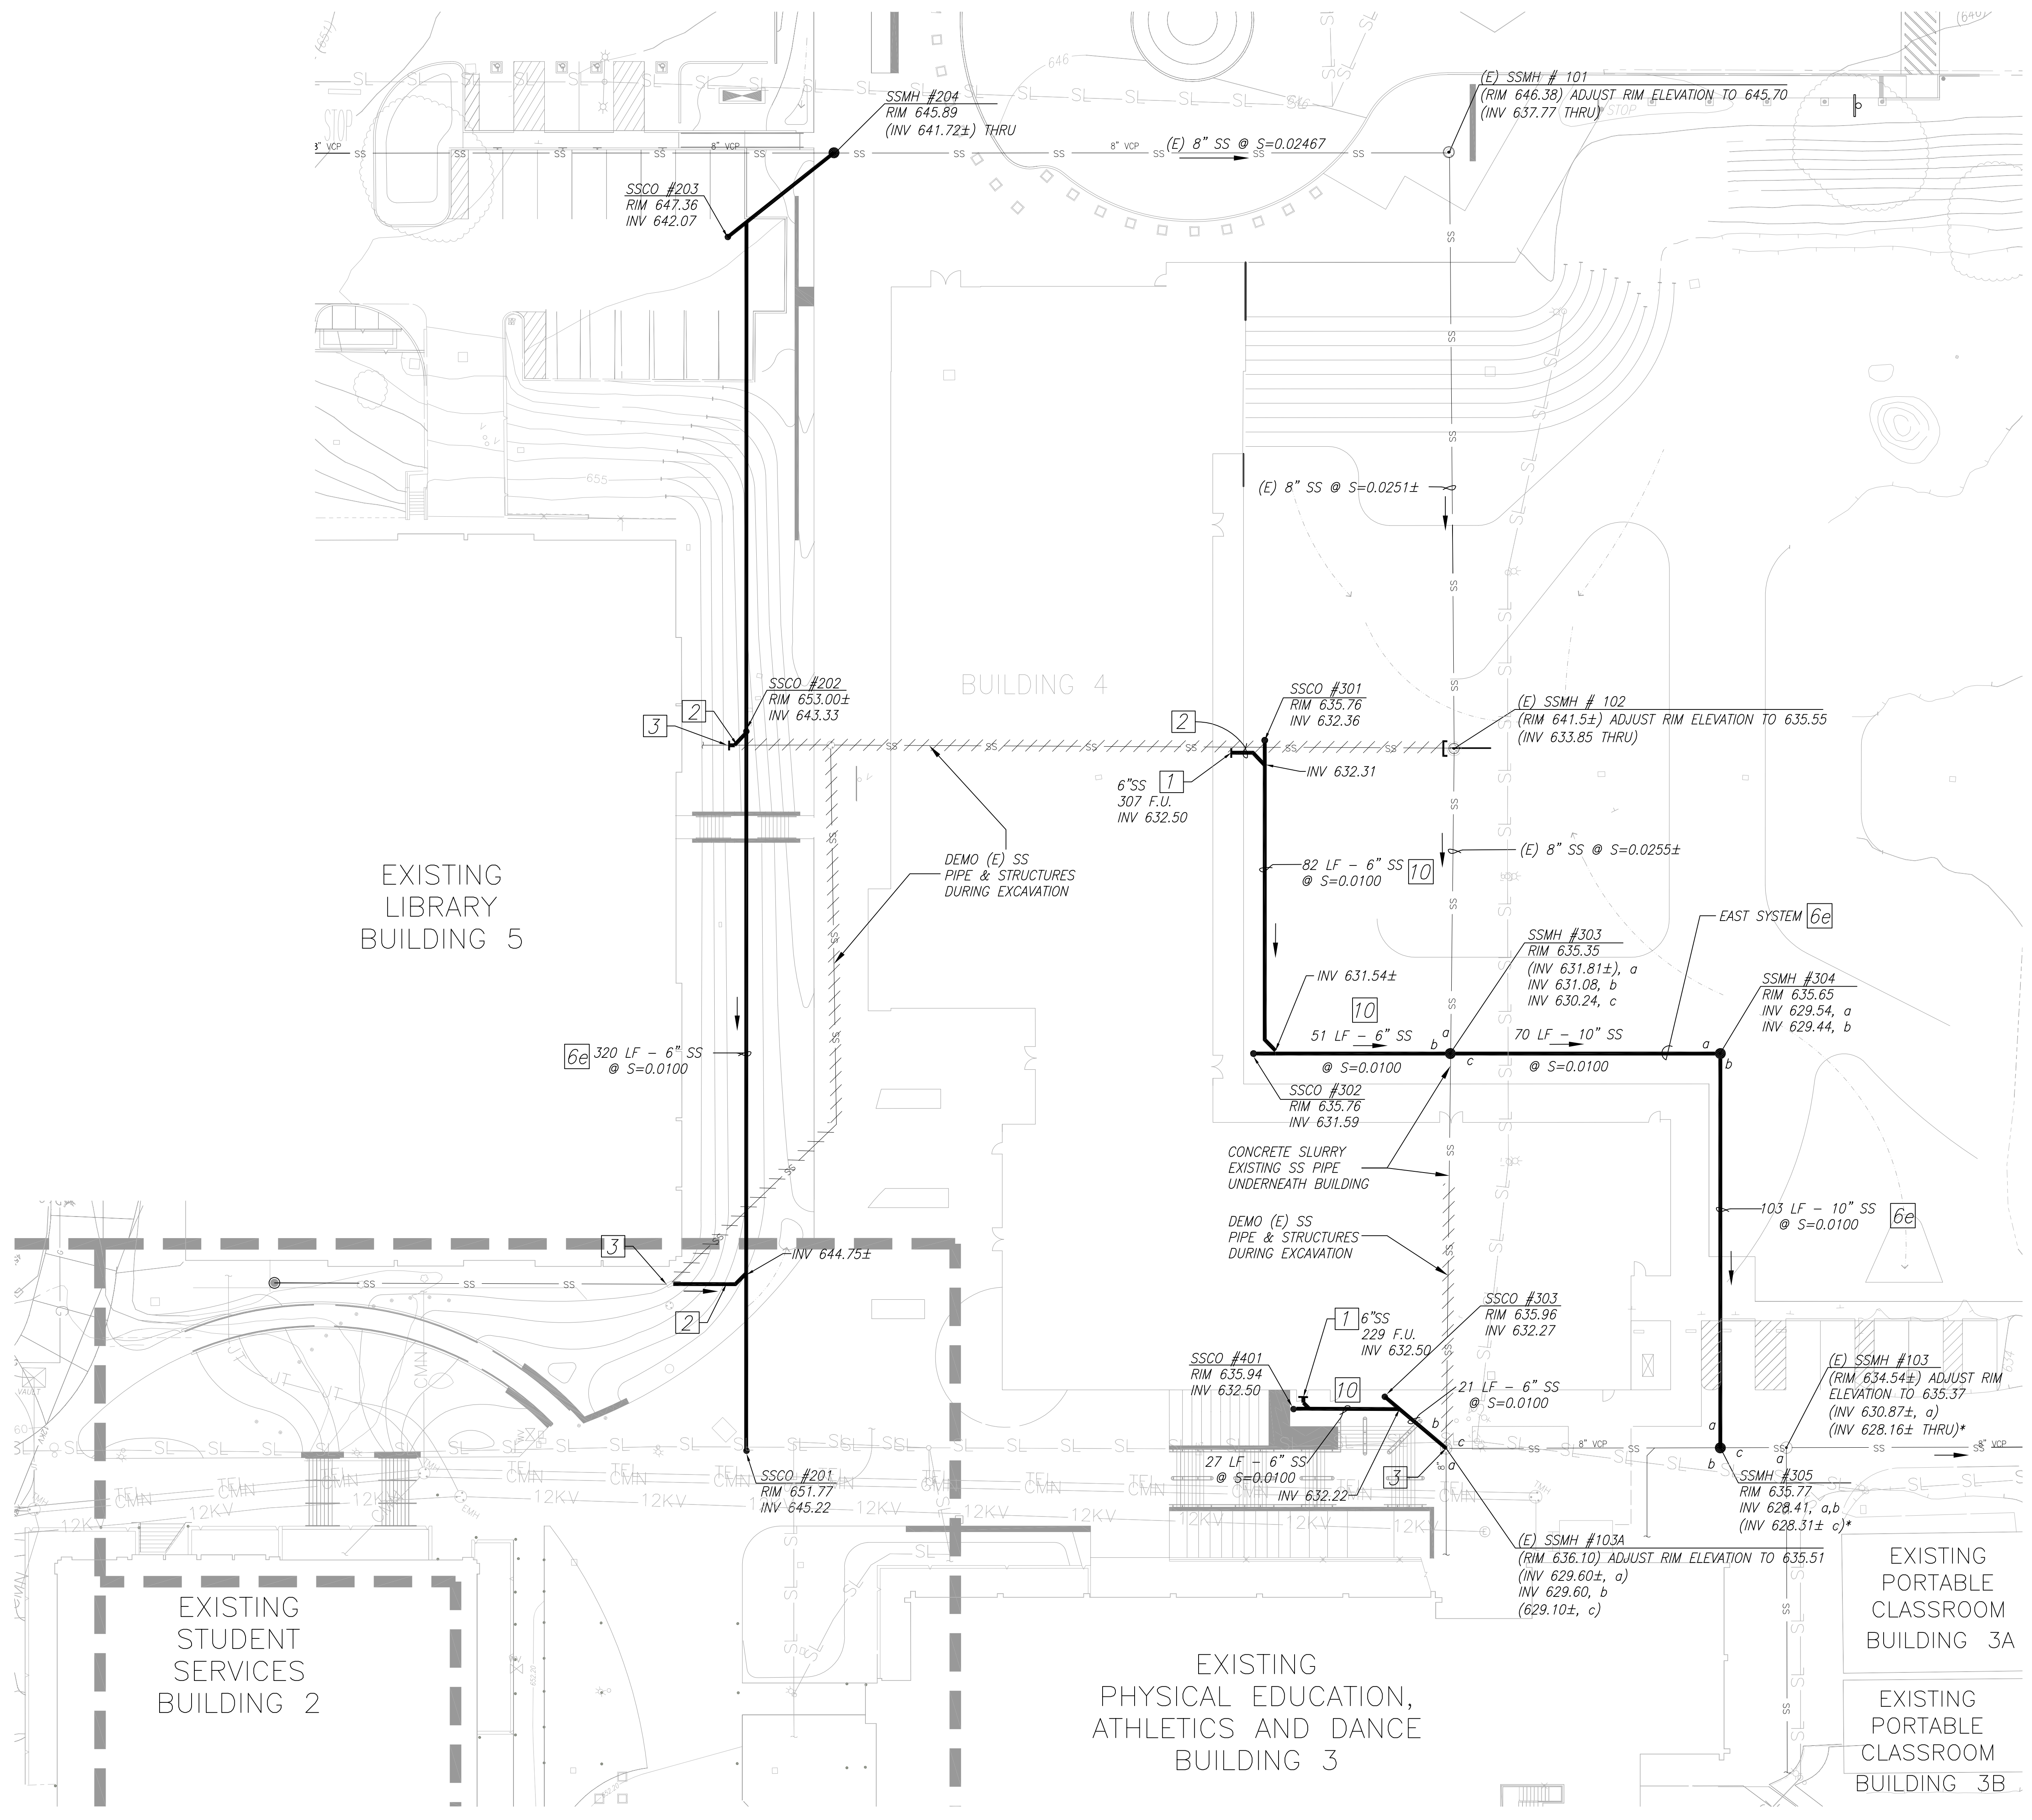

All drawings and written material appearing herein constitute original and unpublished work of the Architect/Engineer and may not be duplicated, used or disclosed without consent of Architect/Engineer. If this drawing is not 30"x42", then the drawing has been revised from its original size. Noted scales must be adjusted. This line should be equal to one inch.