


McCarthy Building Companies, Inc.  
343 Sansome Street, 14th Floor  
San Francisco, California 94104  
P 415 | 364-1339  
F 415 | 397-5999



255 SHORELINE DRIVE, SUITE 200  
REDWOOD CITY, CA 94065  
PHONE: (650) 482-6300  
FAX: (650) 482-6399

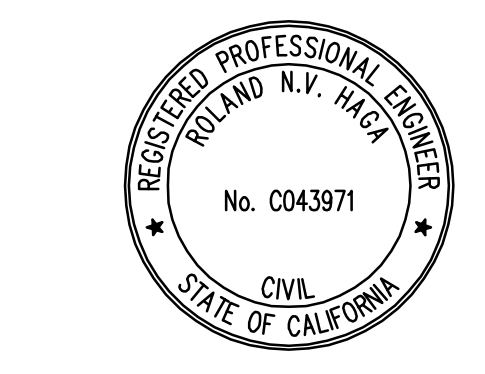

IDENTIFICATION STAMP  
DIV. OF THE STATE ARCHITECT  
OFFICE OF REGULATION SERVICE  
APPL. #: 01-110097  
AC: \_\_\_\_\_ FLS: \_\_\_\_\_ SS: \_\_\_\_\_  
DATE: \_\_\_\_\_  
FILE NUMBER: \_\_\_\_\_

This set of other project documents and all sheets, including and design incorporated therein are instruments of service. All project documents are the property of BKF, INC. BKF, INC. will accept no liability, and in whole or in part, for any project of any nature whatsoever that is not specifically approved by BKF, INC. and the State of California. BKF, INC. hereby disclaims any and all liability for any project documents, reproduction or modification (revised) is not only unlawful but also constitutes a violation of the Public Contract Code. BKF, INC. and its consultants shall not be held responsible for any errors or omissions in any project documents, including drawings, reports, or other project documents, unless such errors or omissions are the result of negligence on the part of BKF, INC. or its consultants. BKF, INC. and its consultants shall not be held responsible for any discrepancies between project documents and the existing conditions.

© Copyright 2008

College of San Mateo  
Site Package  
San Mateo, CA  
Developed for  
San Mateo County Community College District

Revision	Description	Date
1	BULLETIN #3	23 DEC 2009
2	PROJECT RECORD DRAWING	JUNE 2011

Revision	Description	Date
1	DSN SUBMITTAL	19 SEPT 2008
2	DSN FINAL	09 APRIL 2009
3	RT #26	28 AUG 2009
4	RT #26-1	08 AUG 2009
5	RT #26-1	22 JULY 2010
6	RT #26-1	12 AUG 2010
7	BULLETIN #1	05 NOV 2009
8	BULLETIN #2	16 NOV 2009

**RECORD DRAWINGS**  
THESE RECORD DOCUMENTS HAVE BEEN PREPARED BASED ON INFORMATION PROVIDED BY OTHERS. BKF ENGINEERS HAS NOT VERIFIED THE ACCURACY AND/OR COMPLETENESS OF THIS INFORMATION AND SHALL NOT BE RESPONSIBLE FOR ANY ERRORS OR OMISSIONS THAT MAY BE INCORPORATED HEREIN AS A RESULT. BKF ENGINEERS DOES NOT ASSUME ANY RESPONSIBILITY FOR THE FIELD MODIFICATIONS TO THE PLANS.  
BY: BKF ENGINEERS DATE: JUNE 2011

Job No.	27082.30
Date	02 APRIL 2009
Drawn by	MD, JT
Checked by	RH
Scale	1"=60'

**MASTER GRADING PLAN**

**C1.04**