


- NOTES:**
- SEE SHEET C1.05 FOR ADDITIONAL AREAS OF PAVEMENT REHABILITATION WITHIN PARKING LOT 11.
 - SEE SHEET C3.01 FOR ADDITIONAL DEMOLITION NOTES.
 - REMOVE ALL TREES AND VEGETATION IN PARKING LOT ISLANDS AS INDICATED ON THIS PLAN. GRIND ALL STUMPS AND ROOTS TO A DEPTH OF 24" AND REMOVE GROUND MATERIAL, OR REMOVE STUMPS AND ROOTS IN THEIR ENTIRETY. BACKFILL AND COMPACT SOIL TO RECEIVE AGGREGATE BASE AND ASPHALT PAVING AS SPECIFIED IN PROJECT SPECIFICATIONS AND PLANS.
 - CAP ALL IRRIGATION LINES THAT MAY EXTEND INTO THE PARKING LOT PLANTERS AT THEIR SOURCE. DEMOLISH AND REMOVE ANY IRRIGATION LINES THAT MAY BE ENCOUNTERED IN THE TREE WELLS AND REMOVE DEBRIS FROM THE SITE.
 - REGRADE AREAS TO MAINTAIN POSITIVE DRAINAGE TOWARD EXISTING DRAINAGE FACILITIES AND/OR NATURAL DRAINAGE FEATURES.
 - GRIND EXISTING AC PAVEMENT IN PLACE AS INDICATED AND SCARIFY EXISTING AC GRINDINGS AND EXISTING AGGREGATE BASE TO A DEPTH OF 8". COMPACT TO 95% RELATIVE COMPACTION. REPAVE WITH 3" AC.
 - IDENTIFIED AREAS OF PAVEMENT BASE FAILURE SHALL BE RECONSTRUCTED TO CONFORM TO GEOTECHNICAL RECOMMENDATIONS.
 - SEE DETAIL 1, SHEET C1.08 FOR REWORKED PAVEMENT SECTION.
 - ADJUST VALVES, COVERS, VAULTS, ETC. TO FINISH GRADE AS NECESSARY.

- LEGEND:**
- GRIND EXISTING AC INTO EXISTING AB, COMPACT GRINDINGS IN PLACE, AND PLACE 3" AC TO BRING PAVEMENT UP TO GRADE
 - EXCAVATE, HAUL AND DISPOSE OF ALL TREES, STUMPS AND DEBRIS FROM WITHIN EXISTING TREE WELL AND REPLACE WITH 3" AC OVER COMPACTED AC AND AB GRINDINGS.
 - AREA OF PAVEMENT DEEP LIFT, LIFT TOP 6" OF AC/AB AND PATCH WITH NEW AC TO PROVIDE SMOOTH PAVEMENT TRANSITION
 - AREA OF EDGE GRIND WITH AC OVERLAY

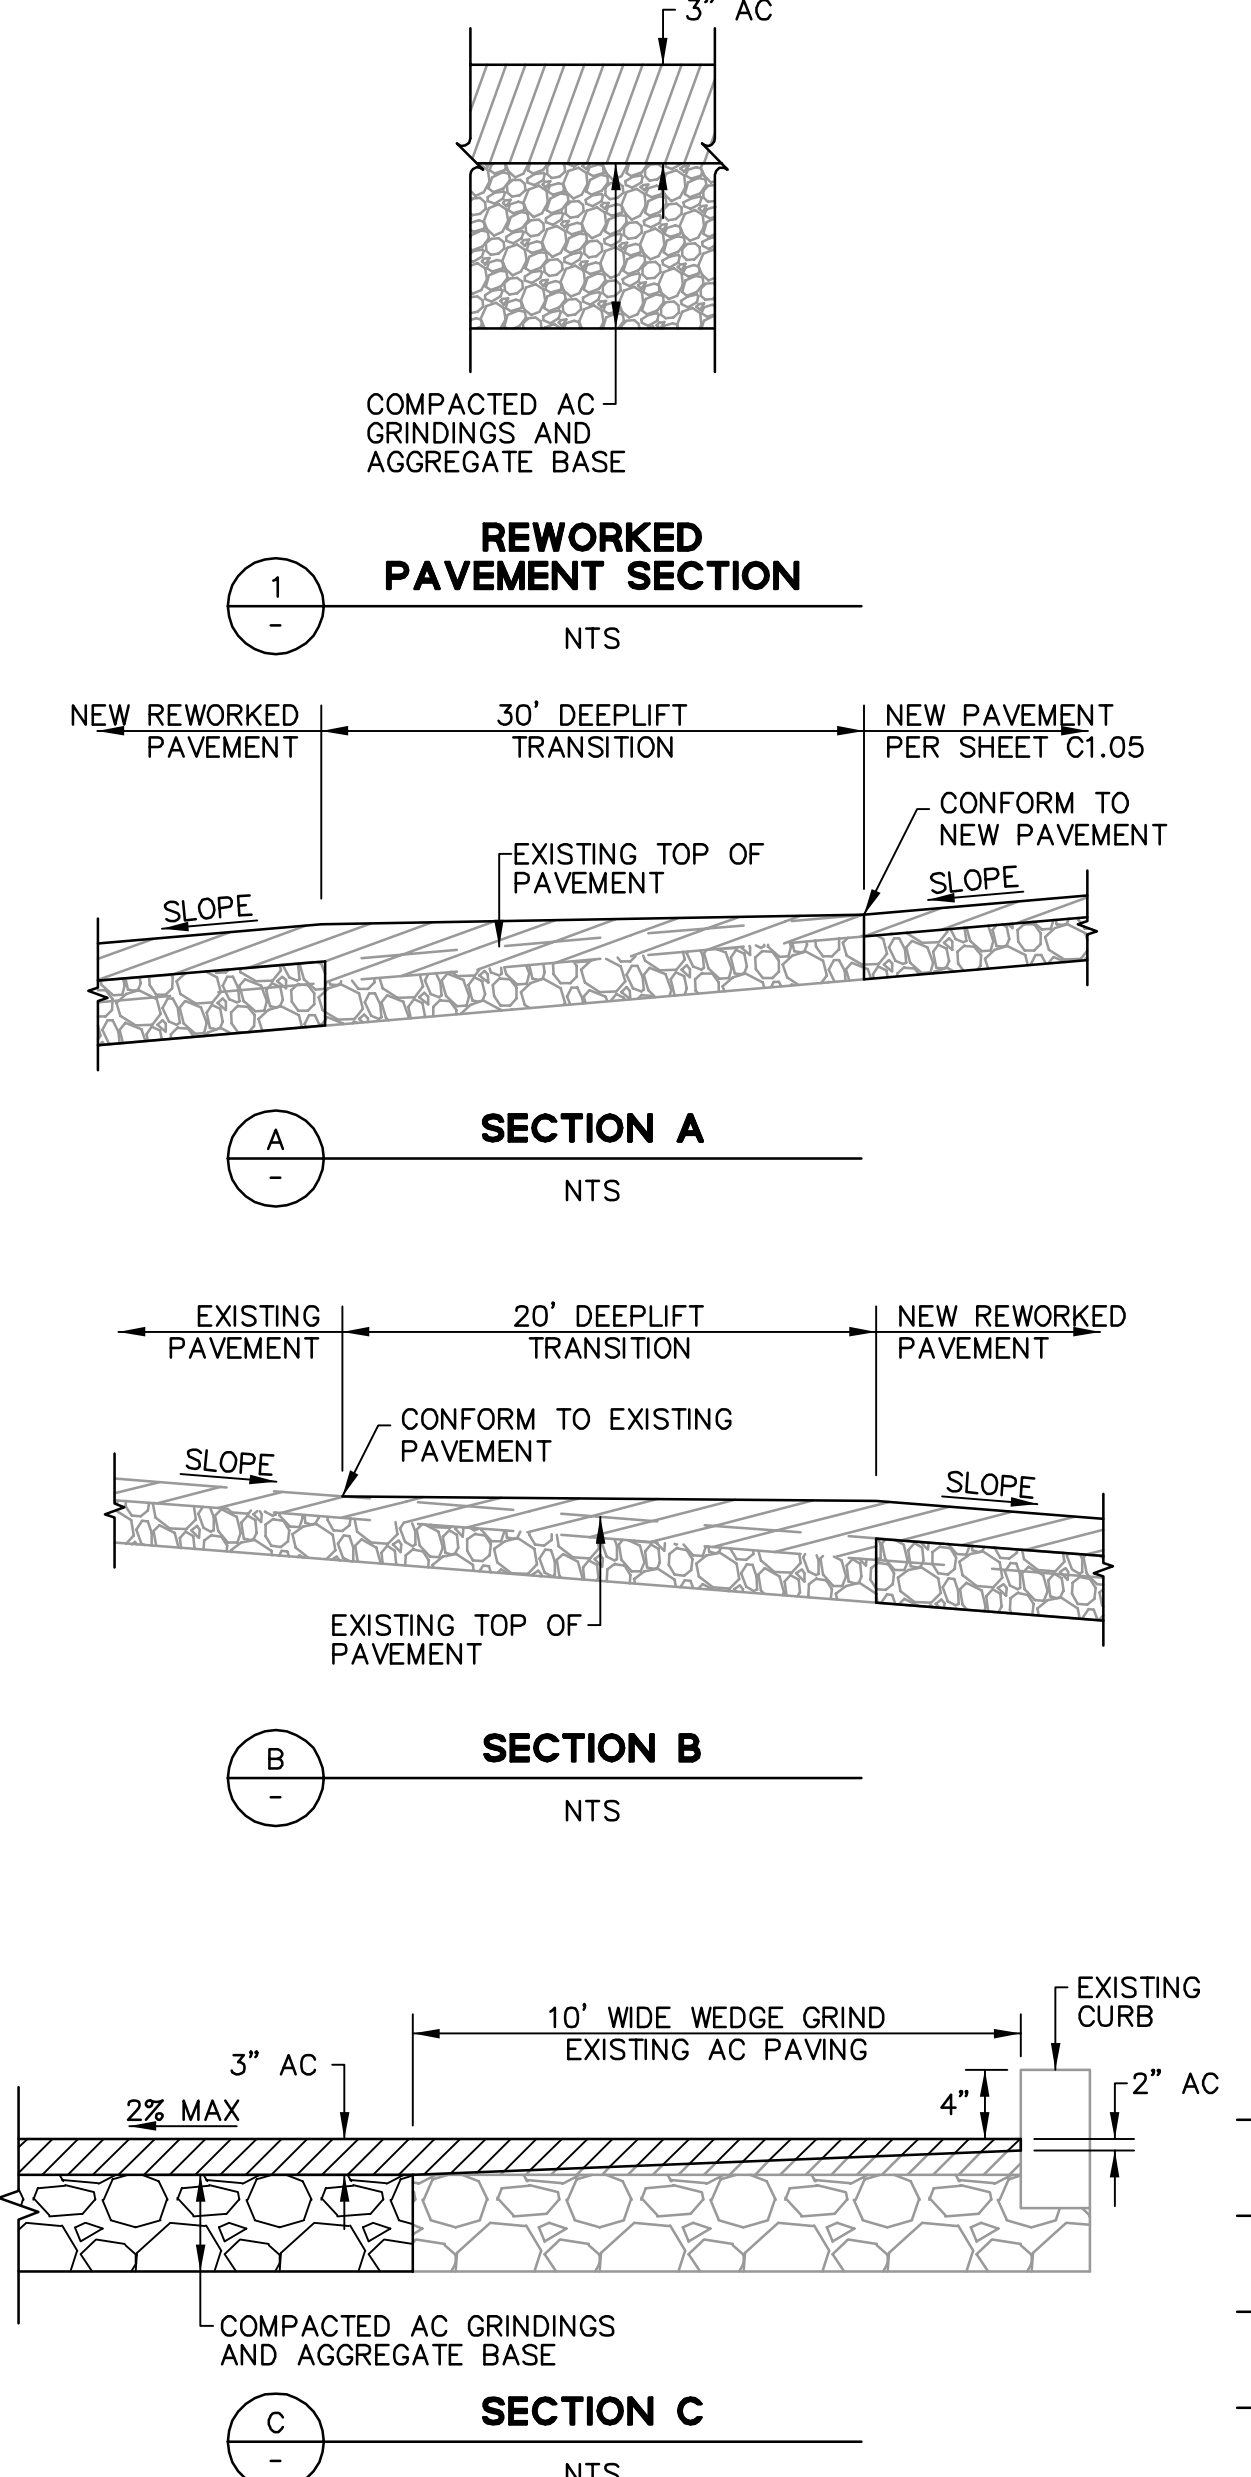

QUANTITIES

TYPE	SF
GRIND EX AC INTO EX AB, COMPACT GRINDINGS IN PLACE, AND PLACE 3" AC TO BRING PAVEMENT UP TO GRADE	39,800±
PAVEMENT DEEP LIFT	9,200±
EDGE GRIND WITH AC OVERLAY	5,300±

RECORD DRAWINGS

THESE RECORD DOCUMENTS HAVE BEEN PREPARED BASED ON INFORMATION PROVIDED BY OTHERS. BKF ENGINEERS HAS NOT VERIFIED THE ACCURACY AND/OR COMPLETENESS OF THIS INFORMATION AND SHALL NOT BE RESPONSIBLE FOR ANY ERRORS OR OMISSIONS THAT MAY BE INCORPORATED HEREIN AS A RESULT. BKF ENGINEERS DOES NOT ASSUME ANY RESPONSIBILITY FOR THE FIELD MODIFICATIONS TO THE PLANS.

BY: BKF ENGINEERS DATE: JUNE 2011



McCarthy Building Companies, Inc.
343 Sansome Street, 14th Floor
San Francisco, California 94104
P 415 | 364-1339
F 415 | 397-5999



255 SHORELINE DRIVE, SUITE 200
REDWOOD CITY, CA 94065
PHONE: (650) 482-6300
FAX: (650) 482-6399



IDENTIFICATION STAMP
DIV. OF THE STATE ARCHITECT
OFFICE OF REGULATION SERVICE

APPL # 01-110097

DATE: _____

FILE NUMBER: _____

This set of other project documents and all their contents and design incorporated therein are the property of LPA, Inc. LPA, Inc. and its consultants shall not be held responsible for any project or design errors or omissions that may occur. The agreement between McCarthy and the State of California is hereby incorporated by reference into this document. LPA hereby represents and warrants that the information contained herein is true and correct to the best of its knowledge and belief. LPA and its consultants shall not be held responsible for any errors or omissions that may occur in the reproduction or modification (rework) of this set of other project documents. LPA and its consultants shall not be held responsible for any errors or omissions that may occur in the reproduction or modification (rework) of this set of other project documents. LPA and its consultants shall not be held responsible for any errors or omissions that may occur in the reproduction or modification (rework) of this set of other project documents.

© Copyright 2008

College of San Mateo
Site Package
San Mateo, CA

Developed for
San Mateo County Community College District

Revision	Description	Date
1	DSN SUBMITTAL	19 SEPT 2008
2	DSN FINAL	09 APRIL 2009
3	BULLETIN #	23 DEC 2009
4	PROJECT RECORD DRAWING	JUNE 2011

Revision	Description	Date
1	DSN SUBMITTAL	19 SEPT 2008
2	DSN FINAL	09 APRIL 2009
3	BULLETIN #	23 DEC 2009
4	PROJECT RECORD DRAWING	JUNE 2011

Job No.	27082.30
Date	02 APRIL 2009
Drawn by	MD, JT
Checked by	RH
Scale	1"=20'

IMPROVEMENTS AT PARKING LOT 11

C1.08