



IDENTIFICATION STAMP
DIV. OF THE STATE ARCHITECT
OFFICE OF REGULATION SERVICE
APPL # 01-110097
AC: FLS SS
DATE: _____
FILE NUMBER: _____

This set of other project documents and all other drawings and design incorporated herein are instruments of service, all project documents are the property of BKF, Inc. (BKF) and shall be held in confidence and shall not be used for any other project without the written consent of BKF, Inc. BKF hereby grants permission to the recipient to use the project documents for reproduction or modification (revised) in any other project documents only if the recipient agrees to indemnify BKF, Inc. from and hold BKF, Inc. harmless from any and all claims, damages, costs or expenses, including reasonable attorneys' fees, that may be incurred by BKF, Inc. as a result of such use. BKF, Inc. and its consultants make no representation concerning the accuracy of documents not prepared by BKF, Inc. or its consultants.

© Copyright 2008

College of San Mateo
Site Package
San Mateo, CA
Developed for
San Mateo County Community College District



Revision	Description	Date
19	DSN SUBMITTAL	19 SEPT 2008
20	DSN FINAL	09 APRIL 2009
21	RFI # 001	04 APRIL 2009
22	PROJECT RECORD DRAWING	JUNE 2011

Revision	Description	Date
23	DSN SUBMITTAL	19 SEPT 2008
24	DSN FINAL	09 APRIL 2009
25	RFI # 001	04 APRIL 2009
26	PROJECT RECORD DRAWING	JUNE 2011

Job No.	Date
27082.30	02 APRIL 2009
Drawn by	MD, JT
Checked by	RH
Scale	1"=20'

HORIZONTAL CONTROL PLAN

C4.04

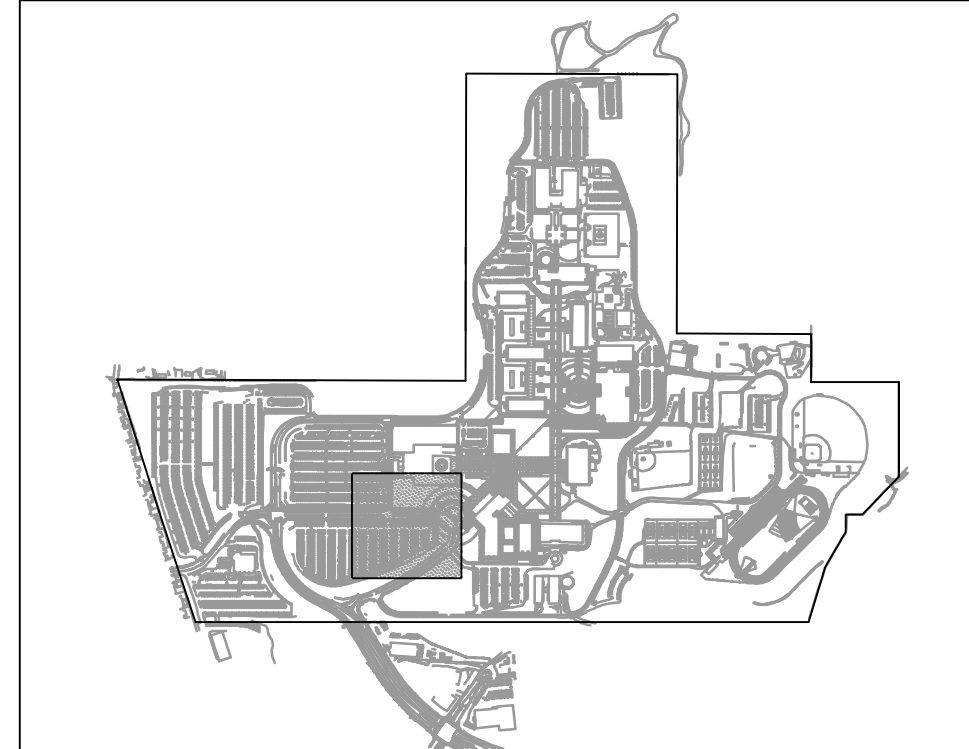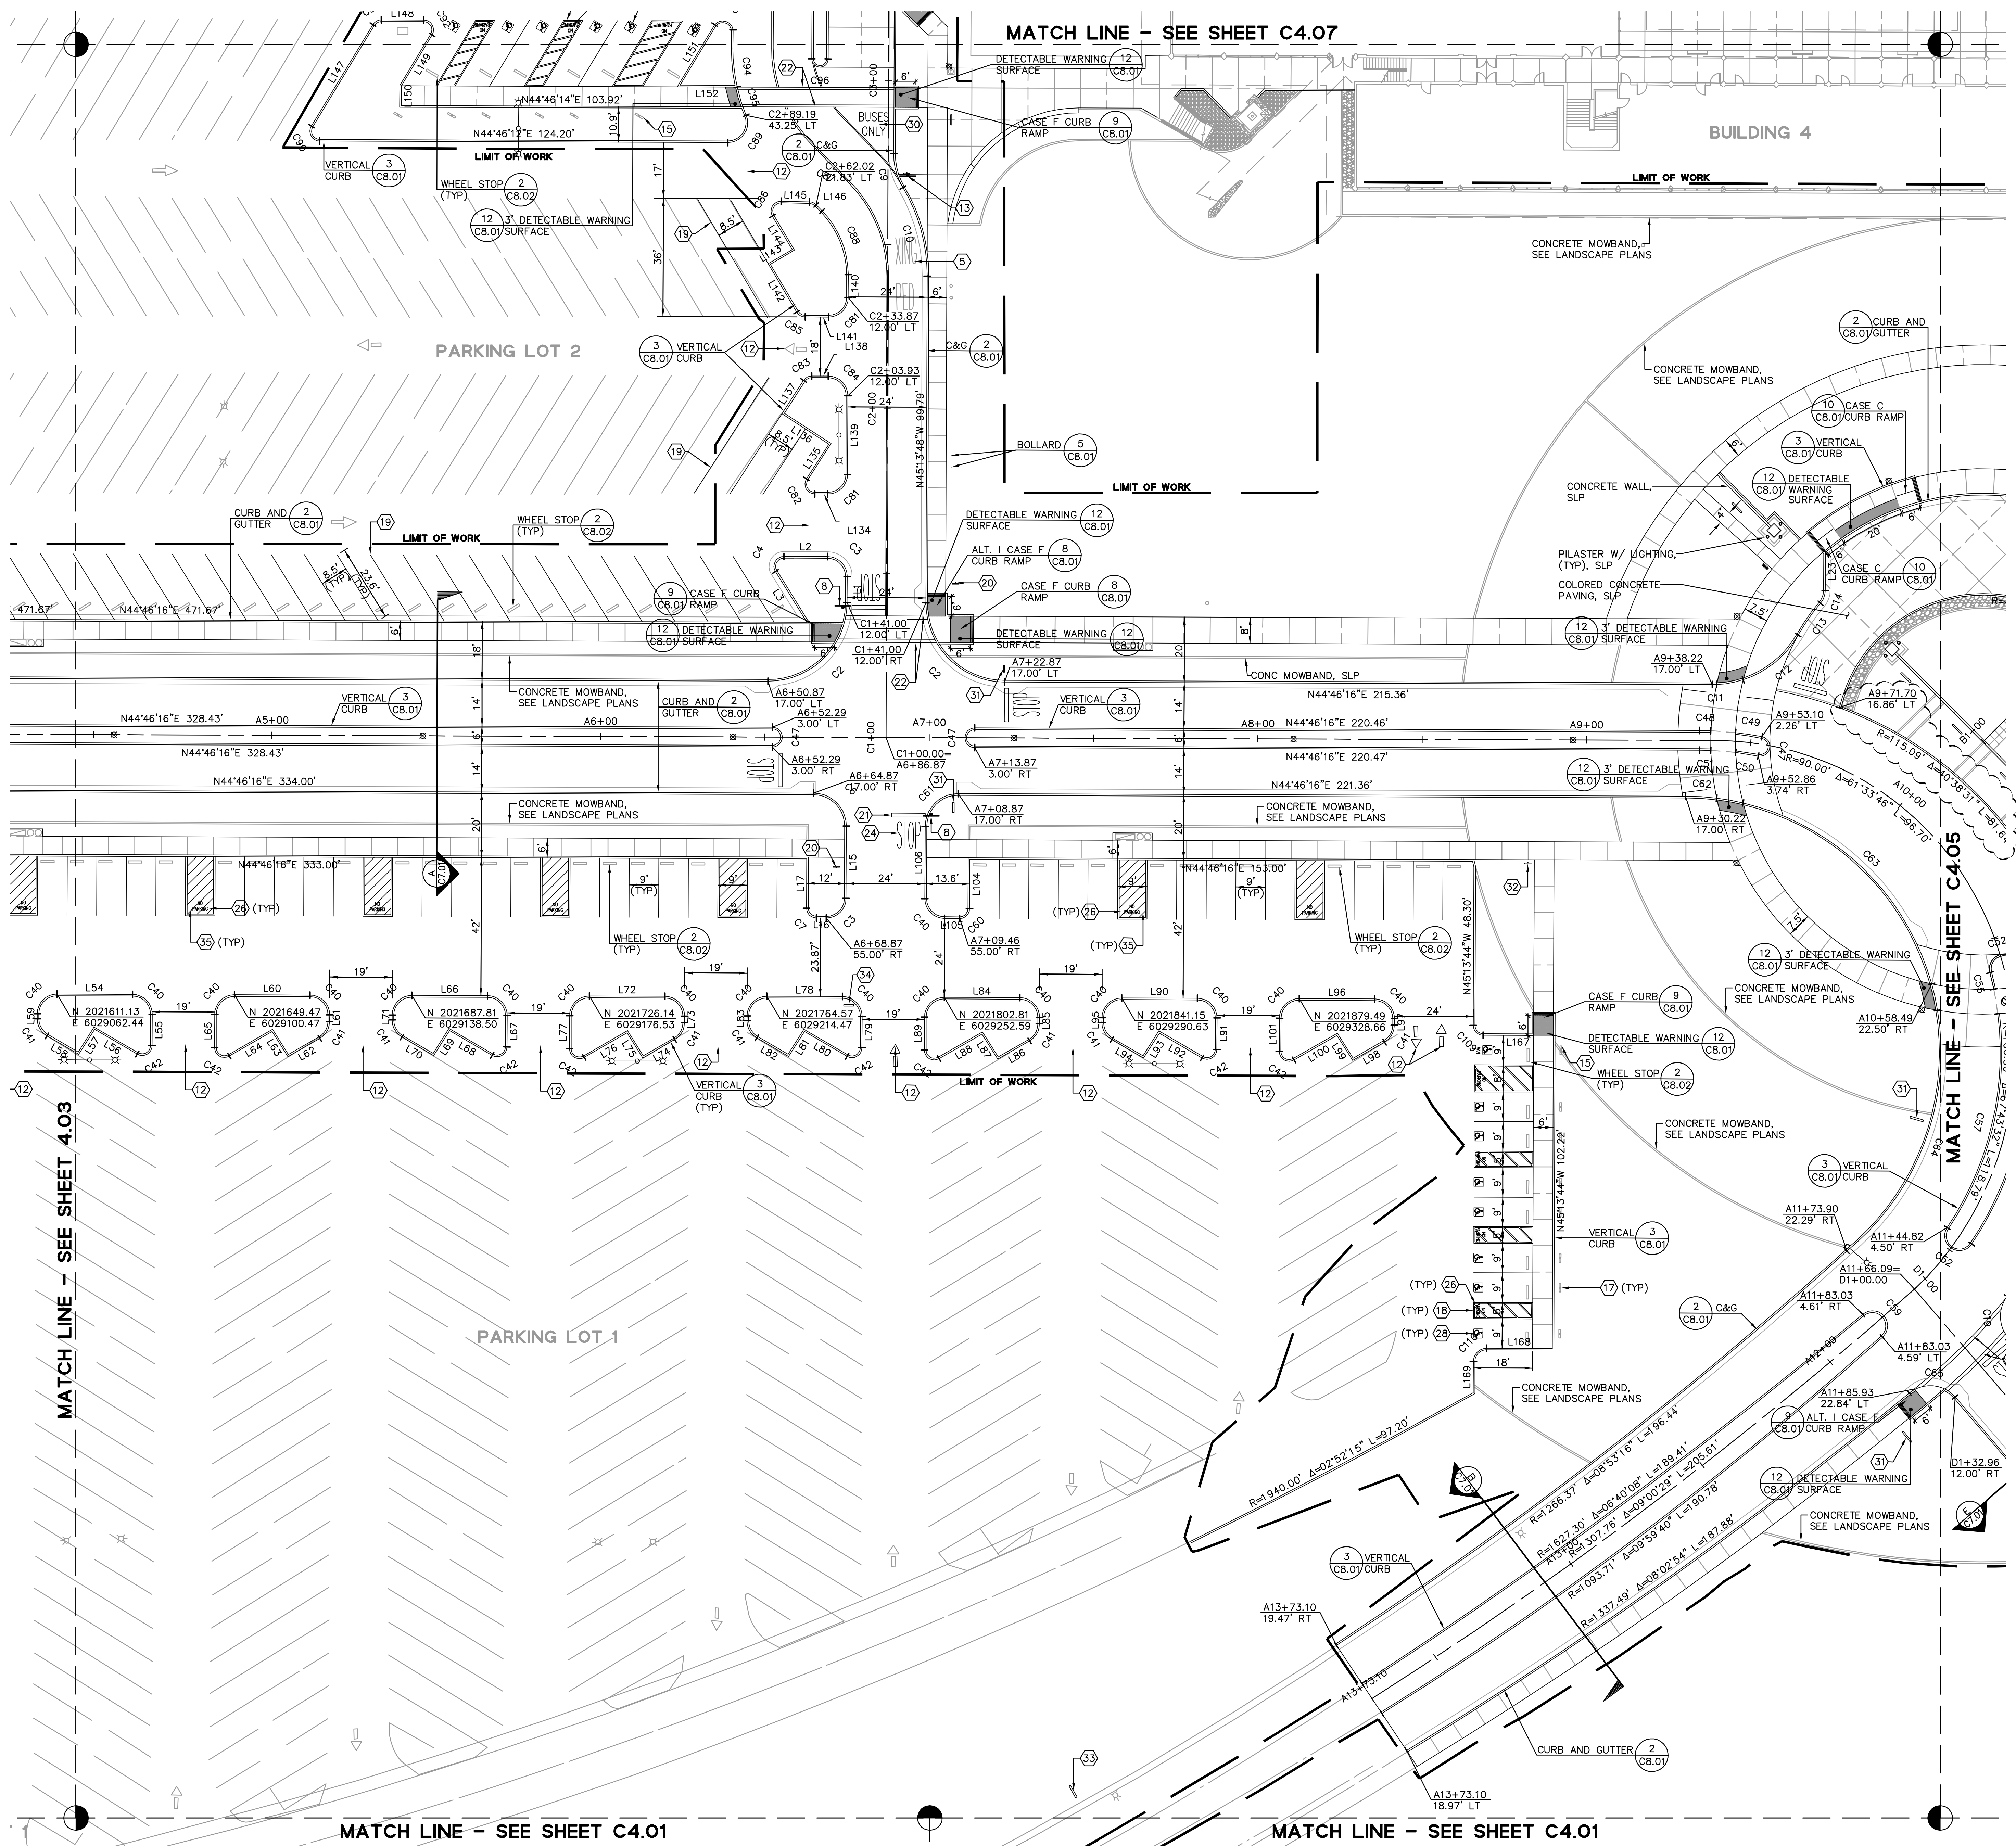

NOTES
1. SEE SHEET C4.01 FOR LINE & CURVE TABLE, AND HORIZONTAL CONTROL NOTES.

MARKING, SIGNING, & STRIPING LEGEND

SYMBOL	DESCRIPTION
(1)	LANE LINE STRIPING, CALTRANS DETAIL 13 PER STANDARD PLAN A20A
(2)	CHEVRON MARKING PER SEC. 3B.10(CA) OF CALIFORNIA MUTCD
(3)	TYPE IV (L) ARROW PER CALTRANS STANDARD PLAN A24A
(4)	TYPE IV (R) ARROW PER CALTRANS STANDARD PLAN A24A
(5)	"PED XING" LETTERING (6" TALL LETTERS)
(6)	R59 (RT) SIGN WITH "RIGHT TURN ONLY"
(7)	"ONE-WAY" SIGN (R6-1)
(8)	STOP SIGN (R1-1)
(9)	R26(S)(CA) - "NO STOPPING ANYTIME" - SEE NOTES 4 & 6
(10)	BLUE REFLECTIVE MARKER
(11)	DETAIL 38, CHANNELIZING LINE PER STANDARD PLAN A20D
(12)	THRU ARROW PER CALTRANS STANDARD PLAN A24A
(13)	"BUSES ONLY" SIGN
(14)	TYPE VI (R) ARROW PER CALTRANS STANDARD PLAN A24A (THRU/RIGHT TURN COMBINATION)
(15)	"VAN ACCESSIBLE" SIGNAGE, SEE DETAIL 1 ON SHEET C8.02
(16)	CA TYPE K-1 (OM2-1H) OBJECT MARKER WITH R4-7 "KEEP RIGHT" SIGN.
(17)	ACCESSIBLE STALL SIGN, SEE DETAIL 1 ON SHEET C8.02
(18)	4 INCH DIAGONAL STRIPING AT 36" O.C., SEE DETAIL 1 ON SHEET C8.02
(19)	4 INCH WHITE STRIPING FOR PARKING STALLS
(20)	TOW AWAY SIGNAGE, SEE DETAIL 1 ON SHEET C8.02
(21)	STOP BAR (12" WHITE STRIPING)
(22)	CROSSWALK (12" WHITE PAINT; 6' WIDE MINIMUM)
(23)	"NO PARKING" SIGN
(24)	"STOP" LETTERING (6" TALL LETTERS)
(25)	"YIELD" LETTERING (6" TALL LETTERS)
(26)	"NO PARKING" LETTERING (12" TALL LETTERS)
(27)	"LOADING ZONE" LETTERING (12" TALL LETTERS)
(28)	INTERNATIONAL SYMBOL OF ACCESSIBILITY - SEE DETAIL 1 ON SHEET C8.02
(29)	PERMIT PARKING SIGN - COORDINATE WITH SMOCCD
(30)	"BUSES ONLY" LETTERING (2.5' TALL LETTERS)
(31)	DIRECTIONAL SIGNAGE - SEE LANDSCAPE PLANS
(32)	CAMPUS MAP DIRECTORY - SEE LANDSCAPE PLANS
(33)	"STOP AHEAD" SIGN
(34)	"ONE WAY - DO NOT ENTER" SIGN

RECORD DRAWINGS
THESE RECORD DOCUMENTS HAVE BEEN PREPARED BASED ON INFORMATION PROVIDED BY OTHERS. BKF ENGINEERS HAS NOT VERIFIED THE ACCURACY AND/OR COMPLETENESS OF THIS INFORMATION AND SHALL NOT BE RESPONSIBLE FOR ANY ERRORS OR OMISSIONS THAT MAY BE INCORPORATED HEREIN AS A RESULT. BKF ENGINEERS DOES NOT ASSUME ANY RESPONSIBILITY FOR THE FIELD MODIFICATIONS TO THE PLANS.

BY: BKF ENGINEERS DATE: JUNE 2011

MATCH LINE - SEE SHEET 4.03

MATCH LINE - SEE SHEET C4.01

MATCH LINE - SEE SHEET C4.01

MATCH LINE - SEE SHEET C4.05

MATCH LINE - SEE SHEET C4.07