


IDENTIFICATION STAMP  
DIV. OF THE STATE ARCHITECT  
OFFICE OF REGULATION SERVICE  
APPL. # 01-110097  
AC: FLS SS  
DATE: \_\_\_\_\_  
FILE NUMBER: \_\_\_\_\_

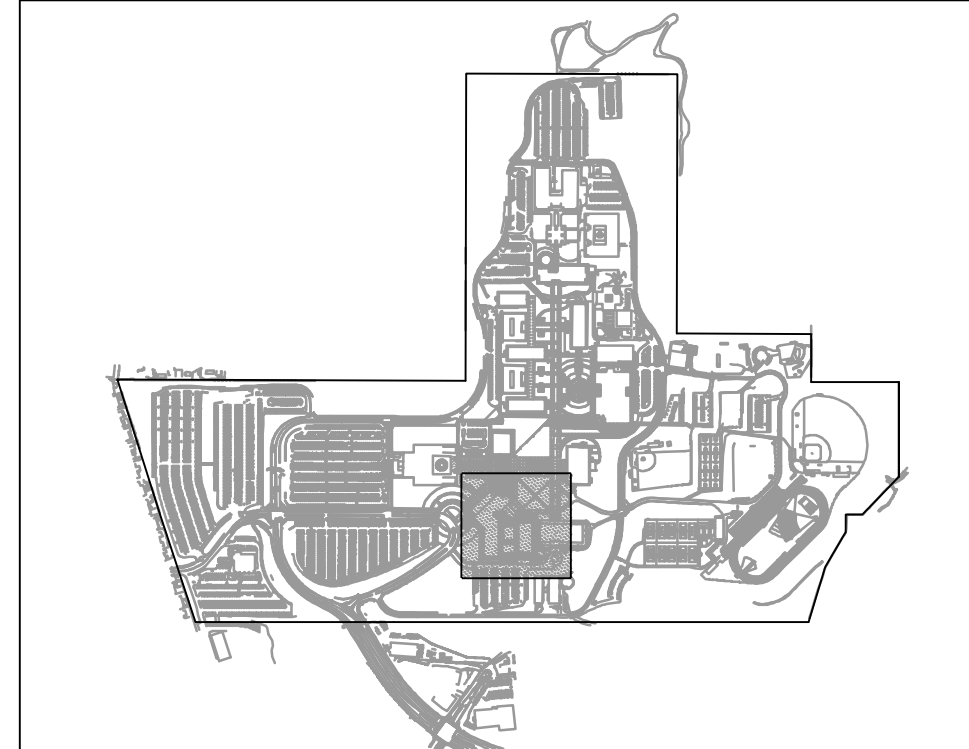

**NOTES**  
1. SEE SHEET C4.01 FOR LINE & CURVE TABLE, AND HORIZONTAL CONTROL NOTES.

**MARKING, SIGNING, & STRIPING LEGEND**

SYMBOL	DESCRIPTION
(1)	LANE LINE STRIPING, CALTRANS DETAIL 13 PER STANDARD PLAN A20A
(2)	CHEVRON MARKING PER SEC. 38.101(CA) OF CALIFORNIA MUTCD
(3)	TYPE IV (L) ARROW PER CALTRANS STANDARD PLAN A24A
(4)	TYPE IV (R) ARROW PER CALTRANS STANDARD PLAN A24A
(5)	"PED XING" LETTERING (6" TALL LETTERS)
(6)	R59 (RT) SIGN WITH "RIGHT TURN ONLY"
(7)	"ONE-WAY" SIGN (R6-1)
(8)	STOP SIGN (R1-1)
(9)	R26(S)(CA) - "NO STOPPING ANYTIME" - SEE NOTES 4 & 6
(10)	BLUE REFLECTIVE MARKER
(11)	DETAIL 38, CHANNELIZING LINE PER STANDARD PLAN A200
(12)	THRU ARROW PER CALTRANS STANDARD PLAN A24A
(13)	"BUSES ONLY" SIGN
(14)	TYPE VI (R) ARROW PER CALTRANS STANDARD PLAN A24A (THRU/RIGHT TURN COMBINATION)
(15)	"VAN ACCESSIBLE" SIGNAGE, SEE DETAIL 1 ON SHEET C8.02
(16)	CA TYPE K-1 (DM2-1H) OBJECT MARKER WITH R4-7 "KEEP RIGHT" SIGN.
(17)	ACCESSIBLE STALL SIGN, SEE DETAIL 1 ON SHEET C8.02
(18)	4 INCH DIAGONAL STRIPING AT 36" O.C., SEE DETAIL 1 ON SHEET C8.02
(19)	4 INCH WHITE STRIPING FOR PARKING STALLS
(20)	TOW AWAY SIGNAGE, SEE DETAIL 1 ON SHEET C8.02
(21)	STOP BAR (12" WHITE STRIPING)
(22)	CROSSWALK (12" WHITE PAINT; 6" WIDE MINIMUM)
(23)	"NO PARKING" SIGN
(24)	"STOP" LETTERING (6" TALL LETTERS)
(25)	"YIELD" LETTERING (6" TALL LETTERS)
(26)	"NO PARKING" LETTERING (12" TALL LETTERS)
(27)	"LOADING ZONE" LETTERING (12" TALL LETTERS)
(28)	INTERNATIONAL SYMBOL OF ACCESSIBILITY - SEE DETAIL 1 ON SHEET C8.02
(29)	PERMIT PARKING SIGN - COORDINATE WITH SMCCCD
(30)	"BUSES ONLY" LETTERING (2.5" TALL LETTERS)
(31)	DIRECTIONAL SIGNAGE - SEE LANDSCAPE PLANS
(32)	CAMPUS MAP DIRECTORY - SEE LANDSCAPE PLANS
(33)	"STOP AHEAD" SIGN
(34)	"ONE WAY - DO NOT ENTER" SIGN
(35)	4 INCH WHITE DIAGONAL STRIPING AT 36" O.C.
(36)	"ACCESSIBLE DROP OFF/LOADING ZONE" LETTERING (2.5" TALL LETTERS)

**RECORD DRAWINGS**  
THESE RECORD DOCUMENTS HAVE BEEN PREPARED BASED ON INFORMATION PROVIDED BY OTHERS. BKF ENGINEERS HAS NOT VERIFIED THE ACCURACY AND/OR COMPLETENESS OF THIS INFORMATION AND SHALL NOT BE RESPONSIBLE FOR ANY ERRORS OR OMISSIONS THAT MAY BE INCORPORATED HEREIN AS A RESULT. BKF ENGINEERS DOES NOT ASSUME ANY RESPONSIBILITY FOR THE FIELD MODIFICATIONS TO THE PLANS.  
BY: BKF ENGINEERS DATE: JUNE 2011

The use of other project documents and all their contents and design incorporated herein on drawings of record, as project documents are the registered property of LPA, Inc. (LPA) and cannot be used, copied, or altered in any way for any project other than that for which they were prepared. No warranty is made by LPA or the State of California for any errors or omissions on drawings prepared by LPA or the State of California. LPA hereby disclaims any liability for any errors or omissions on drawings prepared by LPA or the State of California. LPA and LPA's Consultants make no representation concerning the accuracy of documents not on file and are not responsible for any discrepancies between project documents and the existing conditions.  
© Copyright 2008

College of San Mateo  
Site Package  
San Mateo, CA  
Developed for  
San Mateo County Community College District

Revision	Description	Date
19	SEPT 2008	
18	DSN SUBMITTAL	09 APRIL 2009
17	DSN FINAL	09 APRIL 2009
16	BULLETIN 9 (LOT 11 REVS.)	24 FEB 2009
15	ART # 7	23 APRIL 2009
14	ART # 8	15 MAY 2009
13	ART # 9	18 AUG 2009
12	ART # 10	18 AUG 2009
11	PROJECT RECORD DRAWING	JUNE 2011

Job No. 27082.30  
Date 09 APRIL 2009  
Drawn by MD, JT  
Checked by RH  
Scale 1"=20'