



IDENTIFICATION STAMP
DIV. OF THE STATE ARCHITECT
OFFICE OF REGULATION SERVICE
APPL. #: 01-110097
AC: _____ FLS: _____ SS: _____
DATE: _____
FILE NUMBER: _____

This set of other project documents and all sheets, sections and details incorporated herein are hereby accepted as part of the project documents on the registered property of UPL, INC. UPL, INC. shall be held liable for the accuracy of the project documents and shall be held liable for any errors or omissions that may be incorporated herein as a result of any reproduction or modification (revisions) not authorized by UPL, INC. UPL, INC. shall not be held liable for any errors or omissions that may be incorporated herein as a result of any reproduction or modification (revisions) not authorized by UPL, INC. UPL, INC. shall not be held liable for any errors or omissions that may be incorporated herein as a result of any reproduction or modification (revisions) not authorized by UPL, INC.

© Copyright 2008

College of San Mateo
Site Package
San Mateo, CA

Developed for
San Mateo County Community College District

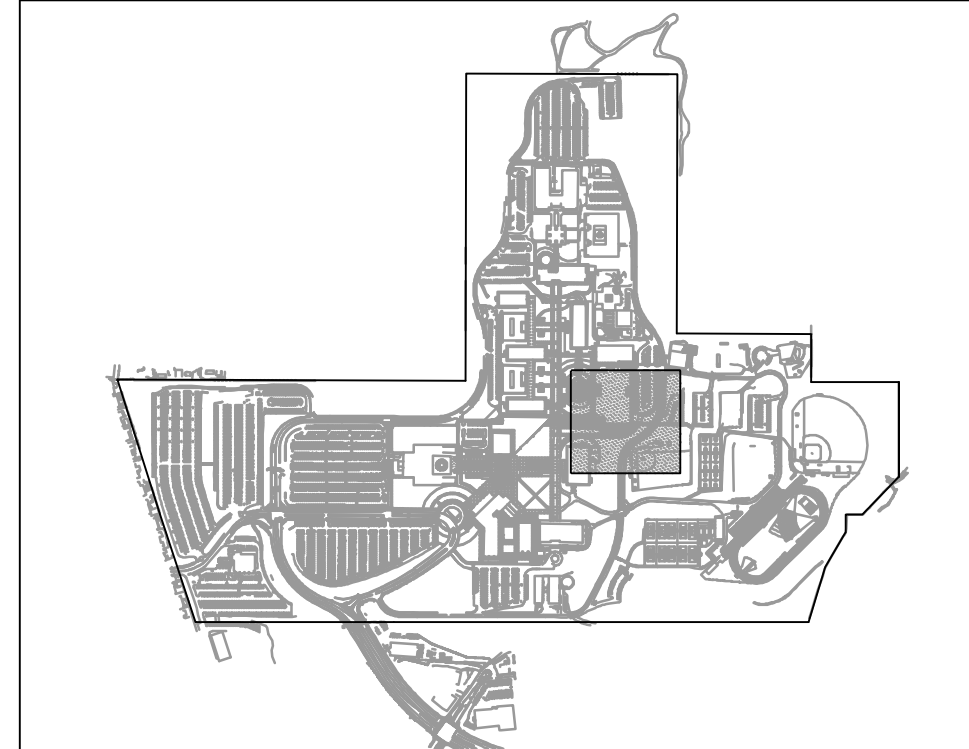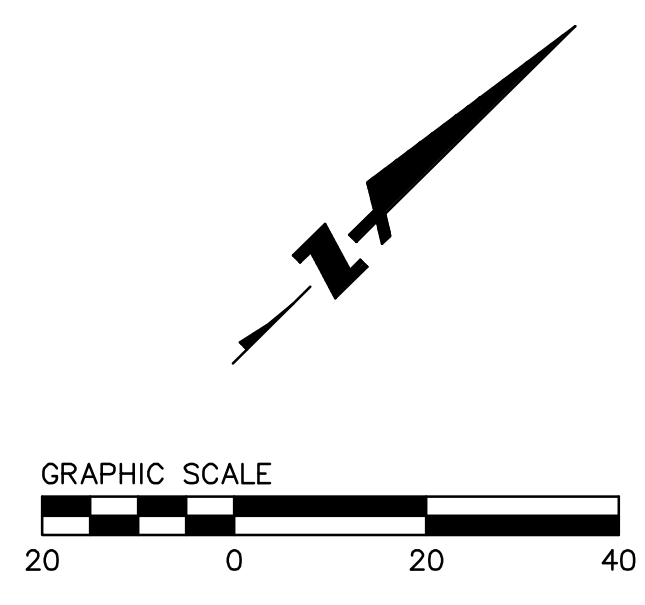

- NOTES**
- SEE SHEET C4.01 FOR LINE & CURVE TABLE, AND HORIZONTAL CONTROL NOTES.

MARKING, SIGNING, & STRIPING LEGEND

SYMBOL	DESCRIPTION
1	LANE LINE STRIPING, CALTRANS DETAIL 13 PER STANDARD PLAN A20A
2	CHEVRON MARKING PER SEC. 38.101(CA) OF CALIFORNIA MUTCD
3	TYPE IV (L) ARROW PER CALTRANS STANDARD PLAN A24A
4	TYPE IV (R) ARROW PER CALTRANS STANDARD PLAN A24A
5	"PED XING" LETTERING (6" TALL LETTERS)
6	R59 (RT) SIGN WITH "RIGHT TURN ONLY"
7	"ONE-WAY" SIGN (R6-1)
8	STOP SIGN (R1-1)
9	R26(S)(CA) - "NO STOPPING ANYTIME" - SEE NOTES 4 & 6
10	BLUE REFLECTIVE MARKER
11	DETAIL 38, CHANNELIZING LINE PER STANDARD PLAN A200
12	THRU ARROW PER CALTRANS STANDARD PLAN A24A
13	"BUSES ONLY" SIGN
14	TYPE VI (R) ARROW PER CALTRANS STANDARD PLAN A24A (THRU/RIGHT TURN COMBINATION)
15	"VAN ACCESSIBLE" SIGNAGE, SEE DETAIL 1 ON SHEET CB.02
16	CA TYPE K-1 (OM2-1H) OBJECT MARKER WITH R4-7 "KEEP RIGHT" SIGN, ACCESSIBLE STALL SIGN, SEE DETAIL 1 ON SHEET CB.02
17	4 INCH DIAGONAL STRIPING AT 36" O.C., SEE DETAIL 1 ON SHEET CB.02
18	4 INCH WHITE STRIPING FOR PARKING STALLS
19	TOW AWAY SIGNAGE, SEE DETAIL 1 ON SHEET CB.02
20	STOP BAR (12" WHITE STRIPING)
21	CROSSWALK (12" WHITE PAINT; 6" WIDE MINIMUM)
22	"NO PARKING" SIGN
23	"STOP" LETTERING (6" TALL LETTERS)
24	"YIELD" LETTERING (6" TALL LETTERS)
25	"NO PARKING" LETTERING (12" TALL LETTERS)
26	"LOADING ZONE" LETTERING (12" TALL LETTERS)
27	INTERNATIONAL SYMBOL OF ACCESSIBILITY - SEE DETAIL 1 ON SHEET CB.02
28	PERMIT PARKING SIGN - COORDINATE WITH SMCCCD
29	"BUSES ONLY" LETTERING (2.5" TALL LETTERS)
30	DIRECTIONAL SIGNAGE - SEE LANDSCAPE PLANS
31	CAMPUS MAP DIRECTORY - SEE LANDSCAPE PLANS
32	"STOP AHEAD" SIGN
33	"ONE WAY - DO NOT ENTER" SIGN
34	4 INCH WHITE DIAGONAL STRIPING AT 36" O.C.
35	"ACCESSIBLE DROP OFF/LOADING ZONE" LETTERING (2.5" TALL LETTERS)

RECORD DRAWINGS
THESE RECORD DOCUMENTS HAVE BEEN PREPARED BASED ON INFORMATION PROVIDED BY OTHERS. BKF ENGINEERS HAS NOT VERIFIED THE ACCURACY AND/OR COMPLETENESS OF THIS INFORMATION AND SHALL NOT BE RESPONSIBLE FOR ANY ERRORS OR OMISSIONS THAT MAY BE INCORPORATED HEREIN AS A RESULT. BKF ENGINEERS DOES NOT ASSUME ANY RESPONSIBILITY FOR THE FIELD MODIFICATIONS TO THE PLANS.
BY: BKF ENGINEERS DATE: JUNE 2011

Revision	Description	Date
19	SUBMITTAL	SEPT 2008
18	FINAL	APRIL 2009
17	EXHIBIT	AUG 2010
16	EXHIBIT	AUG 2010
Job No.	27082.30
Date	02 APRIL 2009
Drawn by	MD, JT
Checked by	RH
Scale	1"=20'