
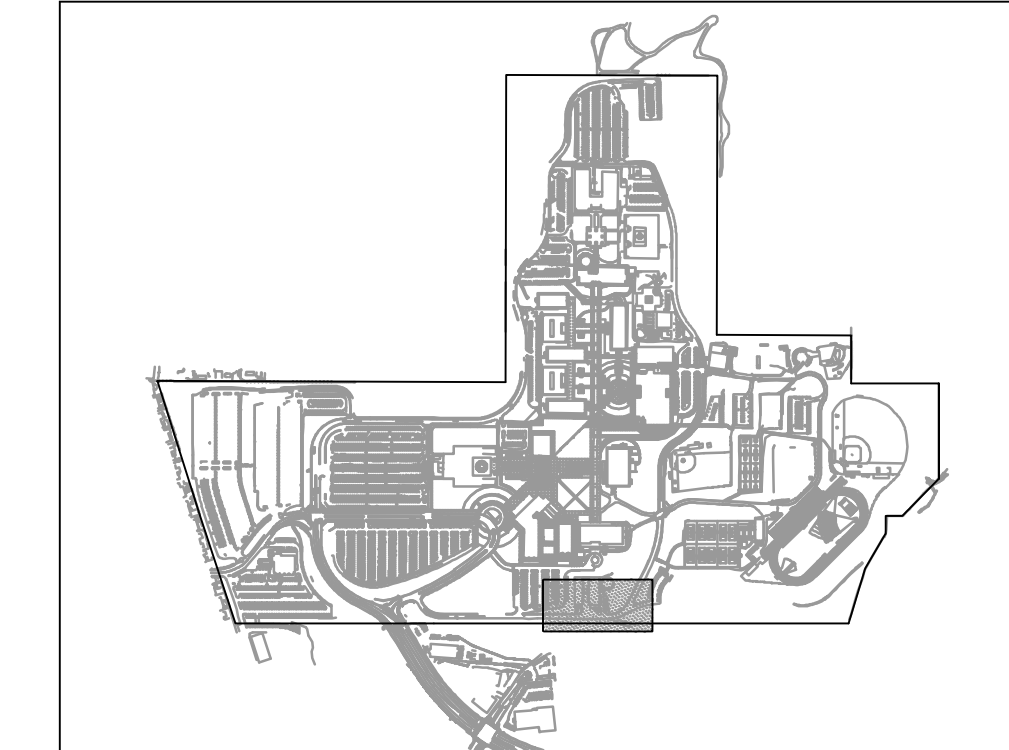


MATCH LINE - SEE SHEET C5.05

MATCH LINE - SEE SHEET C5.06

MATCH LINE - SEE SHEET C5.01

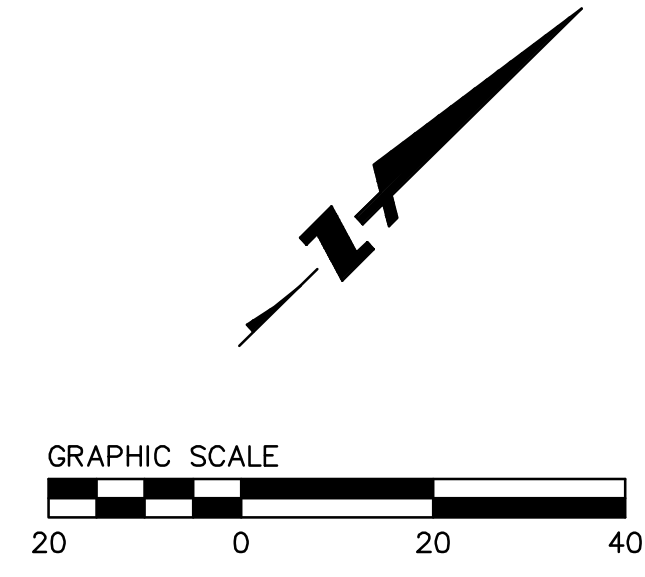

KEYMAP

RECORD DRAWINGS
 THESE RECORD DOCUMENTS HAVE BEEN PREPARED BASED ON INFORMATION PROVIDED BY OTHERS. BKF ENGINEERS HAS NOT VERIFIED THE ACCURACY AND/OR COMPLETENESS OF THIS INFORMATION AND SHALL NOT BE RESPONSIBLE FOR ANY ERRORS OR OMISSIONS THAT MAY BE INCORPORATED HEREIN AS A RESULT. BKF ENGINEERS DOES NOT ASSUME ANY RESPONSIBILITY FOR THE FIELD MODIFICATIONS TO THE PLANS.

BY: BKF ENGINEERS DATE: JUNE 2011



McCarthy Building Companies, Inc.
 343 Sansome Street, 14th Floor
 San Francisco, California 94104
 P 415 | 364-1339
 F 415 | 397-5999



IDENTIFICATION STAMP
 DIV. OF THE STATE ARCHITECT
 OFFICE OF REGULATION SERVICE
 APPL. #: 01-110097
 AC: _____ FLS: _____ SS: _____
 DATE: _____
 FILE NUMBER: _____

This set of other project documents and all items, including and design incorporated therein are instruments of service. All project documents are the registered property of LPA, INC. LPA, INC. will control the handling, use, distribution, and reproduction of these documents. No part of these documents may be reproduced, stored in a retrieval system, or transmitted in any form or by any means, electronic, mechanical, photocopying, recording, or by any information storage and retrieval system, without the prior written consent of LPA, INC. LPA, INC. shall not be held responsible for any reproduction or modification (revisions) of these documents. LPA, INC. and LPA, INC. Consultants shall not be held responsible for any reproduction or modification (revisions) of these documents. These documents are the property of LPA, INC. and LPA, INC. Consultants. LPA, INC. and LPA, INC. Consultants make no representation concerning the accuracy of documents and are not responsible for any discrepancies between project documents and the existing conditions.

© Copyright 2008

College of San Mateo
 Site Package
 San Mateo, CA
 Developed for
 San Mateo County Community College District

Revision	Description	Date

Revision	Description	Date
01	DSN SUBMITTAL	19 SEPT 2008
02	DSN FINAL	09 APRIL 2009
03	PROJECT RECORD DRAWING	JUNE 2011

Job No.	27082.30
Date	02 APRIL 2009
Drawn by	MD, JT
Checked by	RH
Scale	1"=20'

GRADING & DRAINAGE PLAN
C5.02