
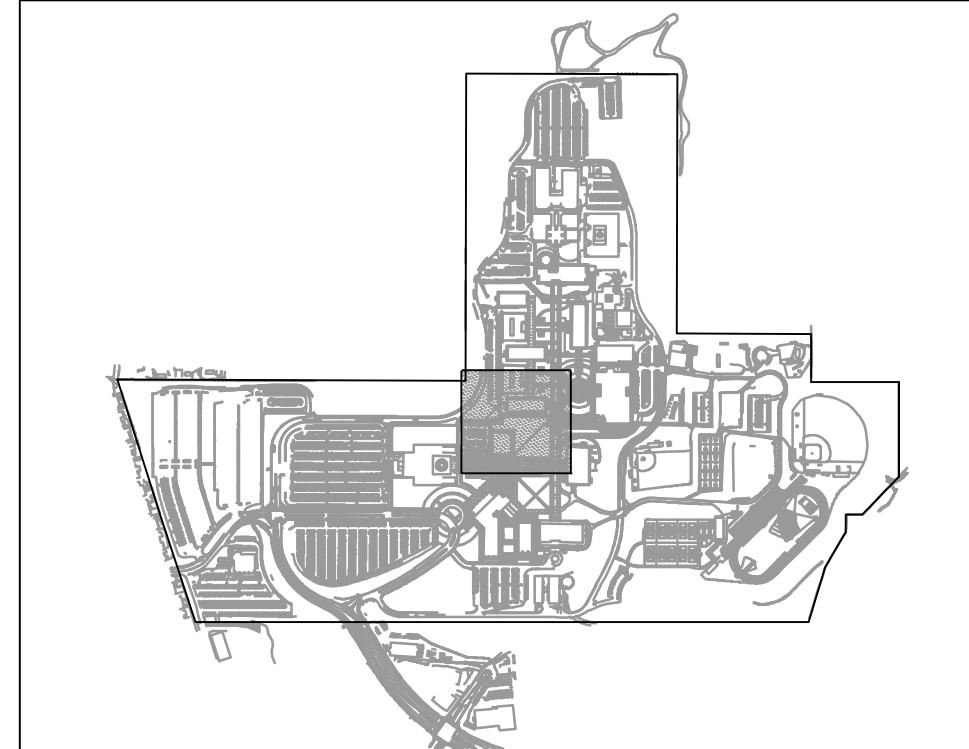


MATCH LINE - SEE SHEET C5.07

MATCH LINE - SEE SHEET C5.11

MATCH LINE - SEE SHEET C5.09

MATCH LINE - SEE SHEET C5.05

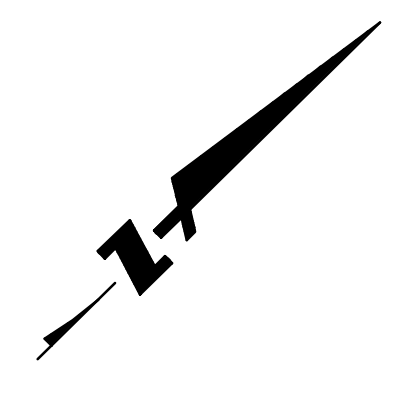

KEYMAP

RECORD DRAWINGS
 THESE RECORD DOCUMENTS HAVE BEEN PREPARED BASED ON INFORMATION PROVIDED BY OTHERS. BKF ENGINEERS HAS NOT VERIFIED THE ACCURACY AND/OR COMPLETENESS OF THIS INFORMATION AND SHALL NOT BE RESPONSIBLE FOR ANY ERRORS OR OMISSIONS THAT MAY BE INCORPORATED HEREIN AS A RESULT. BKF ENGINEERS DOES NOT ASSUME ANY RESPONSIBILITY FOR THE FIELD MODIFICATIONS TO THE PLANS.

BY: BKF ENGINEERS DATE: JUNE 2011



McCarthy Building Companies, Inc.
 343 Sansome Street, 14th Floor
 San Francisco, California 94104
 P 415 364-1339
 F 415 397-5999



255 SHORELINE DRIVE, SUITE 200
 REDWOOD CITY, CA 94065
 PHONE: (650) 482-6300
 FAX: (650) 482-6399



IDENTIFICATION STAMP
 DIV. OF THE STATE ARCHITECT
 OFFICE OF REGULATION SERVICE
 APPL. # 01-110097
 AC: _____ FLS: _____ SS: _____
 DATE: _____
 FILE NUMBER: _____

This set of other project documents and all sheets, sections and details incorporated herein are herewith accepted as project documents on the registered property of LPA, Inc. LPA, Inc. and cannot be further used in whole or in part for any project other than that for which they were prepared without the written approval of McCarthy and the State Architect. LPA hereby certifies that the project documents are true and correct copies of the reproduction or modification (revised) is not only intended but intended to be used as project documents. LPA and LPA's Consultants make no representation concerning the accuracy of documents not on file with the State Architect. LPA and LPA's Consultants make no representation concerning the accuracy of documents not on file with the State Architect.

© Copyright 2008

College of San Mateo
 Site Package
 San Mateo, CA

Developed for
 San Mateo County Community College District

Revision	Description	Date
1	DSN SUBMITTAL	19 SEPT 2008
2	DSA FINAL	09 APRIL 2009
3	RFI # 18	16 JUNE 2009
4	RFI # 24	13 JUNE 2010
5	PROJECT RECORD DRAWING	13 JUNE 2011

Revision	Description	Date
1	DSN SUBMITTAL	19 SEPT 2008
2	DSA FINAL	09 APRIL 2009
3	RFI # 18	16 JUNE 2009
4	RFI # 24	13 JUNE 2010
5	PROJECT RECORD DRAWING	13 JUNE 2011

Job No.	27082.30
Date	02 APRIL 2009
Drawn by	MD, JT
Checked by	RH
Scale	1"=20'

GRADING & DRAINAGE PLAN

C5.08