


MATCH LINE - SEE SHEET C6.03

MATCH LINE - SEE SHEET C6.04

PARKING LOT 1

WEST HILLSDALE BLVD

MATCH LINE - SEE SHEET C6.01 - BOTTOM LEFT

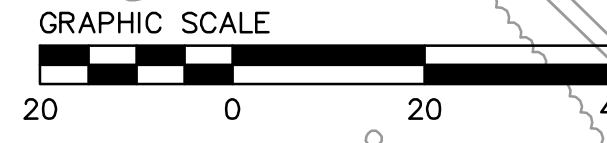


MATCH LINE - SEE SHEET C6.04

MATCH LINE - SEE SHEET C6.05

PARKING LOT 3

MATCH LINE - SEE SHEET C6.02

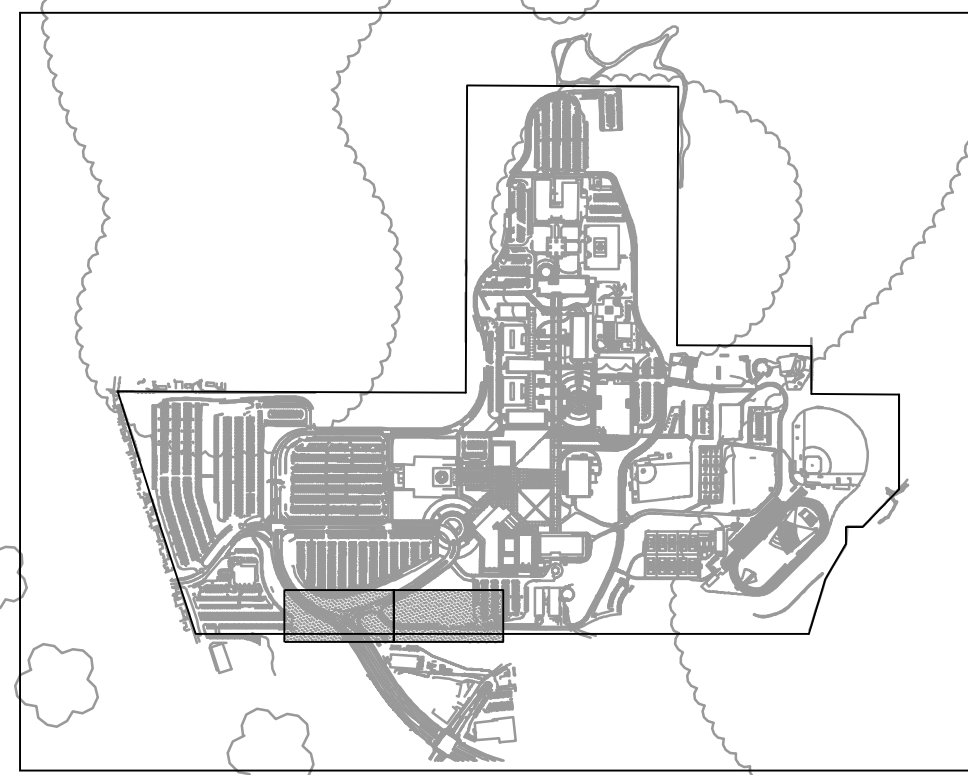

UTILITY NOTES

1. REFER TO SHEETS C8.03 THROUGH C8.05 FOR UTILITY DETAILS.

RECORD DRAWINGS

THESE RECORD DOCUMENTS HAVE BEEN PREPARED BASED ON INFORMATION PROVIDED BY OTHERS. BKF ENGINEERS HAS NOT VERIFIED THE ACCURACY AND/OR COMPLETENESS OF THIS INFORMATION AND SHALL NOT BE RESPONSIBLE FOR ANY ERRORS OR OMISSIONS THAT MAY BE INCORPORATED HEREIN AS A RESULT. BKF ENGINEERS DOES NOT ASSUME ANY RESPONSIBILITY FOR THE FIELD MODIFICATIONS TO THE PLANS.

BY: BKF ENGINEERS DATE: JUNE 2011

CROSSING/CONNECTION INVERT TABLE		
NO.	UTILITY SIZE	INV. ELEV.
1	(E) 15" SD	532.09
1	18" SD	535.38
2	(E) 8" SS	579.27
2	12" SD	575.77
3	8" SD	576.23
3	8" W	574.06
4	8" SD	577.15
4	8" SS	575.18
5	8" SD	575.22
5	8" W	573.05
6	8" SD	576.88
6	8" W	574.71
7	8" SD	578.24
7	8" SS	574.90
8	8" W	572.52
8	12" SD	574.69
9	8" SD	574.27
9	12" SD	573.69
10	8" SS	573.70
10	8" W	576.01
11	(E) 8" W	577.94
11	8" SD	578.09
12	8" SD	578.09
13	8" SD	578.19
13	8" W	575.95
14	8" W	578.29
14	8" SD	575.05
15	8" SD	578.53
15	8" W	577.74
16	8" SD	578.64
16	8" SS	576.49
17	8" SD	578.77
17	8" W	576.60
18	8" SD	578.16
18	8" W	579.16
19	8" SD	579.45
19	8" SS	577.42
20	8" SD	578.25
20	8" W	580.20
21	8" SD	577.27
21	8" SS	577.06
22	(E) 8" SS	578.25
22	8" SD	581.29
23	4" SD	579.78
23	4" SS	579.78
24	4" SS	579.18
24	12" SD	585.07
25	(E) 8" W	583.42
25	8" SD	579.48
26	(E) 8" W	583.50
26	12" SD	585.67
27	12" SD	587.04
27	12" SD	587.04
28	4" SD	593.73
28	12" SD	587.11
29	4" SD, NE	592.83
29	4" SD, SW	593.15
29	12" SD, THRU	615.20
30	8" SD	591.94
30	8" SD	589.71
31	(E) 3" HWS/HWR	599.50
31	8" SD	593.81
32	(E) 2" HWS/HWR	593.00
32	8" SD	587.42
32	8" SD	590.72
32	8" SD	590.72
33	4" SD	591.39
33	8" SD	591.22
34	(E) 8" SS	582.98
34	8" SD	590.34
34	8" SD	590.17
35	8" SD	590.28
35	8" SD	590.11
36	(E) 8" W	593.79
36	8" SD	590.60
37	8" SD	590.06
37	8" SD	589.89
37	8" SD	589.89
38	8" SD	589.73
38	8" SS	589.73
39	(E) 8" SS	582.66
39	8" SD	592.32
40	(E) 8" SS	582.65
40	8" SD	591.32
41	(E) 8" SS	581.68
41	8" SD	589.33
42	8" SD	589.25
42	8" SD	589.25
43	(E) 8" W	591.72
43	8" SD	589.20
44	8" SD	588.98
44	8" SD	588.98
45	(E) 3" HWS/HWR	595.69
45	8" SD	593.76
45	8" SD	588.78
46	(E) 3" HWS/HWR	595.69
46	12" SD	587.83
47	8" SD	588.60
47	12" SD	588.10
48	8" SD	588.85
48	8" SD	592.03
49	4" SD, NE	593.85
49	4" SD, SW	593.85
49	8" SD	589.05
50	8" SD	593.60
50	8" SD	592.31
51	8" SD	593.63
51	8" SD	593.63
52	8" SD	594.21
52	8" SS	592.71
53	(E) 3" HWS/HWR	596.23
53	2 - 6" CWS/CWR	593.26
54	8" SD	596.22
54	12" SD	594.11
55	2 - 6" CWS/CWR	594.33
55	8" SD	596.33
56	8" SD	597.80
56	8" SD	593.22
57	2 - 6" CWS/CWR	595.72
57	8" SD	597.22
58	8" SD	597.02
58	12" SD	595.20
59	8" SD	598.60
59	12" SD	595.57
60	(E) 4" HWS/HWR	600.69
60	8" SD	597.15
61	(E) GAS	600.50
61	8" SD	597.19
62	(E) GAS	602.72
62	(E) HWS/HWR	602.85
62	2 - 6" CWS/CWR	599.39
63	2 - 6" CWS/CWR	597.95
63	8" SD	599.45
64	(E) 1.5" HWS/HWR	603.75
64	8" SD	600.62
65	(E) 8" W	608.47
65	8" SD	605.68
66	(E) 2" HWS/HWR	612.51
66	8" SD	610.35
67	(E) 8" SD	615.62
67	8" SD	615.79
68	(E) 8" SD	615.19
68	8" SD	615.36
69	2 - 4" CWS/CWR	600.67
69	8" SD	598.36
70	2 - 6" CWS/CWR	600.76
70	8" SD	598.72

NOTE: PROVIDE A MINIMUM OF 12" OF VERTICAL CLEARANCE BETWEEN UTILITIES CROSSING PRESSURIZED UTILITY LINES.



McCarthy Building Companies, Inc. 343 Sansome Street, 14th Floor San Francisco, California 94104 P 415 | 364-1339 F 415 | 397-5999



IDENTIFICATION STAMP DIV. OF THE STATE ARCHITECT OFFICE OF REGULATION SERVICE APPL. # 01-110097

This set of other project documents and all their contents and design incorporated herein are hereby accepted as project documents on the registered property of LPA, Inc. LPA, Inc. and its consultants shall be held responsible for any errors or omissions in this set of project documents. LPA hereby grants permission to the recipient to reproduce or modify these documents for use on the project for which they were prepared. LPA and its consultants shall not be held responsible for any reproduction or modification (revised) in any other project documents. LPA and its consultants shall not be held responsible for any reproduction or modification (revised) in any other project documents. LPA and its consultants shall not be held responsible for any reproduction or modification (revised) in any other project documents.

© Copyright 2008

College of San Mateo Site Package San Mateo, CA

Table with columns: Revision, Description, Date. Includes entries for DSA SUBMITTAL, DSA FINAL, and PROJECT RECORD DRAWING.

Table with columns: Revision, Description, Date. Includes entries for DSA SUBMITTAL, DSA FINAL, and PROJECT RECORD DRAWING.

Table with columns: Job No., Date, Drawn by, Checked by, Scale. Includes values for 27082.30, 02 APRIL 2009, MD, JT, RH, 1"=20'

UTILITY PLAN C6.01